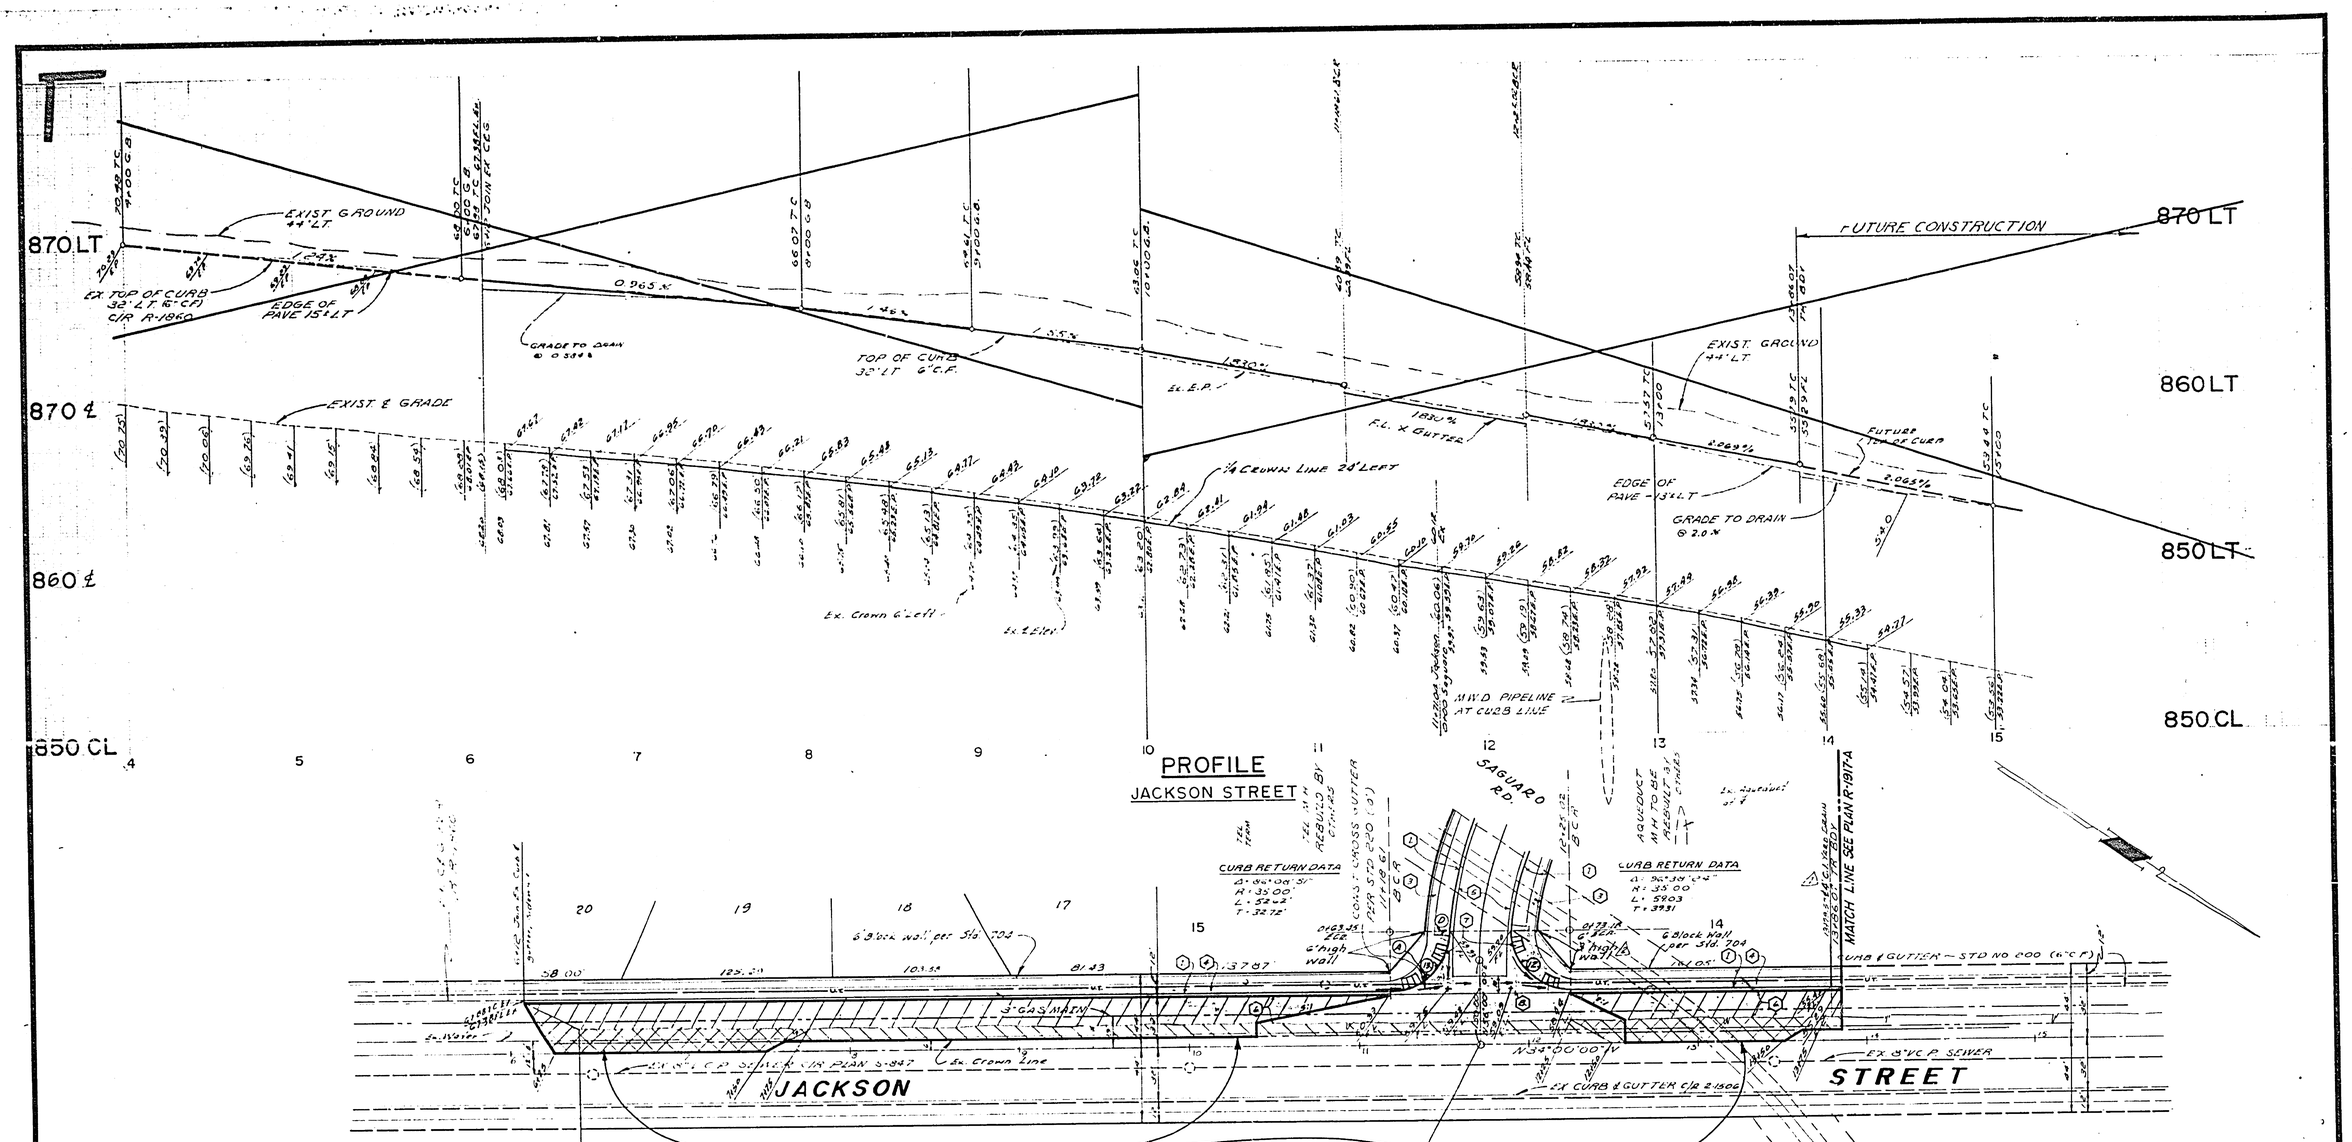

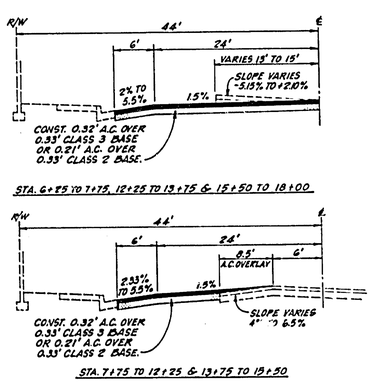

TYPICAL SECTIONS - JACKSON STREET

NOT TO SCALE
T/ = 7

LEGEND

- Denotes paving & base by City, Grading by Developer.
- Denotes overlay. ½ cost to be paid by Developer prior to City going to bid.
- Denotes Remove & Replace Existing Paving at 1.5% to ℄ Crown.

CONSTRUCTION NOTES

1. CONSTRUCTION SHALL BE IN ACCORDANCE WITH STANDARD SPECIFICATIONS FOR PUBLIC WORKS CONSTRUCTION, 1976 EDITION.

BENCH MARK

Elev 845.599, City B.M. FS-11 PK nail and tag in Riv. Wtr. Co. canal head wall on W'ly side of Monroe St., C/R F.B. 659/33

*AS BUILT 8-77 KPT

ALBERT A. WEBB ASSOCIATES
CIVIL ENGINEERS
RIVERSIDE, CALIFORNIA
APPROVED BY [signature] DATE 6-22-76
R.E. No. 38706
WO 76-30 FOR: Brattain Const. Co. F.B. 1067

MARK	REVISIONS	APPR.	DATE

DESIGNED BY R.E.S. DRAWN BY PHJR CHECKED BY BDM

CITY OF RIVERSIDE, CALIFORNIA
PUBLIC WORKS DEPARTMENT

APPROVED BY	BY	DATE
PRINCIPAL ENGINEER	[signature]	5-77
PARK DEPARTMENT	—	—
TRAFFIC DIVISION	[signature]	5-11-77
CHIEF PUB. WKS. ENGR.	[signature]	5-13-77

APPROVED BY [signature]
DIRECTOR OF PUBLIC WORKS
DATE 5-12-77

JACKSON STREET PAVEMENT PARTICIPATION WITH TRACT 5486-2

FROM 600' NORTH OF LINCOLN AVENUE TO 1400' NORTH OF LINCOLN AVENUE

SCALE: HORIZ: 1" = 40', VERT: 1" = 4'

ACCOUNT No. 30-575-390-07

DRAWING NUMBER R-1914-A

SHEET 1 OF 1

76-90-A

ADAPTED FROM PLAN R-1914