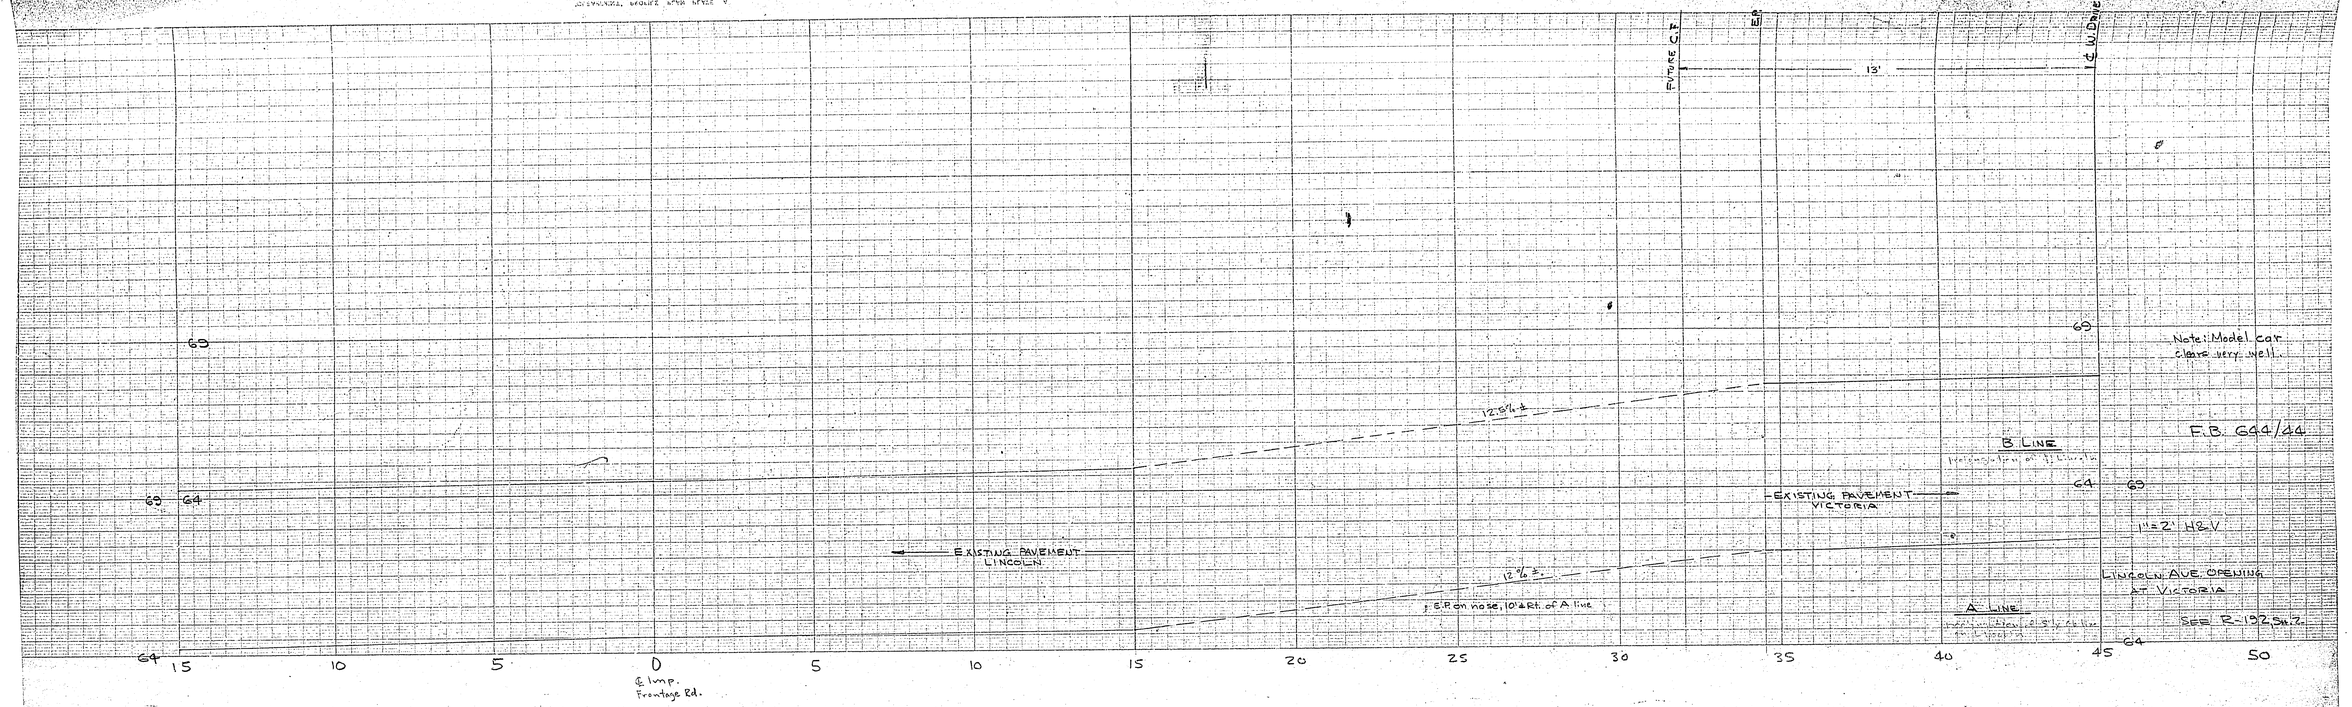

FILE WITH
R-192

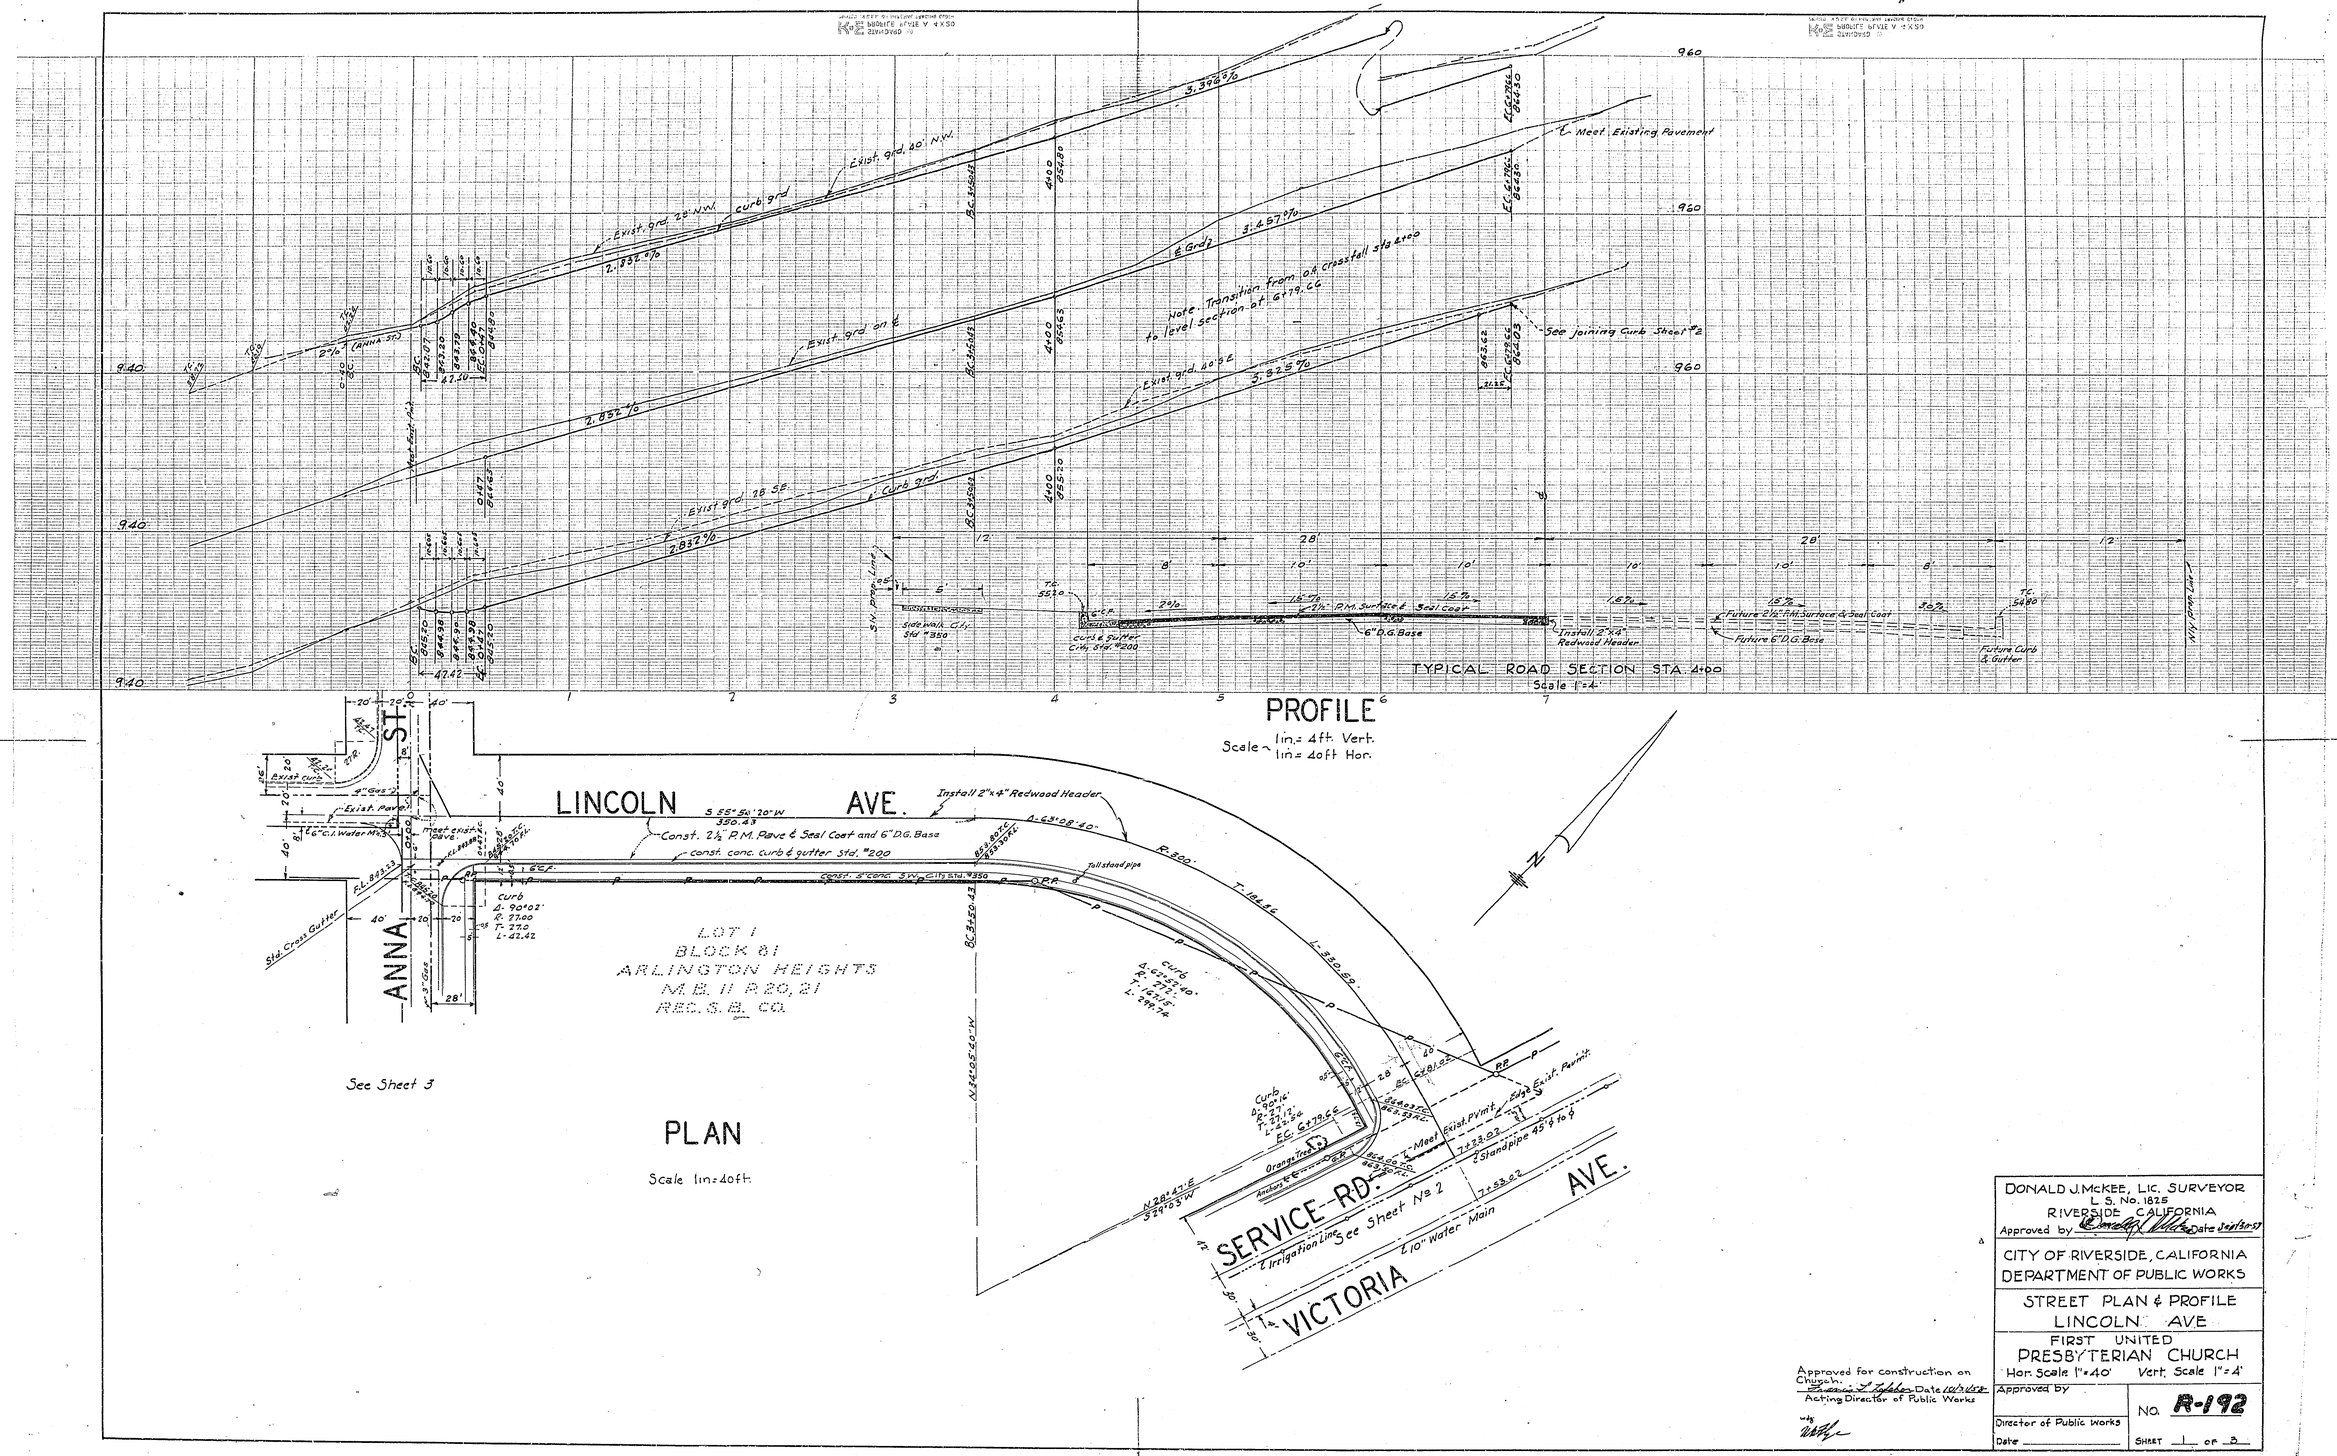

DONALD J. McKEE, LIC. SURVEYOR
L.S. No. 1825
RIVERSIDE CALIFORNIA
Approved by _____ Date _____

CITY OF RIVERSIDE, CALIFORNIA
DEPARTMENT OF PUBLIC WORKS

STREET PLAN & PROFILE
LINCOLN AVE

FIRST UNITED
PRESBYTERIAN CHURCH
Hor. Scale 1"=40' Vert. Scale 1"=4'

Approved for construction on Church.
_____ Date _____
Acting Director of Public Works

Approved by
Director of Public Works
Date _____

NO. R-192
SHEET 1 OF 3

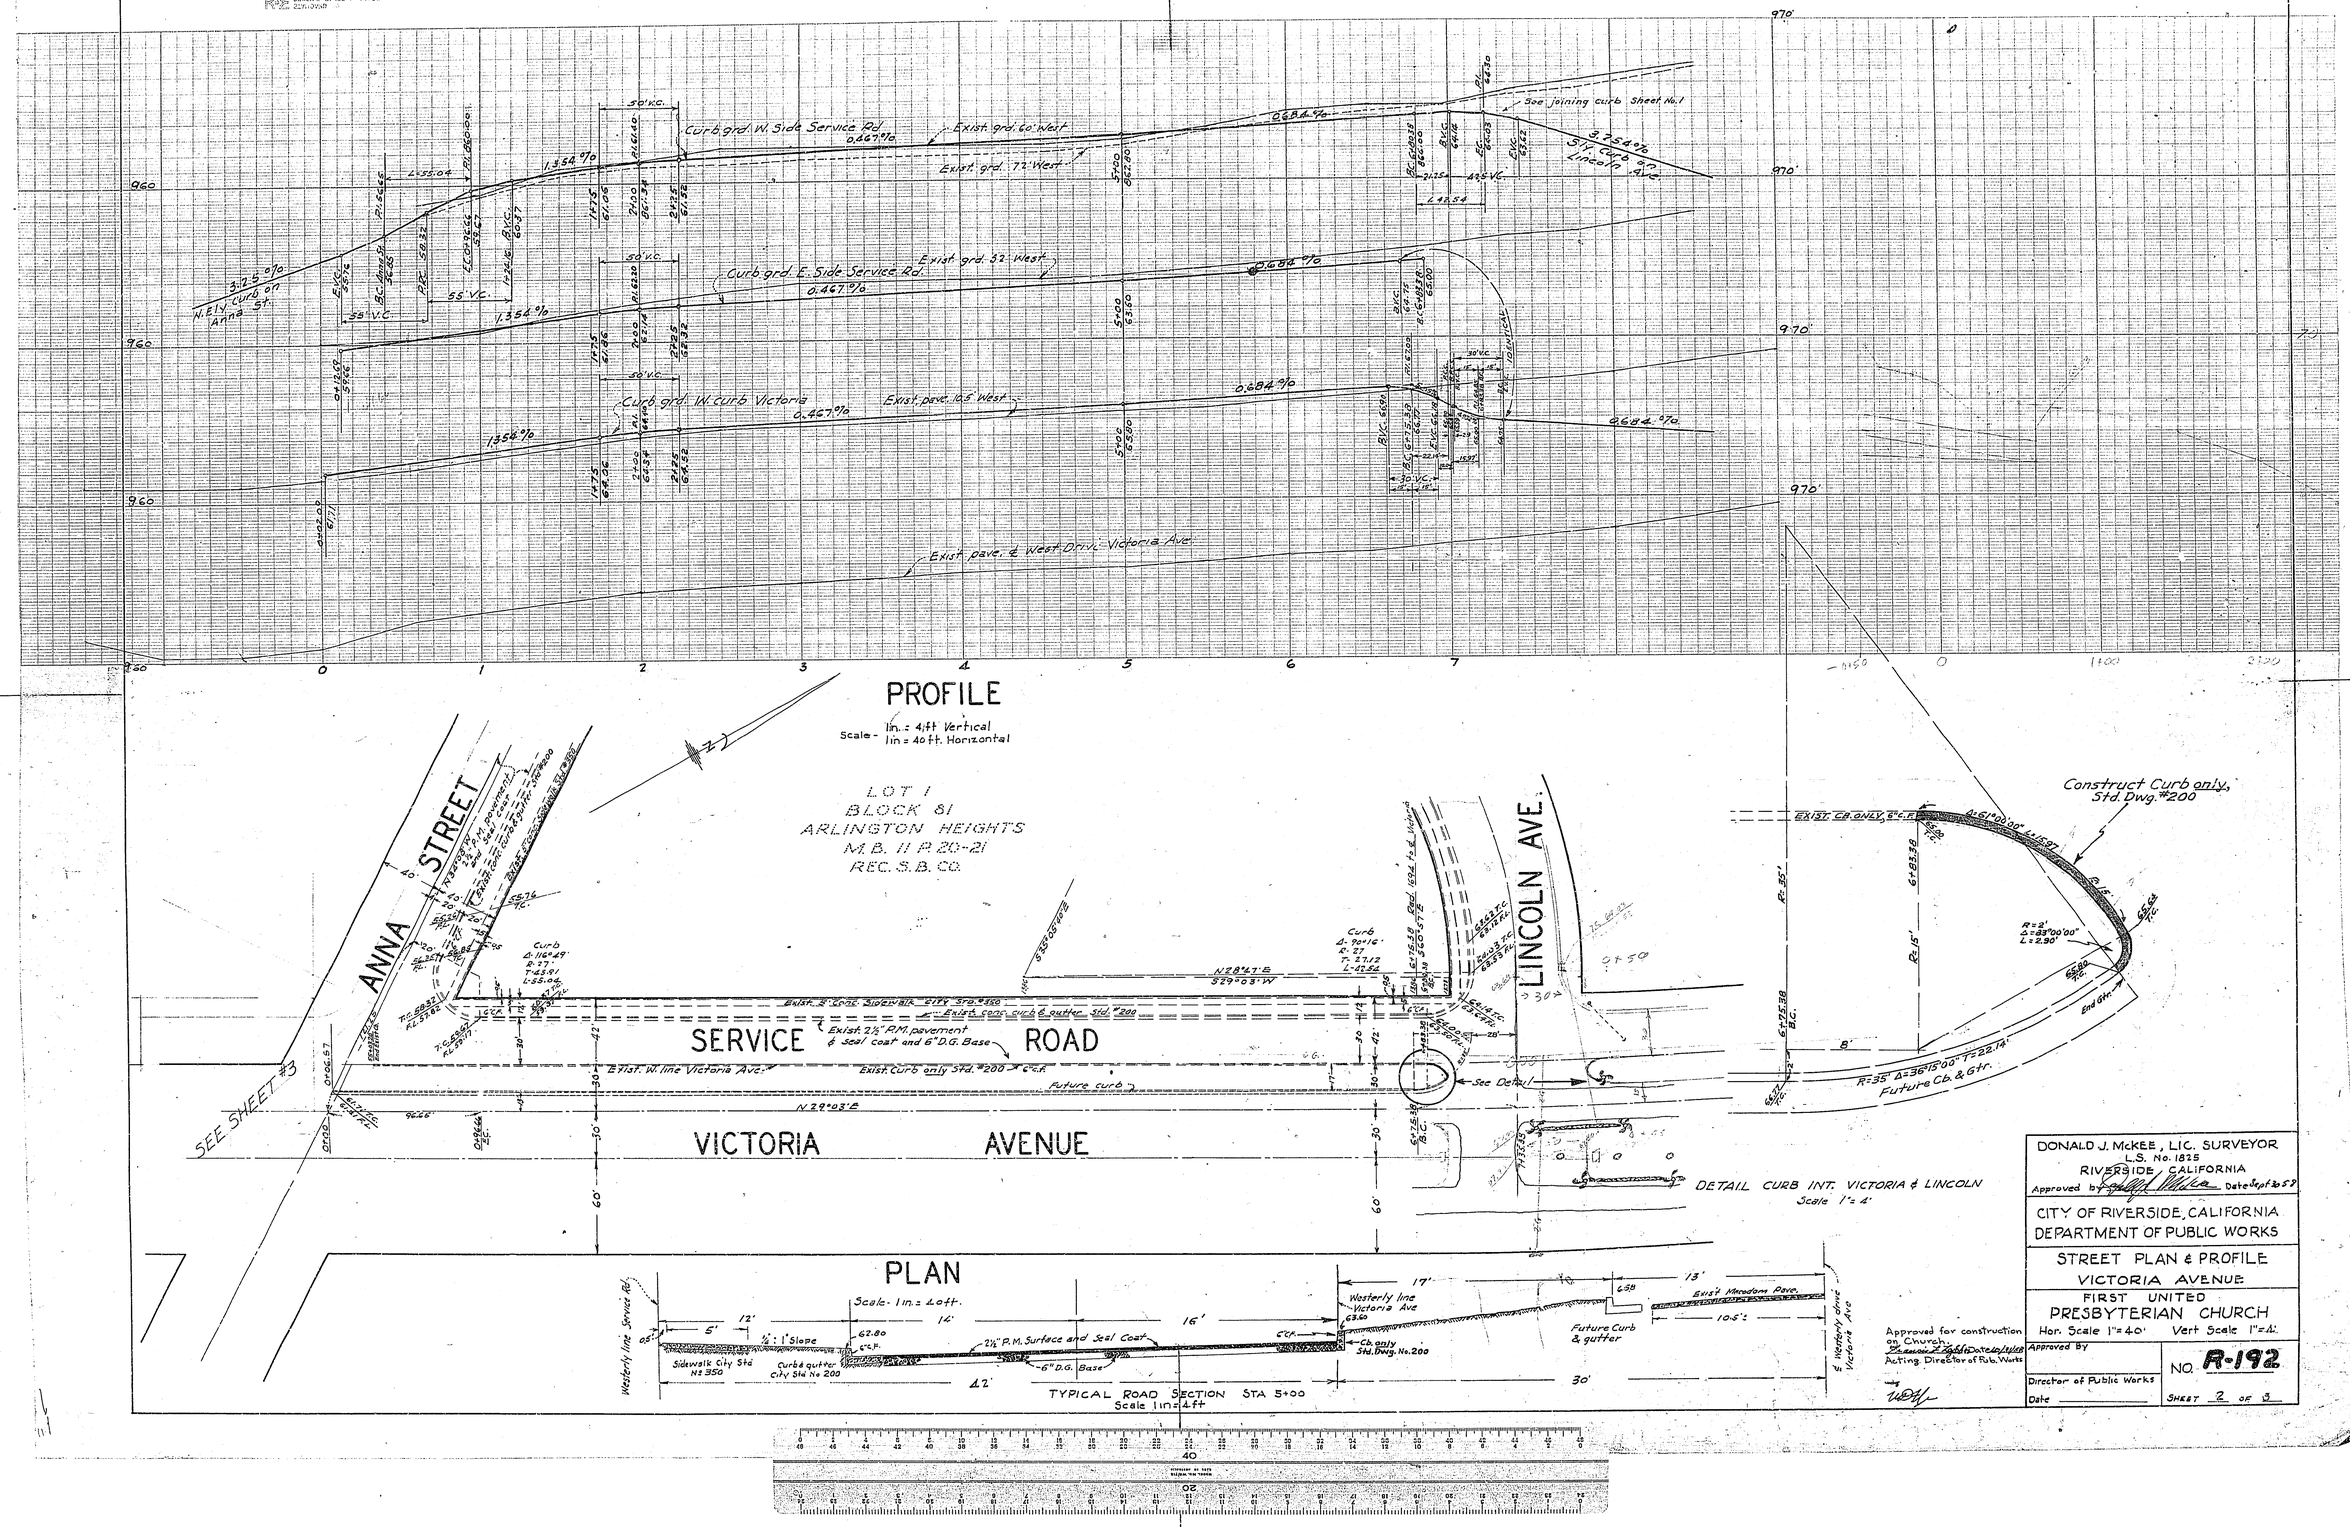
PROFILE
Scale - 1in. = 4ft Vertical
1in = 40 ft. Horizontal
LOT 1
BLOCK 81
ARLINGTON HEIGHTS
M.B. 11 P. 20-21
REC. S.B. CO.
ANNA STREET
LINCOLN AVE.
SERVICE ROAD
VICTORIA AVENUE
SEE SHEET #3
Construct Curb only, Std. Dwg. #200
DETAIL CURB INT. VICTORIA & LINCOLN
Scale 1" = 4'
PLAN
Scale - 1in. = 40ft.
TYPICAL ROAD SECTION STA 5+00
Scale 1in = 4ft
Approved for construction on Church.
Acting Director of Pub. Works
DONALD J. McKEE, LIC. SURVEYOR
L.S. No. 1825
RIVERSIDE, CALIFORNIA
Approved by
Date Sept 30 58
CITY OF RIVERSIDE, CALIFORNIA
DEPARTMENT OF PUBLIC WORKS
STREET PLAN & PROFILE
VICTORIA AVENUE
FIRST UNITED
PRESBYTERIAN CHURCH
Hor. Scale 1" = 40'
Vert Scale 1" = 4'
Approved By
Director of Public Works
Date
NO. R-192
SHEET 2 OF 3

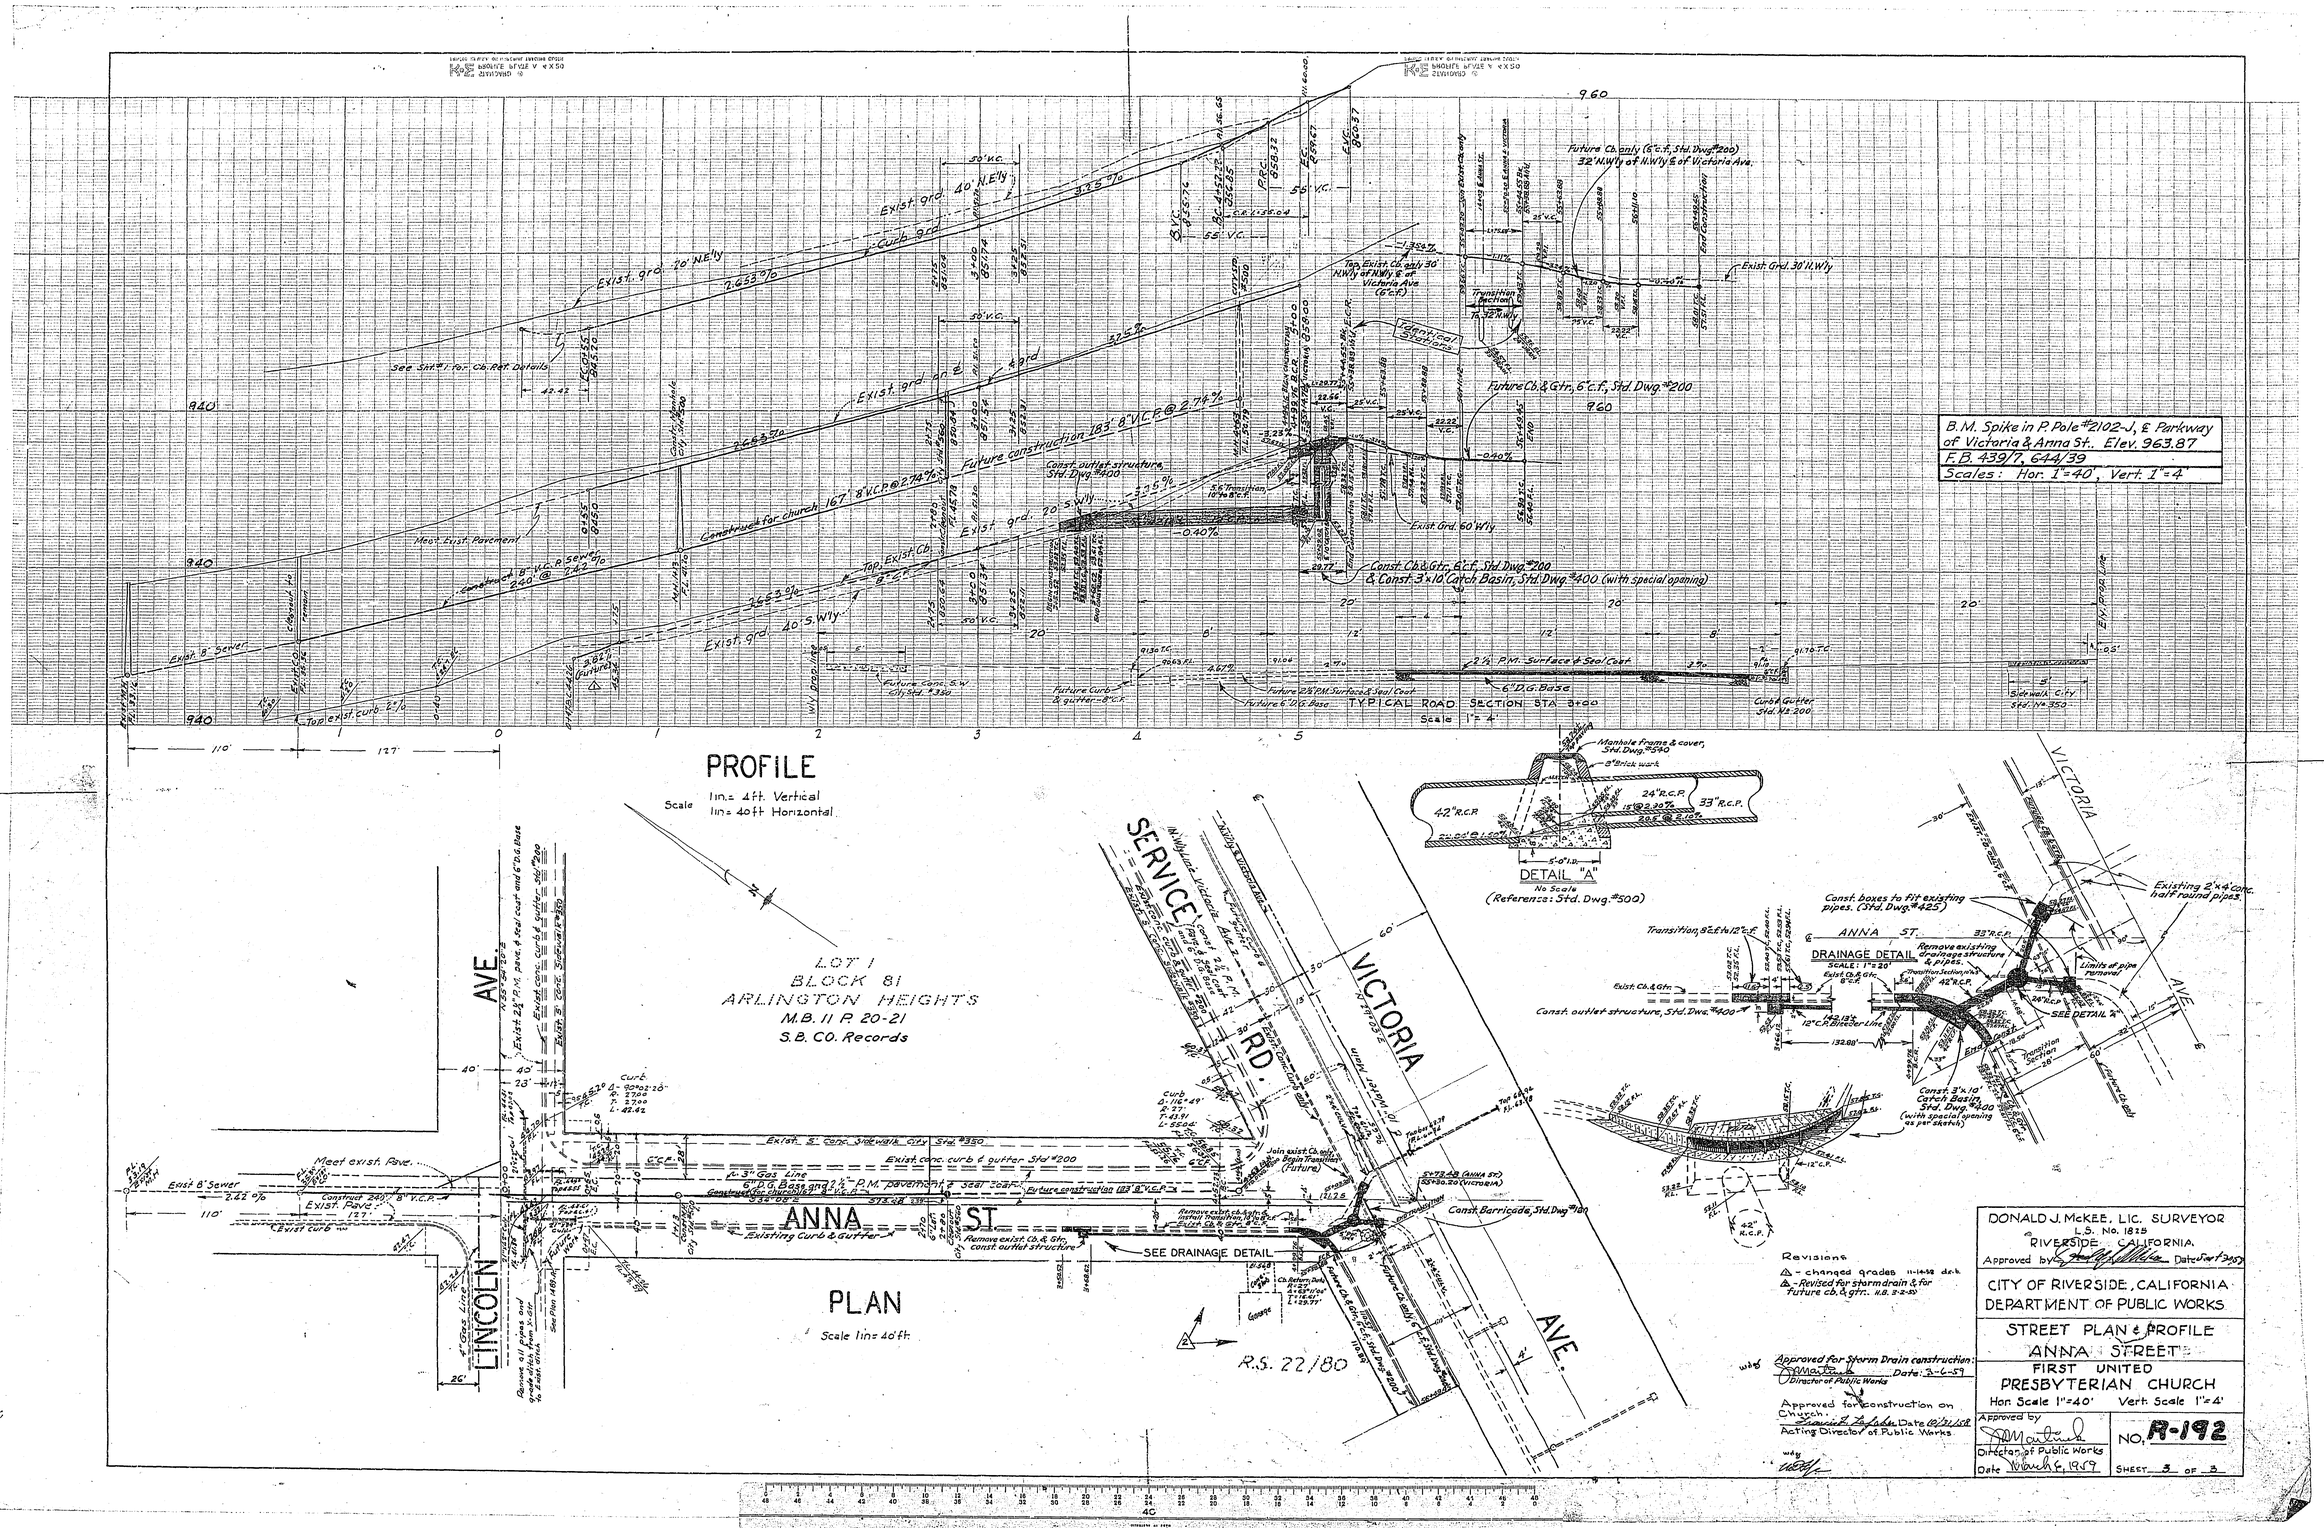
PROFILE
Scale 1in.= 4ft. Vertical
1in.= 40ft. Horizontal
PLAN
Scale 1in.= 40ft.
ANNA ST.
LINCOLN AVE.
VICTORIA AVE.
SERVICE RD.
LOT 1
BLOCK 81
ARLINGTON HEIGHTS
M.B. 11 P. 20-21
S.B. CO. Records
R.S. 22/180
SEE DRAINAGE DETAIL
DRAINAGE DETAIL
SCALE: 1"=20'
DETAIL "A"
No Scale
(Reference: Std. Dwg. #500)
TYPICAL ROAD SECTION STA. 3+00
Scale 1"=4'
B.M. Spike in P. Pole #2102-J, & Parkway of Victoria & Anna St.. Elev. 963.87
F.B. 439/7, 644/39
Scales: Hor. 1"=40', Vert. 1"=4'
DONALD J. McKEE, LIC. SURVEYOR
L.S. No. 1825
RIVERSIDE, CALIFORNIA
CITY OF RIVERSIDE, CALIFORNIA
DEPARTMENT OF PUBLIC WORKS
STREET PLAN & PROFILE
ANNA STREET
FIRST UNITED PRESBYTERIAN CHURCH
Hor. Scale 1"=40' Vert. Scale 1"=4'
Director of Public Works
NO. R-192
SHEET 3 OF 3
Revisions
Approved for Storm Drain construction:
Director of Public Works
Date: 3-6-59
Approved for construction on Church:
Acting Director of Public Works
Date 10/31/58