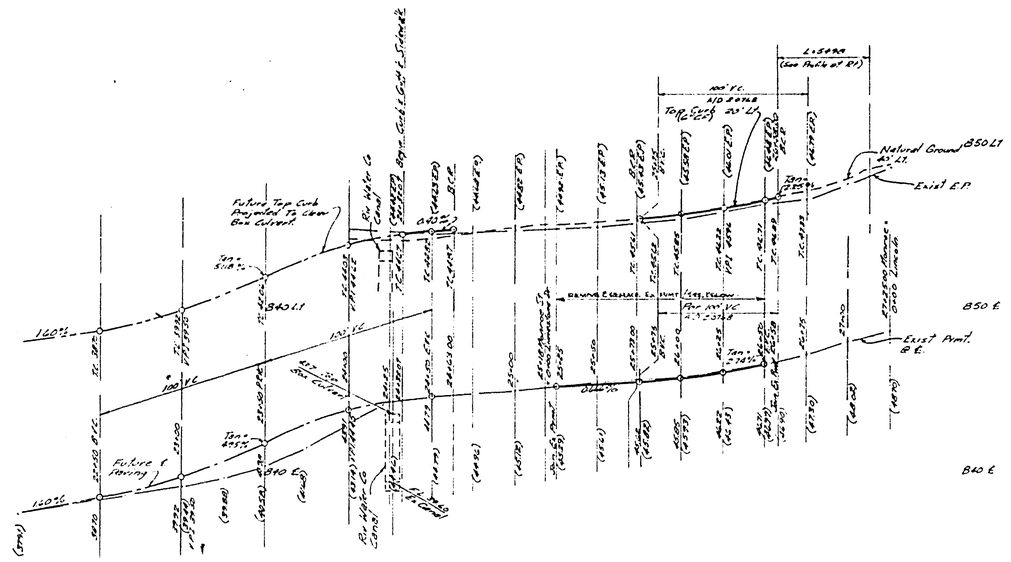

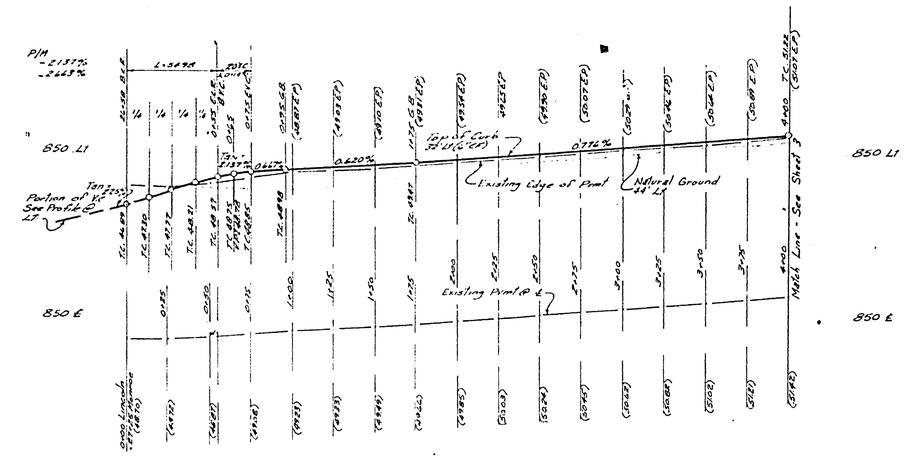

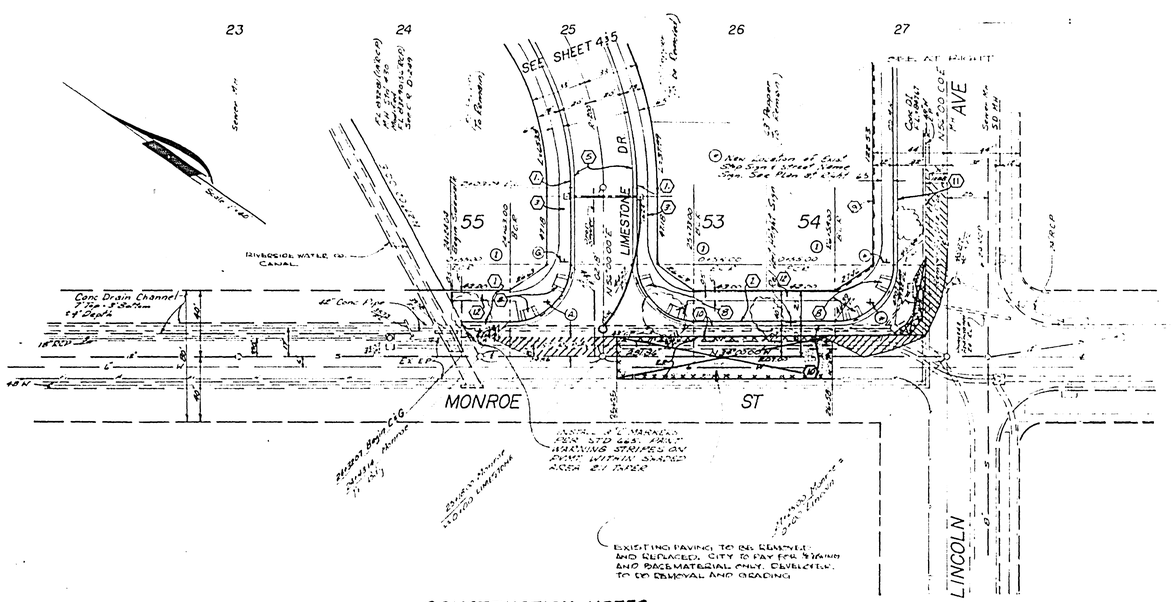

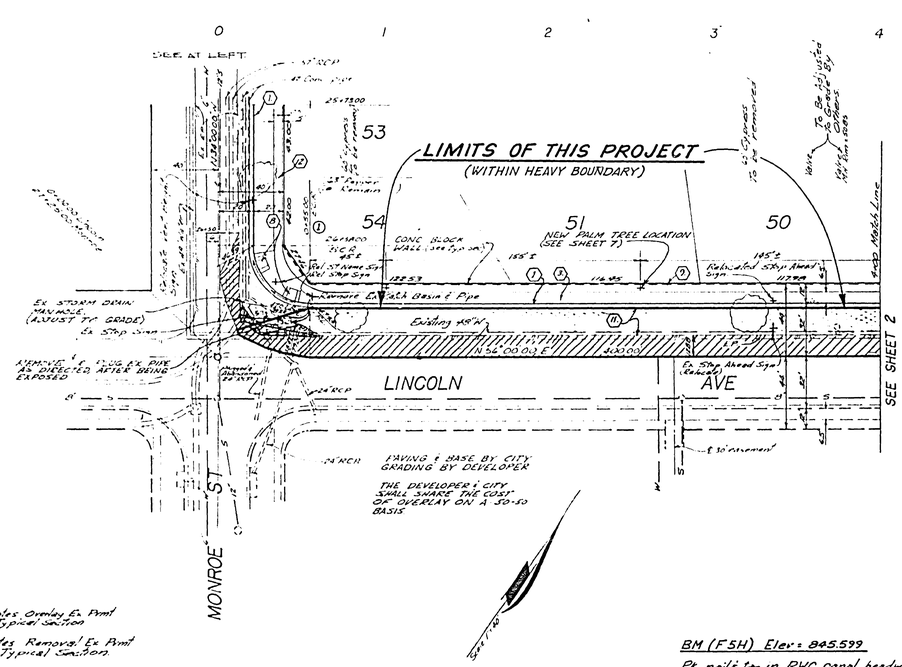

CONSTRUCTION NOTES

1. CONSTRUCTION SHALL BE IN ACCORDANCE WITH STANDARD SPECIFICATIONS FOR PUBLIC WORKS CONSTRUCTION, 1976 EDITION.

Denotes Overlay Ex Pvmt See Typical Section

Denotes Removal Ex Pvmt See Typical Section

BM (FSH) Elev = 845.599

Pk nail & tag in RWC canal headwall on Wly side of Monroe Street. c/p F.B. 839/33.

#AS BUILT 8-77 KPT

CURVE DATA

NO	Δ	R	T	L
1	90°00'00"	35	[illegible]	54.98

ALBERT A. WEBB ASSOCIATES
CIVIL ENGINEERS
RIVERSIDE, CALIFORNIA
APPROVED BY [signature] DATE 8/9/76
R.E. No. 39776
W.O. 75-161 FOR: Woodhaven Enterprises F.B. 1023

MARK	REVISIONS	APPR.	DATE

DESIGNED BY DB DRAWN BY LRM CHECKED BY [illegible]

CITY OF RIVERSIDE, CALIFORNIA
PUBLIC WORKS DEPARTMENT

APPROVED BY	BY	DATE
PRINCIPAL ENGINEER	[illegible]	[illegible]
PARK DEPARTMENT	—	—
TRAFFIC DIVISION	[illegible]	[illegible]
CHIEF PUB. WKS. ENGR.		

APPROVED BY [signature]
DIRECTOR OF PUBLIC WORKS
DATE [illegible]

STREET PLAN & PROFILE
LINCOLN AVENUE PAVEMENT
PARTICIPATION WITH TRACT 7873
MONROE STREET TO GRATTON STREET
SCALE: Horiz 1"=40' Vert 1"=4'

ACCOUNT No. 30-575-204
DRAWING NUMBER
R-1932-A
SHEET 1 OF 2
75-161-A

ADAPTED FROM PLAN R-1932

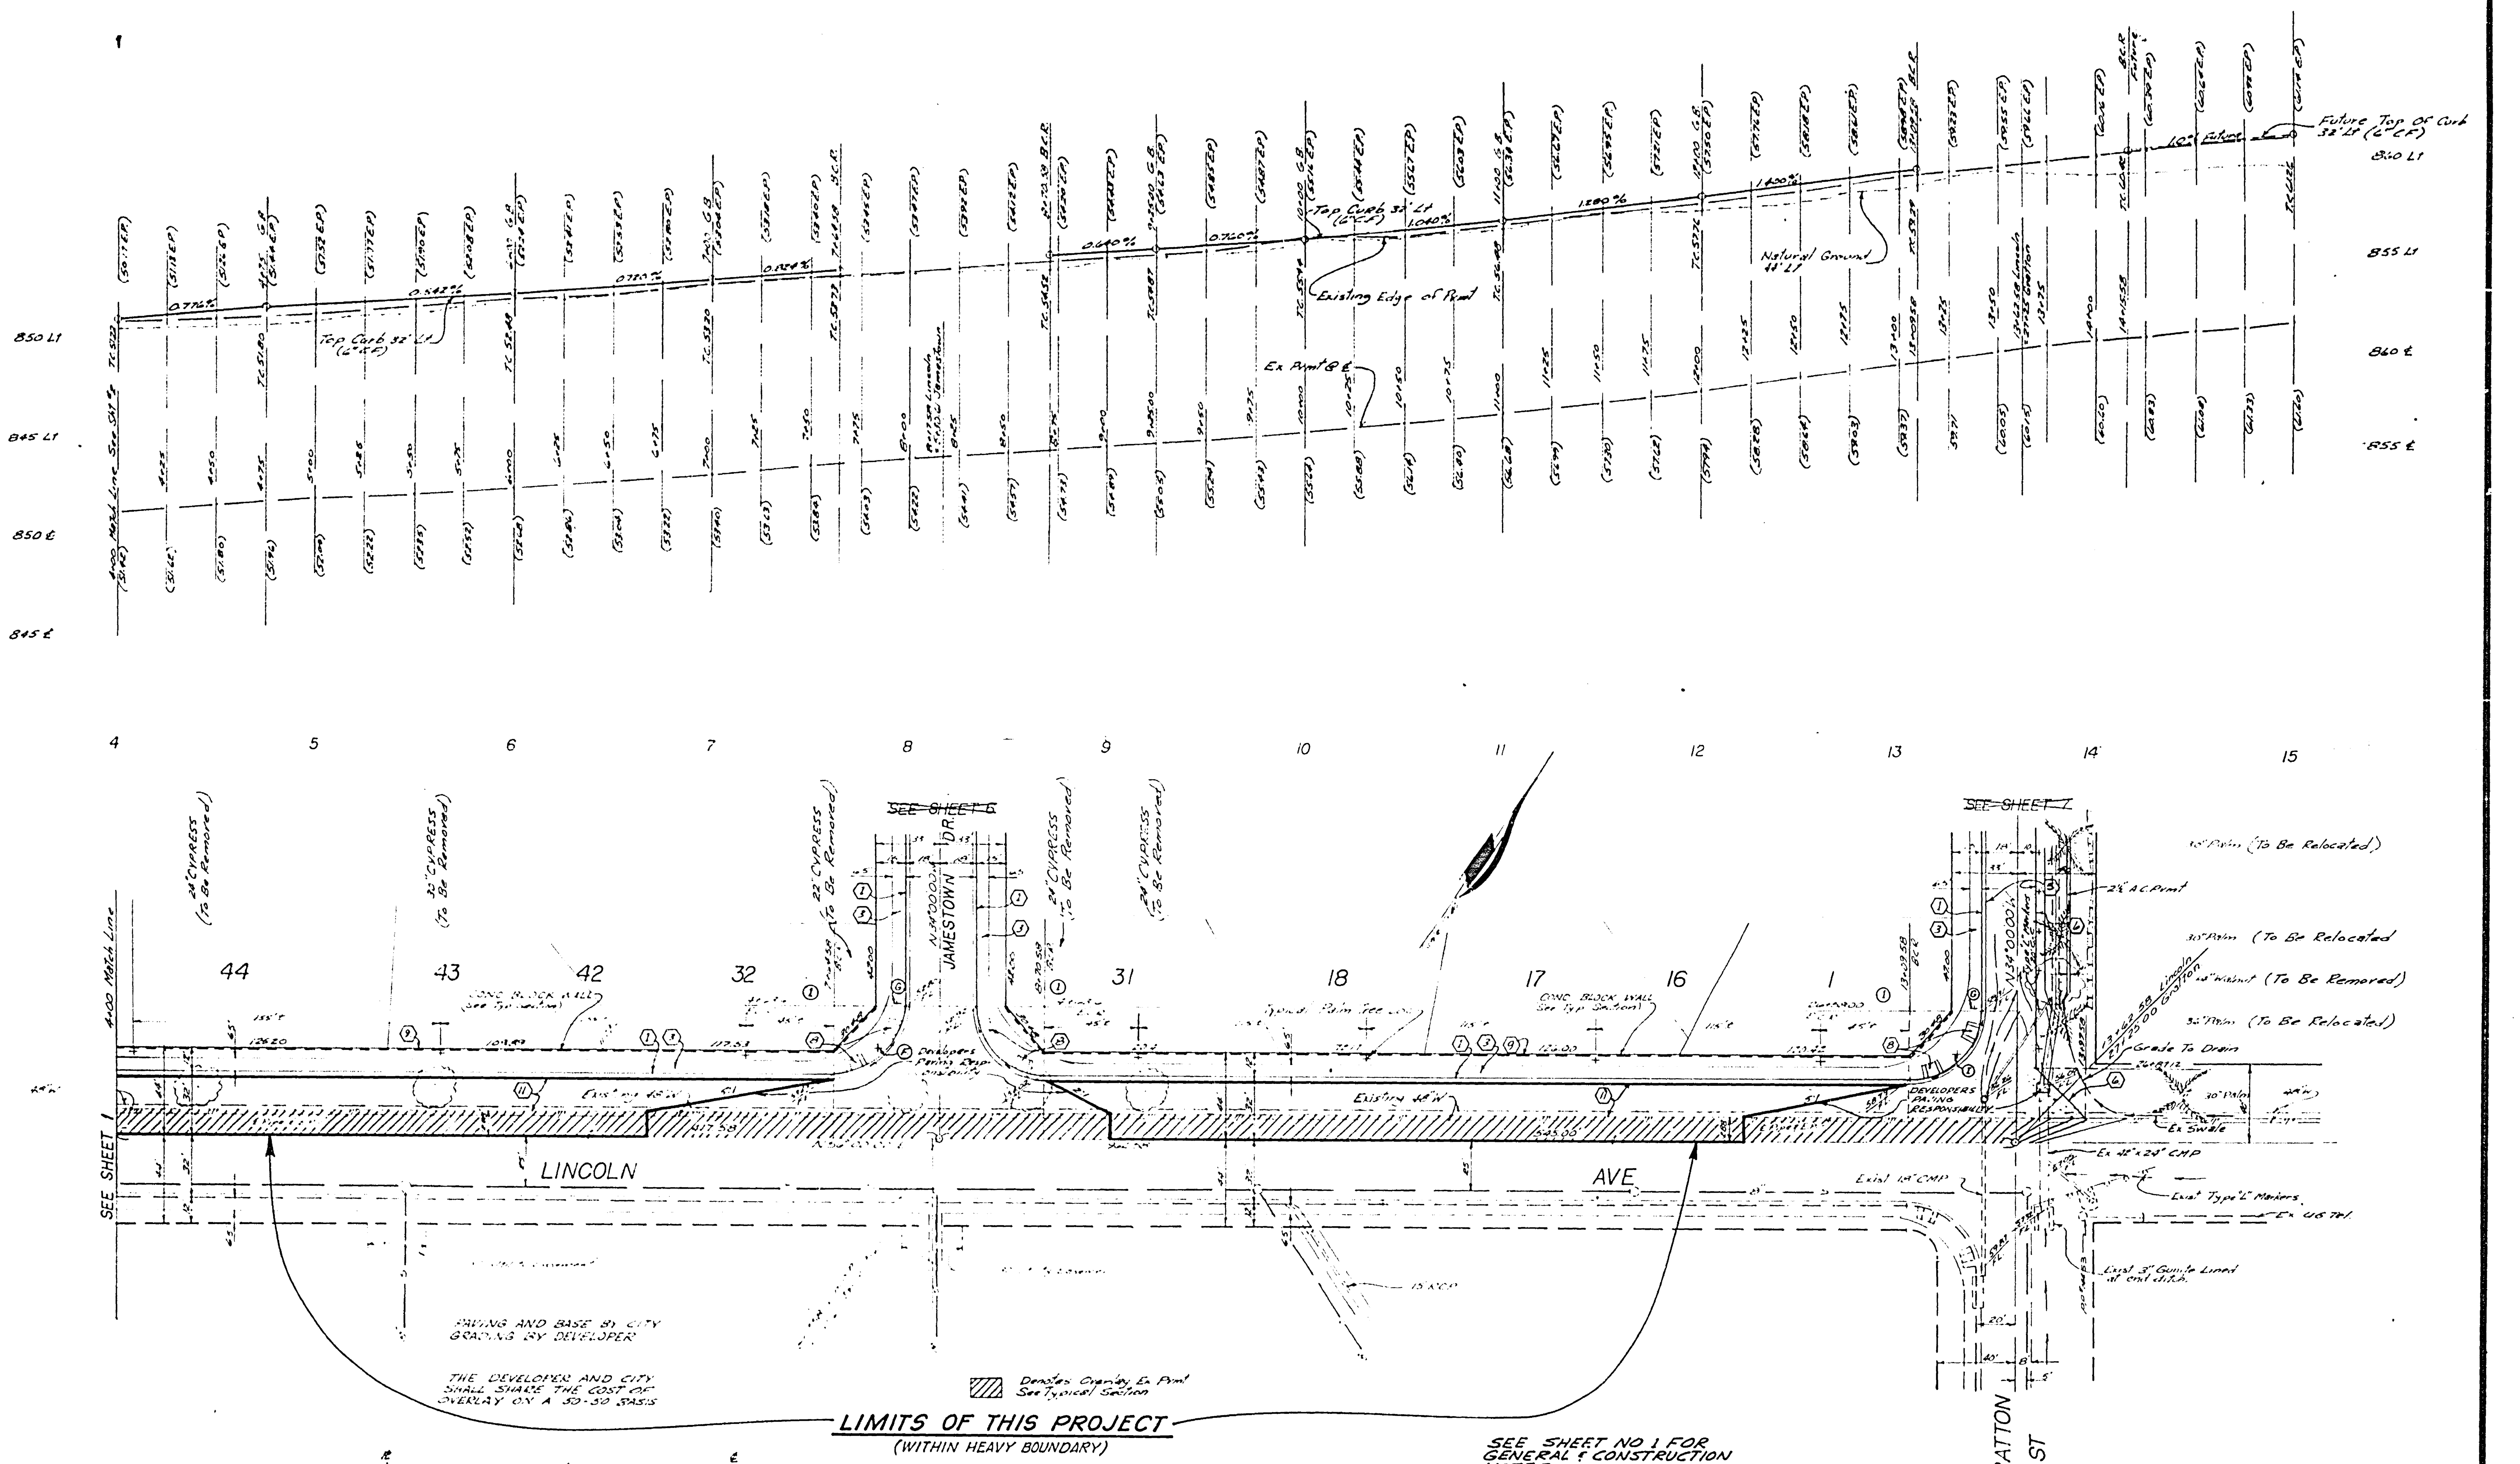

SEE SHEET NO 1 FOR GENERAL & CONSTRUCTION NOTES.

BM (F 5H) Elev = 845.599
PK nail & Tag in RWC canal headwall on Wly side. of Monroe Street. c/R F.B 839/33.

CURVE DATA

NO	Δ	R	T	L
1	90°00'00"	35'	35.00	54.98'

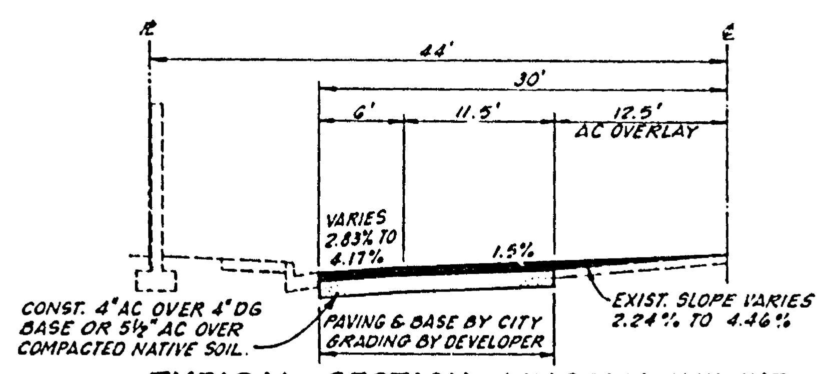

TYPICAL SECTION - LINCOLN AVENUE
NOT TO SCALE
T.I. = 7

ALBERT A. WEBB ASSOCIATES
CIVIL ENGINEERS
RIVERSIDE, CALIFORNIA
APPROVED BY [signature] DATE 8/9/76
R.E. No. 9876
W.O. 75-161 FOR: Woodhaven Enterprises F.B. 1026

MARK	REVISIONS	APPR.	DATE

DESIGNED BY DB DRAWN BY L.R.M. CHECKED BY BDA

CITY OF RIVERSIDE, CALIFORNIA
PUBLIC WORKS DEPARTMENT

APPROVED BY	BY	DATE
PRINCIPAL ENGINEER	[initials]	9/4
PARK DEPARTMENT	—	—
TRAFFIC DIVISION	[initials]	
CHIEF PUB. WKS. ENGR.		

APPROVED BY [signature]
DIRECTOR OF PUBLIC WORKS
DATE 9-1-77

*AS BUILT 8-77 KPT

STREET PLAN & PROFILE
LINCOLN AVENUE PAVEMENT
PARTICIPATION WITH TRACT 7873
MONROE STREET TO GRATTON STREET
SCALE: Horiz 1" = 40' Vert 1" = 4'

INDEXED R.R.
ACCOUNT No. 30-575-204
DRAWING NUMBER
R-1932-A
SHEET 2 OF 2
75-161-A

ADAPTED FROM PLAN R-1932