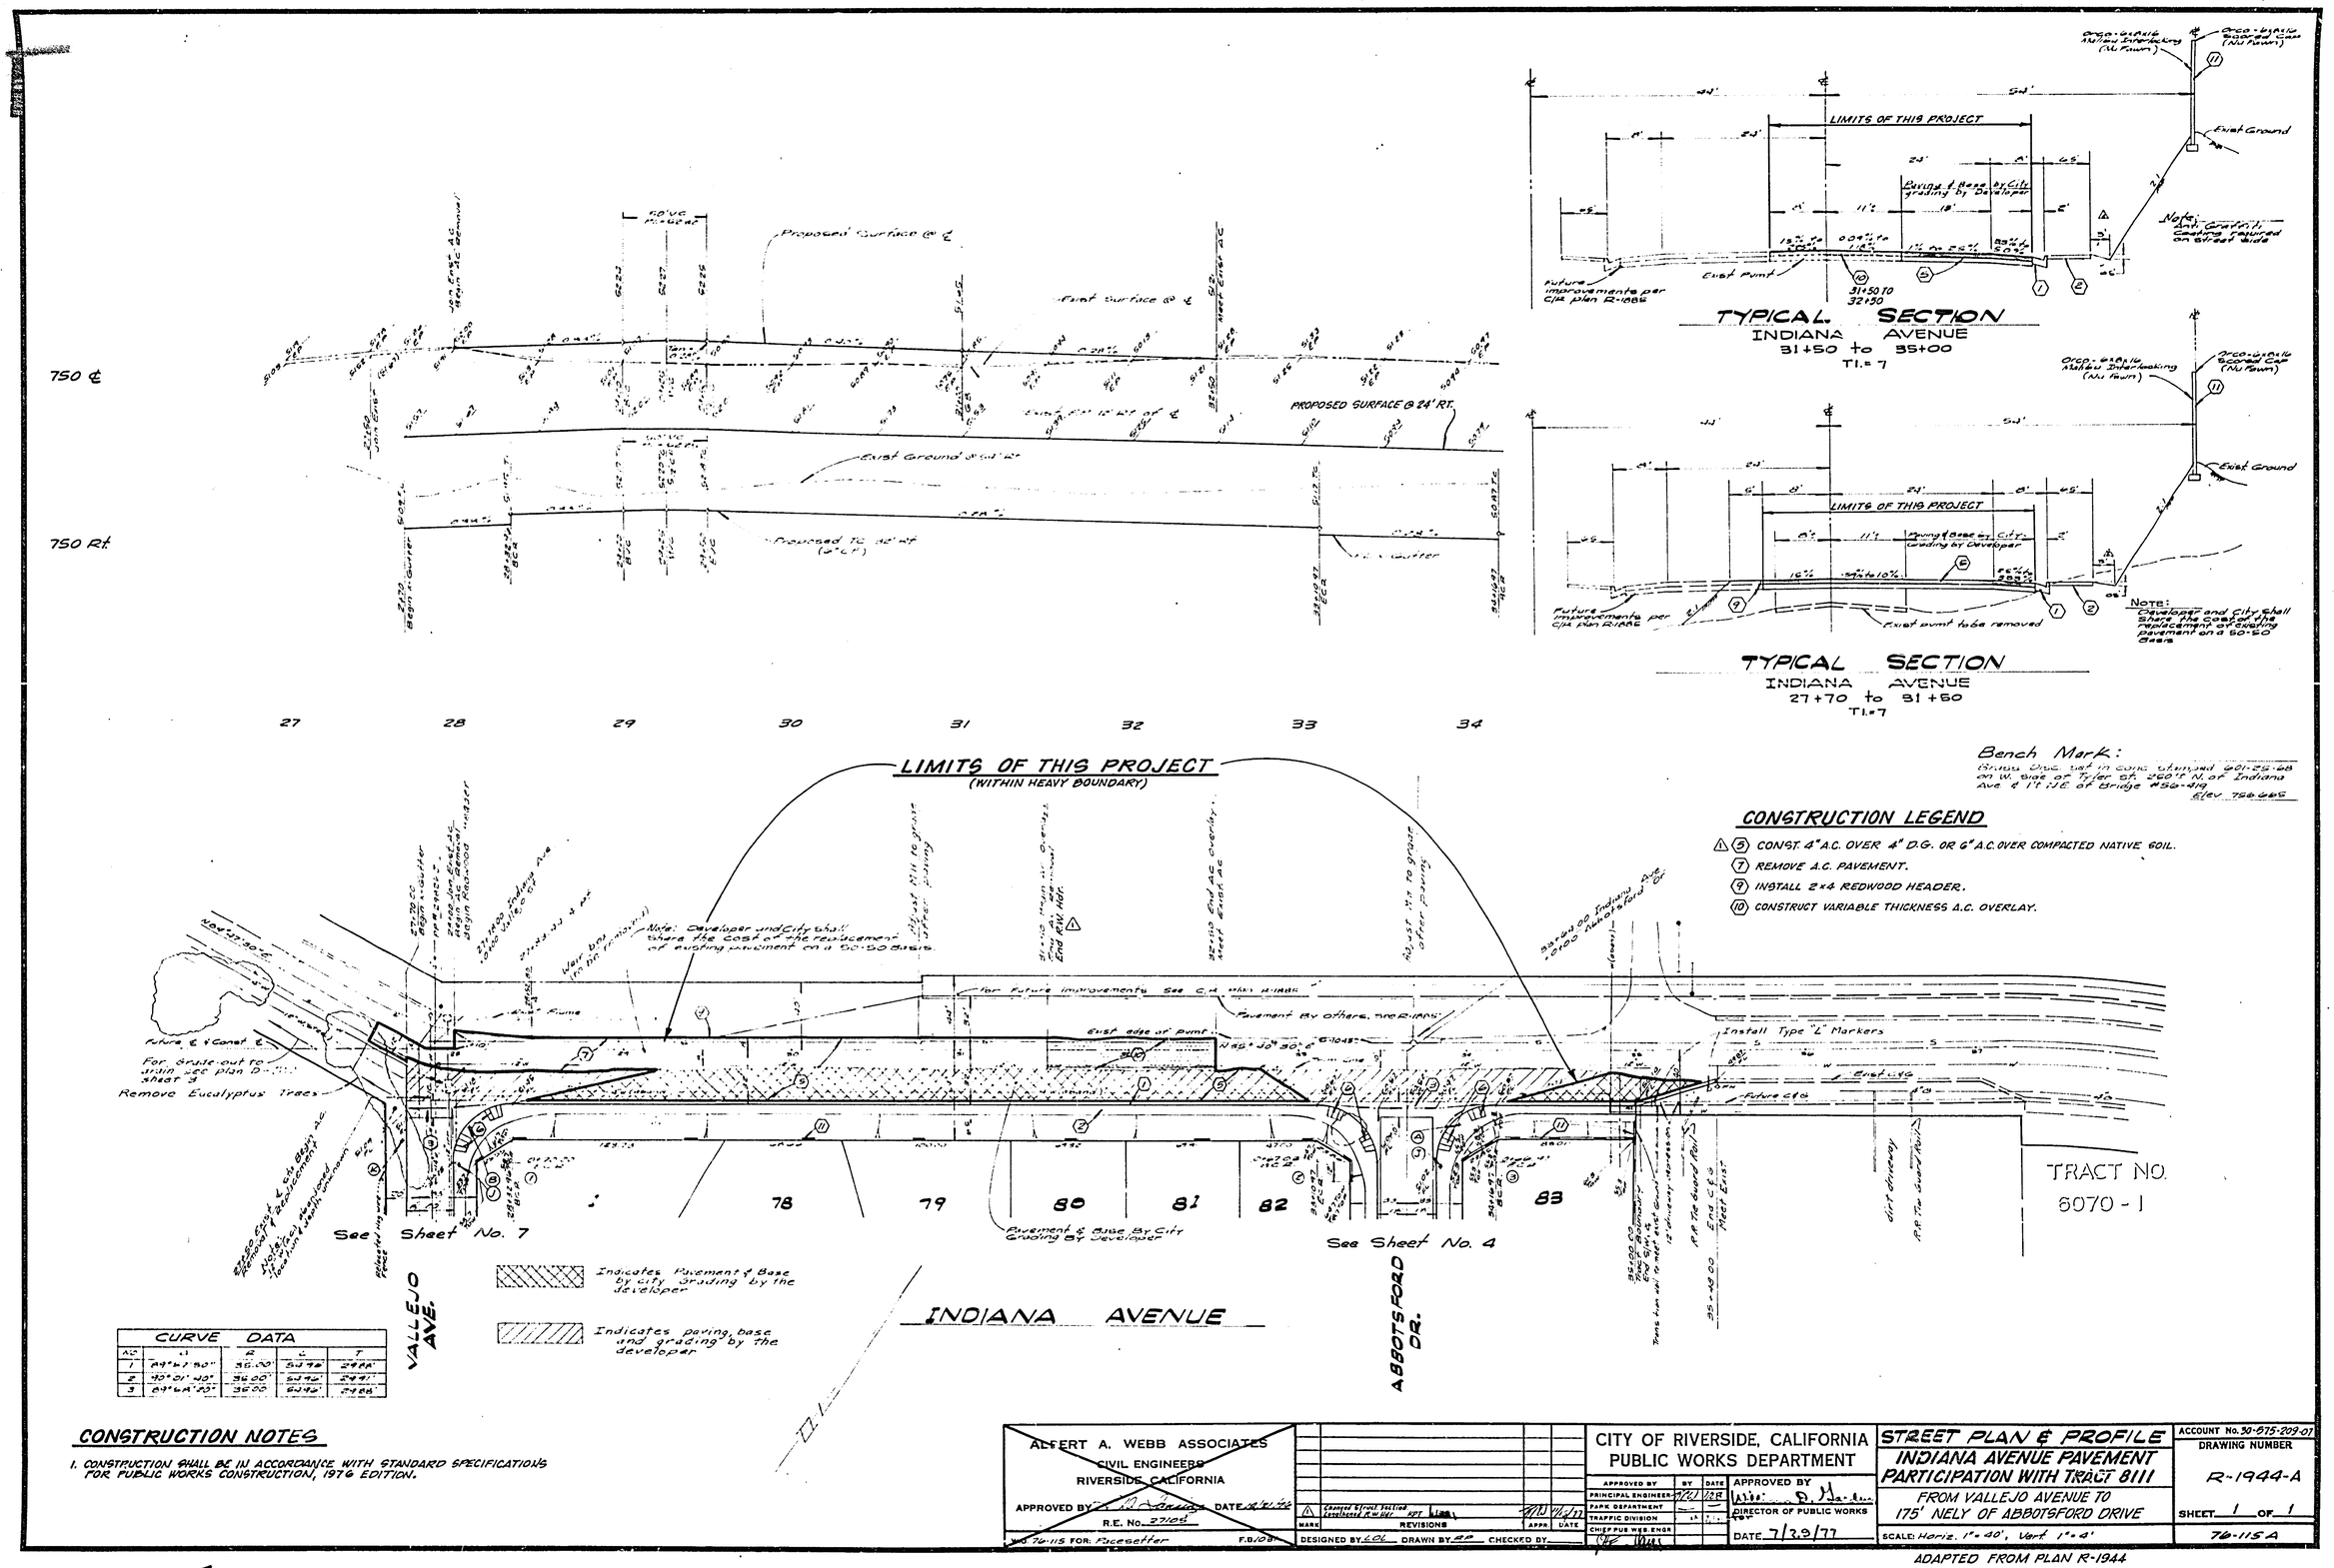

Bench Mark:
Brass Disc set in conc stamped 601-25-68 on W. side of Tyler St. 260'± N. of Indiana Ave & 1'± N.E. of Bridge #56-419
Elev. 756.665

CONSTRUCTION LEGEND

- (5) CONST. 4" A.C. OVER 4" D.G. OR 6" A.C. OVER COMPACTED NATIVE SOIL.
- (7) REMOVE A.C. PAVEMENT.
- (9) INSTALL 2x4 REDWOOD HEADER.
- (10) CONSTRUCT VARIABLE THICKNESS A.C. OVERLAY.

CURVE DATA				
NO	A	R	L	T
1	89°47'30"	35.00'	54.96'	29.88'
2	90°01'40"	35.00'	54.96'	29.91'
3	89°58'20"	35.00'	54.96'	29.88'

CONSTRUCTION NOTES

1. CONSTRUCTION SHALL BE IN ACCORDANCE WITH STANDARD SPECIFICATIONS FOR PUBLIC WORKS CONSTRUCTION, 1976 EDITION.

ALBERT A. WEBB ASSOCIATES
CIVIL ENGINEERS
RIVERSIDE, CALIFORNIA
APPROVED BY [signature] DATE 12/21/76
R.E. No. 27105
W.O. 76-115 FOR: Facesetter F.B./OBI

MARK	REVISIONS	APPR.	DATE
1	Changed Struct. Section Lengthened R.W. Hdr. KPT	[initials]	11/16/77

DESIGNED BY LOL DRAWN BY RP CHECKED BY

CITY OF RIVERSIDE, CALIFORNIA
PUBLIC WORKS DEPARTMENT

APPROVED BY	BY	DATE
PRINCIPAL ENGINEER	[initials]	12/8
PARK DEPARTMENT		
TRAFFIC DIVISION		
CHIEF PUB. WKS. ENGR.		

APPROVED BY [signature]
DIRECTOR OF PUBLIC WORKS
DATE 7/29/77

STREET PLAN & PROFILE
INDIANA AVENUE PAVEMENT PARTICIPATION WITH TRACT 8111
FROM VALLEJO AVENUE TO 175' NELY OF ABBOTSFORD DRIVE
SCALE: Horiz. 1" = 40', Vert. 1" = 4'

ACCOUNT No. 30-575-209-07
DRAWING NUMBER R-1944-A
SHEET 1 OF 1
76-115A

ADAPTED FROM PLAN R-1944