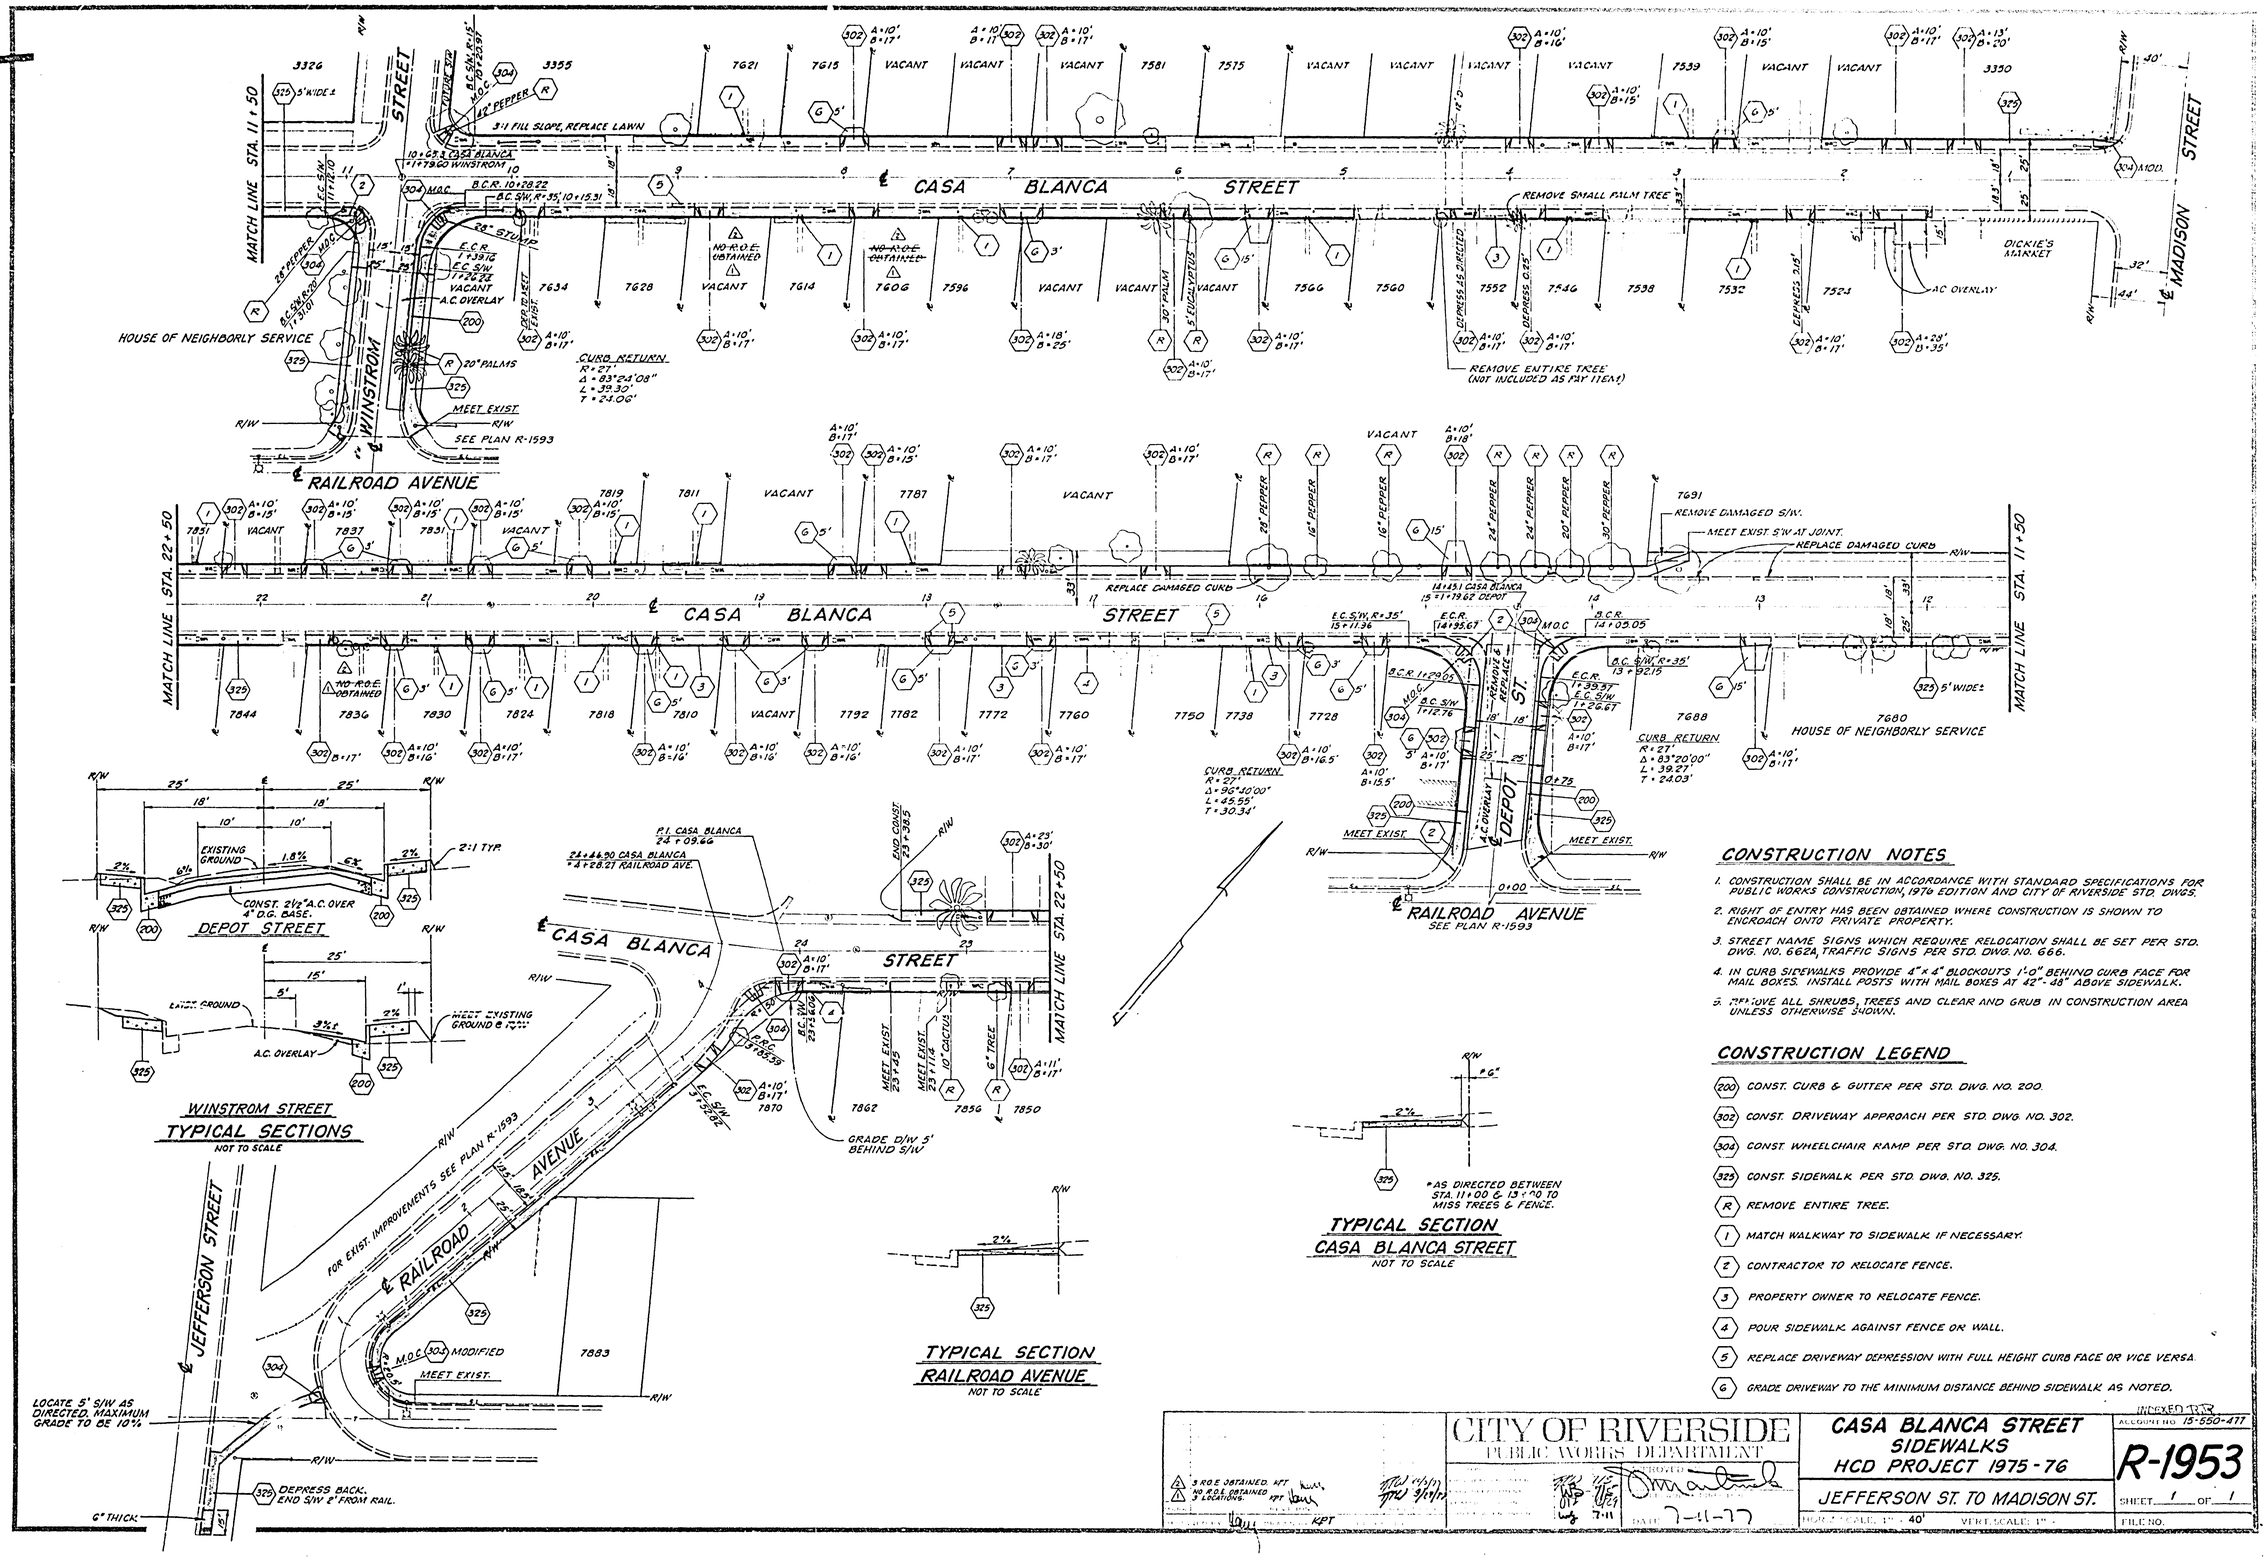

CONSTRUCTION NOTES

1. CONSTRUCTION SHALL BE IN ACCORDANCE WITH STANDARD SPECIFICATIONS FOR PUBLIC WORKS CONSTRUCTION, 1976 EDITION AND CITY OF RIVERSIDE STD. DWGS.
2. RIGHT OF ENTRY HAS BEEN OBTAINED WHERE CONSTRUCTION IS SHOWN TO ENCROACH ONTO PRIVATE PROPERTY.
3. STREET NAME SIGNS WHICH REQUIRE RELOCATION SHALL BE SET PER STD. DWG. NO. 662A, TRAFFIC SIGNS PER STD. DWG. NO. 666.
4. IN CURB SIDEWALKS PROVIDE 4" x 4" BLOCKOUTS 1'-0" BEHIND CURB FACE FOR MAIL BOXES. INSTALL POSTS WITH MAIL BOXES AT 42"-48" ABOVE SIDEWALK.
5. REMOVE ALL SHRUBS, TREES AND CLEAR AND GRUB IN CONSTRUCTION AREA UNLESS OTHERWISE SHOWN.

CONSTRUCTION LEGEND

- (200) CONST. CURB & GUTTER PER STD. DWG. NO. 200.
- (302) CONST. DRIVEWAY APPROACH PER STD. DWG. NO. 302.
- (304) CONST. WHEELCHAIR RAMP PER STD. DWG. NO. 304.
- (325) CONST. SIDEWALK PER STD. DWG. NO. 325.
- (R) REMOVE ENTIRE TREE.
- (1) MATCH WALKWAY TO SIDEWALK IF NECESSARY.
- (2) CONTRACTOR TO RELOCATE FENCE.
- (3) PROPERTY OWNER TO RELOCATE FENCE.
- (4) POUR SIDEWALK AGAINST FENCE OR WALL.
- (5) REPLACE DRIVEWAY DEPRESSION WITH FULL HEIGHT CURB FACE OR VICE VERSA.
- (6) GRADE DRIVEWAY TO THE MINIMUM DISTANCE BEHIND SIDEWALK AS NOTED.

3 R.O.E. OBTAINED. KPT
NO R.O.E. OBTAINED 3 LOCATIONS. KPT

KPT

CITY OF RIVERSIDE
PUBLIC WORKS DEPARTMENT

APPROVED
DATE 7-11-77

CASA BLANCA STREET SIDEWALKS
HCD PROJECT 1975-76

JEFFERSON ST. TO MADISON ST.

HORIZ. SCALE: 1" = 40' VERT. SCALE: 1" =

INDEXED TO
ACCOUNT NO. 15-550-477

R-1953

SHEET 1 OF 1

FILE NO.