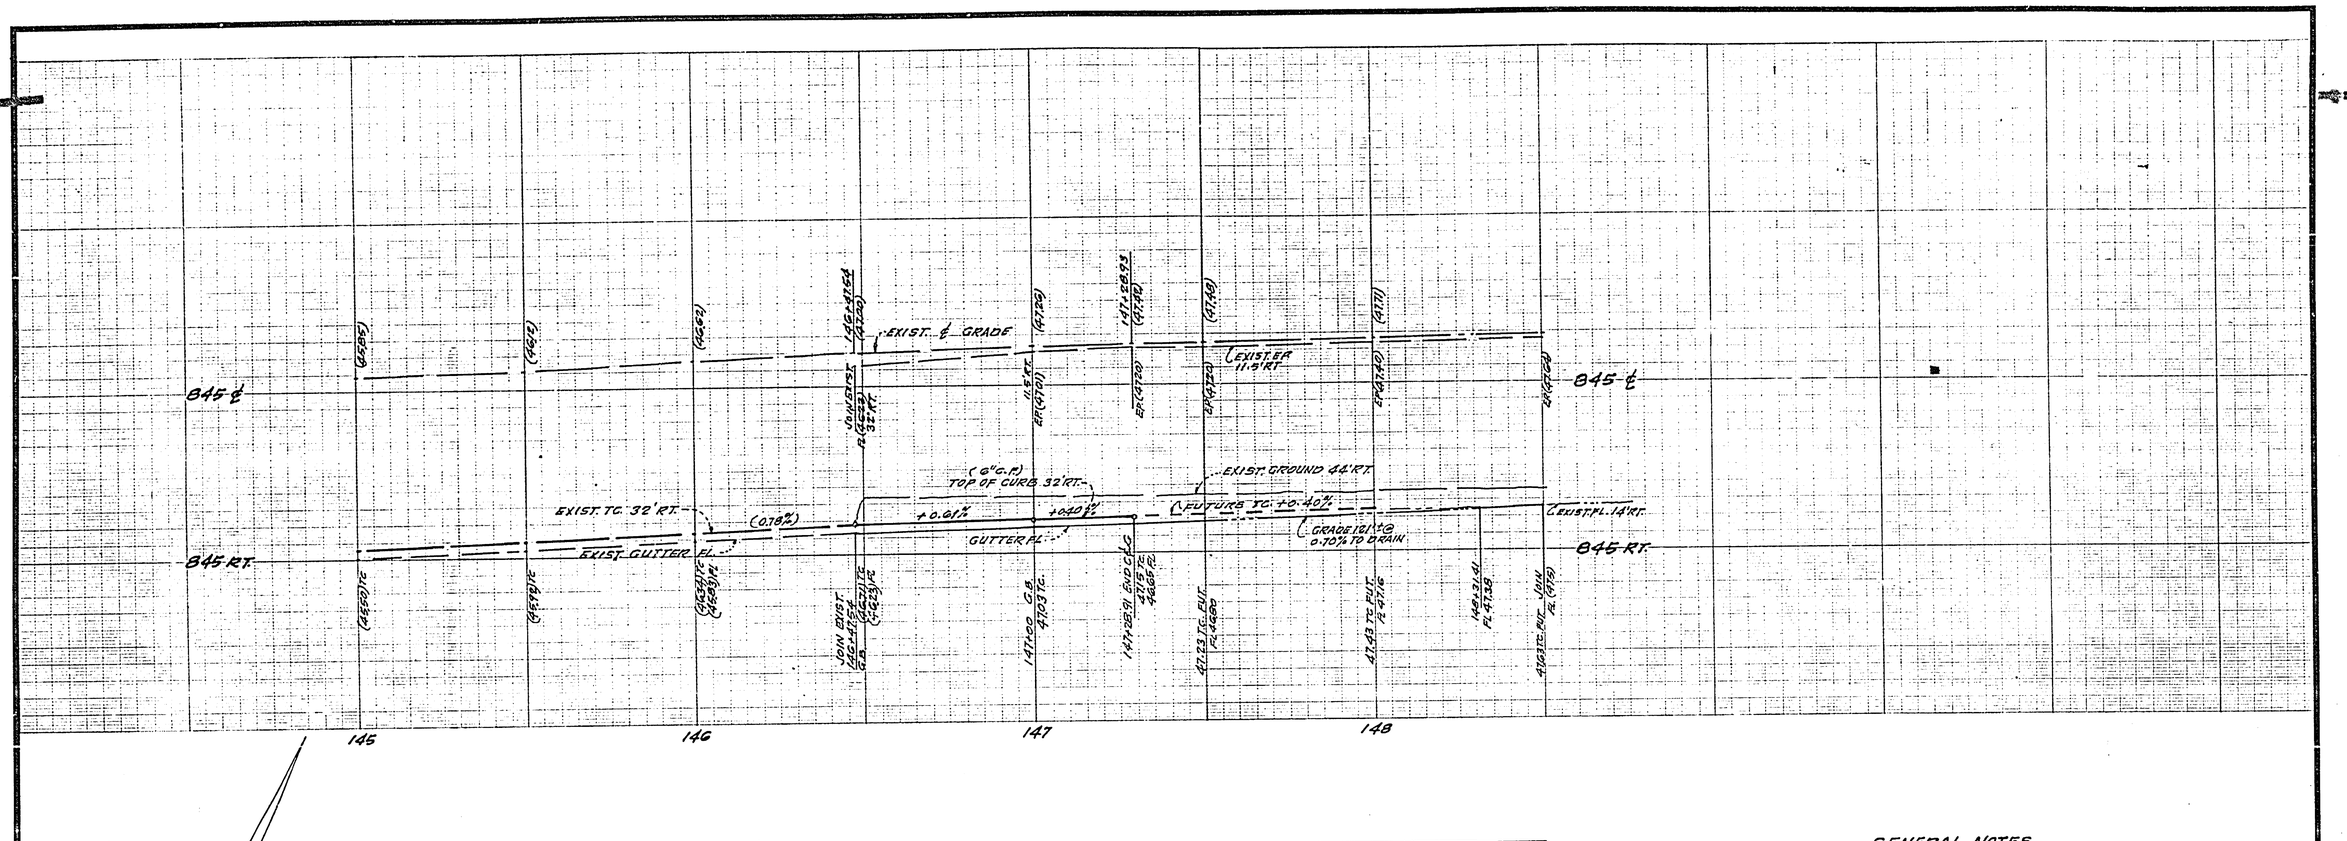

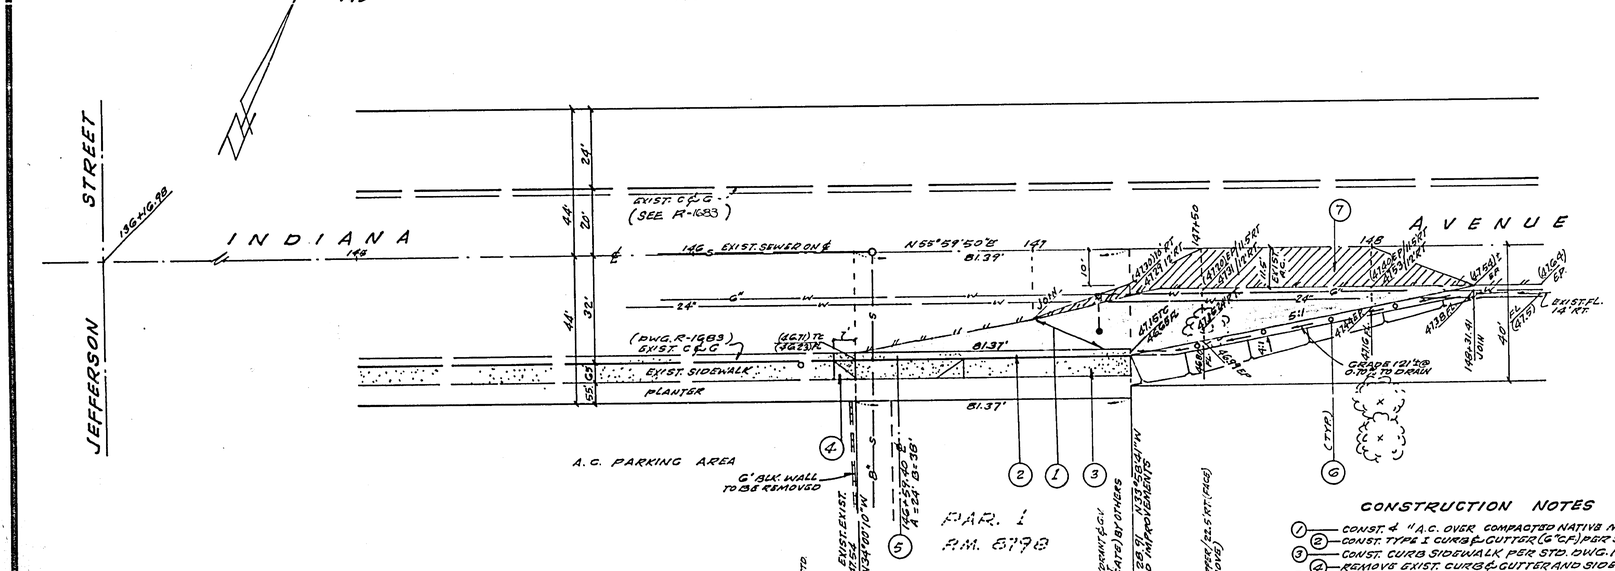

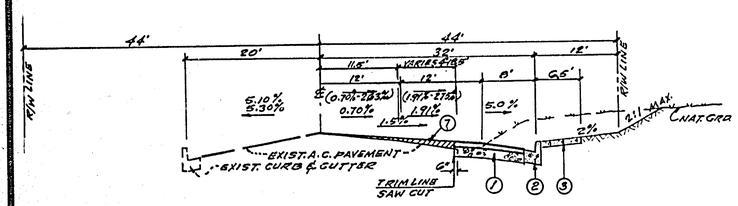

TYPICAL SECTION @ INDIANA AVENUE
SCALE: HORIZ. 1"=10', VERT. 1"=3'
T.I. = 7

GENERAL NOTES

1. CONSTRUCTION SHALL BE IN ACCORDANCE WITH THE CITY OF RIVERSIDE, DEPARTMENT OF PUBLIC WORKS STANDARD DRAWINGS AND PER STANDARD SPECIFICATIONS FOR PUBLIC WORKS CONSTRUCTION, 1976 EDITION.
2. IT SHALL BE THE RESPONSIBILITY OF THE CONTRACTOR TO CLEAR THE RIGHT-OF-WAY IN ACCORDANCE WITH THE PROVISIONS OF LAW AS IT AFFECTS EACH UTILITY INCLUDING IRRIGATION LINES AND APPURTENANCES AND AT NO COST TO THE CITY.
3. TRIM EDGE OF EXISTING PAVEMENT WHERE NEW PAVING JOINS EXISTING PAVEMENT, TO A CLEAN STRAIGHT LINE. CONSTRUCT MATCH-UP PAVING AS SHOWN ON PLAN & OVERLAY AS DIRECTED IN FIELD TO PRODUCE A SMOOTH CROWN SECTION. ENGINEER ESTIMATES OVERLAY TO BE 3.5 TONS.
4. CONSTRUCTION STAKES TO BE 3' BEHIND CURB AT 25' INTERVALS.
5. ~~THE DEVELOPER SHALL ARRANGE FOR A SOILS TEST TO BE MADE BY A SOILS ENGINEER AFTER THE STREETS HAVE BEEN PREPARED TO ROUGH GRADE. DEPTH OF BASE MATERIAL AND A.C. PAVING SHALL BE DETERMINED BY THE CITY OF RIVERSIDE DESIGN STANDARDS AND TEST PROCEDURES.~~
6. ALL FLAGGED ELEVATIONS SHALL BE STAKED IN THE FIELD BY THE PRIVATE ENGINEER.

NOTE:
THE PRIVATE ENGINEER SIGNING THESE PLANS IS RESPONSIBLE FOR THE ACCURACY AND ACCEPTABILITY OF THE WORK HEREON. IN THE EVENT OF DISCREPANCIES ARISING DURING CONSTRUCTION, THE PRIVATE ENGINEER SIGNING SHALL BE RESPONSIBLE FOR DETERMINING AN ACCEPTABLE SOLUTION AND REVISING THE PLANS FOR APPROVAL BY THE CITY.

CONSTRUCTION NOTES

1. CONST. 4" A.C. OVER COMPACTED NATIVE MATERIAL
2. CONST. TYPE I CURB & GUTTER (6" C.F.) PER STD. DWG. Nº 200.
3. CONST. CURB SIDEWALK PER STD. DWG. Nº 325.
4. REMOVE EXIST. CURB & GUTTER AND SIDEWALK, SEE STD. DWG. Nº 303.
5. CONST. TYPE IV DRIVEWAY APPROACH PER STD. DWG. Nº 302
6. INSTALL 4-TYPE "L" GUIDE MARKERS AT 20' O.C.
7. CONST. VARIABLE THICKNESS OVERLAY PAVEMENT FOR SMOOTH JOIN.

BENCH MARK
BRONZE DISC IN CONC. UNDER MONUMENT CAP AT INTERSECTION INDIANA AVE. & JEFFERSON ST.
C.R. BENCH MARK P3-C
ELEV. 837.656

*AS BUILT 8-77- KPT

INDEXED

APPROVED BY
Vicky Hylen 3-11-77
CHIEF UTILITIES ENGINEER, WATER — DATE

HAWKINS, ROBERTSON & ASSOC.
ENGINEERS & SURVEYORS
RIVERSIDE CALIFORNIA
Charles E. Robertson 10/29/76
R.C.E. 15016 — DATE

MARK	REVISIONS	APPR.	DATE

DESIGNED BY G.H. DRAWN BY G.H. CHECKED BY BM

CITY OF RIVERSIDE, CALIFORNIA
DEPARTMENT OF PUBLIC WORKS

	BY	DATE
APPROVED BY		
OFFICE ENGINEER		3-24
PARK DEPARTMENT		3-24
TRAFFIC DIVISION		3-24
ASSISTANT CITY ENG.		4-5

APPROVED BY
DIRECTOR OF PUBLIC WORKS
DATE 4-5-77

STREET PLAN & PROFILE
SE'LY. SIDE, NE'LY. OF JEFFERSON.
INDIANA AVENUE
146+47.54 TO 147+28.93
P.M. 8798 & R-4-766.

HORIZ. SCALE: 1" = 20' VERT. SCALE: 1" = 4'

PROJECT NO. R-1963
SHEET 1 OF 1
FILE NO. 76-2674