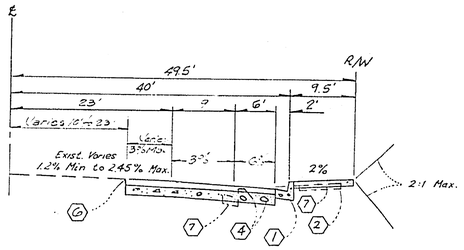

TYPICAL SECTION

UNIVERSITY AVENUE

NO SCALE

T.I. = 7.5

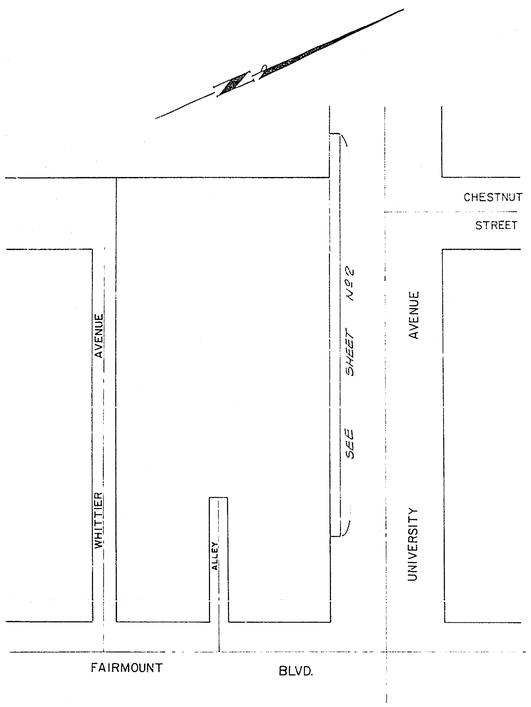

INDEX MAP

NO SCALE

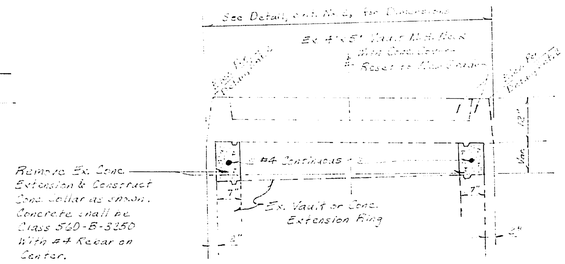

DETAIL-RESET VAULT COVER

NOT TO SCALE

GENERAL NOTES

1. Construction shall be in accordance with the Standard Specifications for Public Works Construction 1976 Edition and per City of Riverside Standard Drawings.
2. All flagged elevations shall be staked in the field by the Engineer.
3. Curb and Gutter to be staked at a 3' offset and at 25' intervals, except when grade is less than 0.35% - Curb to be staked at 12.5' intervals and 2 rows of #3 rebar placed in the gutter. 3/4' steel dowels pins shall be placed at all expansion joints.
4. Trim edge of existing paving to a smooth straight line where new pavement joins. Construct match up paving as shown on plan and overlay paving as directed in the field to produce a smooth section.
5. It shall be the responsibility of the contractor to clear the right of way in accordance with the provisions of the law as it affects each utility including irrigation lines and at no cost to the city.
6. Area to be cleared of all existing structures, trees, Fences, Paving, Curb & Gutter, Sidewalk, etc. to provide for the new construction.
7. Prior to any demolition, contact City of Riverside Water Services Department (787-7442) and request meter service lateral removal for each individual service.
8. Palm trees indicated to be relocated will be placed on-site in accordance with the architect's site plans.
9. Notify City of Riverside Power Systems, phone no. (714) 787-7422, at least 24 hours prior to any work done on Vault as shown on this plan.

CONSTRUCTION NOTES

1. Construct Curb and Gutter per standard 200 (cf. as shown)
2. Construct Sidewalk per Standard 325. Width as shown.
3. Remove Existing Pavement or Concrete
4. * Construct 0.35' A.C. Paving over 0.90' D.G. Base.
5. Existing Facilities To Be Relocated
6. Saw Cut Existing Pavement or Concrete
7. Remove existing curb and gutter, sidewalk, etc.
8. Construct Tree Wells per Standard 327.
9. Construct Concrete Driveway (as shown)

BENCH MARK

Fd. brass disk stamped (16-E) capped on center line 7th Street 10' E'ly of centerline Redwood Drive.
F.B. 735/50. Elevation: 842.996

NOTE:

The Private Engineer Signing These Plans Is Responsible For Assuring The Accuracy And Acceptability Of The Work Hereon. In The Event Of Discrepancies Arising During Construction As A Result Of Error Or Omissions, The Private Engineer Shall Be Responsible For Determining An Acceptable Solution And Revising The Plans For Approval By The City.

*AS BUILT 6-77 KPT

INDEXED R.S.

PSOMAS AND ASSOCIATES
1617 PONTIUS AVENUE
LOS ANGELES, CALIF. 90025

APPROVED BY David W. Wirth DATE 6-13-77
R.C.E. NO. 20228

W.O. 77245 FOR: F.B.

MARK	REVISIONS	APPR.	DATE

DESIGNED BY G.P. DRAWN BY T.G.B. CHKD. BY G.P.

CITY OF RIVERSIDE, CALIFORNIA
PUBLIC WORKS DEPARTMENT

APPROVED BY	BY	DATE
PRINCIPAL ENGINEER		
PARK DEPARTMENT		6-77
TRAFFIC DIVISION		12-13
CHIEF PUB. WKS. ENGR.		12-20

APPROVED BY Robert Clarke
DIRECTOR OF PUBLIC WORKS
DATE 12/20/77

STREET PLAN AND PROFILE

PM 8904
INDEX

UNIVERSITY AVE — CHESTNUT ST 400' EAST

SCALE None

ACCOUNT NO.
DRAWING NO. R-2005
SHEET 1 OF 2

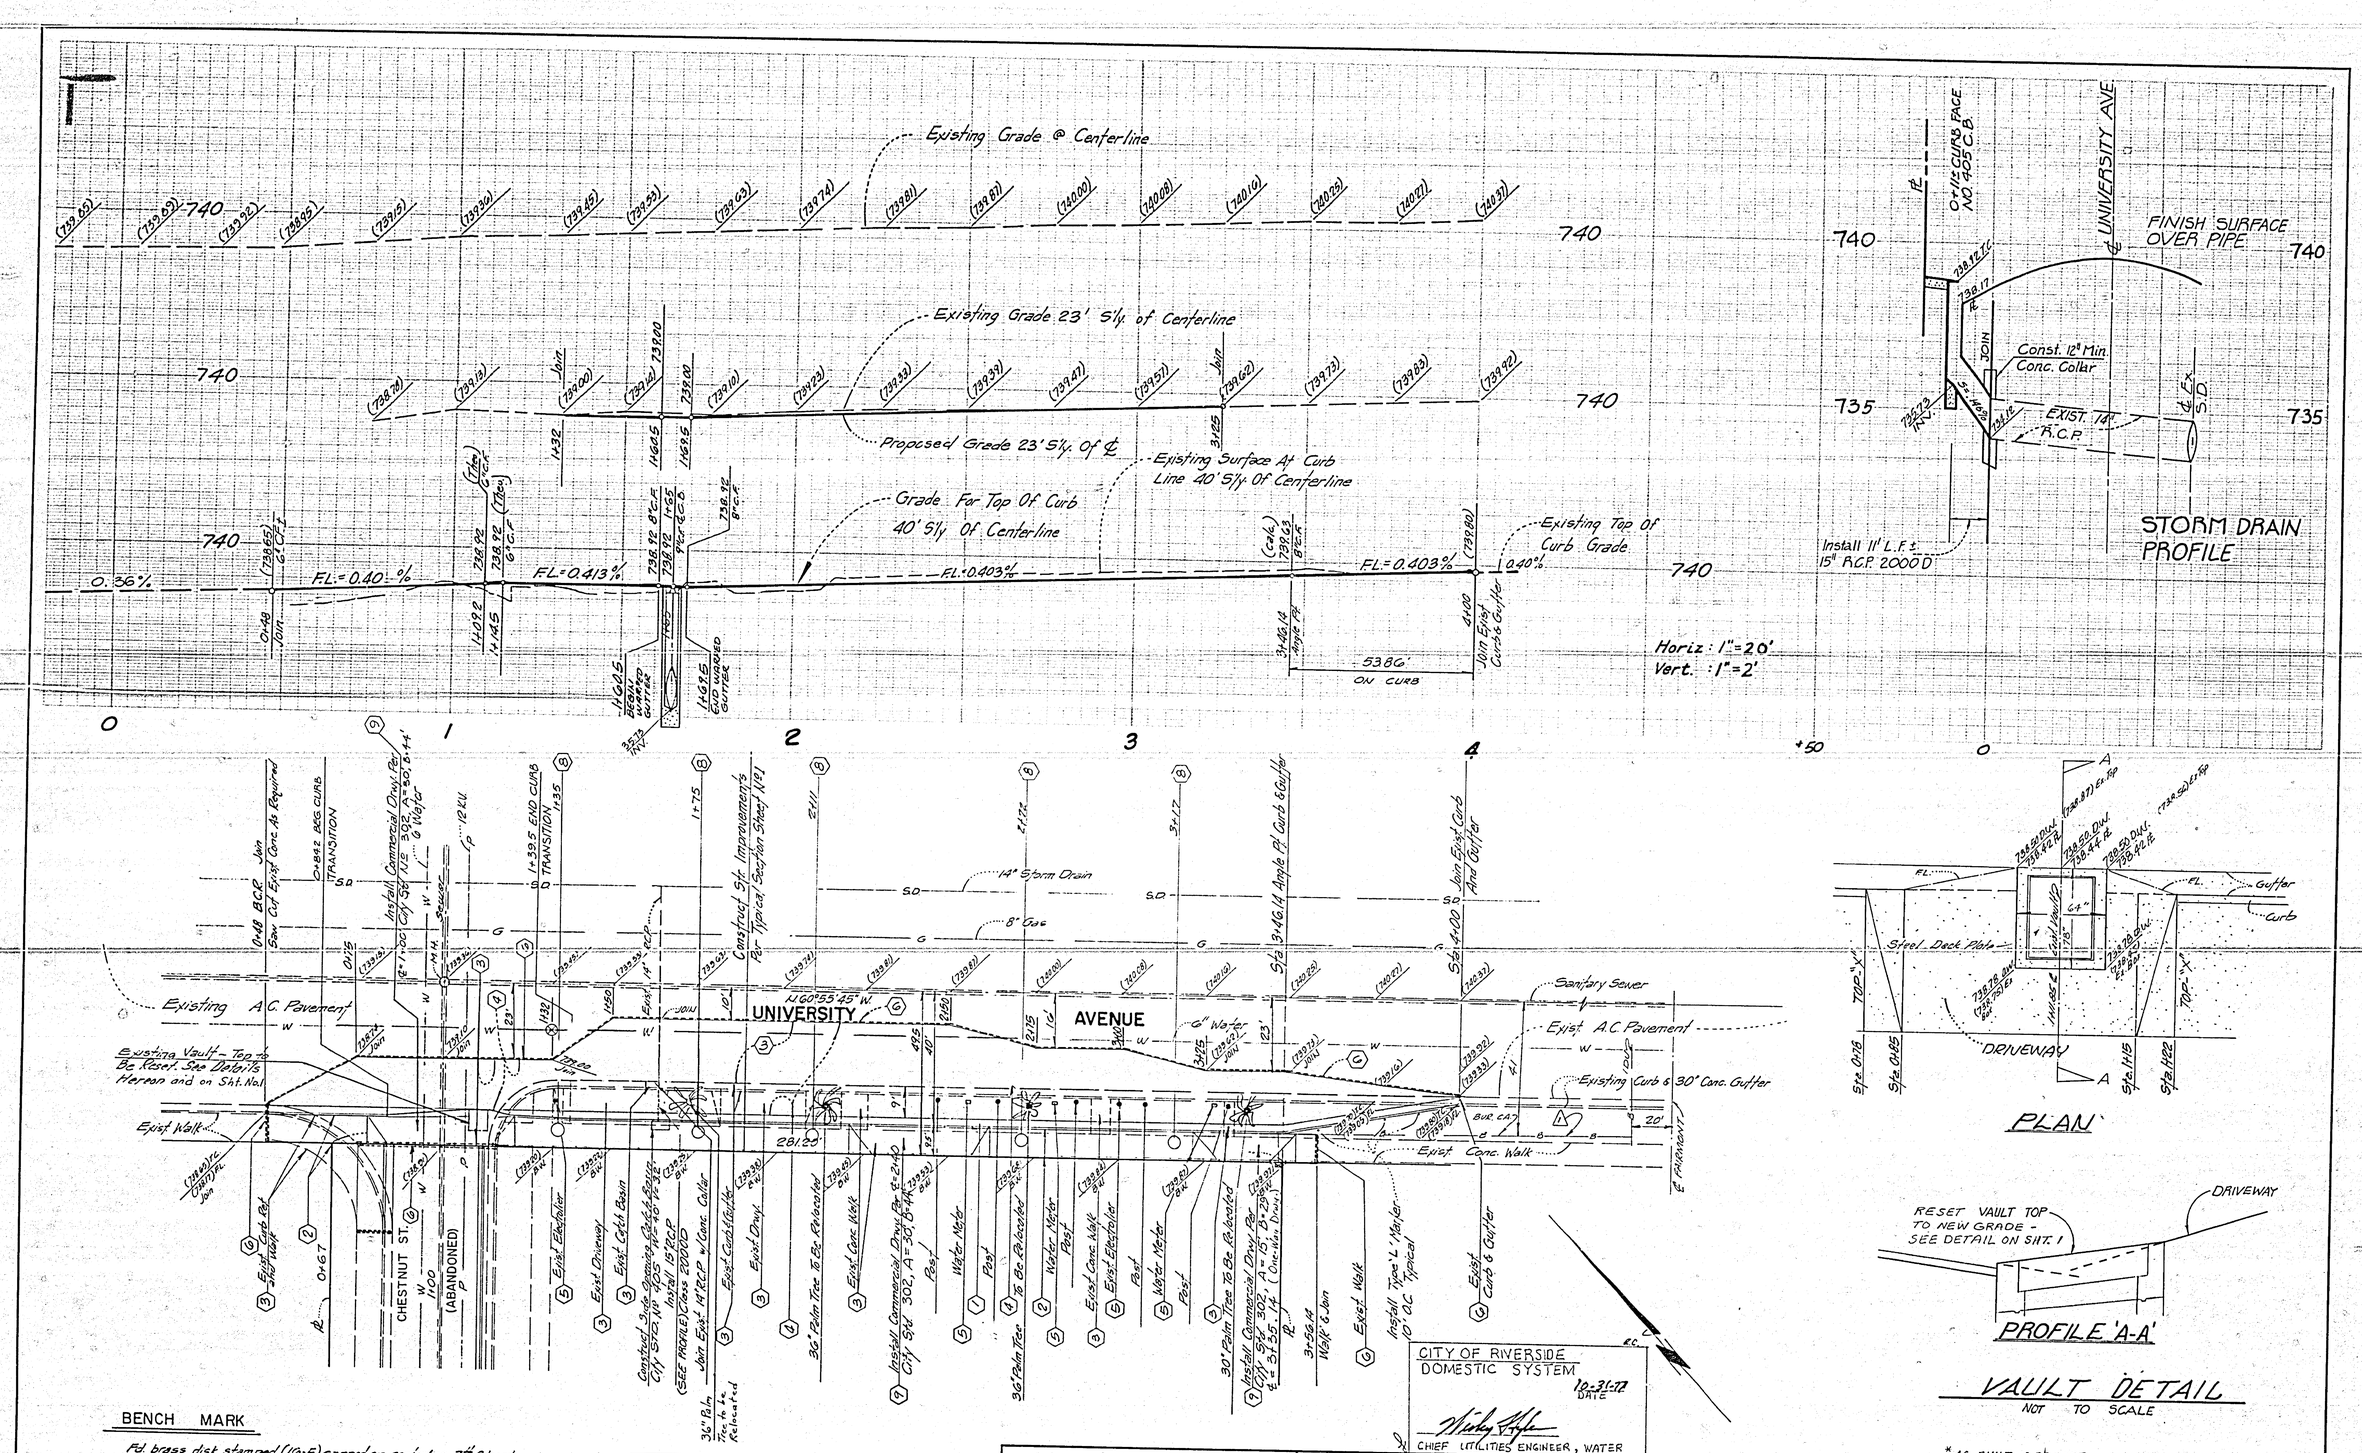

BENCH MARK

Fd brass disk stamped (10-E) capped at centerline 7th Street 10' E'ly of centerline Redwood Drive.

FB. 73550 Elevation: 842.996

CITY OF RIVERSIDE
DOMESTIC SYSTEM
10-31-72
DATE
CHIEF UTILITIES ENGINEER, WATER

CITY OF RIVERSIDE
11/24/77
DATE
CHIEF UTILITIES ENGR., POWER

REDEV. AGENCY

PSOMAS AND ASSOCIATES
1617 PONTIUS AVENUE
LOS ANGELES, CALIF. 90025

APPROVED BY _____ DATE 6-13-77
R.C.E. NO. 20228

W.O. 77245 FOR: F.B.

MARK	REVISIONS	APPR.	DATE
1	ADDED PACIFIC TELEPHONE GABLE		1-13-78

DESIGNED BY G.P. DRAWN BY T.C.B. CHKD. BY G.P.

CITY OF RIVERSIDE, CALIFORNIA
PUBLIC WORKS DEPARTMENT

APPROVED BY	BY	DATE
PRINCIPAL ENGINEER		
PARK DEPARTMENT		10-17
TRAFFIC DIVISION		12-13
CHIEF PUB WKS ENGR.		12-20

APPROVED BY _____
DIRECTOR OF PUBLIC WORKS
DATE 12/20/77

STREET PLAN AND PROFILE

PM 8904
UNIVERSITY AVENUE
CHESTNUT ST TO 400' EAST

SCALE: Horiz: 1"=20' Vert: 1"=2'

*AS BUILT 8-78 KPT

INDEXED R.R.

ACCOUNT NO.
DRAWING NO. R-2005
SHEET 2 OF 2