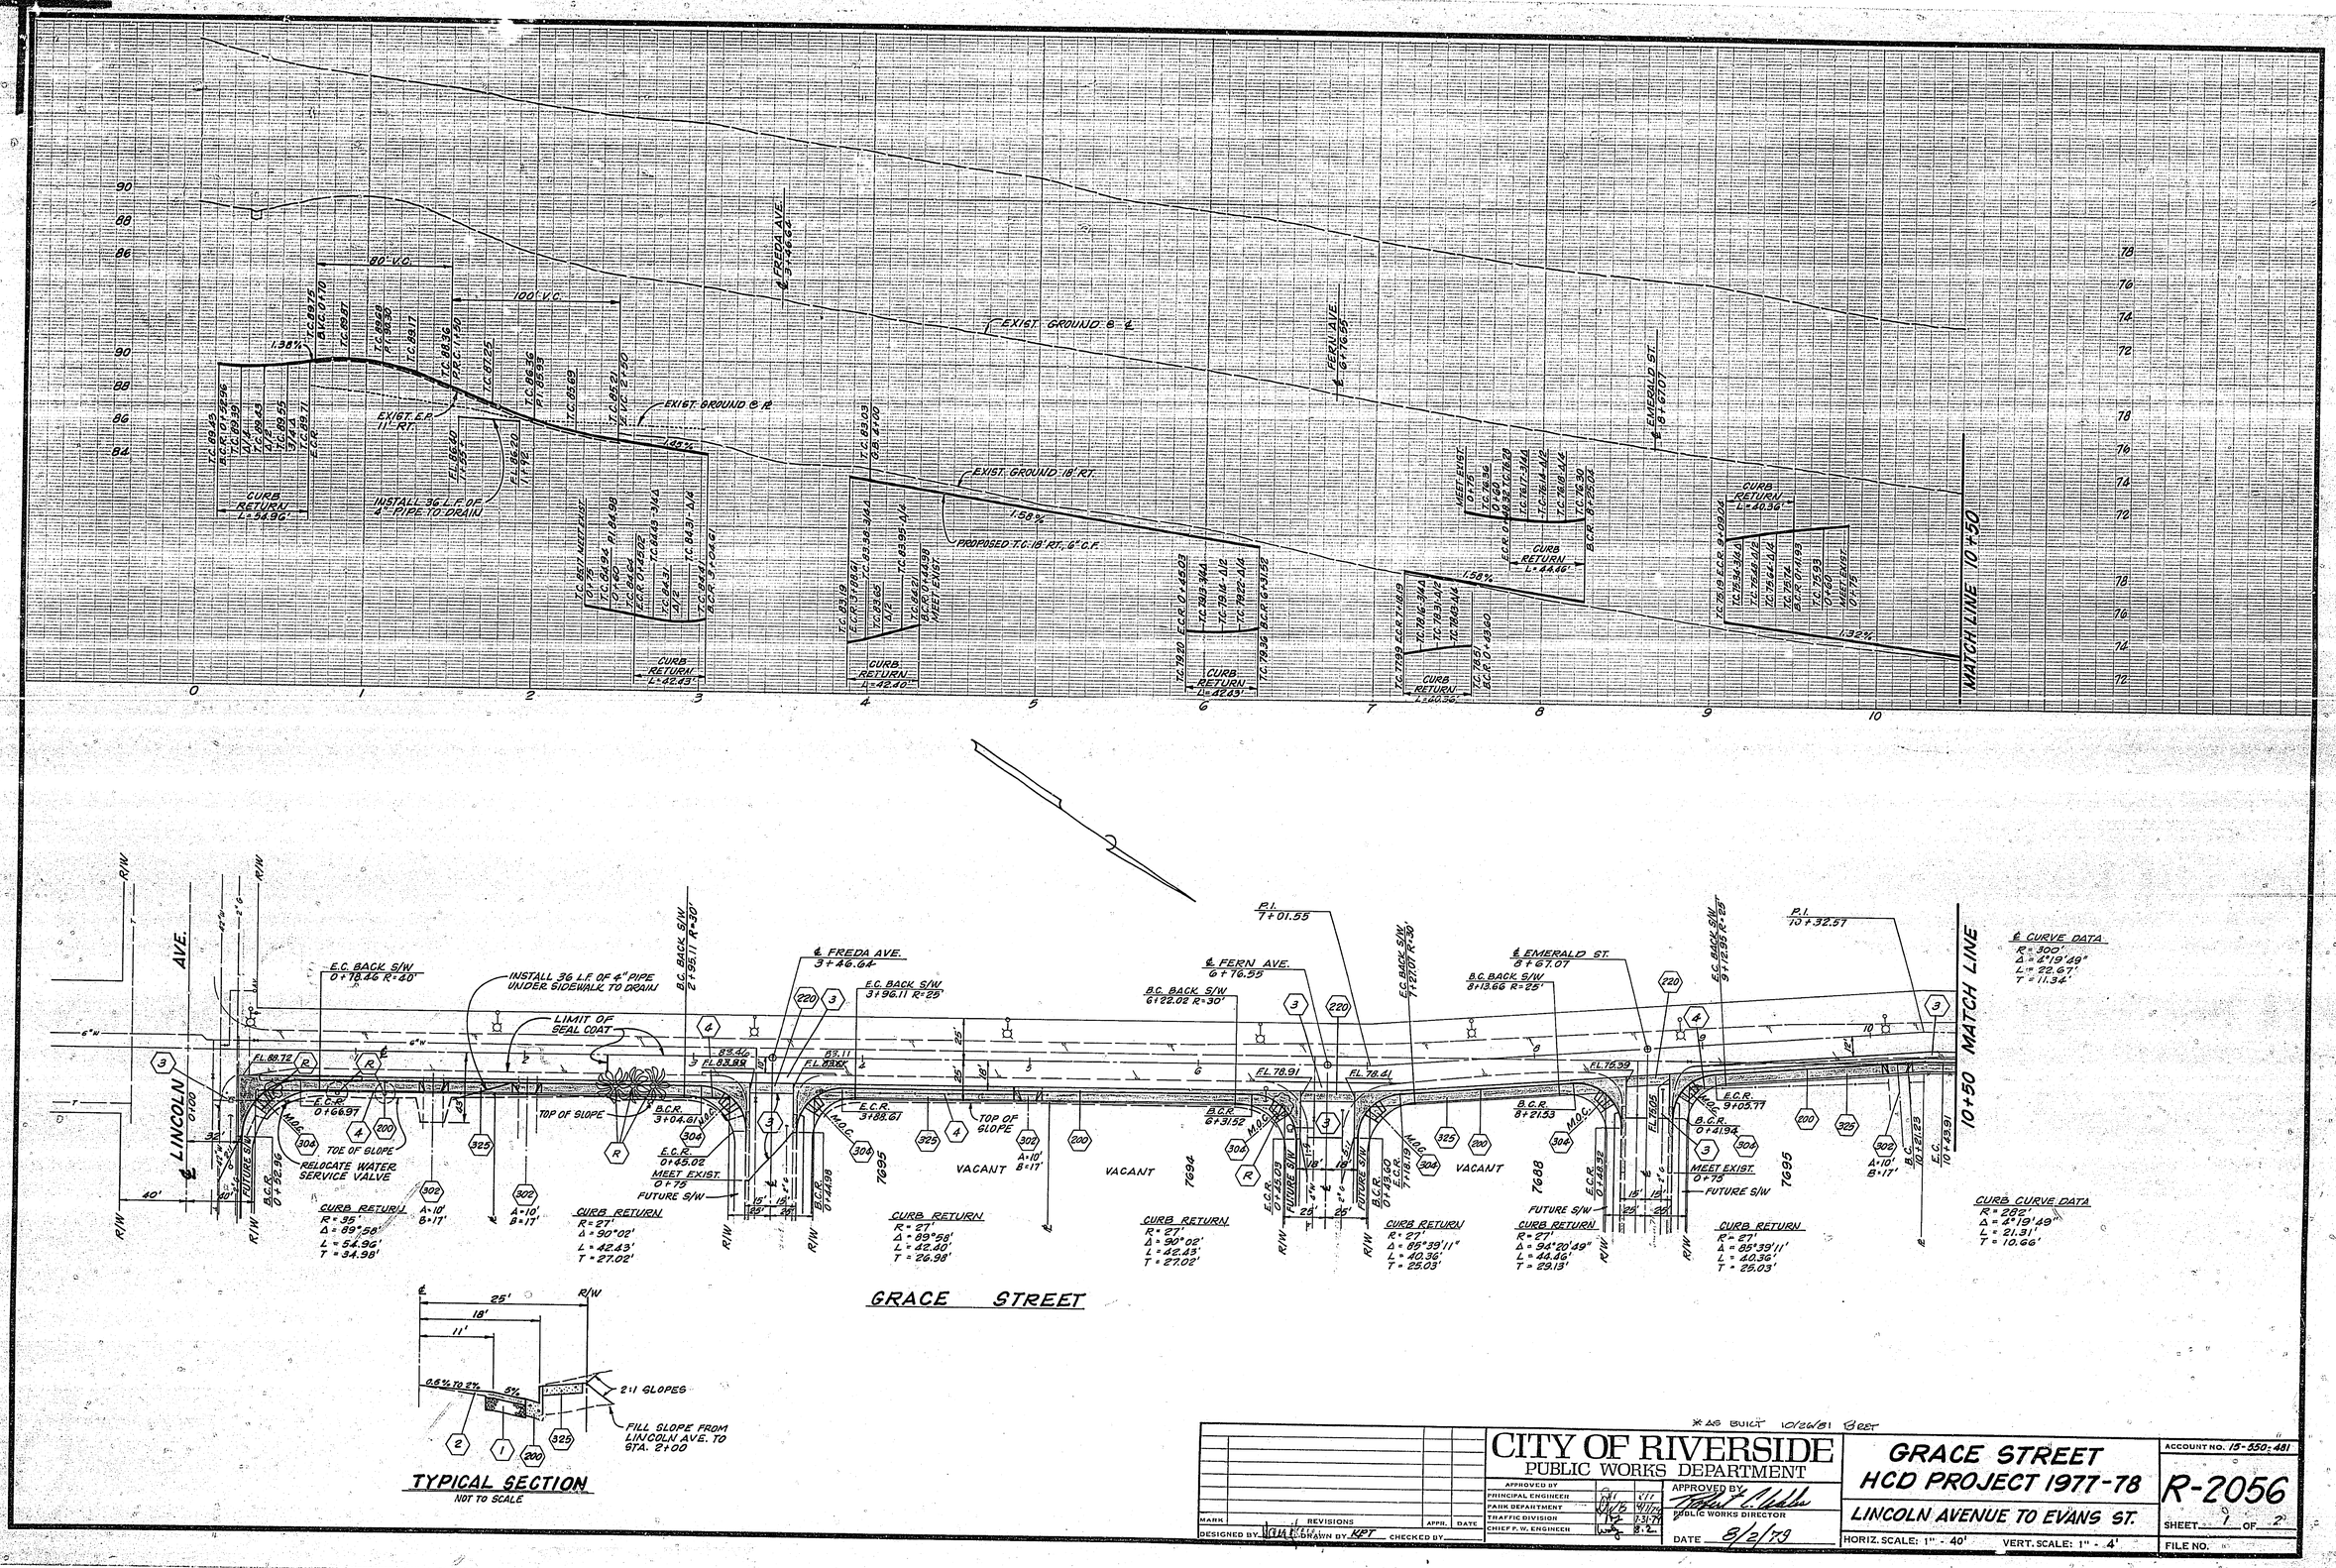

*AS BUILT 10/26/81 BRET

MARK	REVISIONS	APPR.	DATE
DESIGNED BY	DRAWN BY KPT	CHECKED BY	

CITY OF RIVERSIDE
PUBLIC WORKS DEPARTMENT

APPROVED BY		
PRINCIPAL ENGINEER		
PARK DEPARTMENT		4/1/79
TRAFFIC DIVISION		7-31-79
CHIEF P.W. ENGINEER		8.2

APPROVED BY [signature]
PUBLIC WORKS DIRECTOR
DATE 8/2/79

GRACE STREET
HCD PROJECT 1977-78
LINCOLN AVENUE TO EVANS ST.
HORIZ. SCALE: 1" - 40' VERT. SCALE: 1" - 4'

ACCOUNT NO. 15-550-481
R-2056
SHEET 1 OF 2
FILE NO.

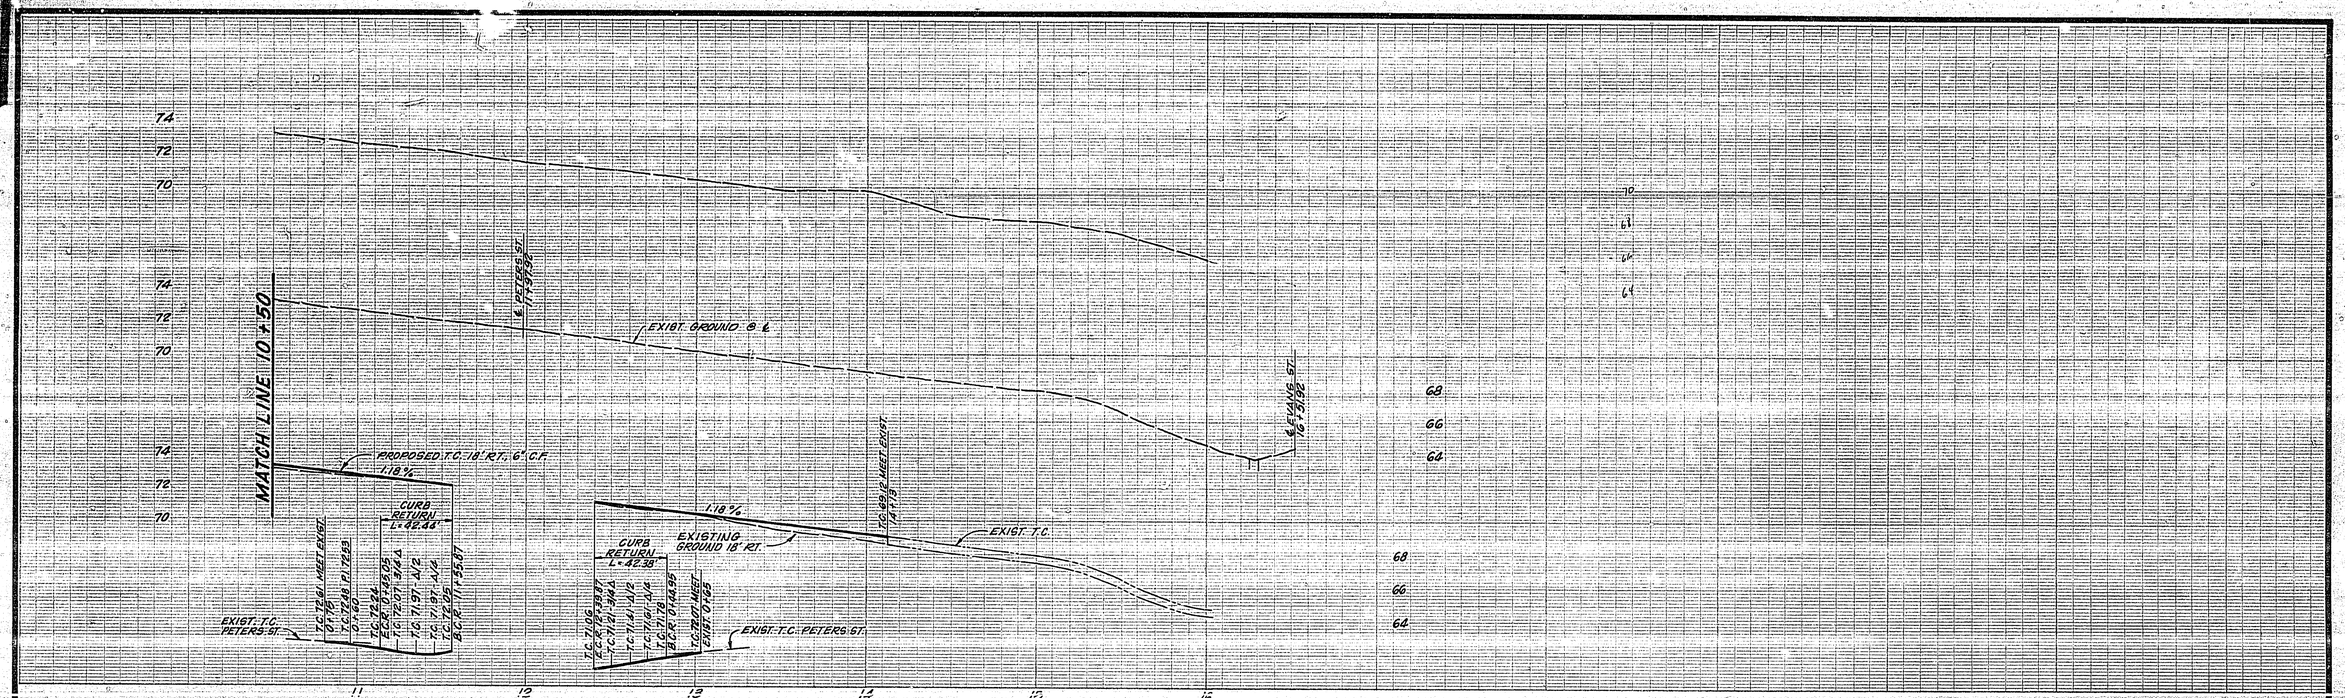

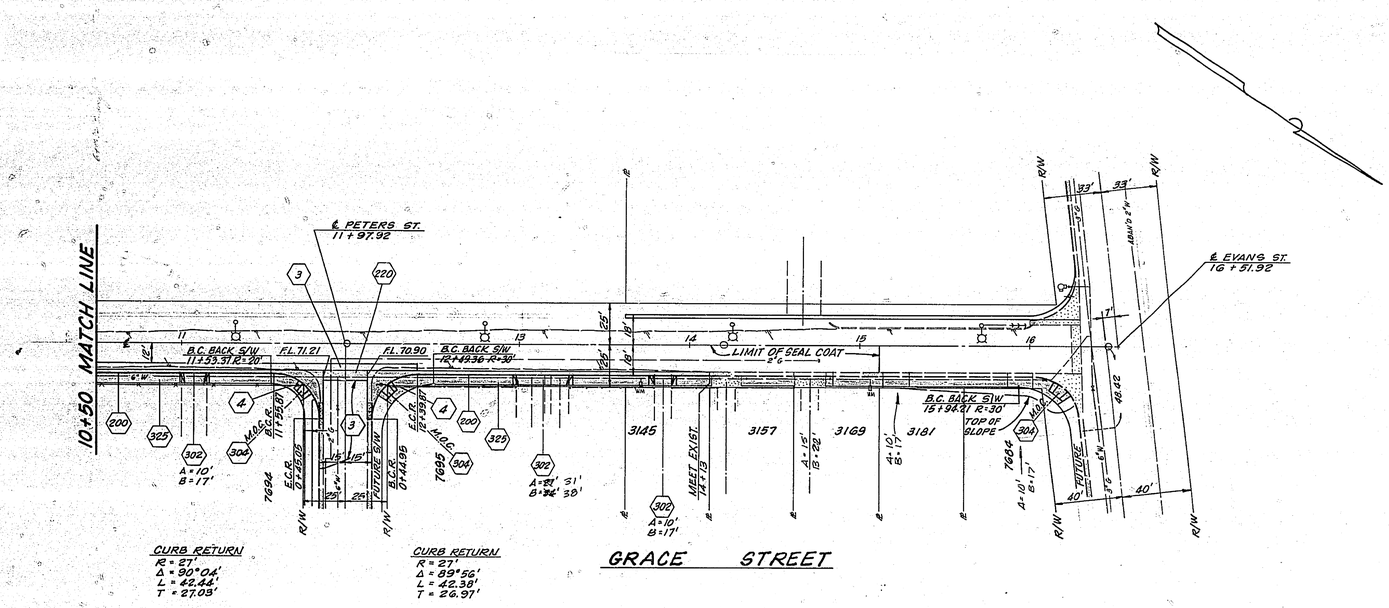

CONSTRUCTION NOTES

1. CONSTRUCTION SHALL BE IN ACCORDANCE WITH STANDARD SPECIFICATIONS FOR PUBLIC WORKS CONSTRUCTION AND CITY OF RIVERSIDE STANDARD DRAWINGS.
2. STREET NAME SIGNS WHICH REQUIRE RELOCATION SHALL BE SET PER STD. DWG. NO. 662A, TRAFFIC SIGNS PER STD. DWG. NO. 666.

CONSTRUCTION LEGEND

- (1) CONST. 2½" A.C. PAVEMENT OVER 4" D.G. BASE.
- (2) CONST. VARIABLE THICKNESS A.C. OVERLAY. ALL NEW PAVEMENT AND A.C. OVERLAY TO GET A SEAL COAT.
- (R) REMOVE ENTIRE TREE.
- (200) CONST. CURB & GUTTER PER STD. DWG. NO. 200.
- (220) CONST. CROSS GUTTER PER STD. DWG. NO. 220.
- (302) CONST. DRIVEWAY APPROACH PER STD DWG. NO. 302.
- (325) CONST. SIDEWALK PER STD. DWG. NO. 325.
- (304) CONST. WHEELCHAIR RAMP PER STD. DWG. NO. 304
- (3) REPLACE A.C. PAVEMENT. ON LINCOLN AVE. USE 4" A.C. OVER 10" D.G. BASE, OTHER SIDE STREETS 2½" A.C. OVER 4" D.G. BASE.
- (4) CONTRACTOR TO RELOCATE FENCE.

* as built 10/26/81 [illegible]

MARK	REVISIONS	APPR.	DATE

DESIGNED BY [illegible] DRAWN BY KPT CHECKED BY

CITY OF RIVERSIDE
PUBLIC WORKS DEPARTMENT

APPROVED BY		
PRINCIPAL ENGINEER	[illegible]	7/1
PARK DEPARTMENT	[illegible]	8/1/79
TRAFFIC DIVISION	[illegible]	7-31-79
CHIEF F.W. ENGINEER	[illegible]	8-2

APPROVED BY [illegible]
PUBLIC WORKS DIRECTOR
DATE 8/2/79

GRACE STREET
HCD PROJECT 1977-78
LINCOLN AVENUE TO EVANS ST.

HORIZ. SCALE: 1" - 40' VERT. SCALE: 1" - 4'

ACCOUNT NO. 15-550-481
R-2056
SHEET 2 OF 2
FILE NO.

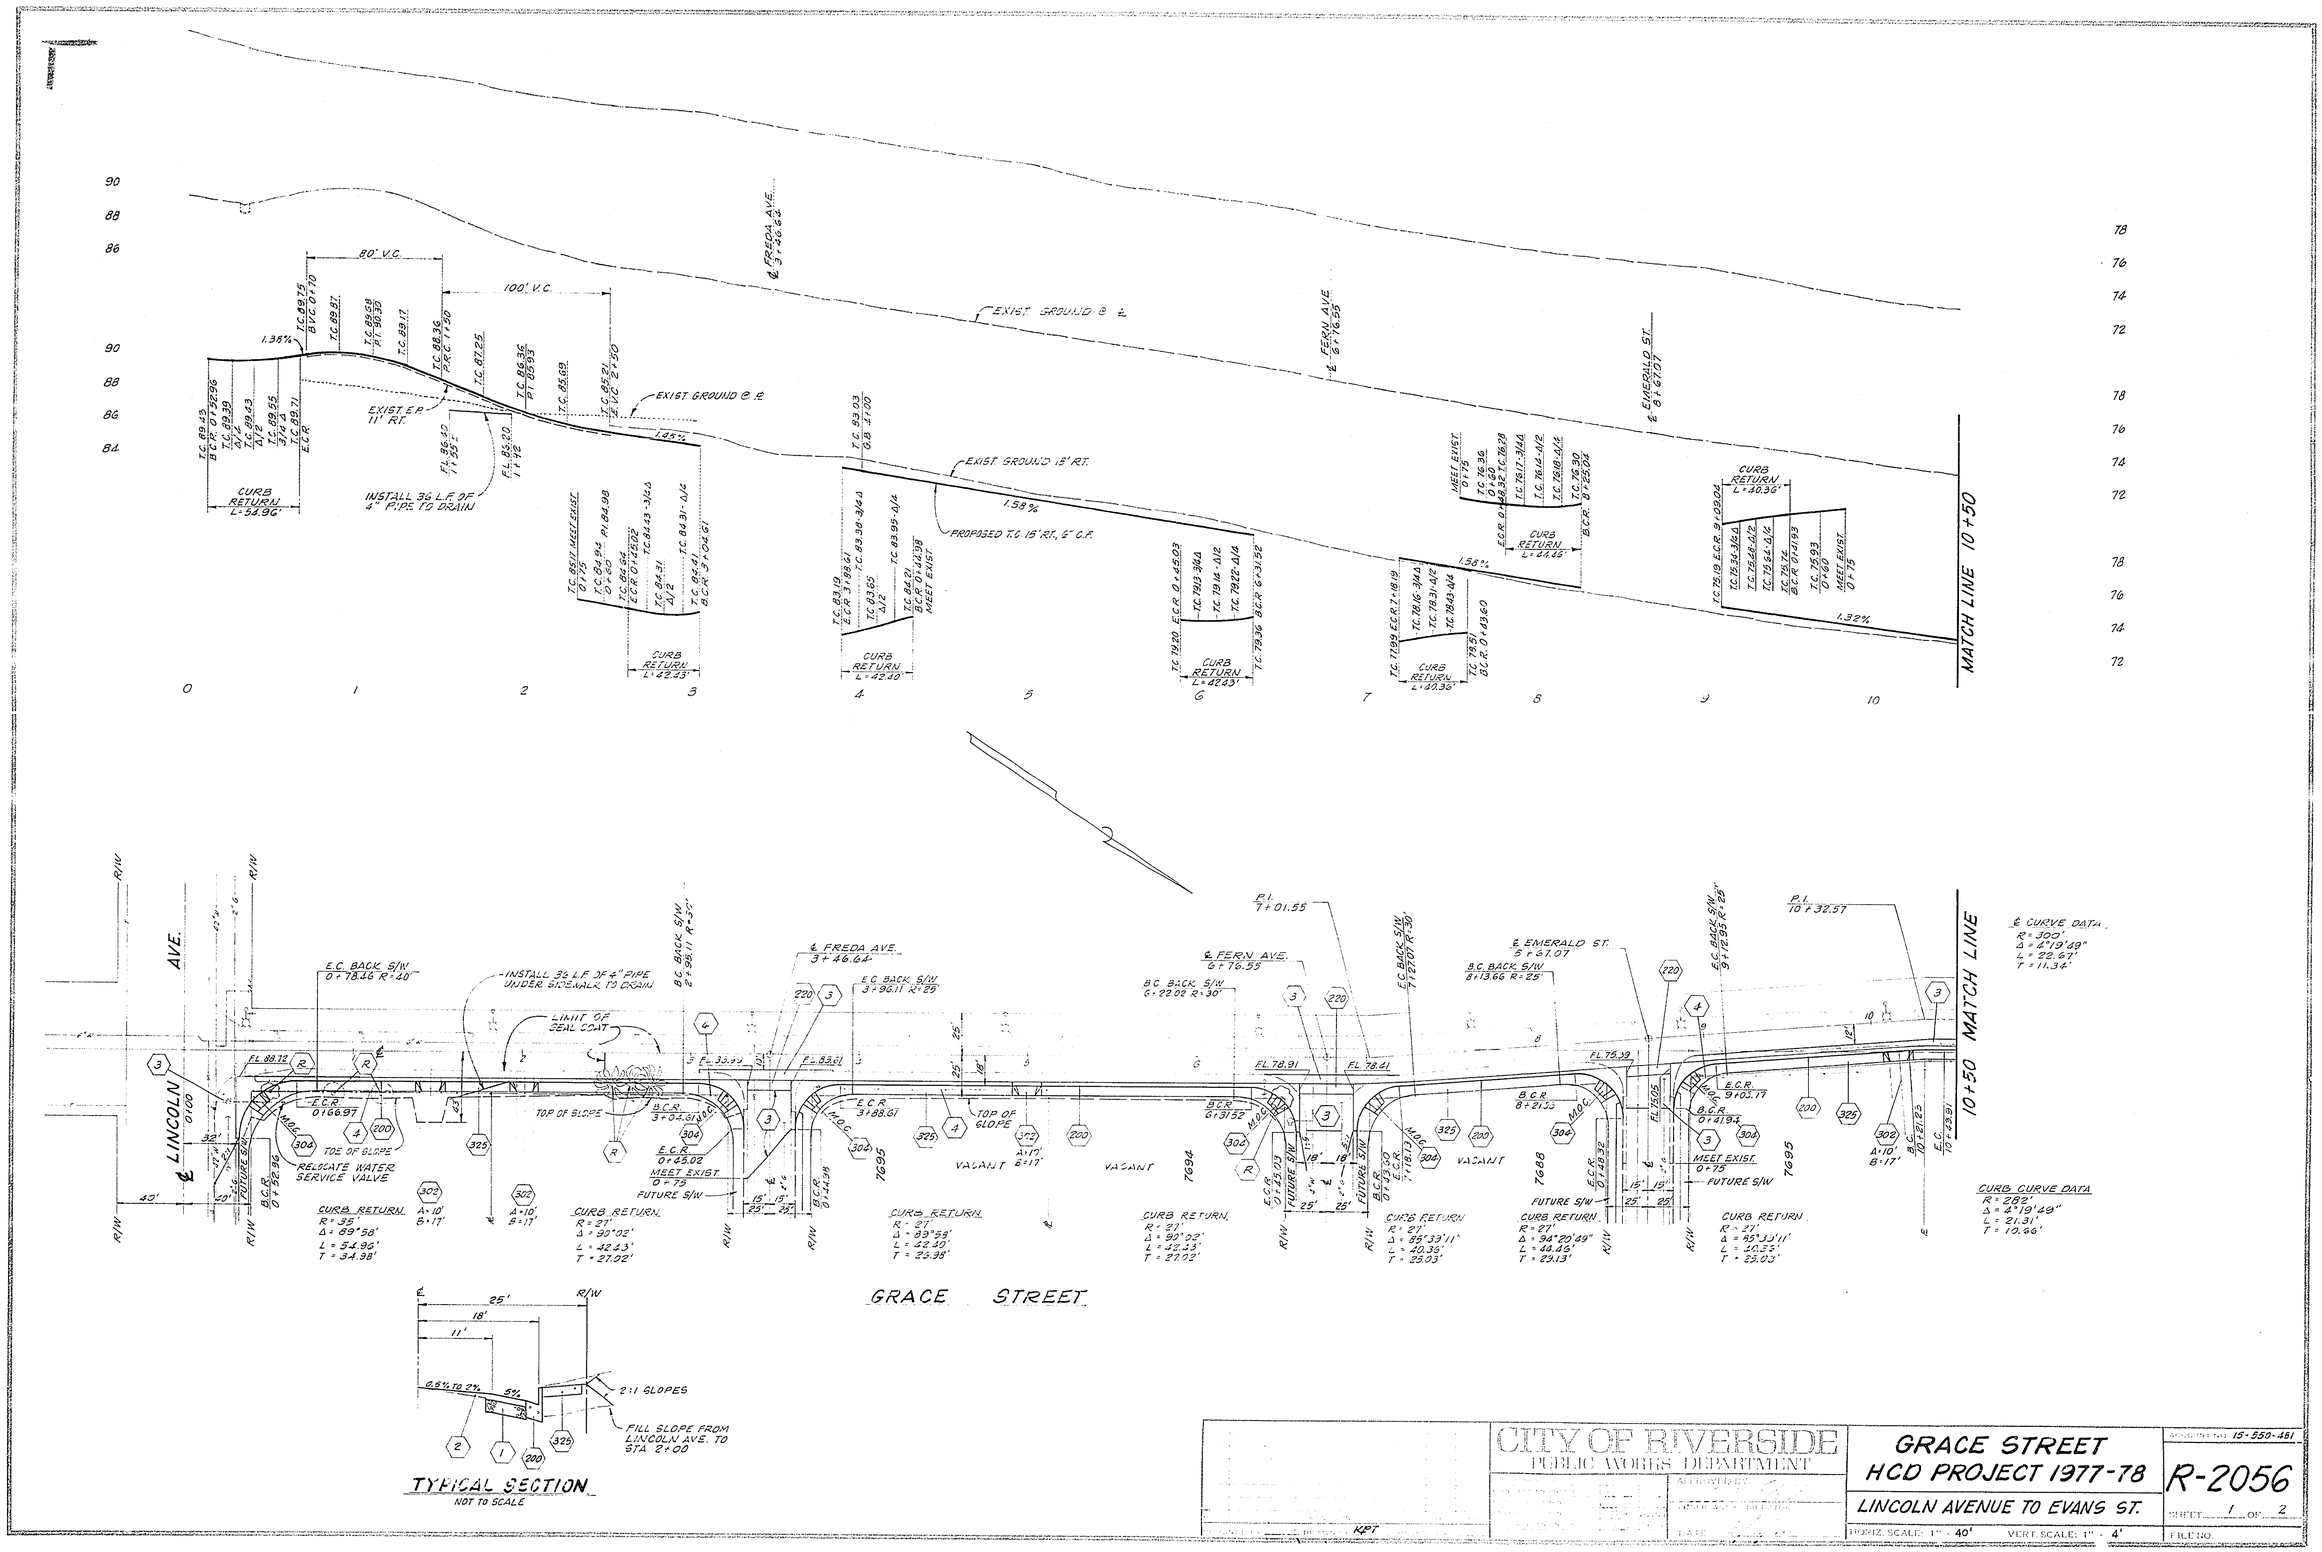

CITY OF RIVERSIDE
PUBLIC WORKS DEPARTMENT

APPROVED BY

DATE

KPT

GRACE STREET
HCD PROJECT 1977-78

LINCOLN AVENUE TO EVANS ST.

HORIZ. SCALE: 1" = 40' VERT. SCALE: 1" = 4'

ASSIGNMENT NO. 15-550-481

R-2056

SHEET 1 OF 2

FILE NO.

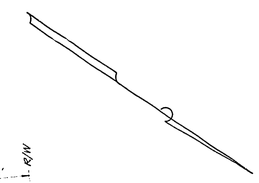

CONSTRUCTION NOTES

1. CONSTRUCTION SHALL BE IN ACCORDANCE WITH STANDARD SPECIFICATIONS FOR PUBLIC WORKS CONSTRUCTION AND CITY OF RIVERSIDE STANDARD DRAWINGS.
2. STREET NAME SIGNS WHICH REQUIRE RELOCATION SHALL BE SET PER STD. DWG. NO. 662A, TRAFFIC SIGNS PER STD. DWG. NO. 666.

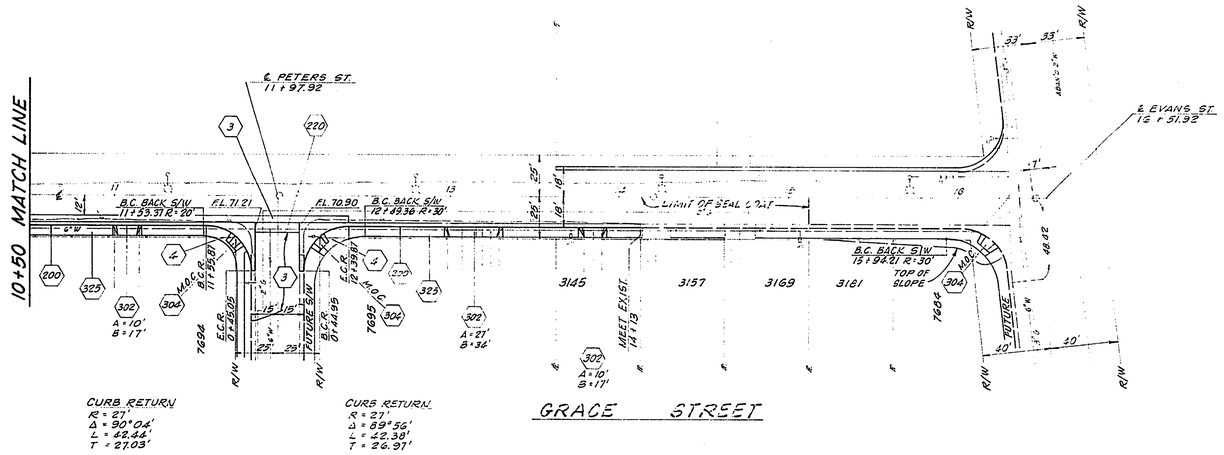

CURB RETURN
R = 27'
Δ = 90°04'
L = 42.44'
T = 27.03'

CURB RETURN
R = 27'
Δ = 89°56'
L = 42.38'
T = 26.97'

CONSTRUCTION LEGEND

- (1) CONST. 2½" A.C. PAVEMENT OVER 4" D.G. BASE.
- (2) CONST. VARIABLE THICKNESS A.C. OVERLAY. ALL NEW PAVEMENT AND A.C. OVERLAY TO GET A SEAL COAT.
- (R) REMOVE ENTIRE TREE.
- (200) CONST. CURB & GUTTER PER STD. DWG. NO. 200.
- (220) CONST. CROSS GUTTER PER STD. DWG. NO. 220.
- (302) CONST. DRIVEWAY APPROACH PER STD DWG. NO. 302.
- (325) CONST. SIDEWALK PER STD. DWG. NO. 325.
- (304) CONST. WHEELCHAIR RAMP PER STD. DWG. NO. 304.
- (3) REPLACE A.C. PAVEMENT. IN LINCOLN AVE. USE 4" A.C. OVER 10" D.G. BASE, OTHER SIDE STREETS 2½" A.C. OVER 4" D.G. BASE.
- (4) CONTRACTOR TO RELOCATE FENCE.

RPT	CITY OF RIVERSIDE PUBLIC WORKS DEPARTMENT TRAFFIC ENGINEER	APPROVED BY PUBLIC WORKS DIRECTOR DATE 5/6/78	GRACE STREET HCD PROJECT 1977-78 LINCOLN AVENUE TO EVANS ST. HORIZ. SCALE: 1" = 40' VERT. SCALE: 1" = 4'

ACCOUNT NO. 15-550-481

R-2056

SHEET 2 OF 2

FILE NO.