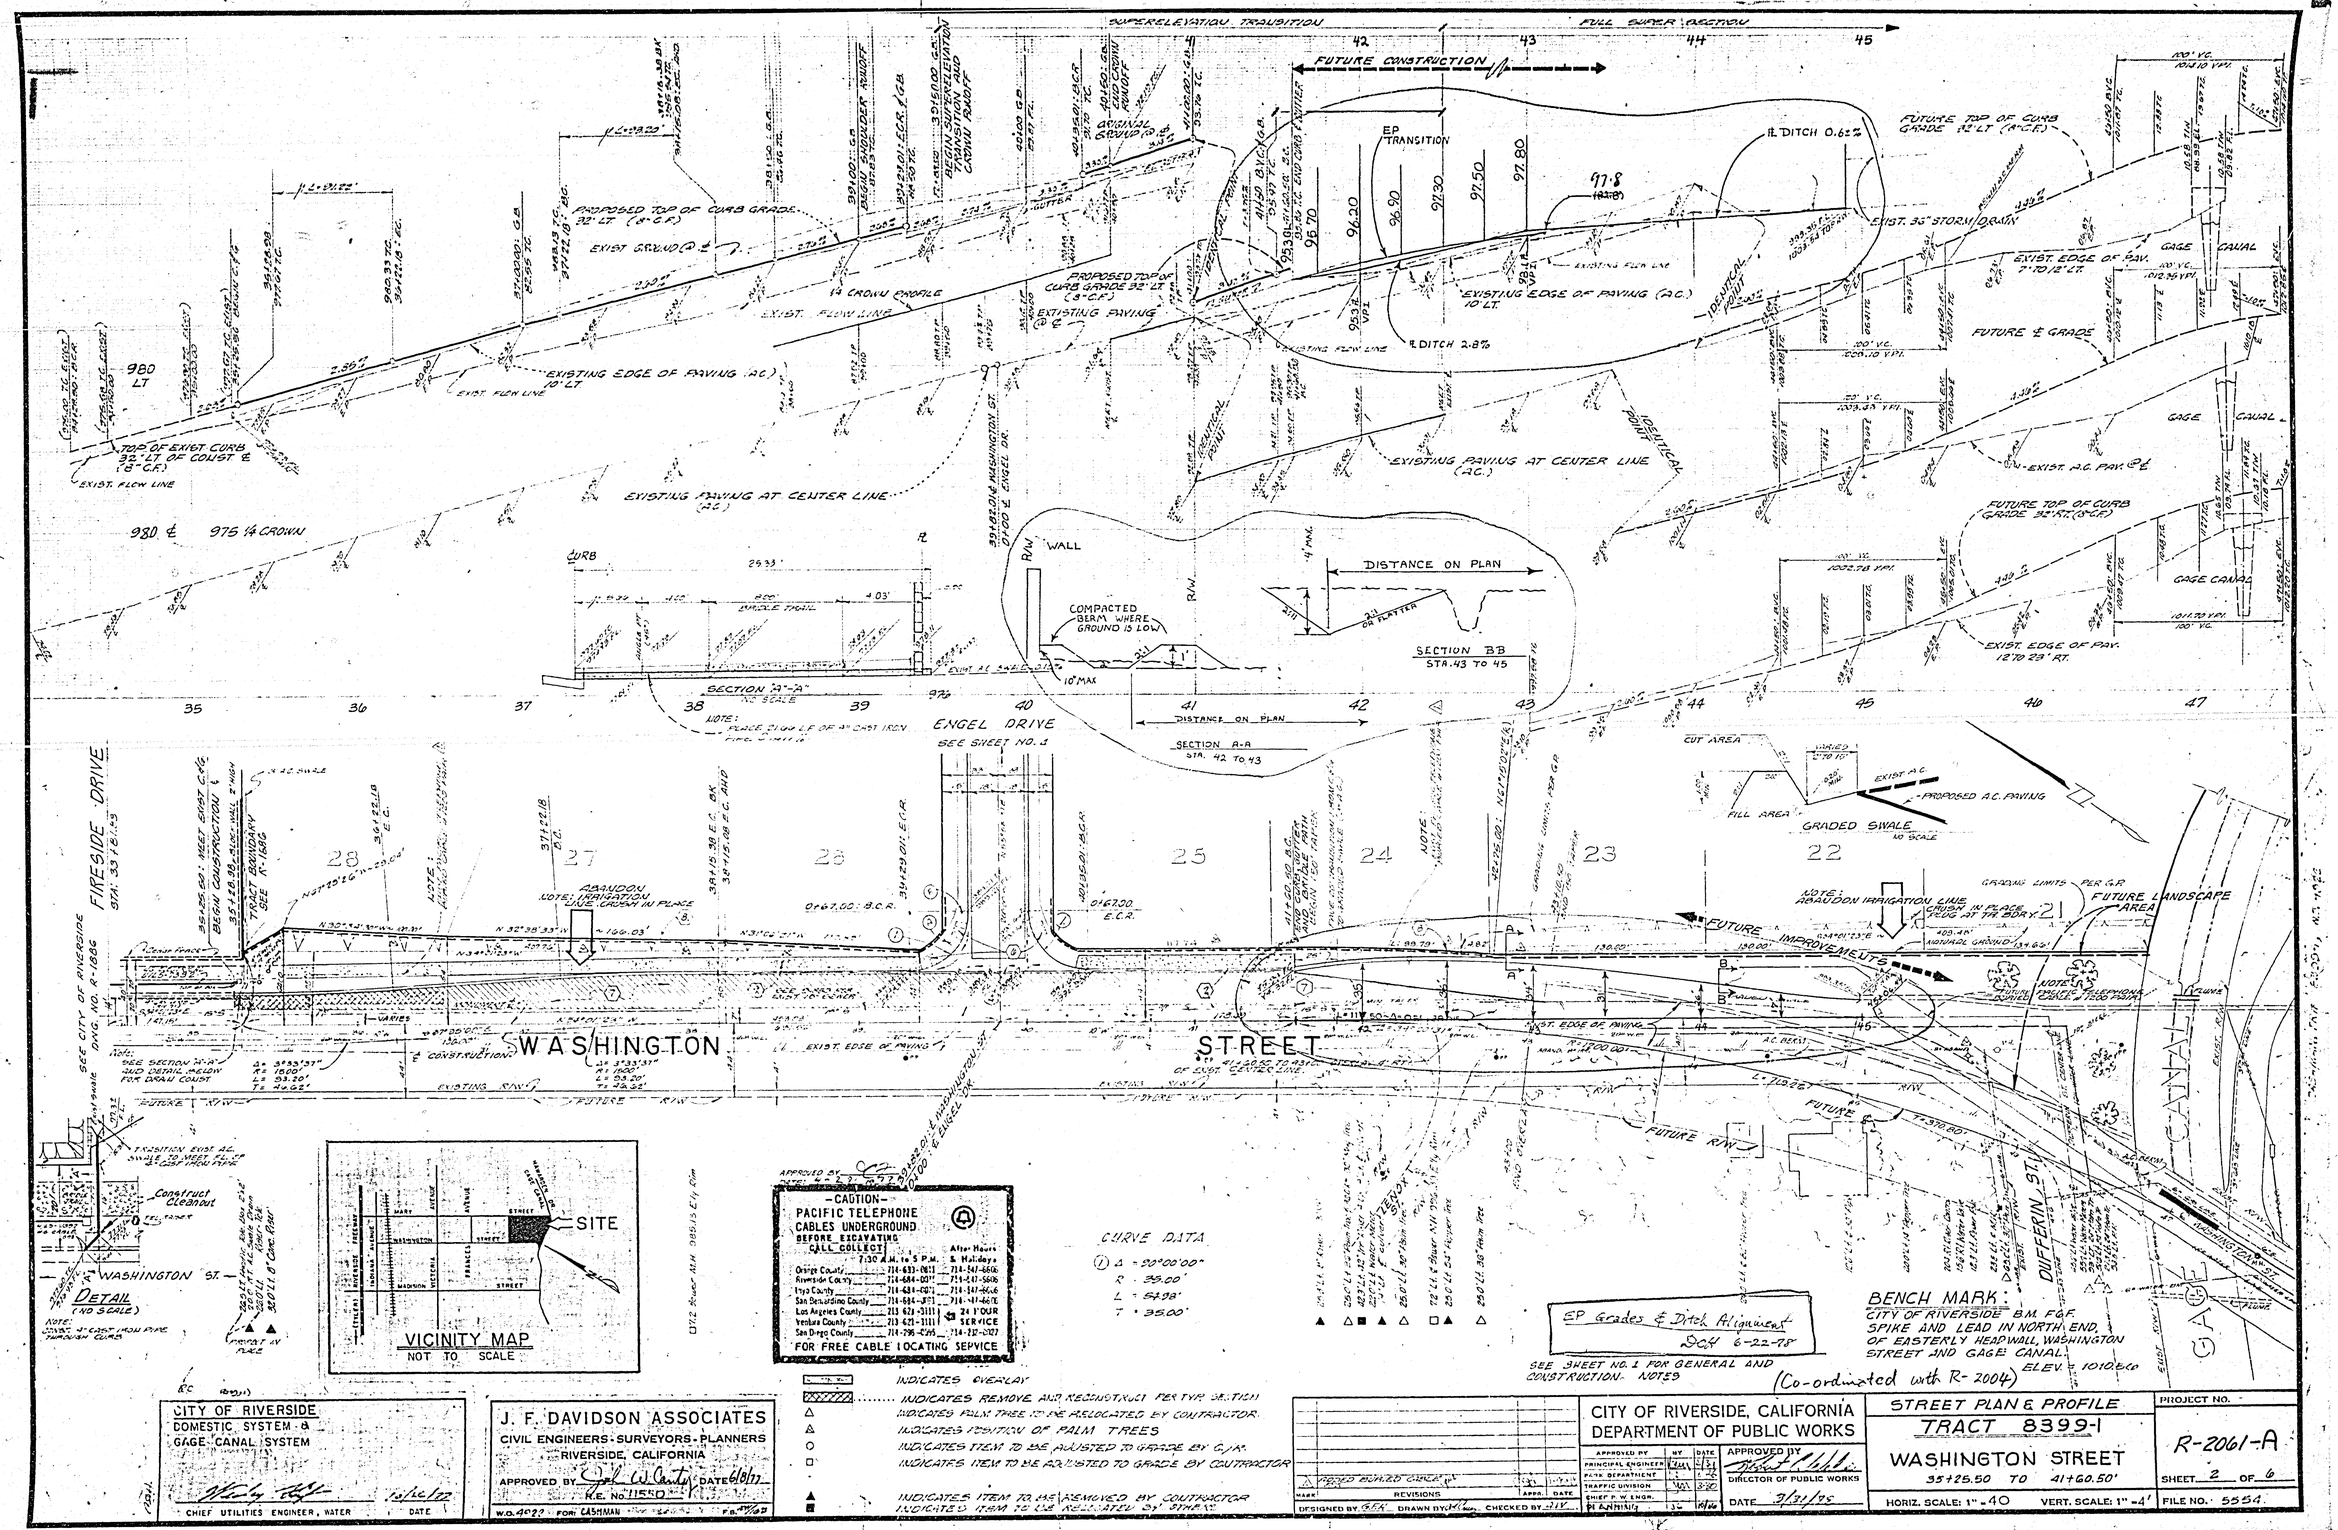

SUPERELEVATION TRANSITION
FULL SUPER SECTION
FUTURE CONSTRUCTION
EP TRANSITION
℄ DITCH 0.62%
℄ DITCH 2.8%
PROPOSED TOP OF CURB GRADE 32' LT (8" C.F.)
EXIST. GROUND @ ℄
EXISTING EDGE OF PAVING (A.C.) 10' LT.
EXISTING PAVING @ ℄
EXISTING PAVING AT CENTER LINE (A.C.)
TOP OF EXIST. CURB 32' LT OF CONST ℄ (8" C.F.)
EXIST. FLOW LINE
980 LT
980 ℄ 975 ¼ CROWN
FUTURE TOP OF CURB GRADE 32' LT (8" C.F.)
EXIST. 36" STORM DRAIN
EXIST. EDGE OF PAV. 7' TO 12' LT.
FUTURE ℄ GRADE
GAGE CANAL
EXIST. A.C. PAV. @ ℄
FUTURE TOP OF CURB GRADE 32' RT. (8" C.F.)
EXIST. EDGE OF PAV. 12' TO 23' RT.
IDENTICAL POINT
WALL
COMPACTED BERM WHERE GROUND IS LOW
DISTANCE ON PLAN
SECTION BB STA. 43 TO 45
SECTION A-A STA. 42 TO 43
SECTION "A"-"A" NO SCALE
ENGEL DRIVE SEE SHEET NO. 1
FIRESIDE DRIVE
SEE CITY OF RIVERSIDE DWG. NO. R-1886
TRACT BOUNDARY SEE R-1686
ABANDON IRRIGATION LINE CRUSH IN PLACE
WASHINGTON STREET
EXIST. EDGE OF PAVING
EXISTING R/W
FUTURE R/W
FUTURE IMPROVEMENTS
CUT AREA
FILL AREA
GRADED SWALE NO SCALE
PROPOSED A.C. PAVING
FUTURE LANDSCAPE AREA
DUFFERIN ST.
WASHINGTON ST.
Construct Cleanout
DETAIL (NO SCALE)
VICINITY MAP NOT TO SCALE
SITE
CAUTION
PACIFIC TELEPHONE CABLES UNDERGROUND BEFORE EXCAVATING CALL COLLECT
FOR FREE CABLE LOCATING SERVICE
CURVE DATA
Δ = 90°00'00"
R = 35.00'
L = 54.98'
T = 35.00'
EP Grades & Ditch Alignment DCH 6-22-78
SEE SHEET NO. 1 FOR GENERAL AND CONSTRUCTION NOTES
BENCH MARK: CITY OF RIVERSIDE B.M. F.G.F. SPIKE AND LEAD IN NORTH END OF EASTERLY HEADWALL, WASHINGTON STREET AND GAGE CANAL. ELEV. = 1010.86
(Co-ordinated with R-2004)
INDICATES OVERLAY
INDICATES REMOVE AND RECONSTRUCT PER TYP. SECTION
INDICATES PALM TREE TO BE RELOCATED BY CONTRACTOR
INDICATES POSITION OF PALM TREES
INDICATES ITEM TO BE ADJUSTED TO GRADE BY C/R
INDICATES ITEM TO BE ADJUSTED TO GRADE BY CONTRACTOR
INDICATES ITEM TO BE REMOVED BY CONTRACTOR
INDICATES ITEM TO BE RELOCATED BY OTHERS
CITY OF RIVERSIDE DOMESTIC SYSTEM & GAGE CANAL SYSTEM
CHIEF UTILITIES ENGINEER, WATER
J. F. DAVIDSON ASSOCIATES
CIVIL ENGINEERS - SURVEYORS - PLANNERS
RIVERSIDE, CALIFORNIA
APPROVED BY
DATE 6/8/77
R.E. No. 11550
W.O. 4022 FOR: CASHMAN
CITY OF RIVERSIDE, CALIFORNIA
DEPARTMENT OF PUBLIC WORKS
APPROVED BY
DIRECTOR OF PUBLIC WORKS
DATE 3/31/78
STREET PLAN & PROFILE
TRACT 8399-1
WASHINGTON STREET
35+25.50 TO 41+60.50'
HORIZ. SCALE: 1" = 40
VERT. SCALE: 1" = 4'
PROJECT NO. R-2061-A
SHEET 2 OF 6
FILE NO. 5554