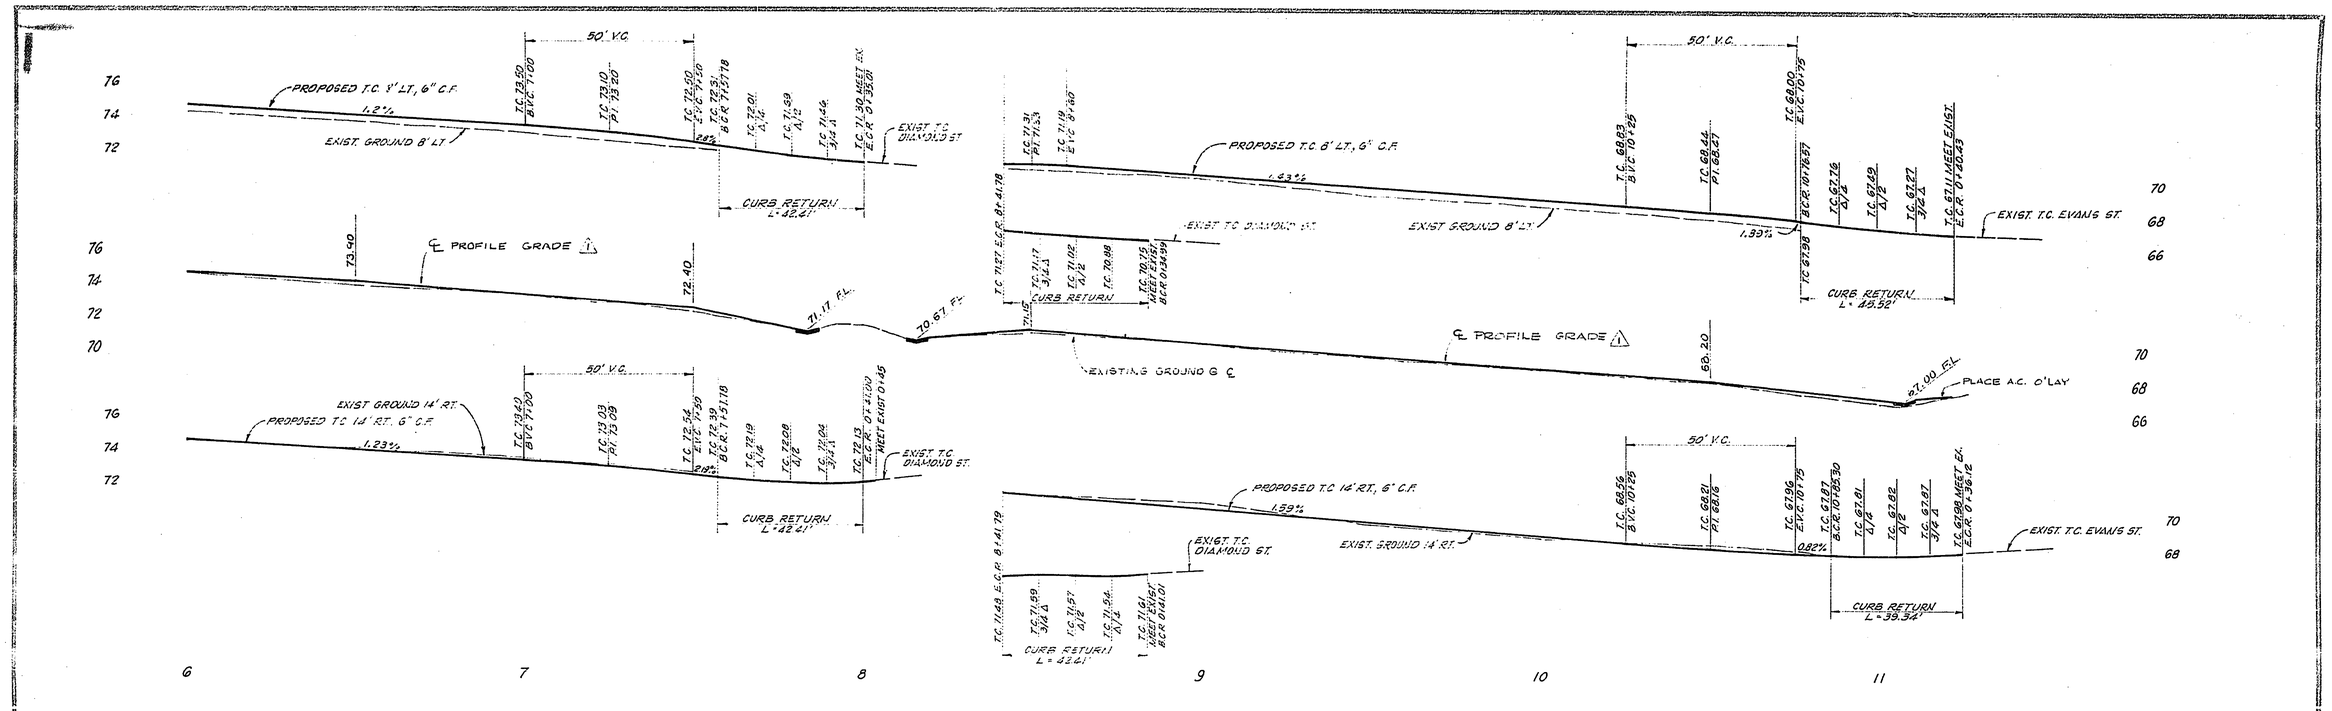

CONSTRUCTION LEGEND

1. CONST. 2½" A.C. PAVEMENT OVER 4" D.G. BASE.
2. REMOVE CULVERT.
3. INSTALL 38 L.F. 17"×13" CMPA SQUASHED TO 18"×11".
4. CONST. BUBBLER OUTLET BOX SIMILAR TO STD. DWG. NO. 425 WITH FRAME & GRATING, ALHAMBRA A-1555 OR APPROVED EQUAL
6. CUT EXIST. X-GUTTER & REMOVE ENDS
7. RELOCATE FENCE.
8. PROPERTY OWNER TO RELOCATE FENCE. IF NOT SO DONE THE CONTRACTOR SHALL REMOVE FENCE & PLACE ON PRIVATE PROPERTY
R. REMOVE ENTIRE TREE.
200. CONST. CURB & GUTTER PER STD. DWG. NO. 200.
220. CONST. CURB RETURN APRONS PER STD. DWG. NO. 220. - CONST. X-GUTTER AS/PER CHANGE ORDER
302. CONST. DRIVEWAY APPROACH PER STD. DWG. NO. 302.
304. CONST. WHEELCHAIR RAMP PER STD. DWG. NO. 304.
325. CONST. SIDEWALK PER STD. DWG. NO. 325.
9. CONNECT WALK TO SIDEWALK WITH 4" PCC & D/W WITH 6" PCC.
10. APPLY SEAL COAT OVER ENTIRE WIDTH OF BUNKER ST.

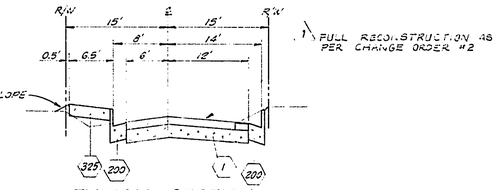

TYPICAL SECTION
FROM PETERS ST. TO EVANS ST.

CITY OF RIVERSIDE
PUBLIC WORKS DEPARTMENT

BUNKER STREET
HCD PROJECT 1977-78
FROM EMERALD ST. TO EVANS STREET

HORIZ. SCALE: 1" = 20' VERT. SCALE: 1" = 4'

15-550-481
R-2075
SHEET 2 OF 2

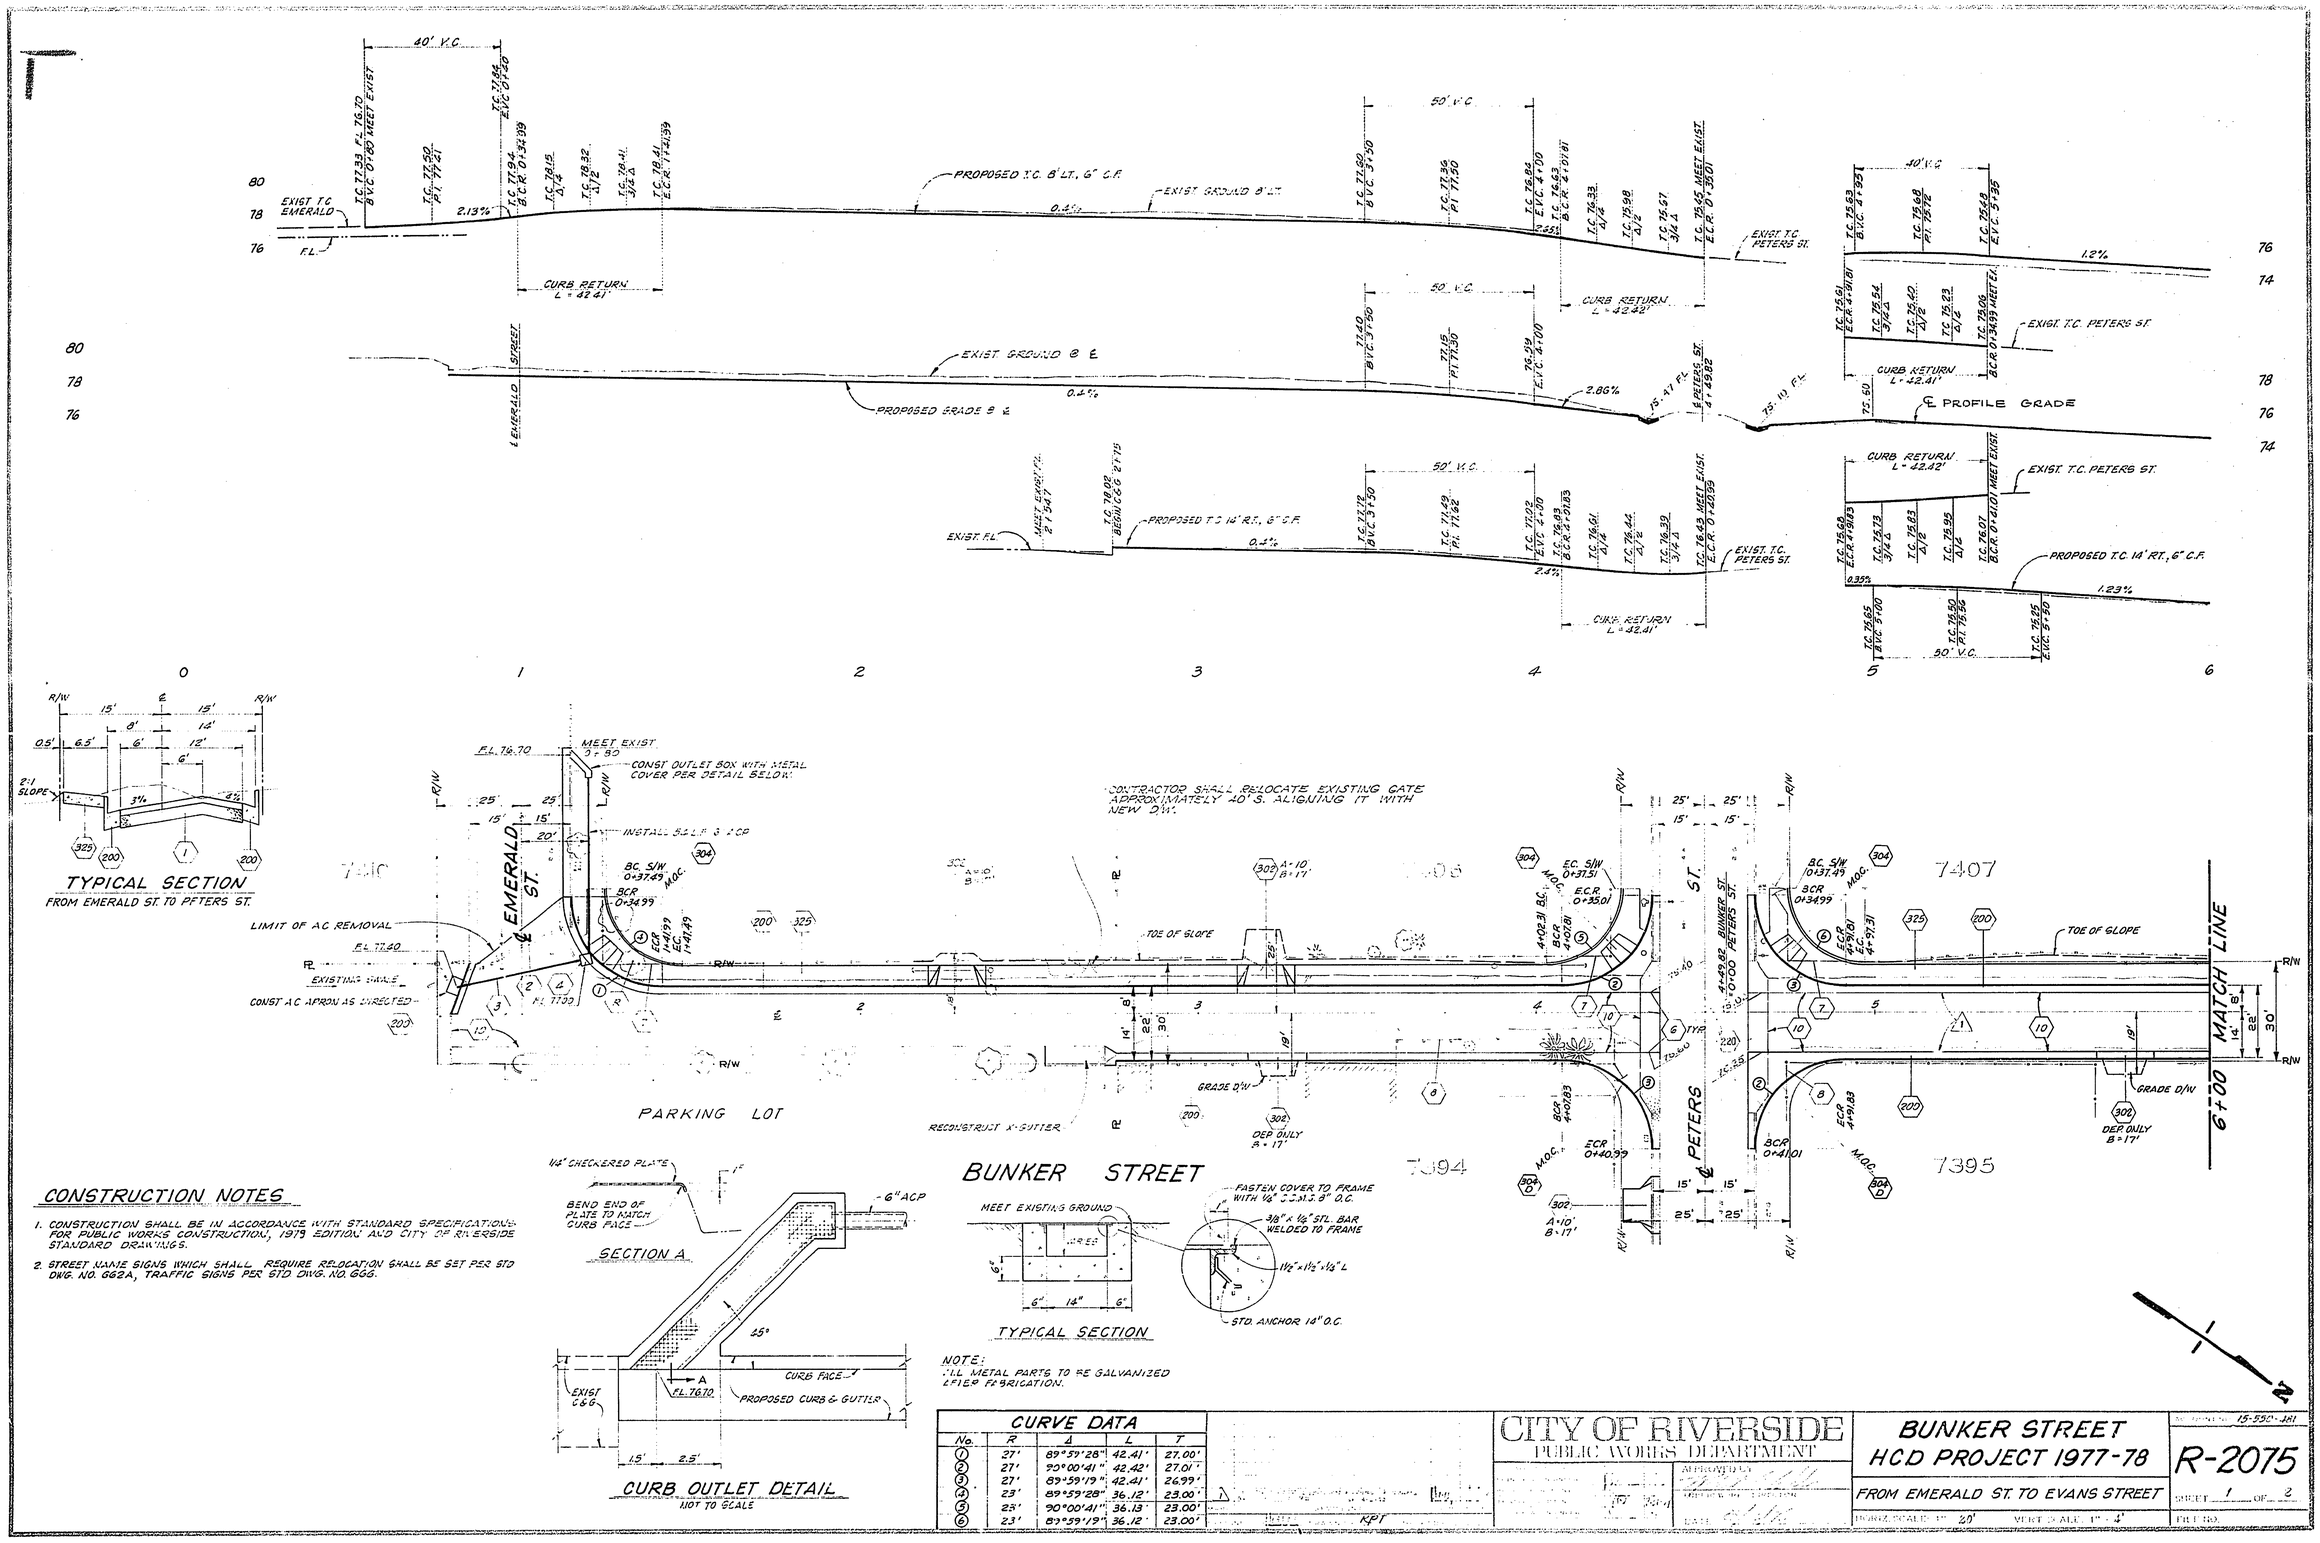

CONSTRUCTION NOTES

1. CONSTRUCTION SHALL BE IN ACCORDANCE WITH STANDARD SPECIFICATIONS FOR PUBLIC WORKS CONSTRUCTION, 1979 EDITION AND CITY OF RIVERSIDE STANDARD DRAWINGS.
2. STREET NAME SIGNS WHICH SHALL REQUIRE RELOCATION SHALL BE SET PER STD DWG. NO. G62A, TRAFFIC SIGNS PER STD DWG. NO. G66.

CURVE DATA

No.	R	Δ	L	T
1	27'	89°59'28"	42.41'	27.00'
2	27'	90°00'41"	42.42'	27.01'
3	27'	89°59'19"	42.41'	26.99'
4	23'	89°59'28"	36.12'	23.00'
5	23'	90°00'41"	36.13'	23.00'
6	23'	89°59'19"	36.12'	23.00'

CITY OF RIVERSIDE
PUBLIC WORKS DEPARTMENT

BUNKER STREET
HCD PROJECT 1977-78
FROM EMERALD ST. TO EVANS STREET

15-550-481
R-2075
SHEET 1 OF 2

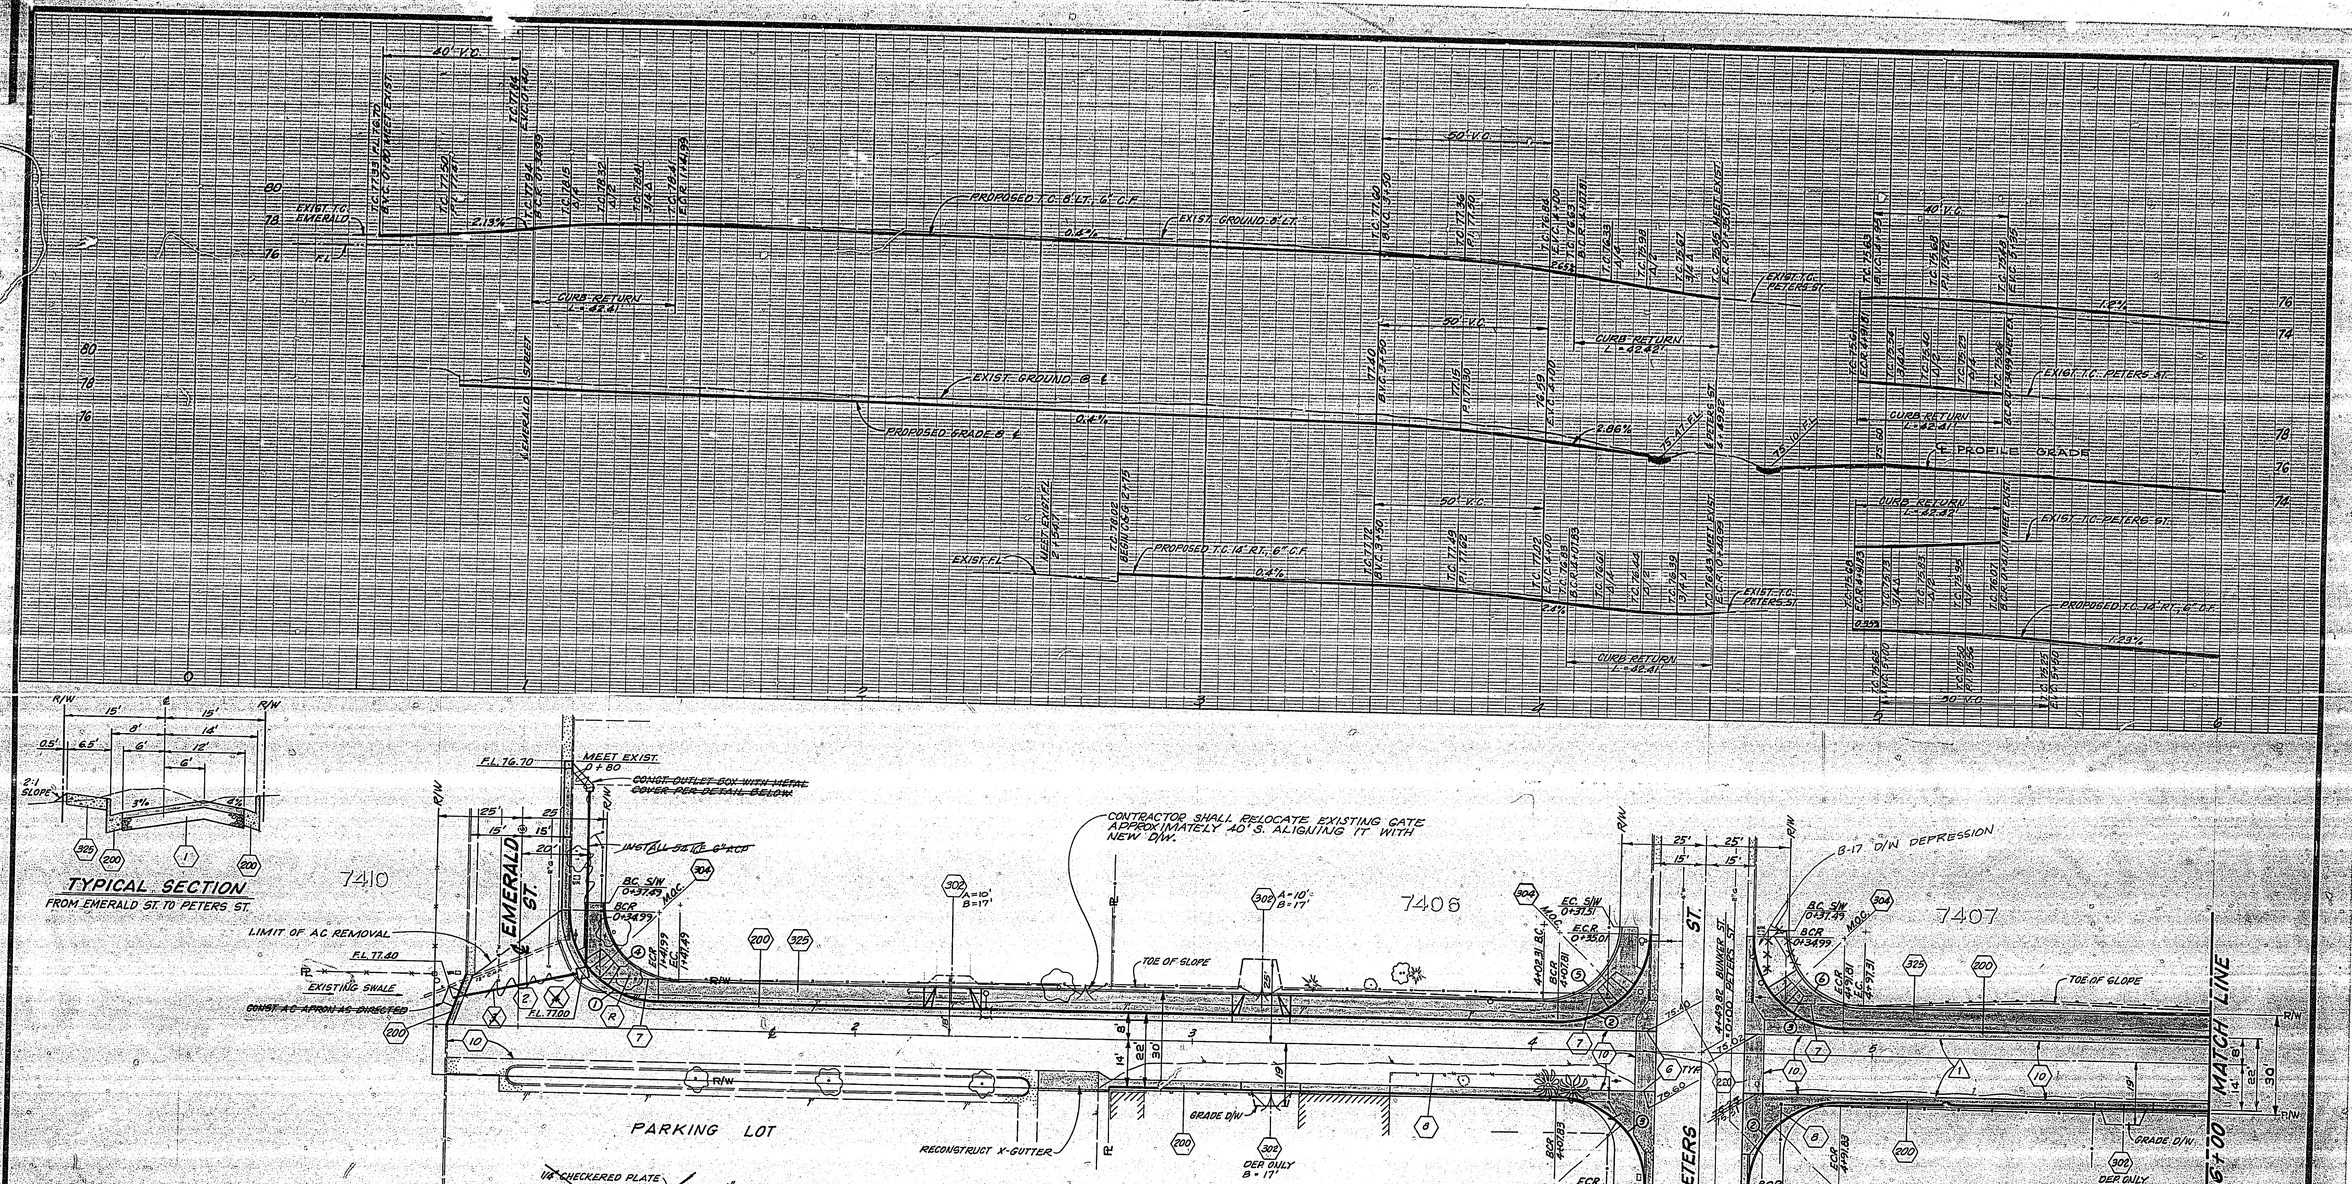

CONSTRUCTION NOTES

1. CONSTRUCTION SHALL BE IN ACCORDANCE WITH STANDARD SPECIFICATIONS FOR PUBLIC WORKS CONSTRUCTION, 1979 EDITION AND CITY OF RIVERSIDE STANDARD DRAWINGS.
2. STREET NAME SIGNS WHICH SHALL REQUIRE RELOCATION SHALL BE SET PER STD. DWG. NO. 662A, TRAFFIC SIGNS PER STD. DWG. NO. 666.

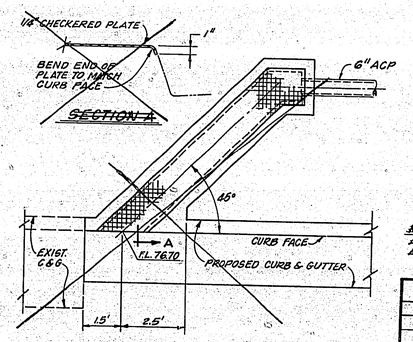

~~CURB OUTLET DETAIL~~
~~NOT TO SCALE~~

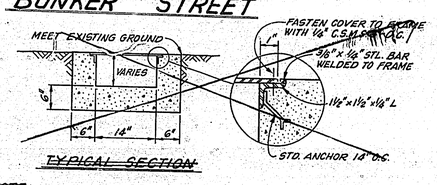

~~TYPICAL SECTION~~

~~NOTE:~~
~~ALL METAL PARTS TO BE GALVANIZED AFTER FABRICATION.~~

CURVE DATA

No.	R	Δ	L	T
1	27'	89°59'28"	42.41'	27.00'
2	27'	90°00'41"	42.42'	27.01'
3	27'	89°59'19"	42.41'	26.99'
4	23'	89°59'28"	36.12'	23.00'
5	23'	90°00'41"	36.13'	23.00'
6	23'	89°59'19"	36.12'	23.00'

MARK	REVISIONS	APPR.	DATE
1	RECONSTRUCT BETWEEN PETERS & EVANS AS PER C.O. 82	[illegible]	4/2/80

DESIGNED BY [illegible] DRAWN BY KPT CHECKED BY

CITY OF RIVERSIDE
PUBLIC WORKS DEPARTMENT

APPROVED BY
PRINCIPAL ENGINEER [illegible] 8/1
PARK DEPARTMENT [illegible] 4/4/79
TRAFFIC DIVISION [illegible] 7-31-79
CHIEF P. W. ENGINEER [illegible] 8-2

APPROVED BY [illegible]
PUBLIC WORKS DIRECTOR
DATE 8/2/79

* AS BUILT 6/10/81 [illegible]

BUNKER STREET
HCD PROJECT 1977-78
FROM EMERALD ST. TO EVANS STREET

HORIZ. SCALE: 1" = 20' VERT. SCALE: 1" = 4'

INDEXED BY BLD
ACCOUNT NO. 15-550-481
R-2075
SHEET 1 OF 2
FILE NO.

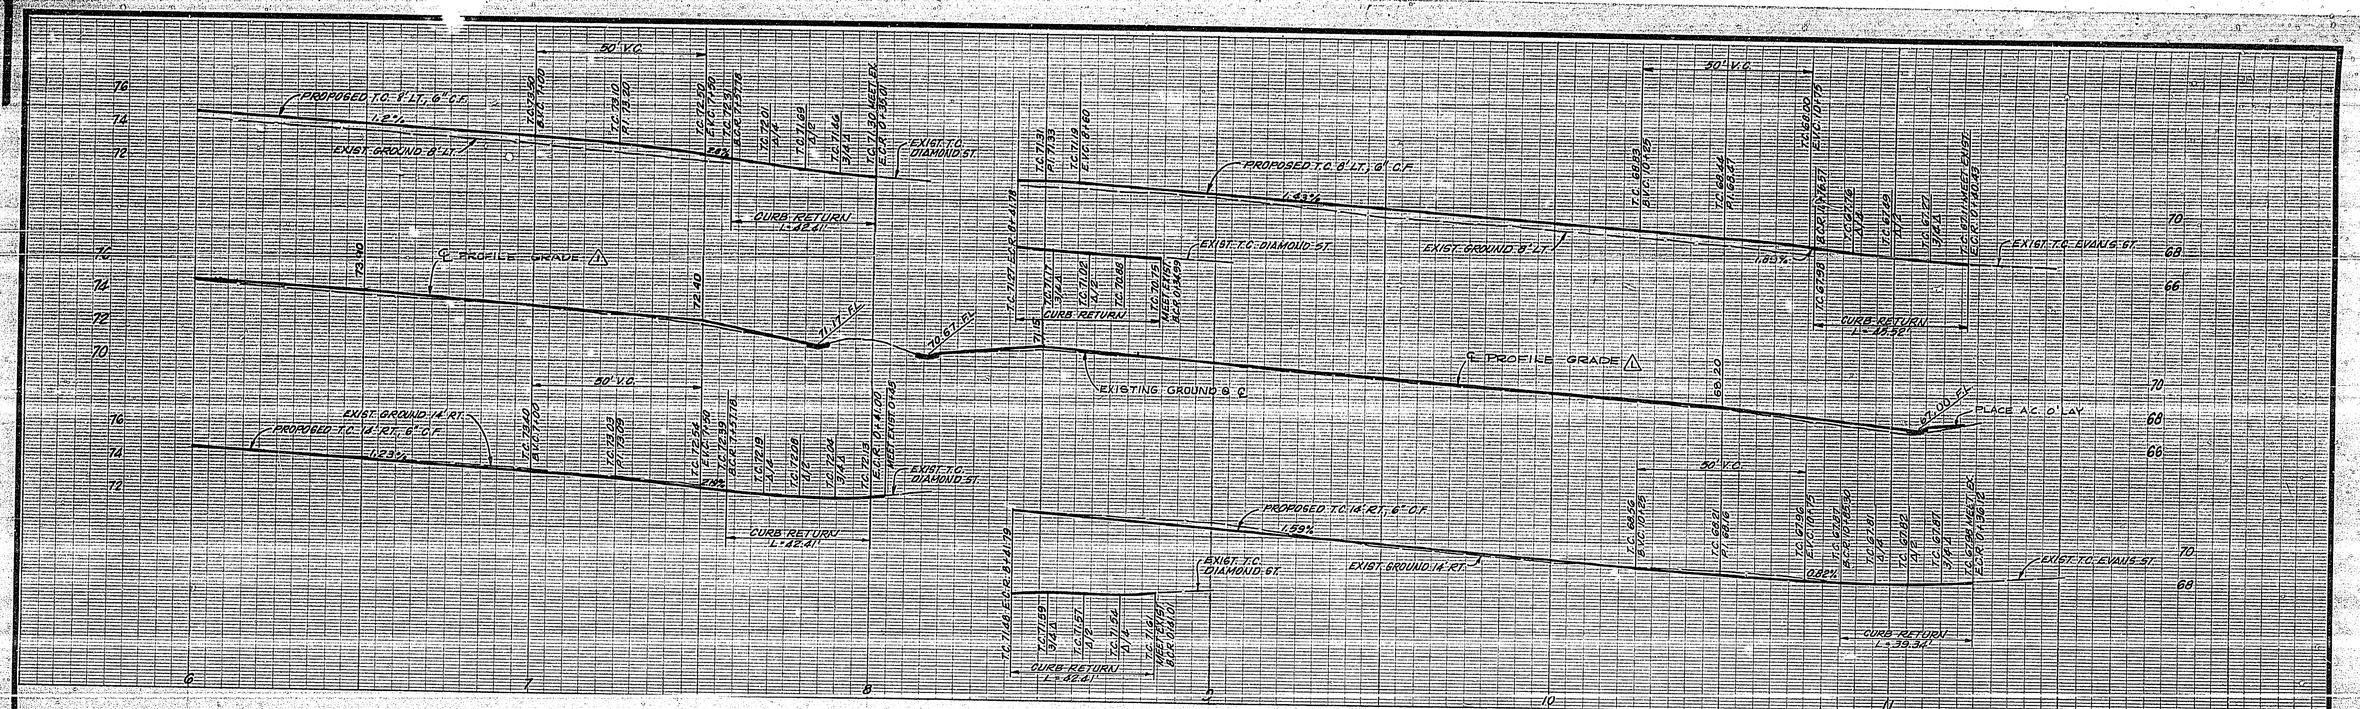

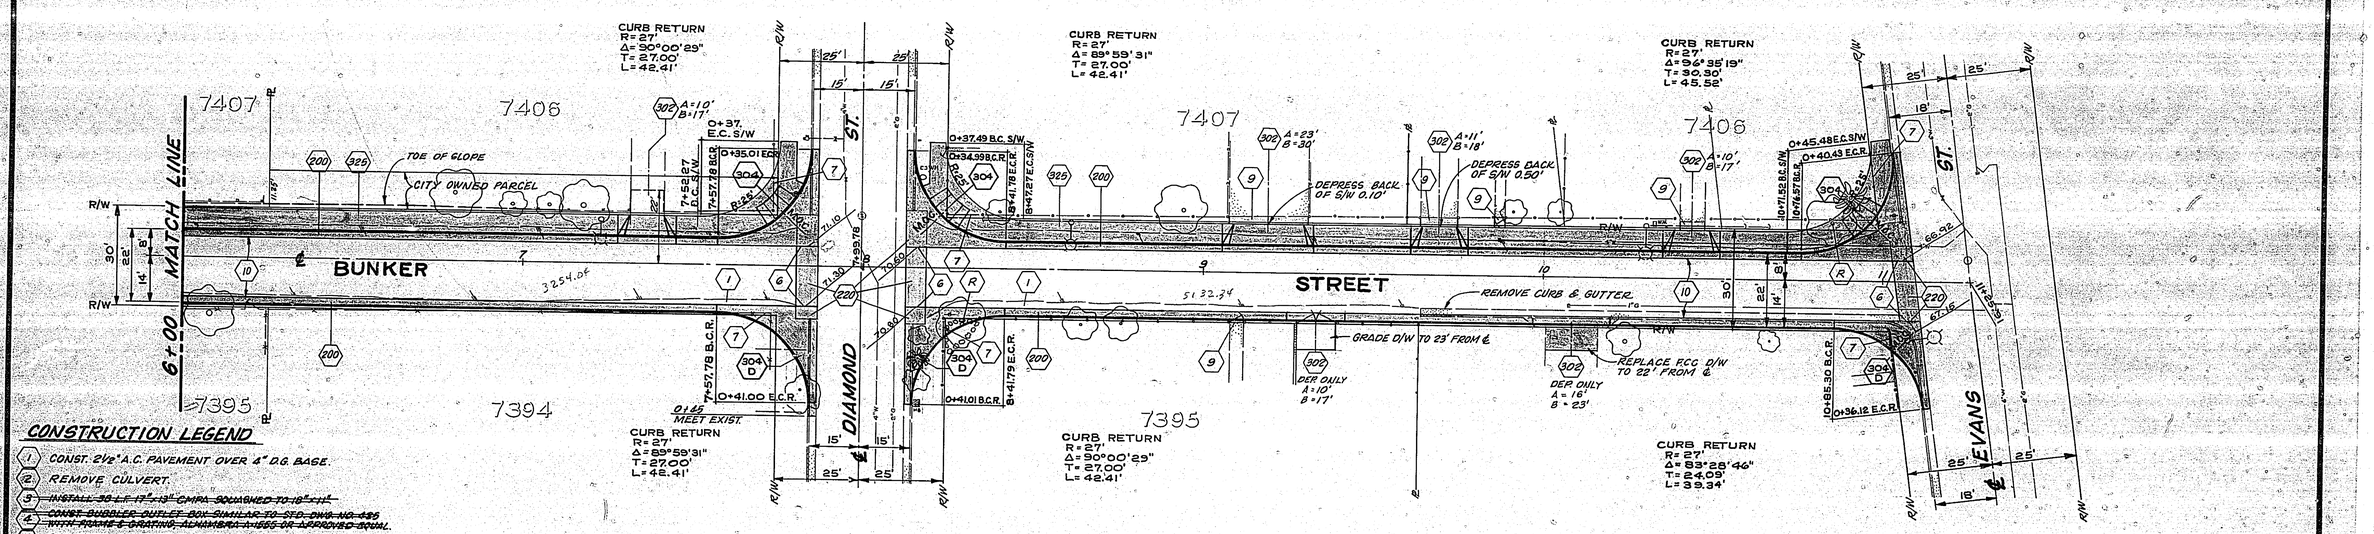

CONSTRUCTION LEGEND

1. CONST. 2½" A.C. PAVEMENT OVER 4" D.G. BASE.
2. REMOVE CULVERT.
3. ~~INSTALL 38 L.F. 17"x13" CMPA SQUASHED TO 18"x11"~~
4. ~~CONST. BUBBLER OUTLET BOX SIMILAR TO STD. DWG. NO. 425 WITH FRAME & GRATING, ALHAMBRA A-1555 OR APPROVED EQUAL.~~
6. CUT EXIST. X-GUTTER & REMOVE ENDS
7. RELOCATE FENCE.
8. PROPERTY OWNER TO RELOCATE FENCE. IF NOT SO DONE, THE CONTRACTOR SHALL REMOVE FENCE & PLACE ON PRIVATE PROPERTY.
R. REMOVE ENTIRE TREE.
200. CONST. CURB & GUTTER PER STD. DWG. NO. 200.
220. CONST. CURB RETURN APRONS PER STD. DWG. NO. 220. - CONST. X-GUTTER AS PER CHANGE ORDER 1
302. CONST. DRIVEWAY APPROACH PER STD. DWG. NO. 302.
304. CONST. WHEELCHAIR RAMP PER STD. DWG. NO. 304.
325. CONST. SIDEWALK PER STD. DWG. NO. 325.
9. CONNECT WALK TO SIDEWALK WITH 4" PCC & D/W WITH 6" PCC.
10. APPLY SEAL COAT OVER ENTIRE WIDTH OF BUNKER ST.

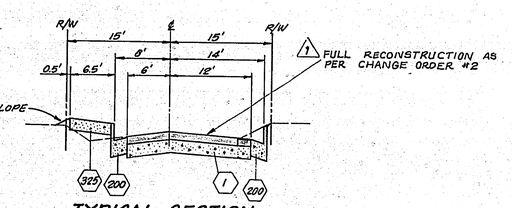

TYPICAL SECTION
FROM PETERS ST. TO EVANS ST.

MARK	REVISIONS	APPR.	DATE
1	RECONSTRUCT BETWEEN PETERS & EVANS AS PER C.O. #2	[illegible]	4/2/80

DESIGNED BY [illegible] DRAWN BY KPT CHECKED BY

CITY OF RIVERSIDE
PUBLIC WORKS DEPARTMENT

APPROVED BY	BY	DATE
PRINCIPAL ENGINEER	[illegible]	8/1
PARK DEPARTMENT	[illegible]	9/1/79
TRAFFIC DIVISION	[illegible]	7-31-79
CHIEF P. W. ENGINEER	[illegible]	8-2

APPROVED BY [illegible]
PUBLIC WORKS DIRECTOR
DATE 8/3/79

* AS BUILT 6/10/81 [illegible]

INDEXED BY R.L.D.

BUNKER STREET
HCD PROJECT 1977-78
FROM EMERALD ST. TO EVANS STREET

HORIZ. SCALE: 1" = 20' VERT. SCALE: 1" = 4'

ACCOUNT NO. 15-550-481

R-2075

SHEET 2 OF 2