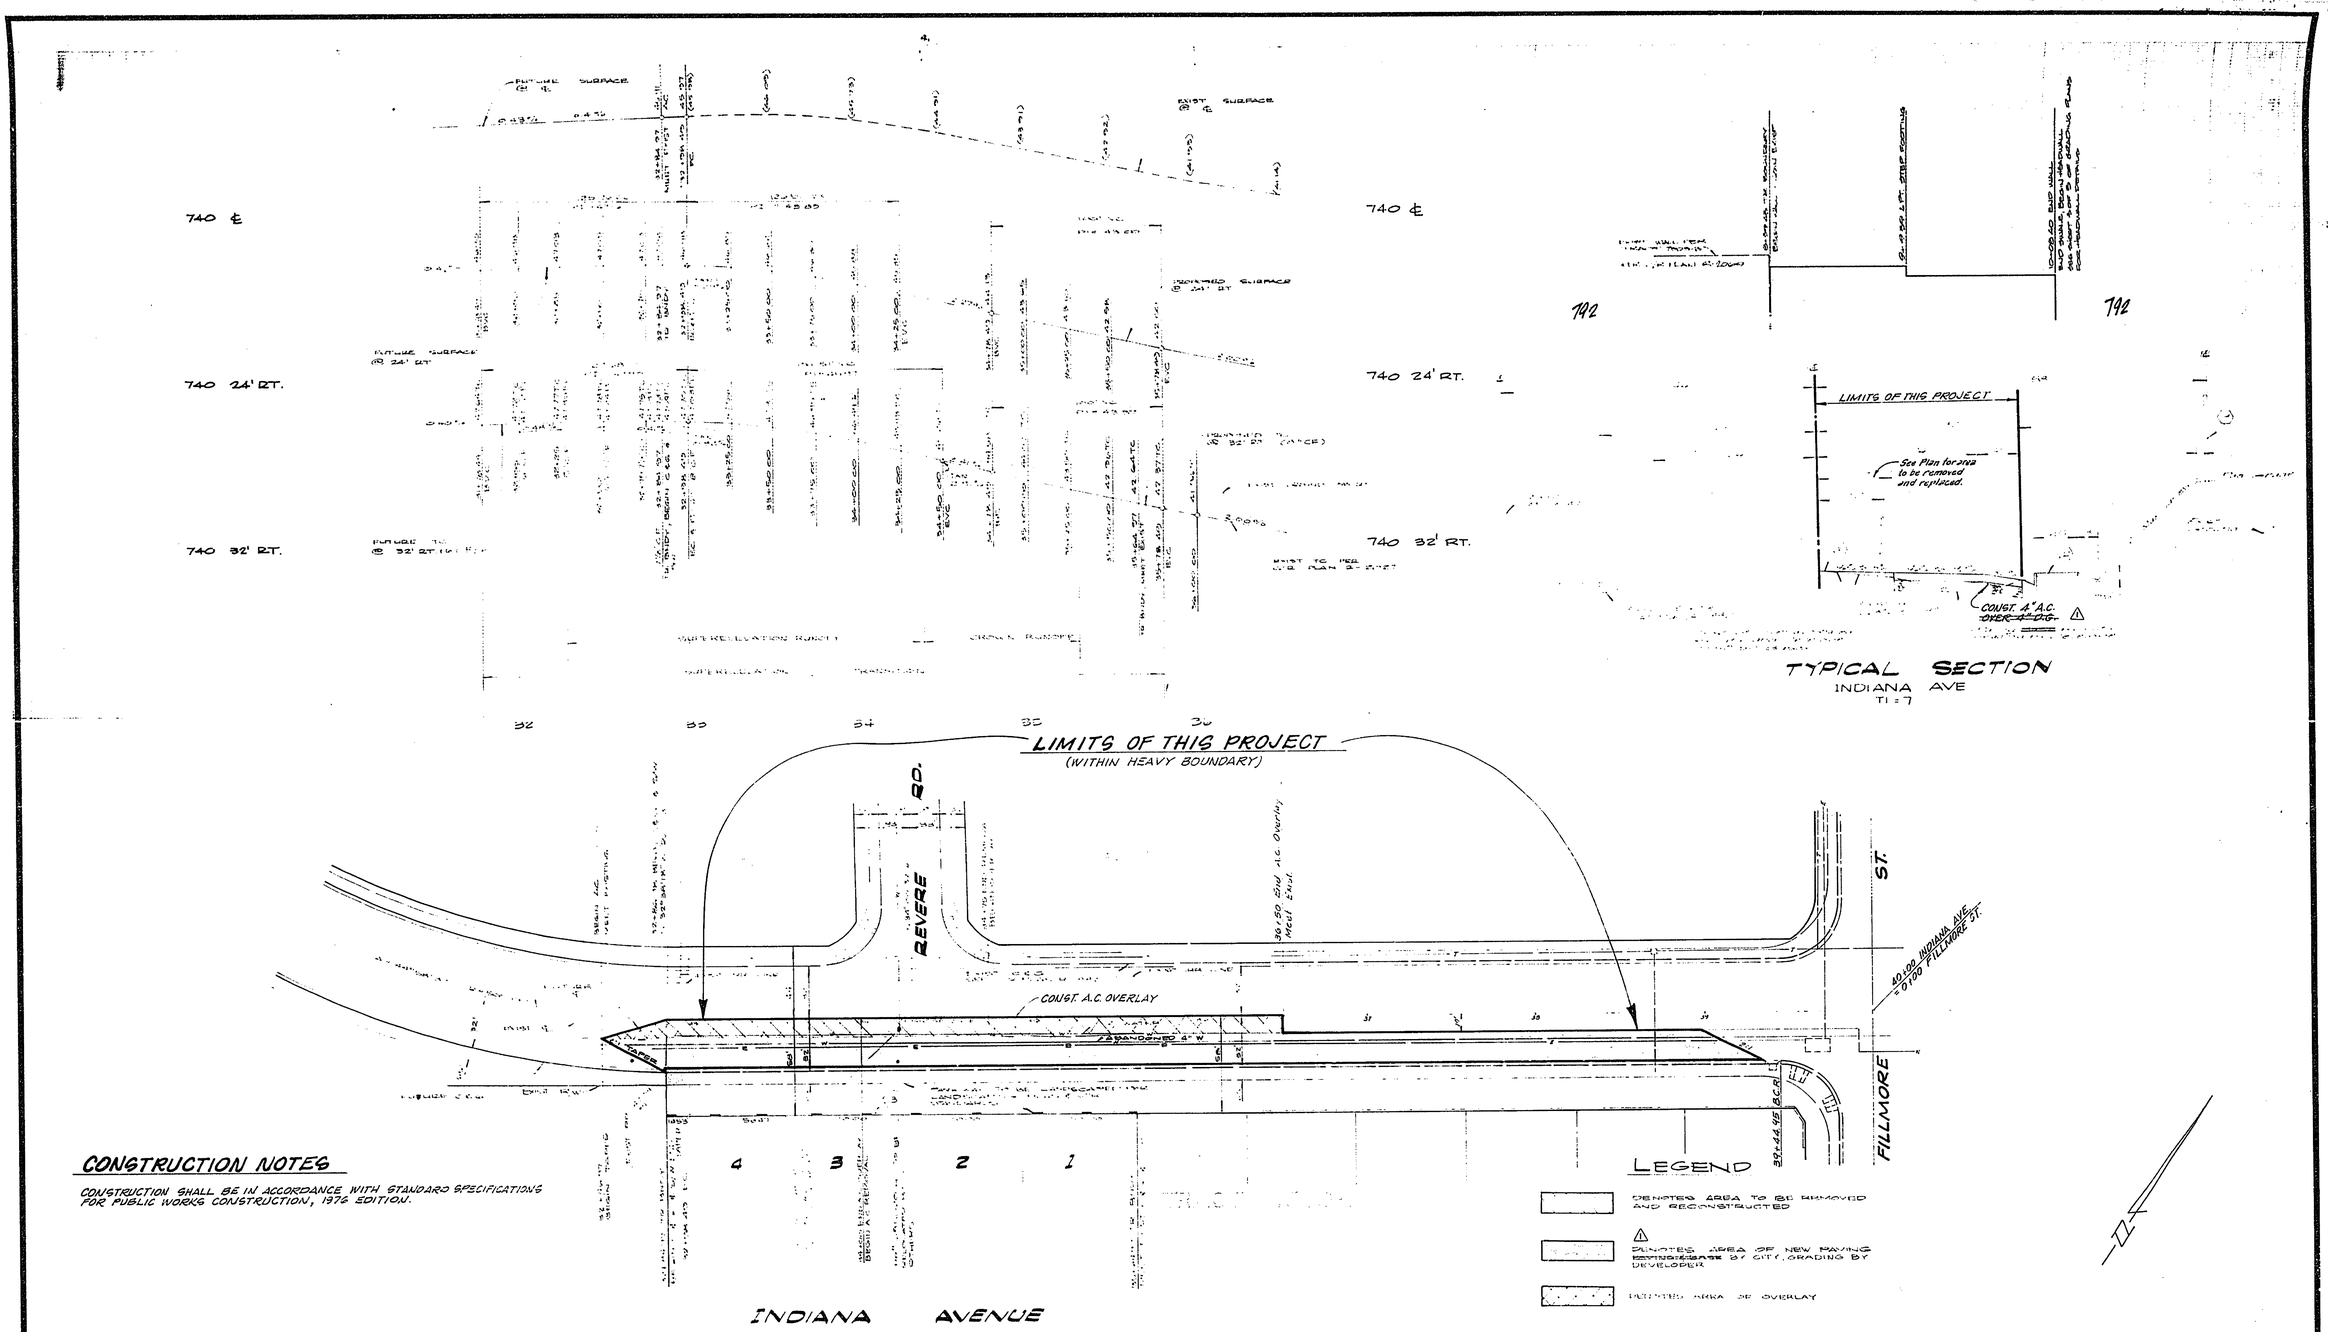

TYPICAL SECTION
INDIANA AVE
TI = 7

CONSTRUCTION NOTES

CONSTRUCTION SHALL BE IN ACCORDANCE WITH STANDARD SPECIFICATIONS FOR PUBLIC WORKS CONSTRUCTION, 1976 EDITION.

BENCH MARK:
E 20-PK. NAIL IN CENTER OF S.E. CURB RETURN AT INDIANA AVENUE AND FILLMORE STREET ELEV 758.968

* AS BUILT 1-22-80 BEP

ALBERT A. WEBB ASSOCIATES
CIVIL ENGINEERS
RIVERSIDE, CALIFORNIA
APPROVED BY [signature] DATE 6-7-77
R.E. No. 27105
W.O. 76-248 FOR: CITATION BUILDERS F.B. 105

MARK	REVISIONS	APPR.	DATE
1	Base Installed by Others. LPT		

DESIGNED BY MC DRAWN BY RP CHECKED BY

CITY OF RIVERSIDE, CALIFORNIA
PUBLIC WORKS DEPARTMENT

APPROVED BY	BY	DATE
PRINCIPAL ENGINEER		
PARK DEPARTMENT		
TRAFFIC DIVISION	JM	6/22
CHIEF PUB. WKS. ENGR.		

APPROVED BY
DIRECTOR OF PUBLIC WORKS
DATE

STREET PLAN & PROFILE
INDIANA AVENUE PAVEMENT
PARTICIPATION WITH TR. 7503-1 & 7503-4
FROM 150' SWLY OF REVERE RD. TO FILLMORE STREET
SCALE: HORIZ. 1" = 40', VERT. 1" = 4'

ACCOUNT No. 30-575-238-07
DRAWING NUMBER R-2080A
SHEET 1 OF 1
76-248-A

ADAPTED FROM PLANS R-2027 & R-2080