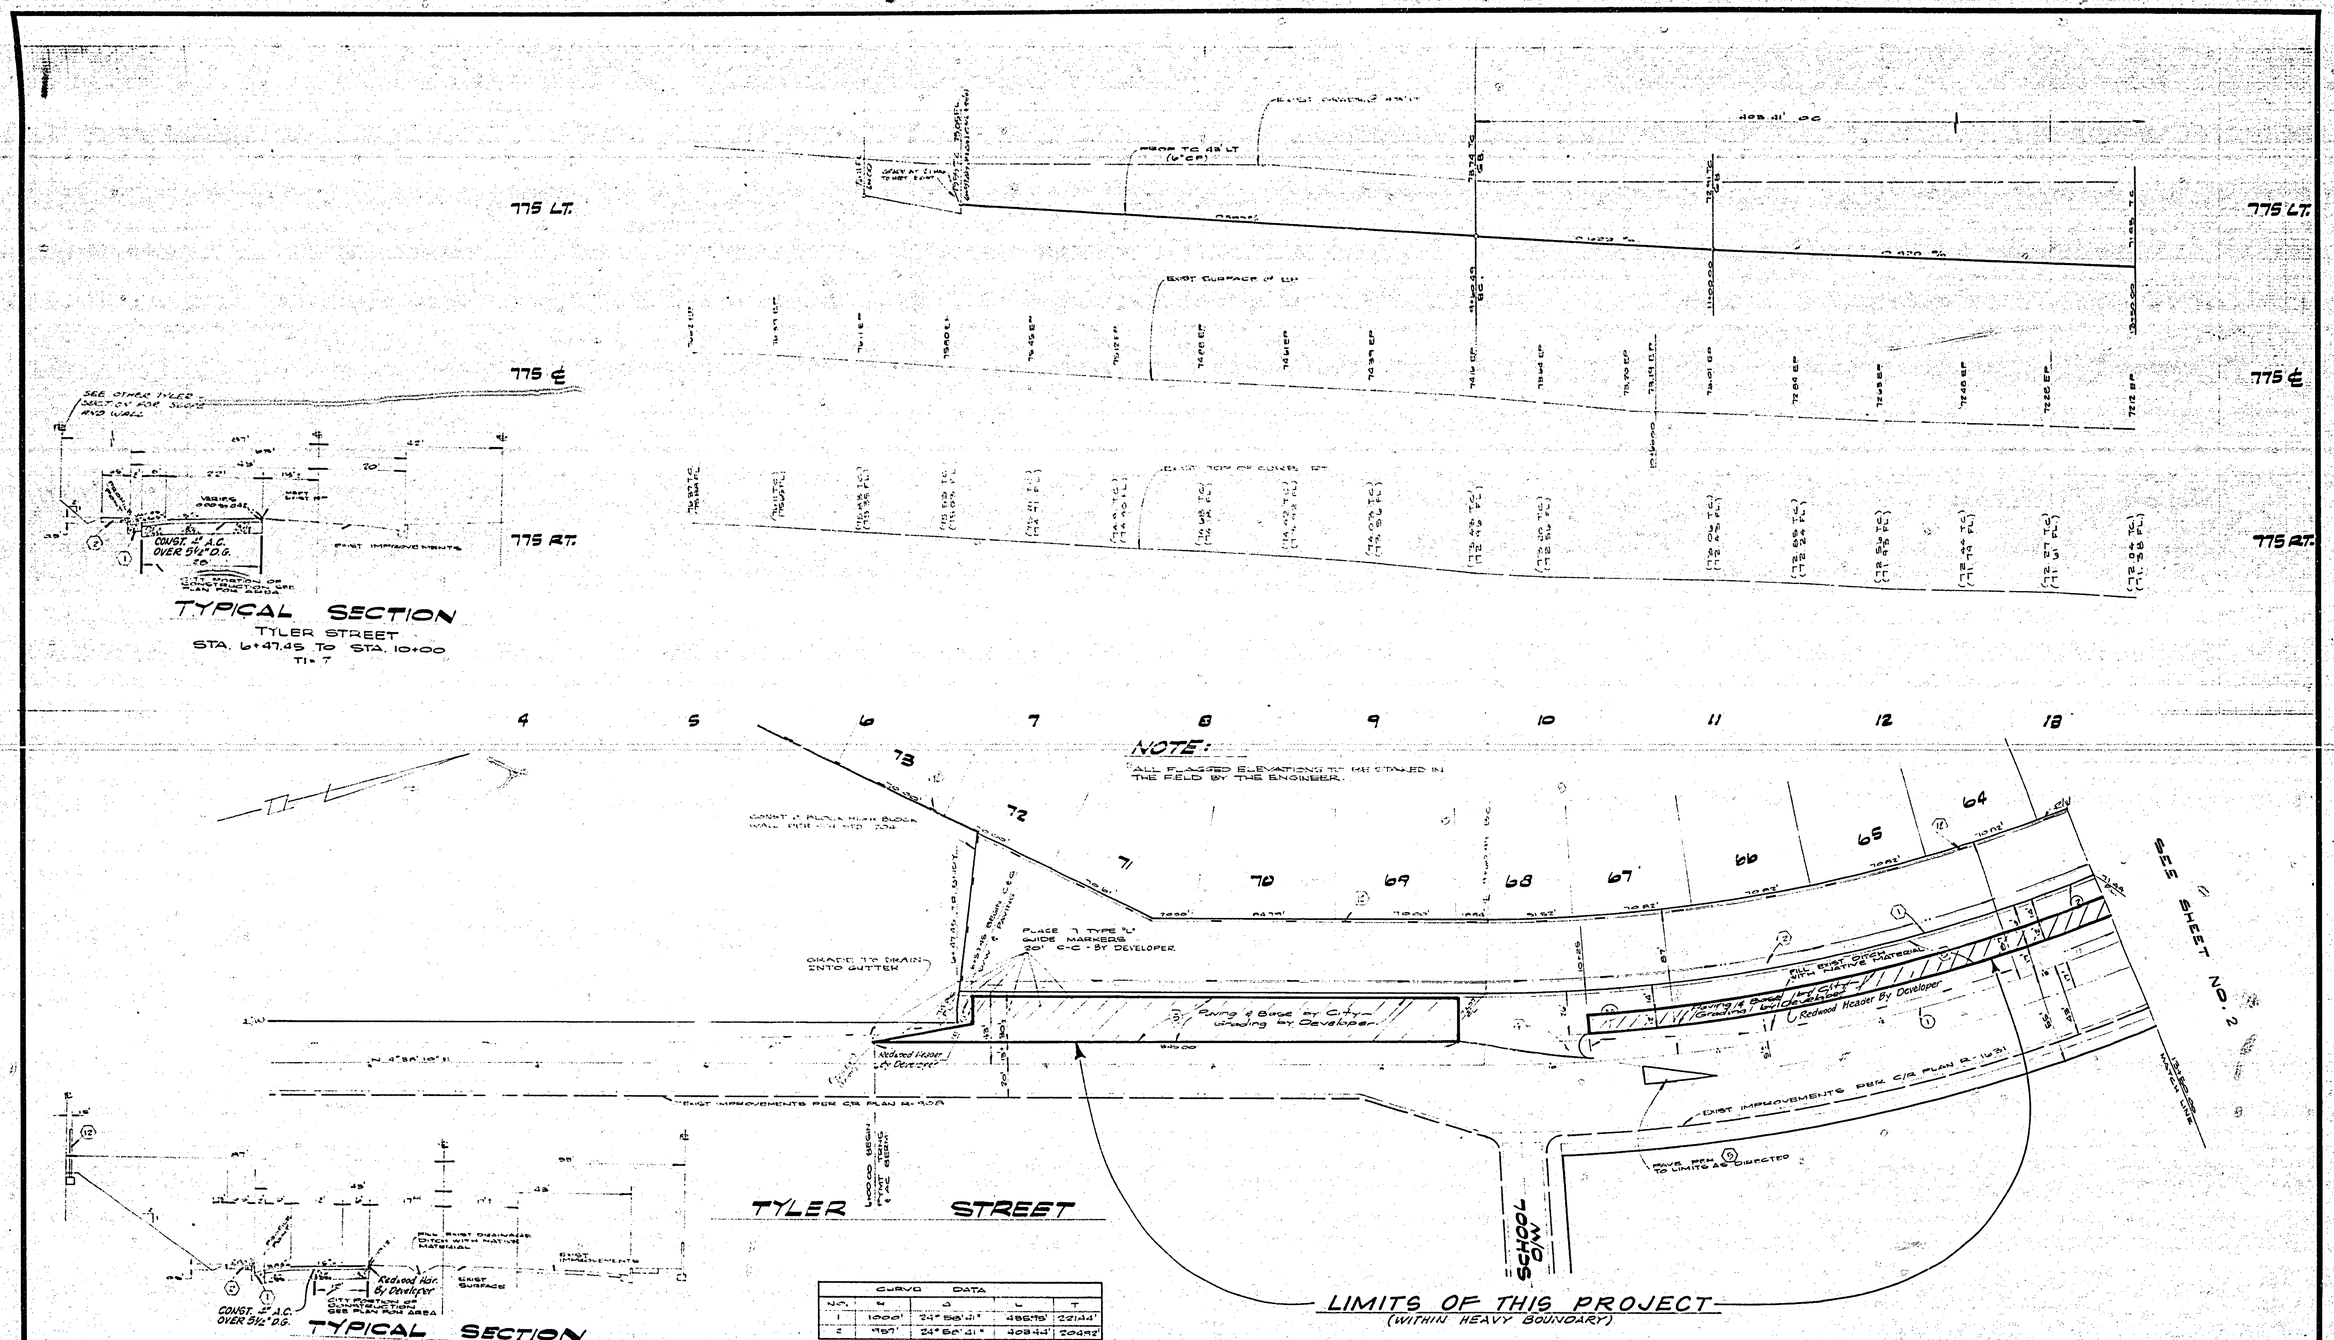

CURVE DATA				
NO.	R	Δ	L	T
1	1000'	24° 58' 41"	435.75'	221.44'
2	957'	24° 58' 41"	403.44'	204.92'

NOTE:
1. CONSTRUCTION SHALL BE IN ACCORDANCE WITH STANDARD SPECIFICATIONS FOR PUBLIC WORKS CONSTRUCTION, 1976 EDITION.

BENCH MARK:
TOP OF BOLT ON S.E. CORNER OF SIGNAL BASE @ THE NW CORNER OF ARLINGTON & TYLER PER C/R F.B. 996/14. ELEV. 781.486

ALBERT A. WEBB ASSOCIATES
CIVIL ENGINEERS
RIVERSIDE, CALIFORNIA
APPROVED BY [signature] DATE 8-18-77
R.E. No. 21884
W.O. 77-38 FOR: ANDEN CORP F.B. 1043

MARK	REVISIONS	APPR.	DATE

DESIGNED BY [illegible] DRAWN BY [illegible] CHECKED BY

CITY OF RIVERSIDE, CALIFORNIA
PUBLIC WORKS DEPARTMENT

APPROVED BY	BY	DATE
PRINCIPAL ENGINEER	—	—
PARK DEPARTMENT	—	—
TRAFFIC DIVISION	JW	5/22
CHIEF PUB. WKS. ENGR.		

APPROVED BY [signature]
DIRECTOR OF PUBLIC WORKS
DATE 5/20/79

STREET PLAN & PROFILE
TYLER STREET PAVEMENT PARTICIPATION WITH TRACT 9418
FROM 800' SOUTH OF VERONA ST. TO EUREKA DRIVE
SCALE: HORZ. 1" = 40' VERT. 1" = 4'

ACCOUNT No. 30-575-252-07
DRAWING NUMBER R-2093A
SHEET 1 OF 2
77-38A

ADAPTED FROM PLAN R-2093

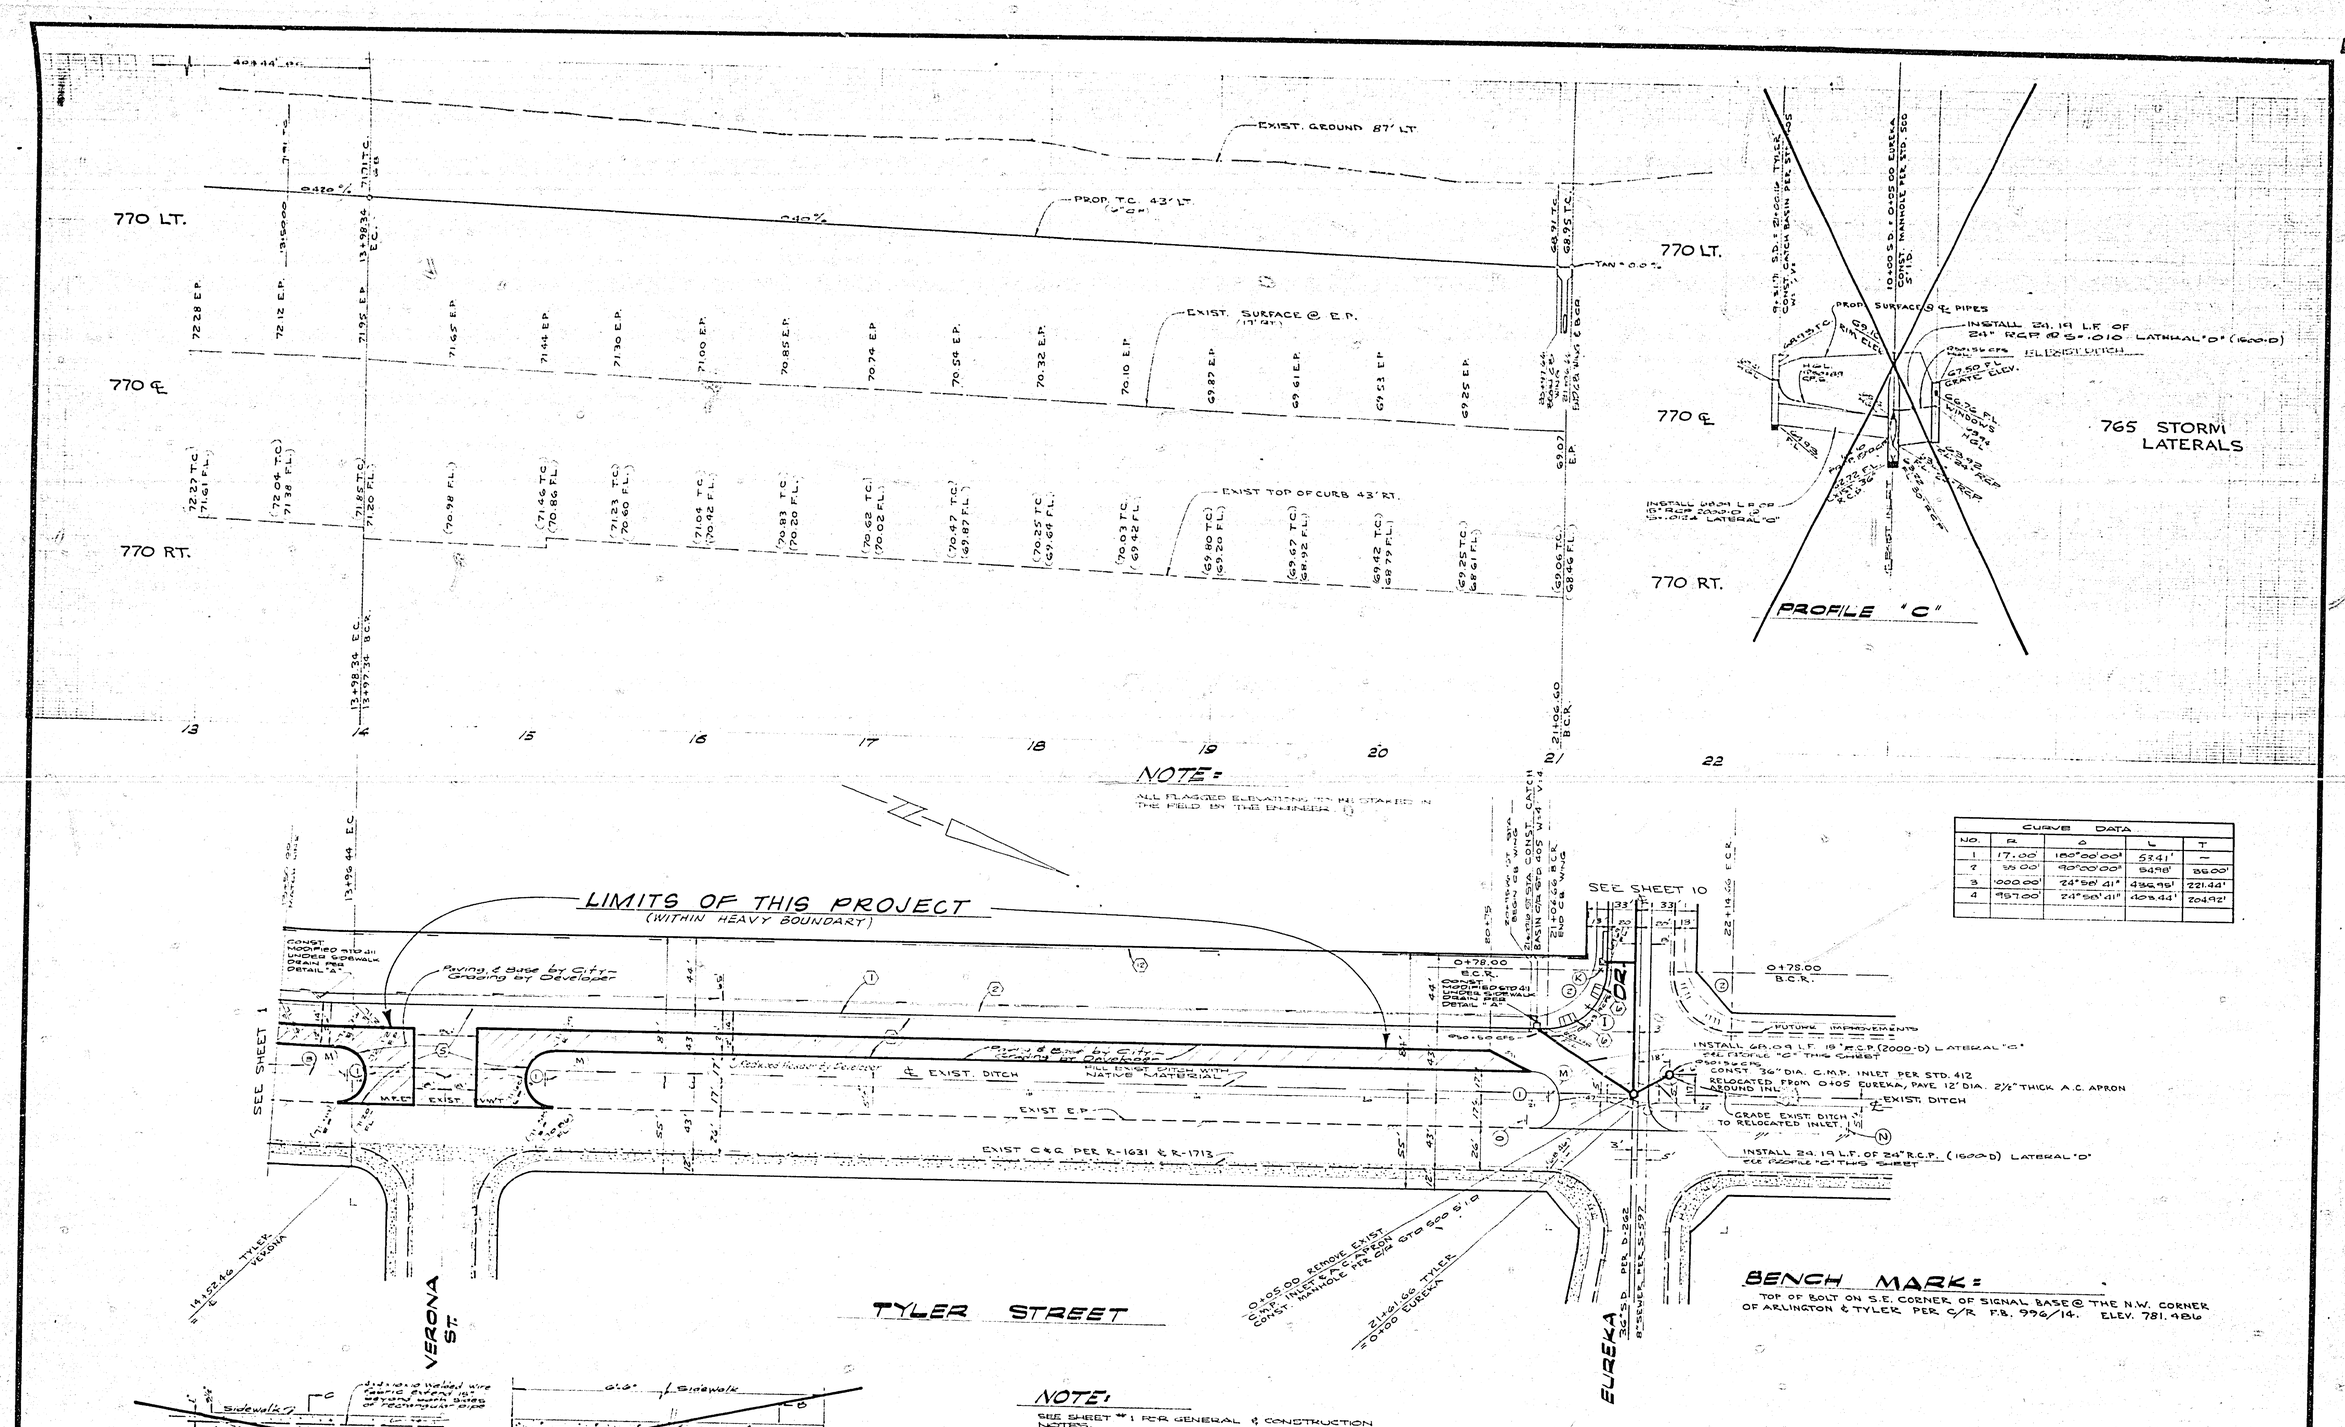

CURVE DATA				
NO.	R	Δ	L	T
1	17.00'	180°00'00"	53.41'	—
2	55.00'	90°00'00"	94.98'	55.00'
