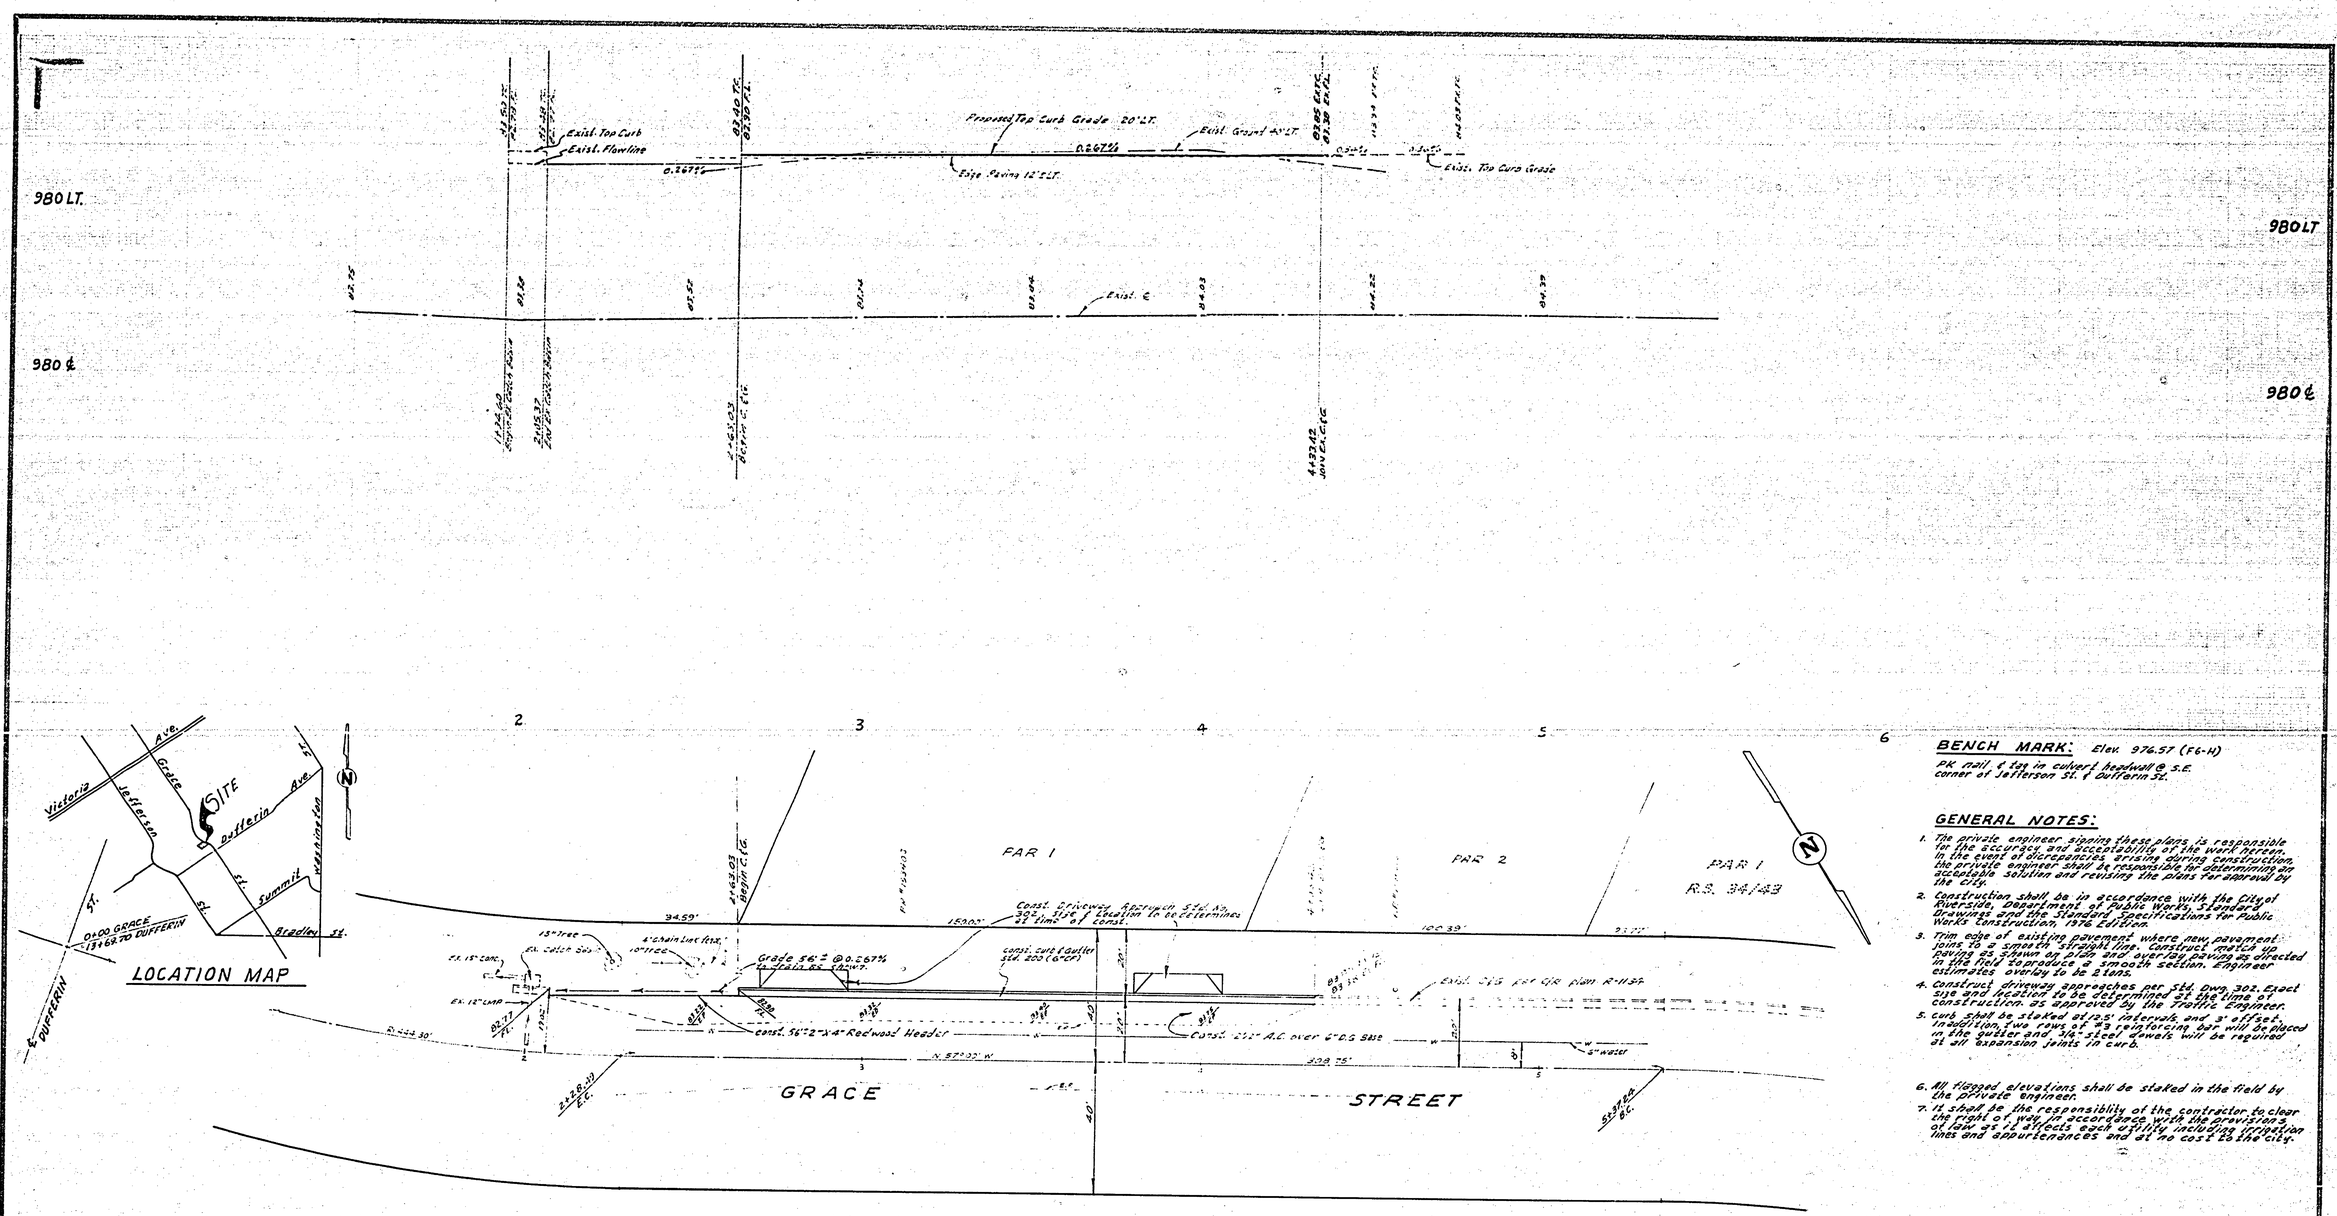

BENCH MARK: Elev. 976.57 (F6-H)

PK nail & tag in culvert headwall @ S.E. corner of Jefferson St. & Dufferin St.

GENERAL NOTES:

1. The private engineer signing these plans is responsible for the accuracy and acceptability of the work herein. In the event of discrepancies arising during construction, the private engineer shall be responsible for determining an acceptable solution and revising the plans for approval by the City.
2. Construction shall be in accordance with the City of Riverside, Department of Public Works, Standard Drawings and the Standard Specifications for Public Works Construction, 1976 Edition.
3. Trim edge of existing pavement where new pavement joins to a smooth straight line. Construct match up paving as shown on plan and overlay paving as directed in the field to produce a smooth section. Engineer estimates overlay to be 2 tons.
4. Construct driveway approaches per Std. Dwg. 302. Exact size and location to be determined at the time of construction as approved by the Traffic Engineer.
5. Curb shall be staked at 12.5' intervals, and 3' offset. In addition, two rows of #3 reinforcing bar will be placed in the gutter and 3/4" steel dowels will be required at all expansion joints in curb.
6. All flagged elevations shall be staked in the field by the private engineer.
7. It shall be the responsibility of the contractor to clear the right of way in accordance with the provisions of law as it affects each utility including irrigation lines and appurtenances and at no cost to the city.

*AS BUILT 6-79 KPT

INDEXED R.R.

ALBERT A. WEBB ASSOCIATES CIVIL ENGINEERS RIVERSIDE, CALIFORNIA APPROVED BY R. E. N. Webb DATE 5/15/78 R.E. No. 9876 No. 77-113 Tom L. Mazzetti	DESIGNED BY BEL DRAWN BY BEL CHECKED BY W.F.	CITY OF RIVERSIDE, CALIFORNIA DEPARTMENT OF PUBLIC WORKS APPROVED BY / BY / DATE PARK & RECREATION Bal 7/12 PARK DEVELOPMENT JL 7/12 TRAFFIC DIVISION JM 7/12 CITY ENGINEER Webb 7/13	APPROVED BY Robert Maltsberger DIRECTOR OF PUBLIC WORKS DATE 7/13/78

STREET PLAN AND PROFILE

GRACE ST.

BETWEEN DUFFERIN AVE. & VICTORIA AVE.

PARCEL MAP NO. 9925

SCALE 1"=20' Horiz., 1"=4' Vert.

ACCOUNT No.

DRAWING NUMBER **R-2120**

SHEET 1 OF 1

W.O. 77-113-A