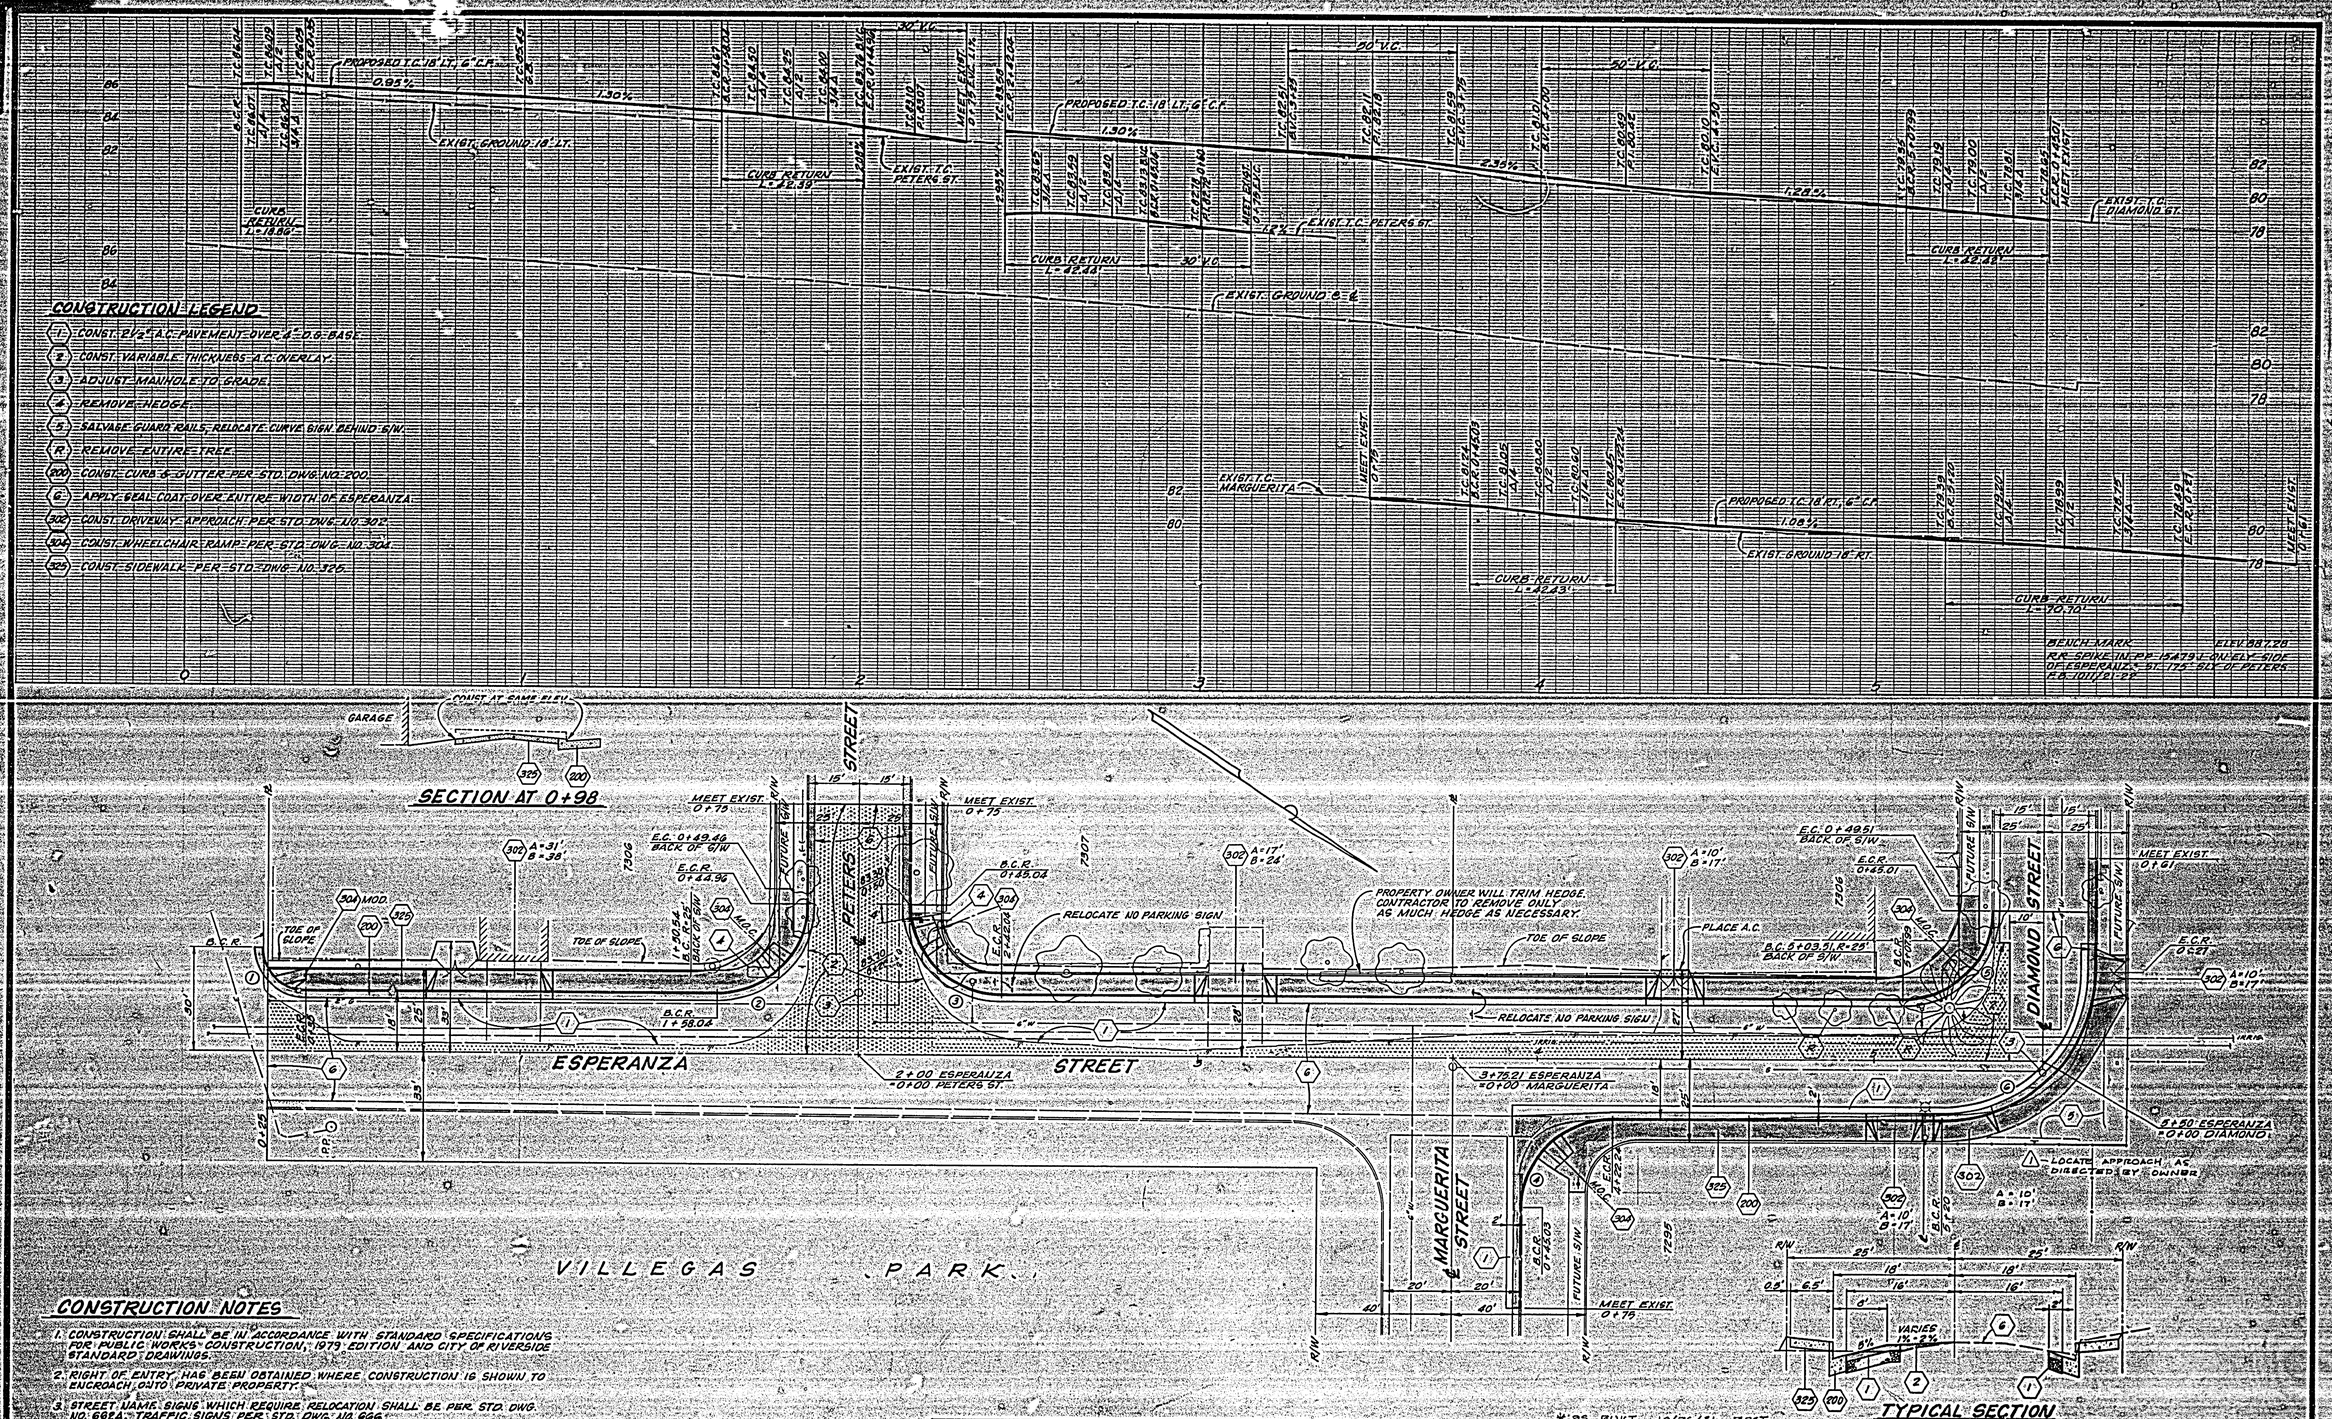

CONSTRUCTION LEGEND

1. CONST. 2½" A.C. PAVEMENT OVER 4" D.G. BASE.
2. CONST. VARIABLE THICKNESS A.C. OVERLAY.
3. ADJUST MANHOLE TO GRADE.
4. REMOVE HEDGE.
5. SALVAGE GUARD RAILS, RELOCATE CURVE SIGN BEHIND S/W.
R. REMOVE ENTIRE TREE.
200. CONST. CURB & GUTTER PER STD. DWG. NO. 200.
6. APPLY SEAL COAT OVER ENTIRE WIDTH OF ESPERANZA.
302. CONST. DRIVEWAY APPROACH PER STD. DWG. NO. 302.
304. CONST. WHEELCHAIR RAMP PER STD. DWG. NO. 304.
325. CONST. SIDEWALK PER STD. DWG. NO. 325.

CONSTRUCTION NOTES

1. CONSTRUCTION SHALL BE IN ACCORDANCE WITH STANDARD SPECIFICATIONS FOR PUBLIC WORKS CONSTRUCTION, 1979 EDITION AND CITY OF RIVERSIDE STANDARD DRAWINGS.
2. RIGHT OF ENTRY HAS BEEN OBTAINED WHERE CONSTRUCTION IS SHOWN TO ENCROACH ONTO PRIVATE PROPERTY.
3. STREET NAME SIGNS WHICH REQUIRE RELOCATION SHALL BE PER STD. DWG. NO. 662A, TRAFFIC SIGNS PER STD. DWG. NO. 666.

CURVE DATA

NO.	R	Δ	L	T
1	12'	90°03'	18.86'	12.01'
2	27'	89°57'	42.39'	26.98'
3	27'	90°03'	42.44'	27.02'
4	27'	90°02'20"	42.43'	27.02'
5	27'	90°00'51"	42.42'	27.01'
6	45'	90°00'51"	70.70'	45.01'

MARK	REVISIONS	APPR.	DATE
1	ADD APPROACH FOR 3122 JUANITA	[illegible]	1/29/80

DESIGNED BY [illegible] DRAWN BY KET CHECKED BY

* BS BUILT 10/26/81 BRET

CITY OF RIVERSIDE
PUBLIC WORKS DEPARTMENT

APPROVED BY
PRINCIPAL ENGINEER [illegible] 8/1
PARK DEPARTMENT [illegible] 8/1/79
TRAFFIC DIVISION [illegible] 7-31-79
CHIEF P. W. ENGINEER [illegible] 8-2

APPROVED BY [illegible]
PUBLIC WORKS DIRECTOR
DATE 8/2/79

ESPERANZA STREET HCD PROJECT 1977-78

FROM VILLEGAS PARK TO DIAMOND STREET

HORIZ. SCALE: 1" = 20' VERT. SCALE: 1" = 4'

ACCOUNT NO. 19-550-481

R-2125

SHEET 1 OF 1

FILE NO.

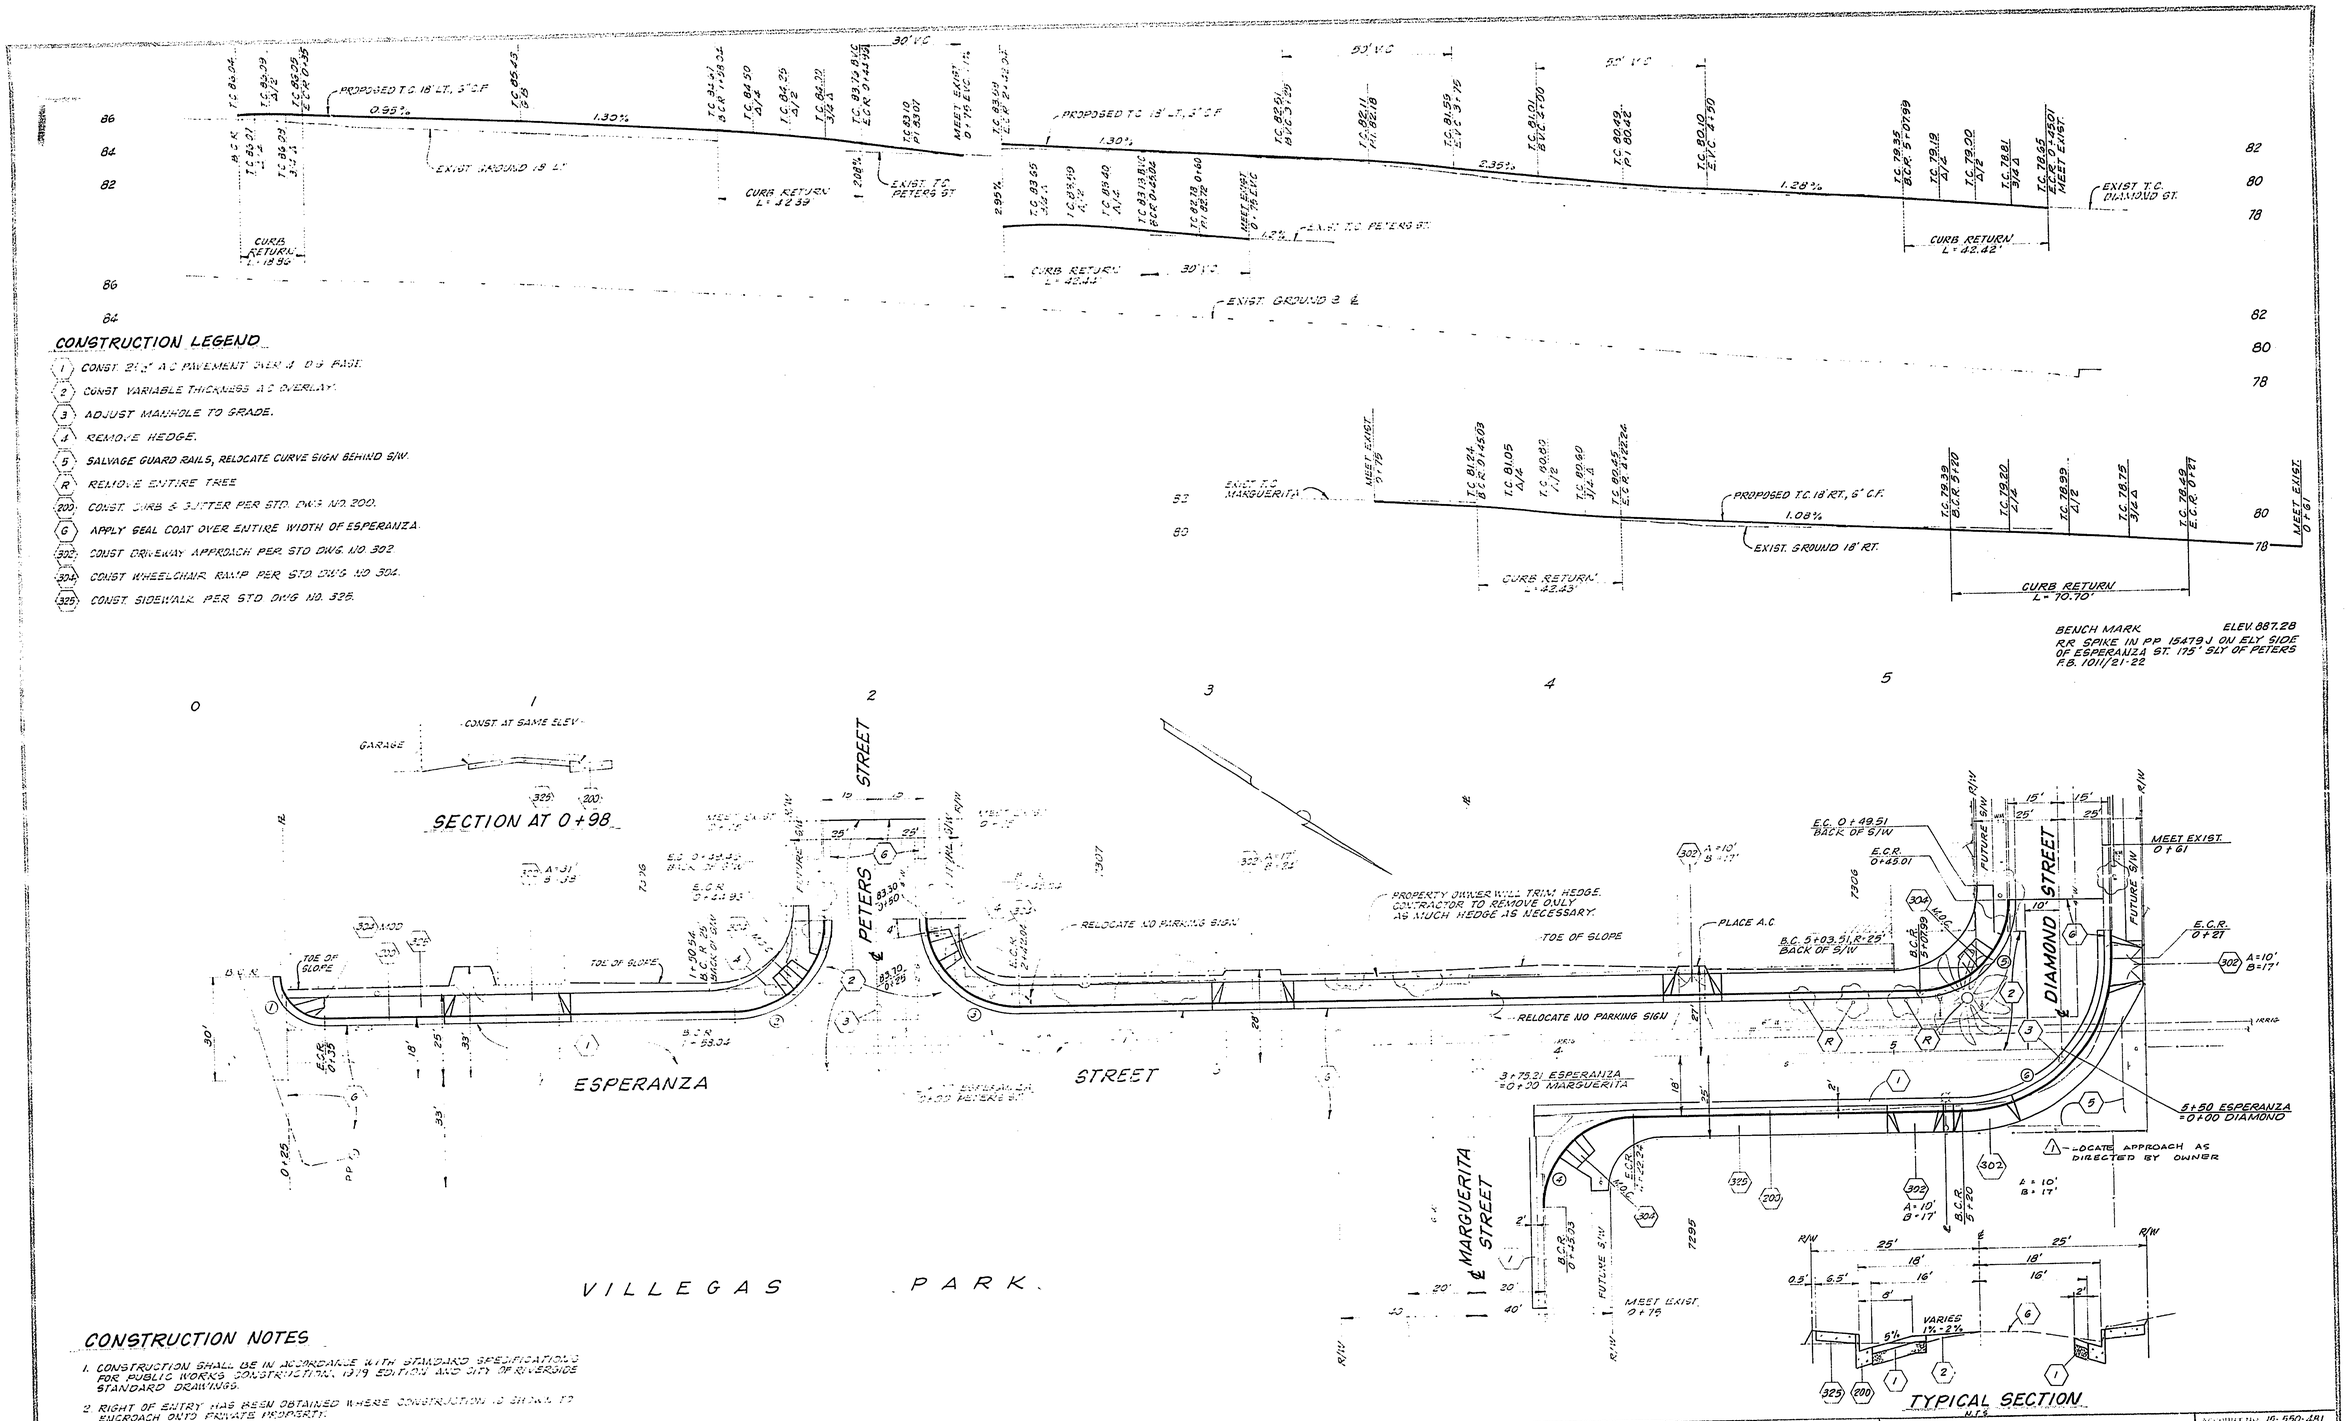

CONSTRUCTION LEGEND

1. CONST. 2½" A.C. PAVEMENT OVER 4" D.G. BASE.
2. CONST. VARIABLE THICKNESS A.C. OVERLAY.
3. ADJUST MANHOLE TO GRADE.
4. REMOVE HEDGE.
5. SALVAGE GUARD RAILS, RELOCATE CURVE SIGN BEHIND S/W.
R. REMOVE ENTIRE TREE
200. CONST. CURB & GUTTER PER STD. DWG. NO. 200.
G. APPLY SEAL COAT OVER ENTIRE WIDTH OF ESPERANZA.
302. CONST. DRIVEWAY APPROACH PER STD. DWG. NO. 302.
304. CONST. WHEELCHAIR RAMP PER STD. DWG. NO. 304.
325. CONST. SIDEWALK PER STD. DWG. NO. 325.

CONSTRUCTION NOTES

1. CONSTRUCTION SHALL BE IN ACCORDANCE WITH STANDARD SPECIFICATIONS FOR PUBLIC WORKS CONSTRUCTION, 1979 EDITION AND CITY OF RIVERSIDE STANDARD DRAWINGS.
2. RIGHT OF ENTRY HAS BEEN OBTAINED WHERE CONSTRUCTION IS SHOWN TO ENCROACH ONTO PRIVATE PROPERTY.
3. STREET NAME SIGNS WHICH REQUIRE RELOCATION SHALL BE PER STD. DWG. NO. 662A, TRAFFIC SIGNS PER STD. DWG. NO. 656.

CURVE DATA

NO.	R	Δ	L	T
1	12'	90°03'	18.86'	12.01'
2	21'	89°57'	42.39'	26.98'
3	27'	90°03'	42.44'	27.02'
4	27'	90°02'20"	42.43'	27.02'
5	27'	90°00'51"	42.42'	27.01'
6	45'	90°00'51"	70.70'	45.01'

1 ADD APPROACH FOR 3122 JUANITA

KPT

CITY OF RIVERSIDE
PUBLIC WORKS DEPARTMENT

ESPERANZA STREET HCD PROJECT 1977-78

FROM VILLEGAS PARK TO DIAMOND STREET

SHEET SCALE 1" = 20' VERT. SCALE 1" = 4'

ACCOUNT NO. 15-550-481

R-2125

SHEET 1 OF 1

FILE NO.