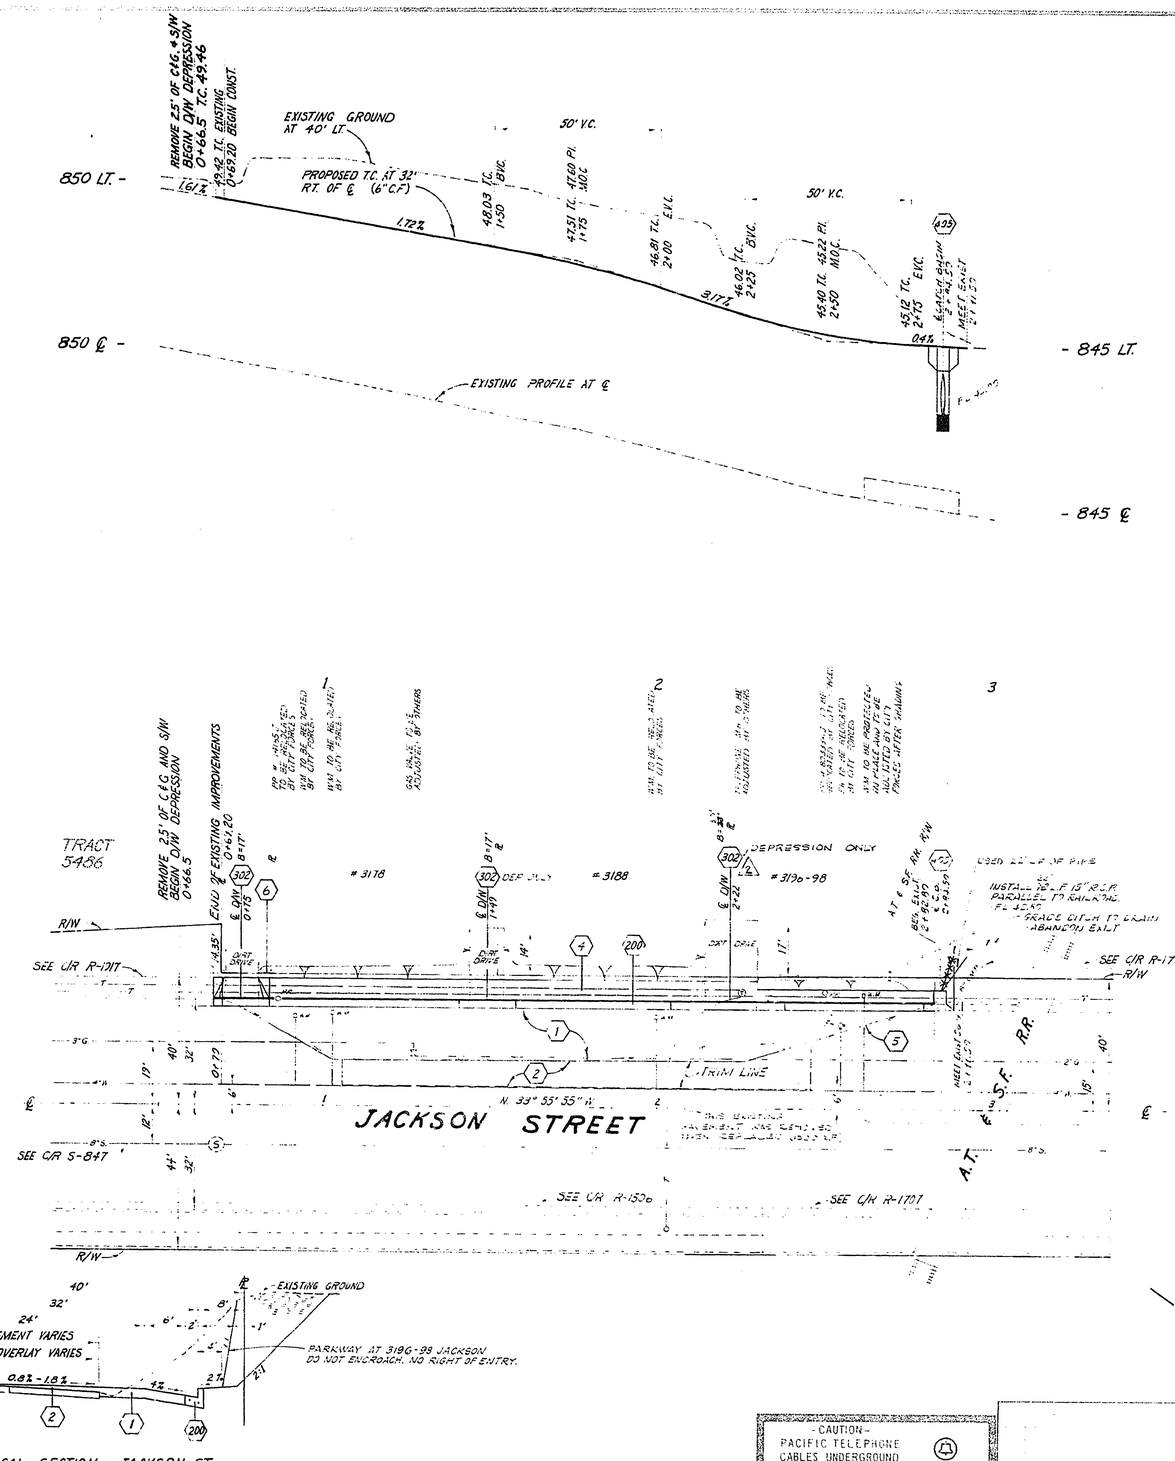

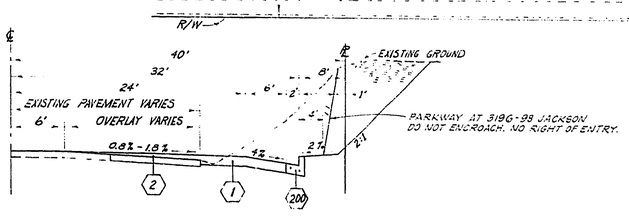

TYPICAL SECTION - JACKSON ST.
NOT TO SCALE
T.I. = 7

BENCH MARK:
601-22 CSDH BRONZE DISC IN MON. VAULT CAPPED AT INTERSECTION OF DIANA ST. AND JACKSON ST.

CONSTRUCTION NOTES:

1. CONSTRUCTION SHALL BE IN ACCORDANCE WITH THE CITY OF RIVERSIDE, DEPARTMENT OF PUBLIC WORKS, STANDARD DRAWINGS, AND THE STANDARD SPECIFICATIONS FOR PUBLIC WORKS CONSTRUCTION, 1979 EDITION.
2. TRIM EDGE OF EXISTING PAVEMENT WHERE NEW PAVEMENT JOINS TO A SMOOTH, STRAIGHT LINE. CONSTRUCT MATCH-UP PAVING AS SHOWN ON PLAN AND OVERLAY PAVING AS DIRECTED IN THE FIELD TO PRODUCE A SMOOTH SECTION.
3. RIGHTS OF ENTRY HAVE BEEN OBTAINED FOR WORK SHOWN ON PRIVATE PROPERTIES.
4. ~~CONTRACTOR TO GIVE CITY WATER DIVISION FIVE (5) WORKING DAYS WRITTEN NOTICE PRIOR TO START OF CONSTRUCTION AND TO ALLOW CITY TEN (10) WORKING DAYS FOR COMPLETION OF WORK.~~

(200) CONSTRUCT CURB AND GUTTER PER STD. DWG. NO. 200, 6" C.F.

(302) CONSTRUCT DRIVEWAY APPROACH PER STD. DWG. NO. 302

(1) CONSTRUCT 2½" A.C. OVER 4" CRUSHED BASE.

(2) OVERLAY EXISTING PAVEMENT WITH VARIABLE THICKNESS A.C. TO LIMITS SHOWN ON PLANS.

(405) CONSTRUCT CATCH BASIN PER STD. DWG. NO. 405.

(4) GRADE WALKWAY AND DRIVEWAYS TO LIMITS SHOWN ON PLAN.

(5) REMOVE EXISTING A.C. BERM.

(6) FENCE TO REMAIN AT EXISTING LOCATION. FENCE POLES TO BE ADJUSTED AS REQUIRED.

- CAUTION -
PACIFIC TELEPHONE
CABLES UNDERGROUND
BEFORE EXCAVATING
CALL COLLECT

CHANGED NOTES 1 & 4

R.C. R.C.

CITY OF RIVERSIDE
PUBLIC WORKS DEPARTMENT

JACKSON STREET WIDENING

SOUTHERLY OF A.T.&S.F. R.R., WESTERLY SIDE OF JACKSON STREET

HORIZ. SCALE: 1" = 20' VERT. SCALE: 1" = 2'

SUBMITTED 30-575-241

R-2126

SHEET 1 OF 1

FILE NO.