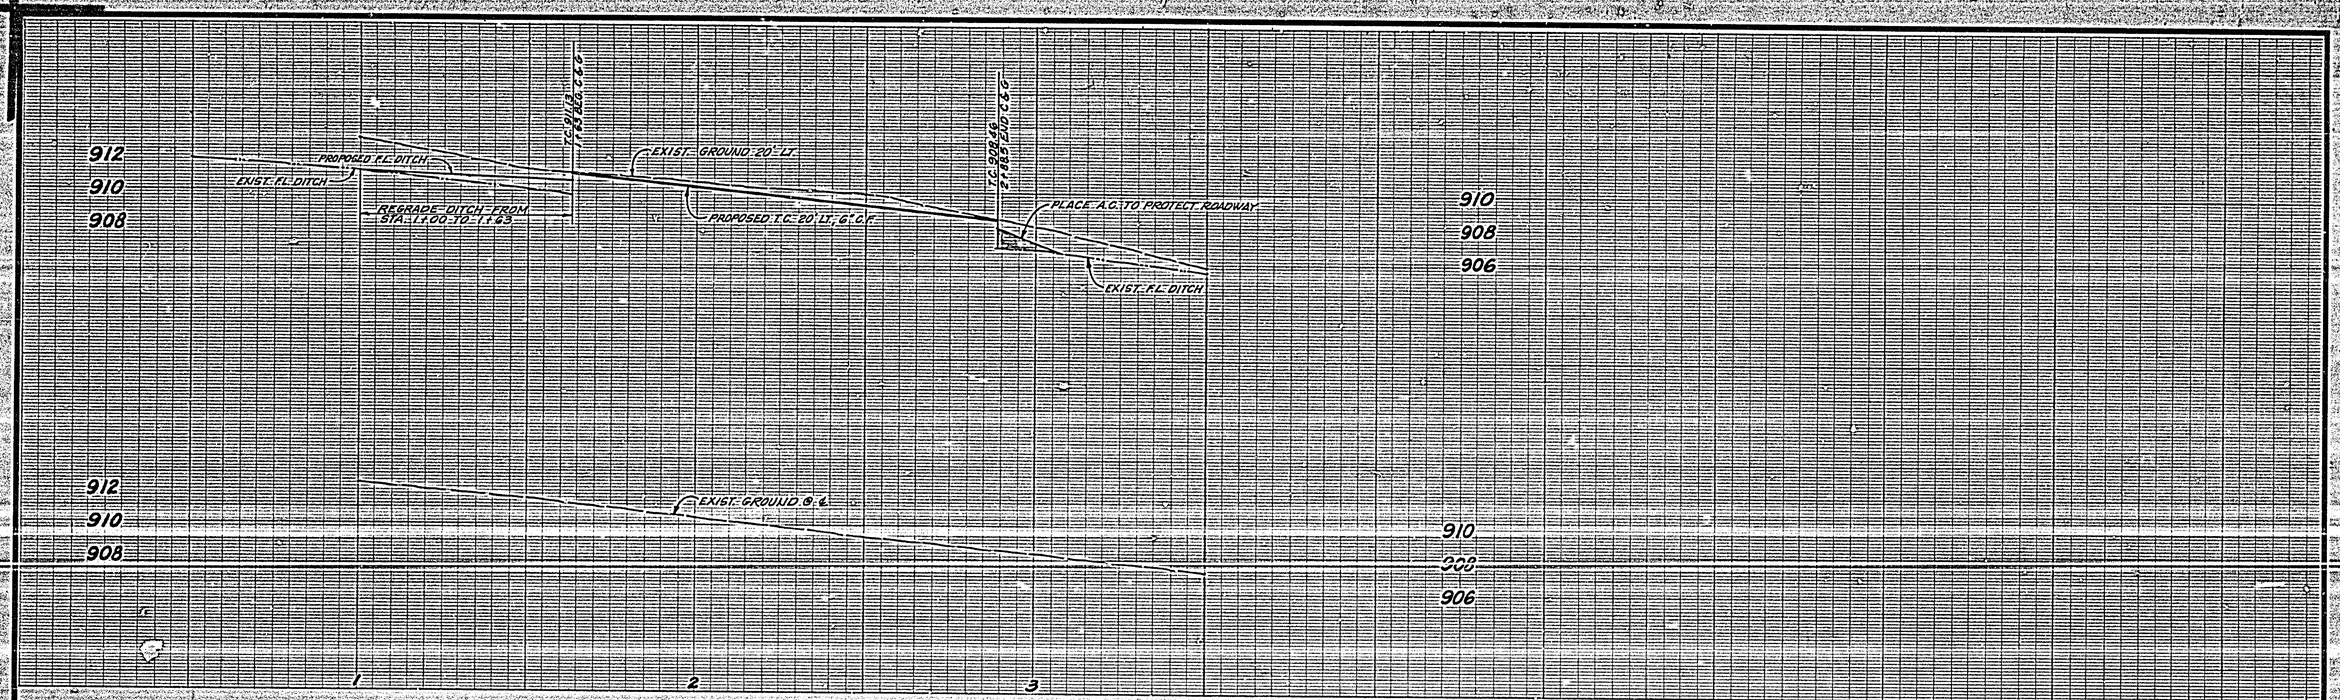

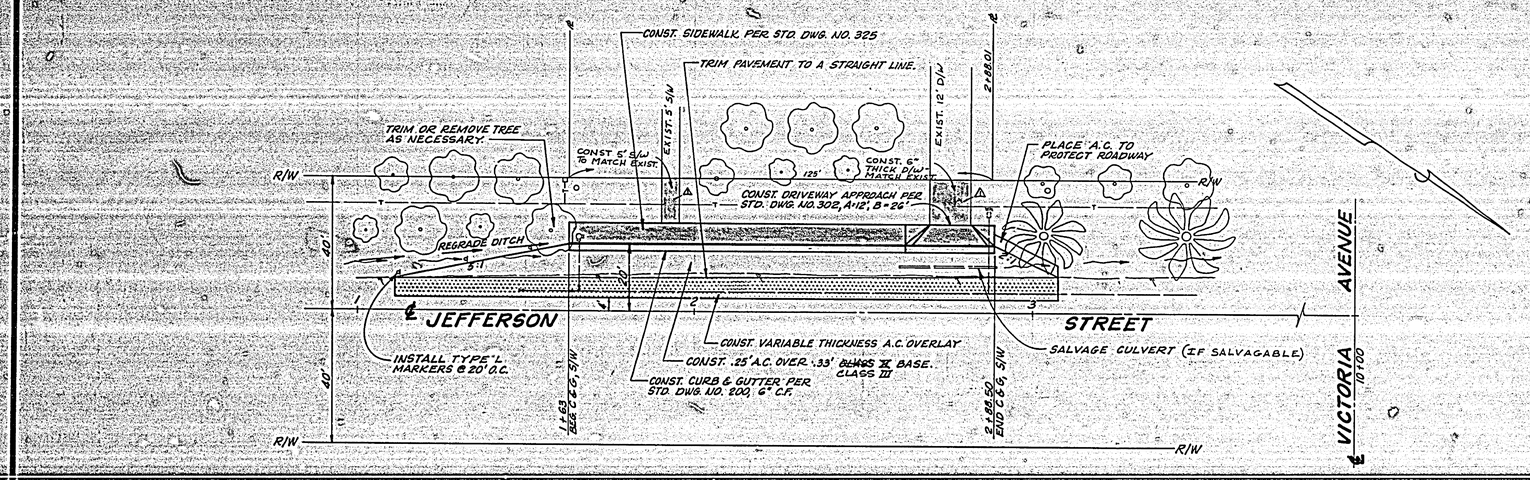

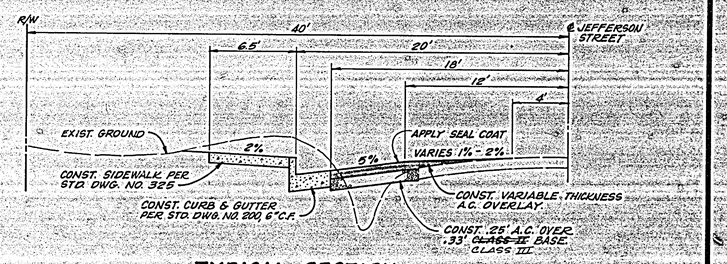

TYPICAL SECTION

NOT TO SCALE
T.I. = 6

CONSTRUCTION NOTES

1. CONSTRUCTION SHALL BE IN ACCORDANCE WITH STANDARD SPECIFICATIONS FOR PUBLIC WORKS CONSTRUCTION, 1976 EDITION AND CITY OF RIVERSIDE STANDARD DRAWINGS.

MARK	REVISIONS	APPR.	DATE
△	Added D/W & S/W Match-up sections	[illegible]	10/2/79

DESIGNED BY [illegible] DRAWN BY KPT CHECKED BY

CITY OF RIVERSIDE
PUBLIC WORKS DEPARTMENT

APPROVED BY
PRINCIPAL ENGINEER
PARK DEPARTMENT
TRAFFIC DIVISION
CHIEF P. W. ENGINEER

APPROVED BY
PUBLIC WORKS DIRECTOR
DATE 6/18/79

* AS BUILT 10-27-5 BRET

JEFFERSON ST. WIDENING FOR FIRE STATION NO. 10

800' SOUTHEASTERLY OF VICTORIA AVE.

HORIZ. SCALE: 1" = 20' VERT. SCALE: 1" = 4'

ACCOUNT NO. 33-580-575

R-2193

SHEET 1 OF 1

FILE NO.