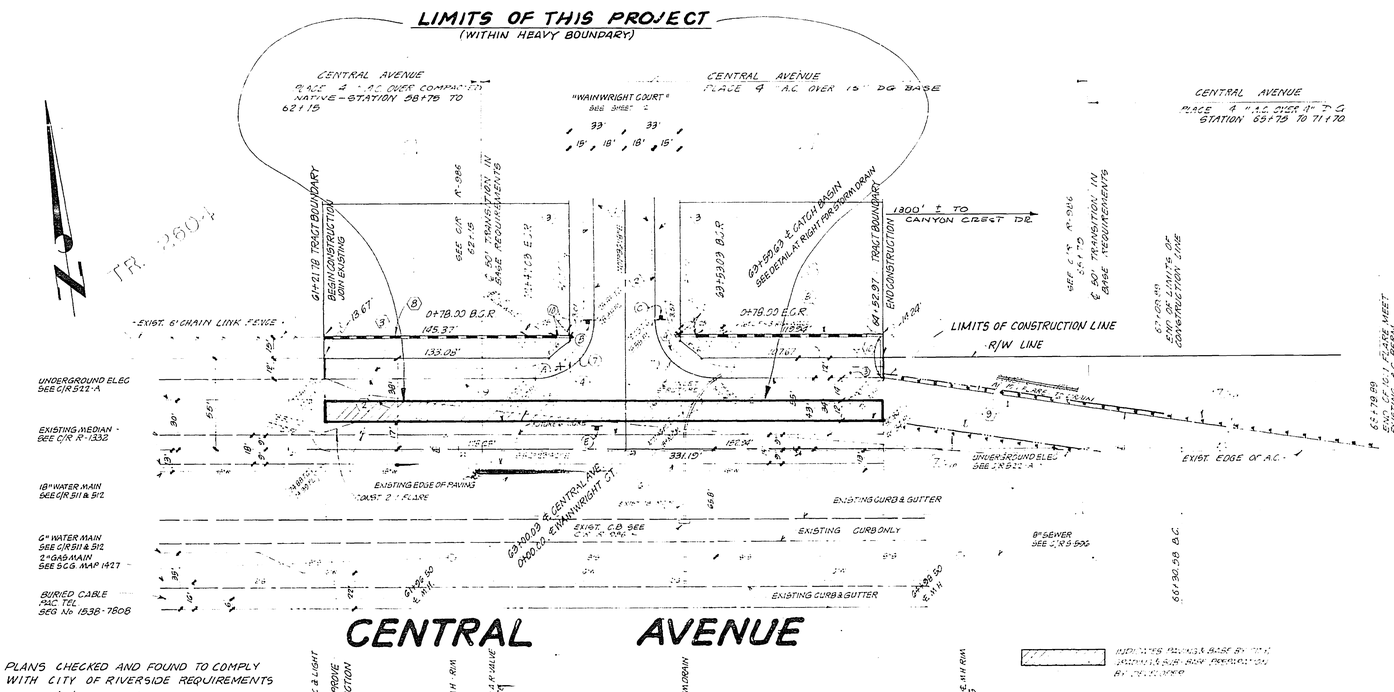

PLANS CHECKED AND FOUND TO COMPLY WITH CITY OF RIVERSIDE REQUIREMENTS

by: [signature] 10/3/79
C.G. ENGINEERING DATE

BENCH MARK

P.K. NAIL & CITY TAG AT BC STA. 66+30.58 ON E'LY CURB CENTER DIVIDER CENTRAL AVE. & FRONTAGE ROAD ELEV 1080.96

Contractor agrees that he shall assume sole and complete responsibility for on site conditions during the course of construction of this Project including safety of all persons and property; that this requirement shall apply continuously and not be limited to normal working hours; and that the Contractor shall defend, indemnify and hold the Owner and the Engineer harmless from any and all liability, real or alleged, in connection with the performance of work on this Project, except for liability arising from the sole negligence of the Owner or the Engineer.

GENERAL NOTES

1. IT SHALL BE THE RESPONSIBILITY OF THE CONTRACTOR TO CLEAR THE RIGHT OF WAY IN ACCORDANCE WITH THE PROVISIONS OF LAW AS IT AFFECTS EACH UTILITY INCLUDING IRRIGATION LINES, AND AT NO COST TO THE CITY.
2. CONSTRUCTION SHALL BE IN ACCORDANCE WITH THE CITY OF RIVERSIDE, DEPARTMENT OF PUBLIC WORK; STANDARD DRAWINGS AND SPECIFICATIONS FOR PUBLIC WORKS, CONSTRUCTION, 1979 EDITION.
3. ~~PRIME COAT~~, SEAL COAT, AND PAINT BINDER ARE REQUIRED.
4. NOTICE TO CONTRACTOR: THE EXISTENCE AND LOCATION OF ANY UNDERGROUND UTILITY PIPES OR STRUCTURES SHOWN ON THESE PLANS WERE OBTAINED BY A SEARCH OF THE AVAILABLE RECORDS. TO THE BEST OF OUR KNOWLEDGE THERE ARE NO EXISTING UTILITIES EXCEPT AS SHOWN ON THESE PLANS. THE CONTRACTOR IS REQUIRED TO TAKE PRECAUTIONARY MEASURES TO PROTECT THE UTILITY LINES SHOWN AND ANY OTHER LINES, NOT OF RECORD OR NOT SHOWN ON THESE PLANS.

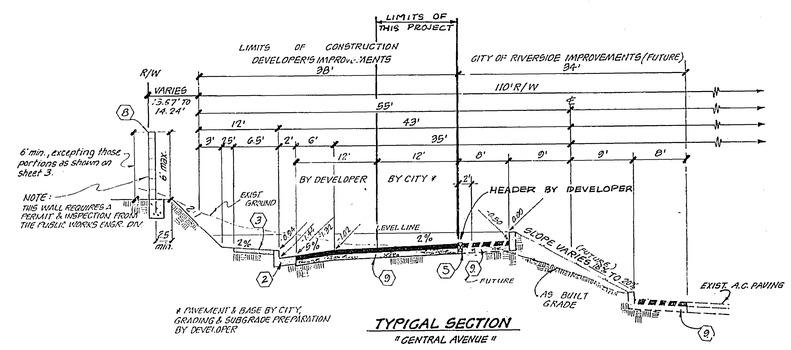

TYPICAL SECTION
"CENTRAL AVENUE"
TYP. 7
NO SCALE

*AS BUILT 6/10/81 BMET

Indexed RMF

J. F. DAVIDSON ASSOCIATES
CIVIL ENGINEERS · SURVEYORS · PLANNERS
RIVERSIDE, CALIFORNIA
APPROVED BY [signature] DATE 4/24/78
R.E. No 17550
NO 6427 FOR ROBERT E. OSBORNE F.D.

MARK REVISIONS APPR. DATE
DESIGNED BY [illegible] DRAWN BY [illegible] CHECKED BY [illegible]

CITY OF RIVERSIDE, CALIFORNIA
DEPARTMENT OF PUBLIC WORKS

APPROVED BY	BY	DATE
PRINCIPAL ENGINEER	[illegible]	11/1/80
PARK DEPARTMENT		
TRAFFIC DIVISION	[illegible]	1/20/80
CHIEF P. W. ENGR.	[illegible]	1-30

APPROVED BY [signature]
DIRECTOR OF PUBLIC WORKS
DATE 1/30/80

STREET PLAN & PROFILE
CENTRAL AVE. PAVEMENT PARTICIPATION W/ TRACT - 9566
AT WAINRIGHT COURT.
HORIZ. SCALE: 1" 40' VERT. SCALE: 1" 4'

PROJECT NO. 30-575-306
R-2208A
SHEET 1 OF 1
FILE NO. 5567

(ADAPTED FROM PLAN R-2208)