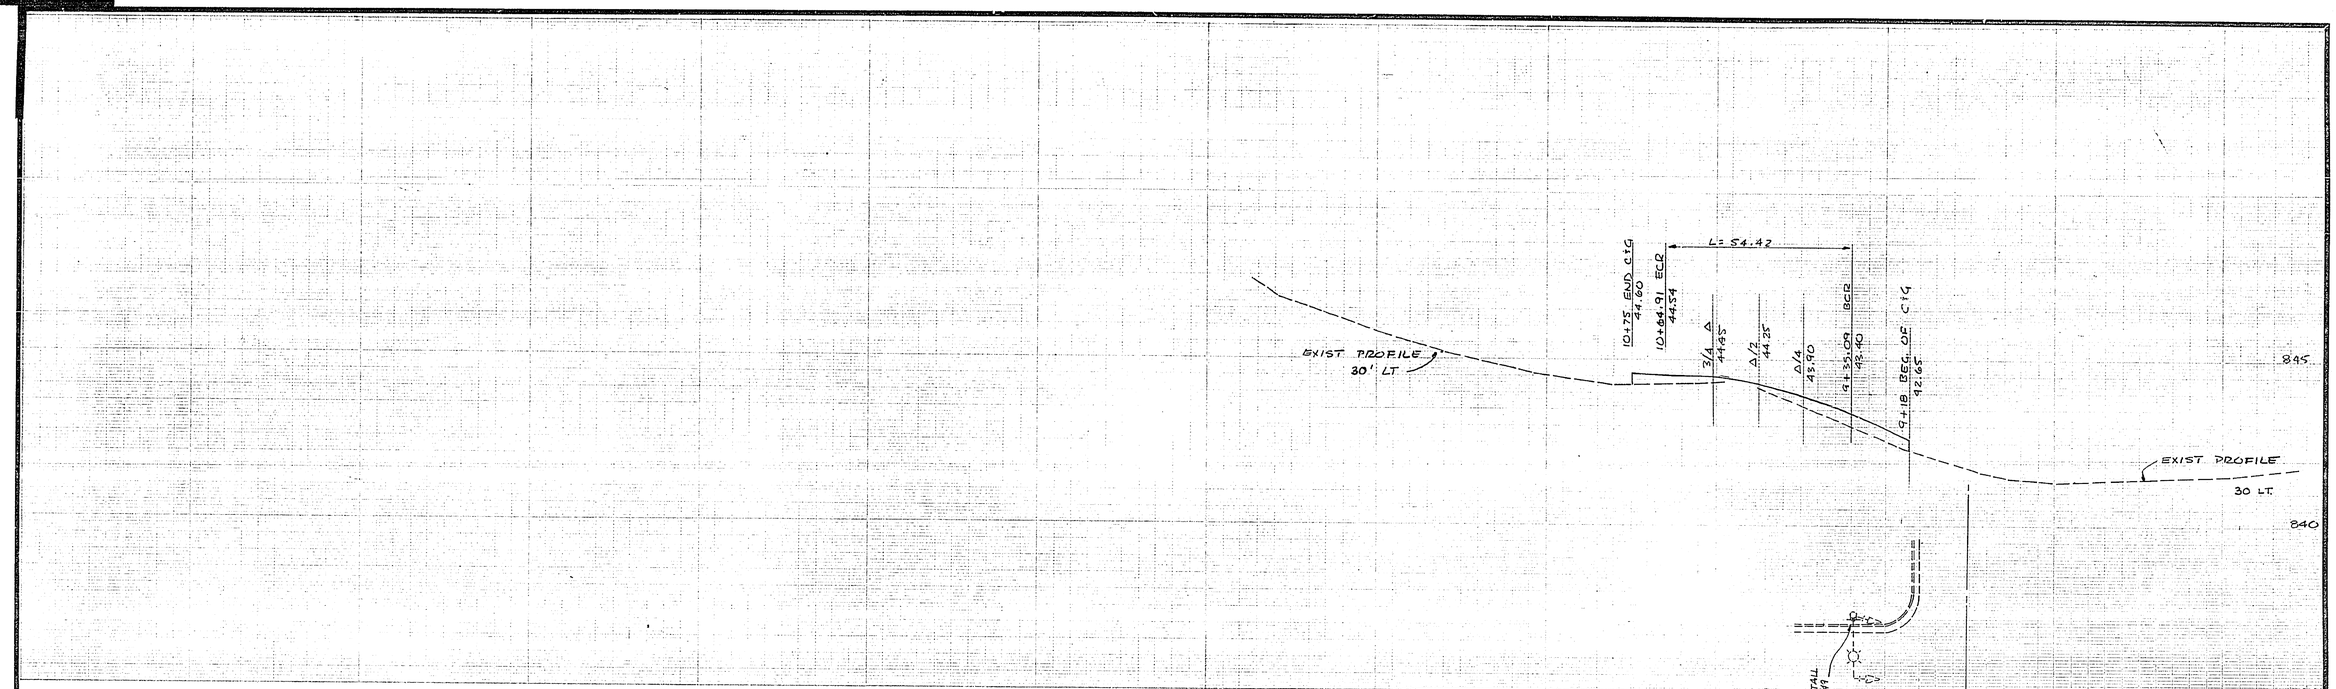

CONSTRUCTION NOTES

1. CONSTRUCTION TO BE IN ACCORDANCE WITH STANDARD SPECIFICATIONS FOR PUBLIC WORKS CONSTRUCTION, 1979 EDITION AND CITY OF RIVERSIDE STANDARD DRAWINGS.

LEGEND

- (200) CONST. P.C.C. CURB AND GUTTER AS PER STD. DWG # 200, 6" C.F.
- (250) CONST. A.C. BERM, TYPE I, AS PER STD. DWG. NO. 250
- (1) INSTALL FLEXIBLE DELINEATORS GLUED TO EXISTING PAVEMENT @ 20' CENTERS AS PER. SPECIFIED PROVISIONS.
- (2) REMOVE EXISTING CURB ALONG ONE SIDE OF ISLAND.
- (3) RESURFACE AREA W/ 3" A.C. OVER 4" OF CLASS II A.B.
- (304) CONSTRUCT WHEELCHAIR RAMPS AS PER STD. DWG. NO. 304
- (4) SALVAGE SIGNS (6 SIGNS)

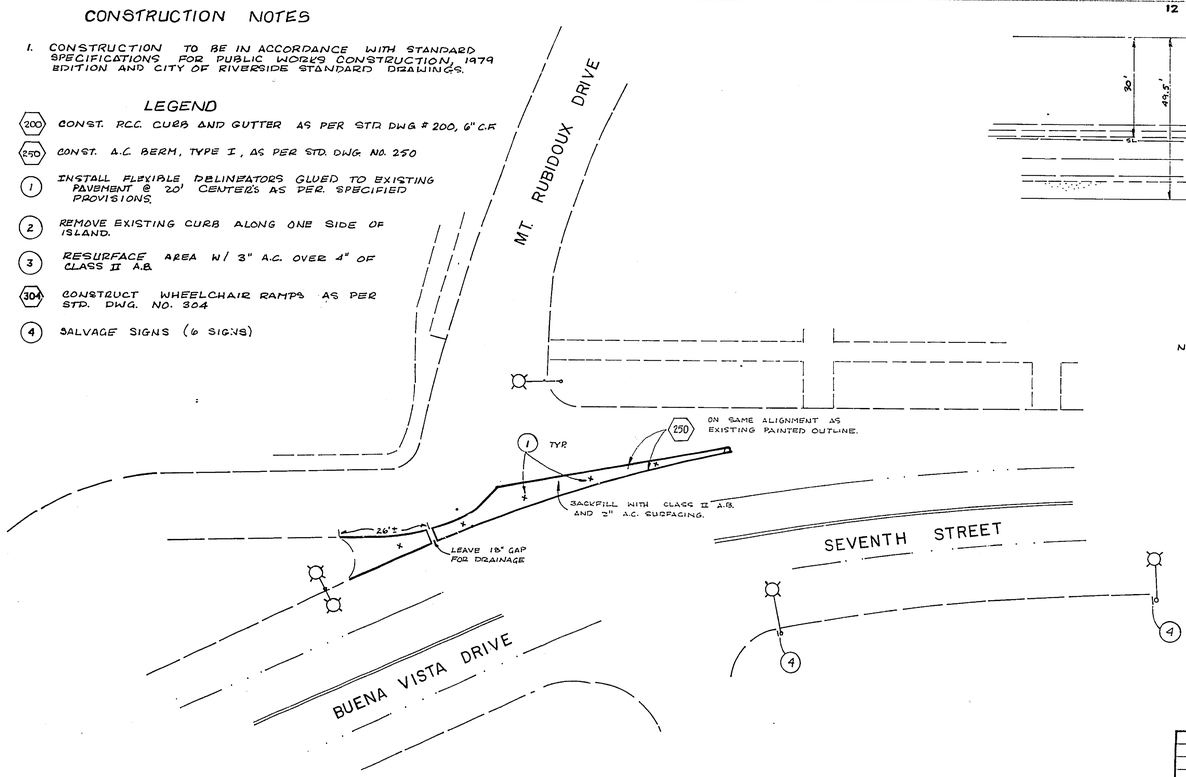

NOTE: (SEE TRAFFIC SIGNAL PLAN X-118 FOR DETAILS)

1.) DETECTOR LOOPS, PULLBOXES AND STANDARD WILL BE LOCATED IN THE FIELD BY THE TRAFFIC ENG. OR HIS REPRESENTATIVE.
2.) DETECTOR LOOPS SHALL BE INSTALLED IN THE PRESENCE OF THE TRAFFIC ENG. OR HIS REPRESENTATIVE.
3.) SPLICES WILL NOT BE ALLOWED
4.) CONDUITS SHALL BE T.W.
5.) ADD #14 CONDUCTORS FOR PEDESTRIAN INDICATIONS AND PEDESTRIAN PUSH BUTTONS. (PEDESTRIAN PUSH BUTTONS TO HAVE SEPARATE CONDUCTORS). RUN △ SHALL HAVE NEW CONDUCTORS AND △ SHALL HAVE SOME NEW CONDUCTORS (ADDITIONS).
6). CONTRACTOR SHALL OBTAIN INFORMATION FOR DRILLING 56 A3 STANDARD FROM P.U.M.C.O.

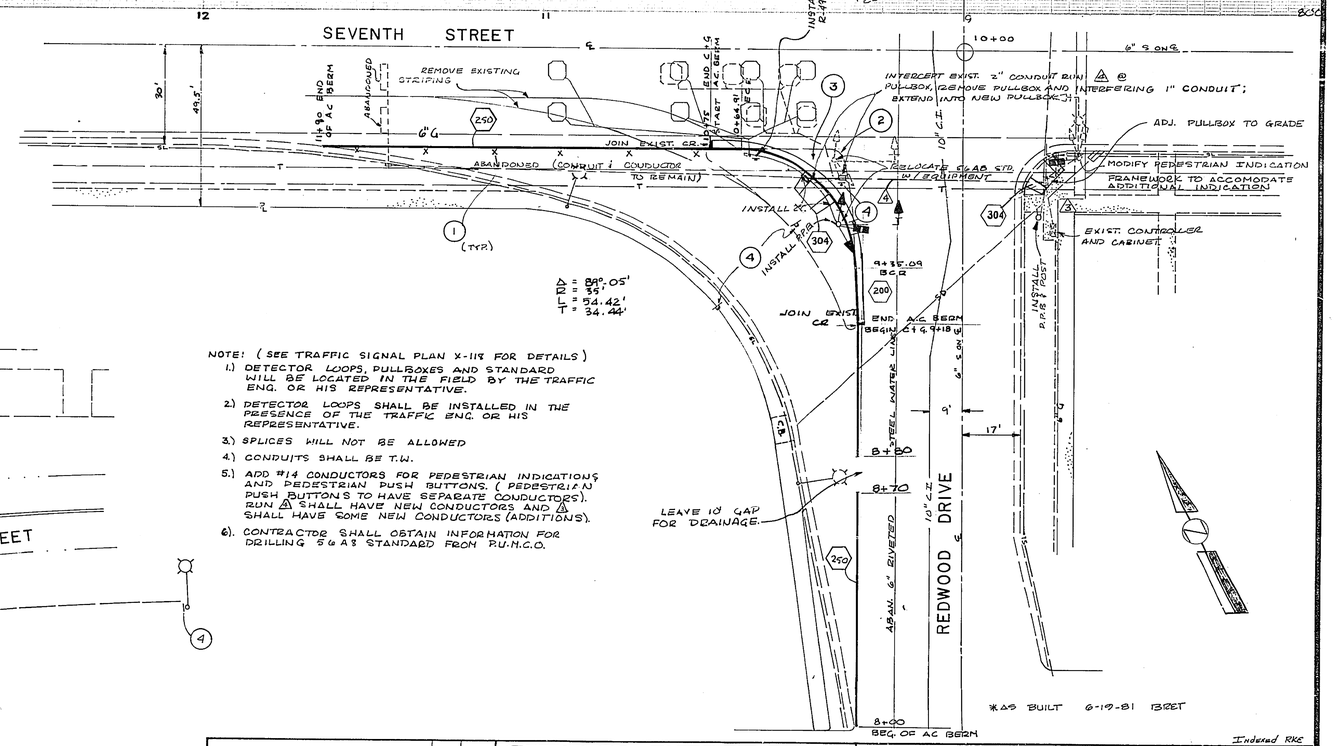

Indexed RKE

MARK	REVISIONS	APPR.	DATE

DESIGNED BY [illegible] DRAWN BY [illegible] CHECKED BY

CITY OF RIVERSIDE
PUBLIC WORKS DEPARTMENT

APPROVED BY		
PRINCIPAL ENGINEER	[illegible]	7/22/80
PARK DEPARTMENT		
TRAFFIC DIVISION	[illegible]	7/21/80
CHIEF P.W. ENGINEER	[illegible]	7-29

APPROVED BY [signature]
PUBLIC WORKS DIRECTOR
DATE 3/3/80

REDWOOD AND SEVENTH STREET
ELIMINATION OF FREE
TURN LANE

WESTERLY CORNER OF REDWOOD DRIVE AND SEVENTH STREET

HORIZ. SCALE: 1" - 20' VERT. SCALE: 1" -

ACCOUNT NO. 30-572-308

R-2234

SHEET 1 OF 1

FILE NO.