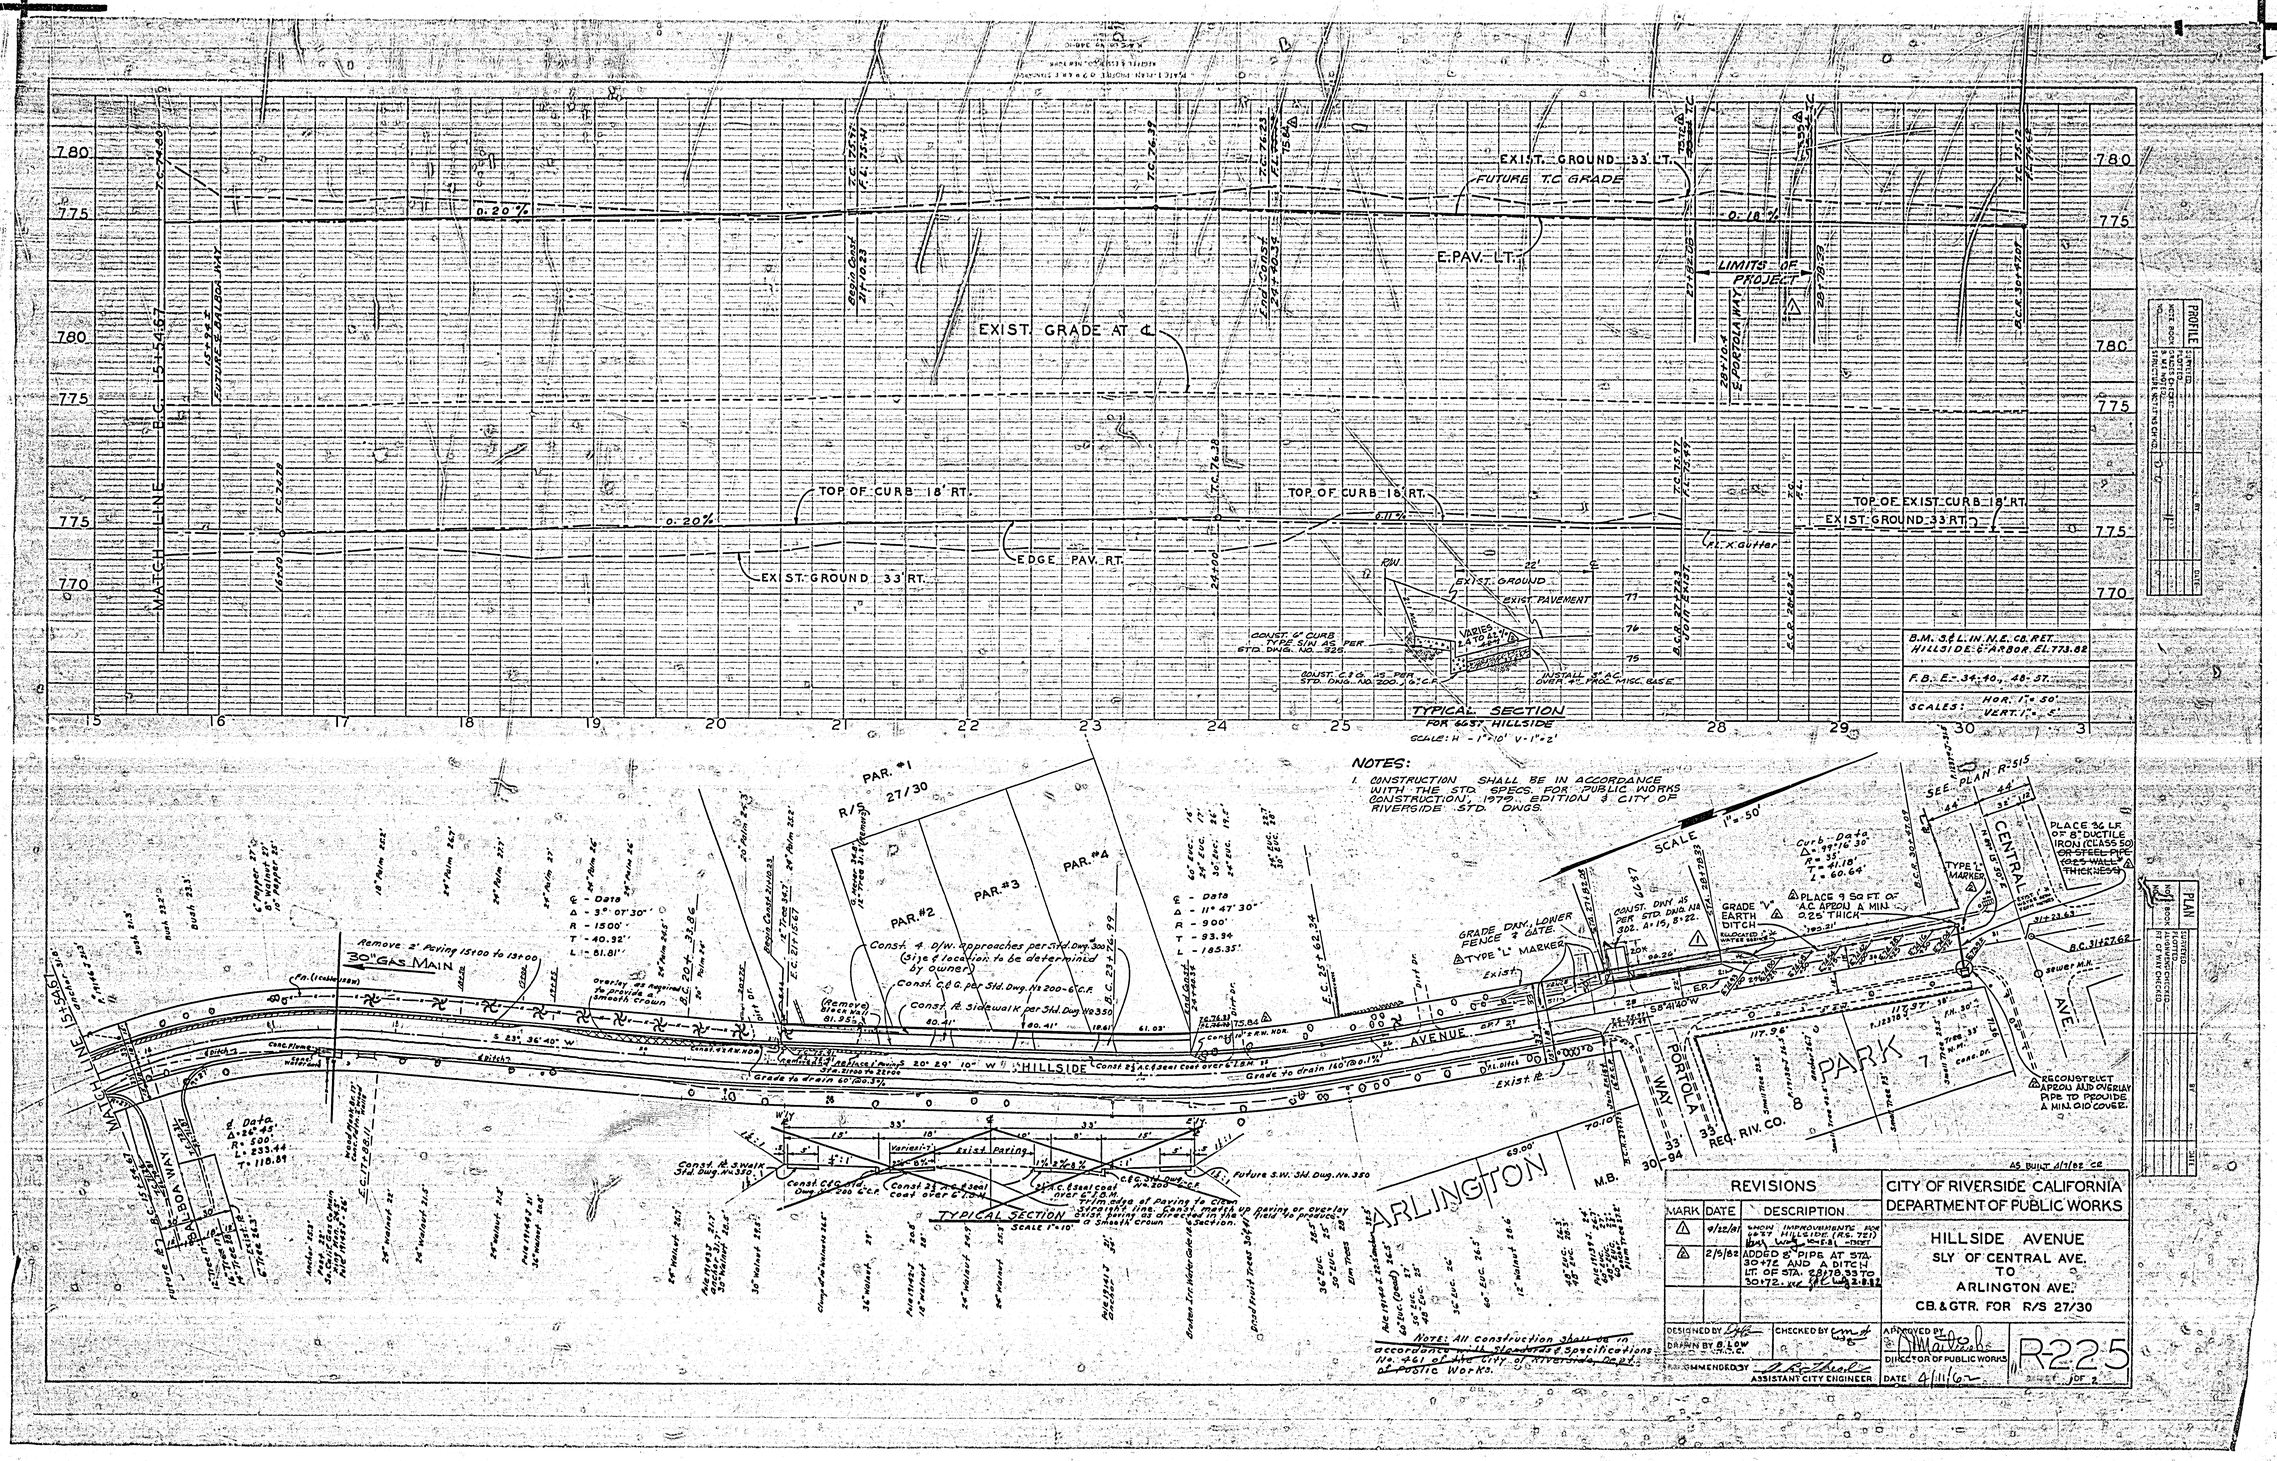
PROFILE
EXIST. GROUND 33' LT.
FUTURE T.C. GRADE
0.18%
E. PAV. LT.
LIMITS OF PROJECT
E. PORTOLA WAY
EXIST. GRADE AT ℄
MATCH LINE P.C. 15+54.67
FUTURE PORTOLA WAY
0.20%
TOP OF CURB 18' RT.
EDGE PAV. RT.
EXIST. GROUND 33' RT.
6.11%
TOP OF EXIST. CURB 18' RT.
EXIST. GROUND 33' RT.
Fl. X Gutter
EXIST. GROUND
EXIST. PAVEMENT
CONST. 6" CURB TYPE S1N AS PER STD. DWG. NO. 326
CONST. C&G AS PER STD. DWG. NO. 200 / 6" C.F.
INSTALL 3" A.C. OVER 4" PROC. MISC. BASE
TYPICAL SECTION FOR EAST HILLSIDE
SCALE: H - 1"=10' V - 1"=2'
B.M. 3¢ L.IN N.E. CB. RET. HILLSIDE: 6" ARBOR. EL. 773.82
F.B. E-34:40, 48:37.
SCALES: HOR. 1"=50' VERT. 1"=5'
NOTES:
1. CONSTRUCTION SHALL BE IN ACCORDANCE WITH THE STD. SPECS. FOR PUBLIC WORKS CONSTRUCTION, 1972 EDITION & CITY OF RIVERSIDE STD. DWGS.
PLAN
PAR. #1
PAR. #2
PAR. #3
PAR. #4
R/S 27/30
30" GAS MAIN
Remove 2' Paving 15+00 to 13+00
Const. 4 D/W. approaches per Std. Dwg. 300 (size & location to be determined by owner)
Const. C&G per Std. Dwg. No 200-6" C.F.
Const. 4' Sidewalk per Std. Dwg. No 350
Grade to drain 60' @ 0.3%
Grade to drain 160' @ 0.1%
HILLSIDE AVENUE
MATCH LINE
PORTOLA WAY
ARLINGTON
PARK
CENTRAL AVE.
SEE PLAN R-2515
PLACE 36 LF OF 8" DUCTILE IRON (CLASS 50 OR STEEL PIPE .125 WALL THICKNESS)
PLACE 9 SQ FT OF A.C. APRON A MIN 0.25 THICK
GRADE "V" EARTH DITCH
GRADE DIV. LOWER FENCE & GATE.
TYPE "L" MARKER
CONST. DWG. AS PER STD. DWG. NO. 302. A-15, B-22.
RECONSTRUCT APRON AND OVERLAY PIPE TO PROVIDE A MIN. 0.10 COVER.
Typical Section
Scale 1"=10'
Exist Paving
Future S.W. Std. Dwg. No. 350
Trim edge of paving to clean straight line. Install match up paving or overlay exist paving as directed in the field to provide a smooth crown
Note: All construction shall be in accordance with the Standard Specifications No. 461 of the City of Riverside, Dept. of Public Works.
AS BUILT 4/1/62 CE
REVISIONS
MARK | DATE | DESCRIPTION
4/12/61 | SHOW IMPROVEMENTS FOR WEST HILLSIDE (R.S. 721)
2/9/62 | ADDED 8" PIPE AT STA. 30+75 AND A DITCH LT OF STA. 28+78.33 TO 30+72.
DESIGNED BY
DRAWN BY B. LOW
CHECKED BY
RECOMMENDED BY
ASSISTANT CITY ENGINEER
APPROVED BY
DIRECTOR OF PUBLIC WORKS
DATE 4/11/62
CITY OF RIVERSIDE CALIFORNIA
DEPARTMENT OF PUBLIC WORKS
HILLSIDE AVENUE
SLY OF CENTRAL AVE.
TO
ARLINGTON AVE.
CB. & GTR. FOR R/S 27/30
R-225
SHEET 1 OF 2