CONSTRUCTION NOTES:

1. CONSTRUCT CURB & GUTTER PER CITY OF RIVERSIDE STANDARD DRAWING NO. 200, TYPE I, WITH 6" CURB FACE.
2. CONSTRUCT CURB ONLY PER CITY OF RIVERSIDE STANDARD DRAWING NO. 200, TYPE II, WITH 6" CURB FACE.
3. CONSTRUCT CROSS GUTTER PER CITY OF RIVERSIDE STANDARD NO. 220, MODIFIED AS SHOWN ON PLAN.
4. CONSTRUCT WHEELCHAIR RAMP PER CITY OF RIVERSIDE STANDARD DRAWING NO. 304.
5. CONSTRUCT SIDEWALK PER CITY OF RIVERSIDE STANDARD DRAWING NO. 325.
6. PLACE 2½" A.C. PAVING OVER 4" OF D.G. PER SOILS REPORT 10%.
7. CONSTRUCT TYPE III CURB PER CITY OF RIVERSIDE STANDARD NO. 200 WITH 6" CURB FACE.
8. CONSTRUCT TEMPORARY INLET STRUCTURE. REF. DETAIL ON SHEET NO. 2.
9. REMOVE EXISTING CURB, GUTTER AND A.C. PAVING.

QUANTITIES:

1. CURB & GUTTER (6" C.F.)	460 L.F.
2. CURB ONLY (6" C.F.)	405 L.F.
3. CROSS GUTTER	144 S.F.
4. WHEELCHAIR RAMPS	4 EACH
5. SIDEWALK	2410 S.F.
6. A.C. PAVING	20,490 S.F.
7. D.G. BASE	20,490 S.F.
8. TEMPORARY INLET	1 EACH
9. 12" R.C.P.	18 L.F.
10. JUNCTION STRUCTURE	3 EACH
11. EXCAVATION	600 C.Y.
12. EMBANKMENT	60 C.Y.
13. CLEAR RIGHT-OF-WAY	LUMP SUM
14. TYPE III CURB (6" C.F.)	105 L.F.
15. 6" A.C. BERM	20 L.F.

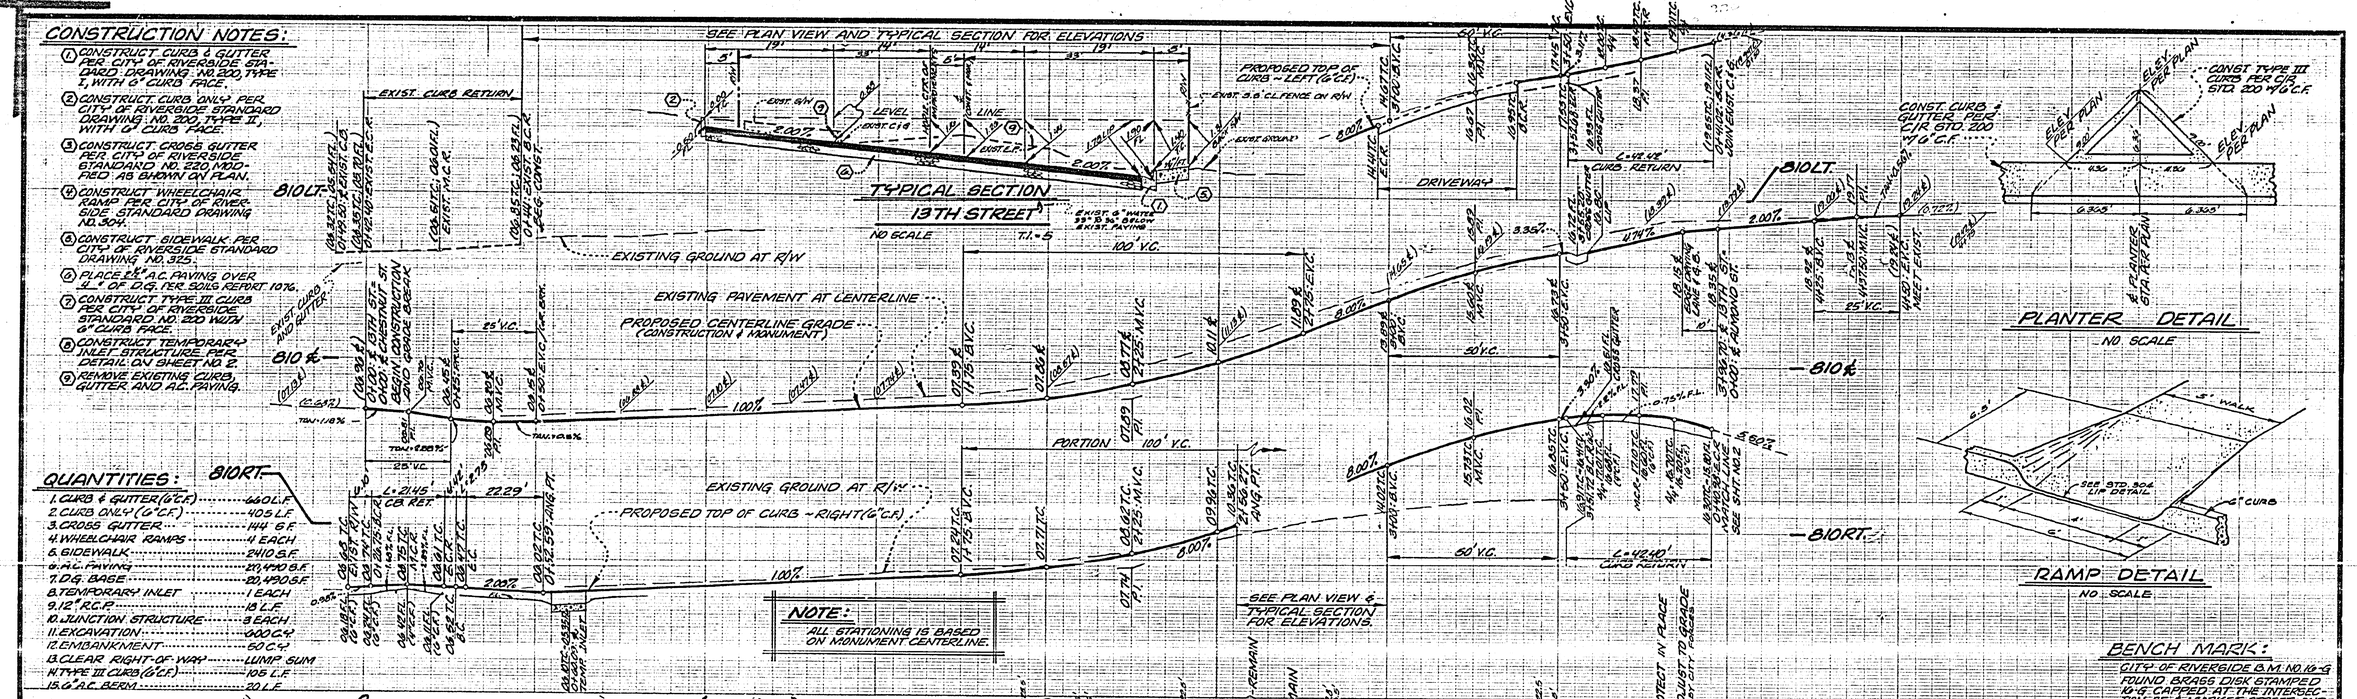

BENCH MARK:

CITY OF RIVERSIDE B.M. NO. 16-G
FOUND BRASS DISK STAMPED 16-G CAPPED AT THE INTERSECTION OF ℄ MARKET STREET AND ℄ 14TH STREET.
C/R F.B. 735/58
ELEV. = 834.134

C.R. DATA

Ⓐ Δ = 81°55'38"
R = 15.00'
L = 21.45'
T = 13.02'

Ⓑ Δ = 90°01'20"
R = 27.00'
L = 42.41'
T = 27.01'

Ⓒ Δ = 89°58'40"
R = 27.00'
L = 42.40'
T = 26.99'

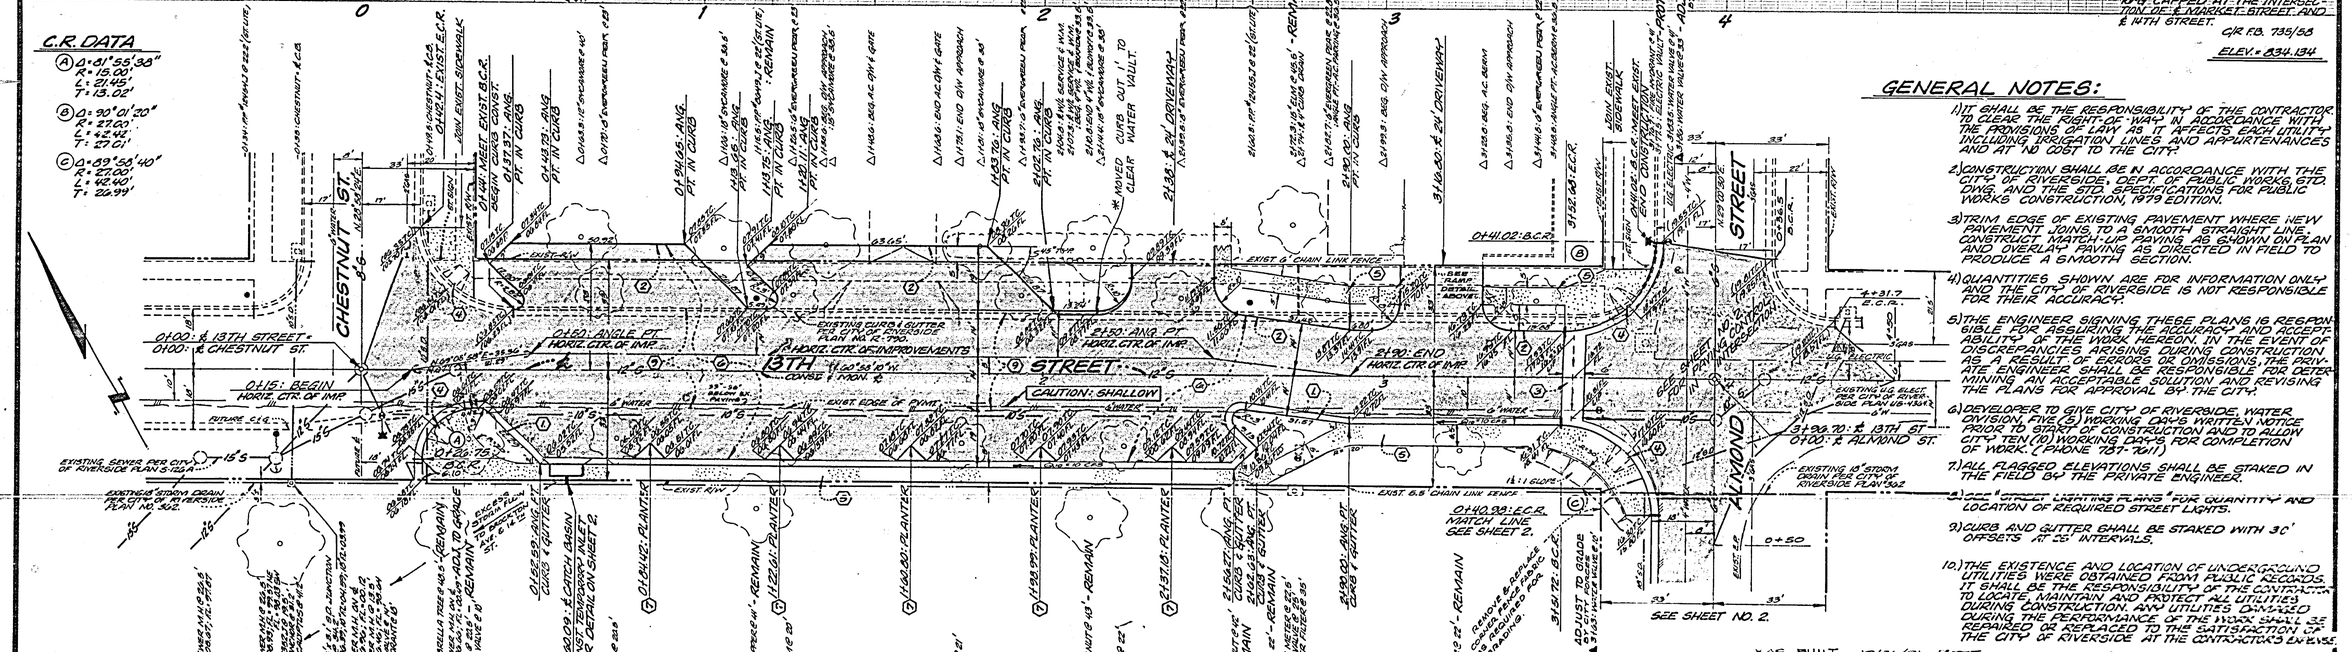

GENERAL NOTES:

1) IT SHALL BE THE RESPONSIBILITY OF THE CONTRACTOR TO CLEAR THE RIGHT-OF-WAY IN ACCORDANCE WITH THE PROVISIONS OF LAW AS IT AFFECTS EACH UTILITY, INCLUDING IRRIGATION LINES AND APPURTENANCES AND AT NO COST TO THE CITY.

2) CONSTRUCTION SHALL BE IN ACCORDANCE WITH THE CITY OF RIVERSIDE, DEPT. OF PUBLIC WORKS STD. DWG. AND THE STD. SPECIFICATIONS FOR PUBLIC WORKS CONSTRUCTION, 1979 EDITION.

3) TRIM EDGE OF EXISTING PAVEMENT WHERE NEW PAVEMENT JOINS, TO A SMOOTH STRAIGHT LINE. CONSTRUCT MATCH-UP PAVING AS SHOWN ON PLAN AND OVERLAY PAVING AS DIRECTED IN FIELD TO PRODUCE A SMOOTH SECTION.

4) QUANTITIES SHOWN ARE FOR INFORMATION ONLY AND THE CITY OF RIVERSIDE IS NOT RESPONSIBLE FOR THEIR ACCURACY.

5) THE ENGINEER SIGNING THESE PLANS IS RESPONSIBLE FOR ASSURING THE ACCURACY AND ACCEPTABILITY OF THE WORK HEREON. IN THE EVENT OF DISCREPANCIES ARISING DURING CONSTRUCTION AS A RESULT OF ERRORS OR OMISSIONS, THE PRIVATE ENGINEER SHALL BE RESPONSIBLE FOR DETERMINING AN ACCEPTABLE SOLUTION AND REVISING THE PLANS FOR APPROVAL BY THE CITY.

6) DEVELOPER TO GIVE CITY OF RIVERSIDE, WATER DIVISION, FIVE (5) WORKING DAYS WRITTEN NOTICE PRIOR TO START OF CONSTRUCTION AND TO ALLOW CITY TEN (10) WORKING DAYS TO FOR COMPLETION OF WORK. (PHONE 787-7011)

7) ALL FLAGGED ELEVATIONS SHALL BE STAKED IN THE FIELD BY THE PRIVATE ENGINEER.

8) "STREET LIGHTING PLANS" FOR QUANTITY AND LOCATION OF REQUIRED STREET LIGHTS.

9) CURB AND GUTTER SHALL BE STAKED WITH 30' OFFSETS AT 25' INTERVALS.

10) THE EXISTENCE AND LOCATION OF UNDERGROUND UTILITIES WERE OBTAINED FROM PUBLIC RECORDS. IT SHALL BE THE RESPONSIBILITY OF THE CONTRACTOR TO LOCATE, MAINTAIN AND PROTECT ALL UTILITIES DURING CONSTRUCTION. ANY UTILITIES DAMAGED DURING THE PERFORMANCE OF THE WORK SHALL BE REPAIRED OR REPLACED TO THE SATISFACTION OF THE CITY OF RIVERSIDE AT THE CONTRACTOR'S EXPENSE.

NOTE:

△ INDICATES ITEMS TO BE REMOVED, ADJUSTED TO GRADE, OR RELOCATED BY CONTRACTOR.

▲ INDICATES ITEMS TO BE REMOVED, RELOCATED OR ADJUSTED TO GRADE BY CITY OF RIVERSIDE.

Contractor agrees that he shall assume sole and complete responsibility for job site conditions during the course of construction of this Project, including safety of all persons and property; that this requirement shall apply continuously and not be limited to normal working hours; and that the Contractor shall defend, indemnify and hold the Owner and the Engineer harmless from any and all liability, real or alleged, in connection with the performance of work on this Project, excepting for liability arising from the sole negligence of the Owner or the Engineer.

BEELER, KRIEGER & STEWART
LAND SURVEYORS – CIVIL ENGINEERS
3602 UNIVERSITY AVE., SUITE 201
RIVERSIDE, CALIFORNIA 92501
(714) 684-6900

APPROVED BY: Mark E. Wassermann 2-21-80
REGISTERED ENGINEER NO. 22020 DATE

MARK	REVISIONS	APPR	DATE
△	REMOVE CURB, GUTTER & U.E. FOR JUNCTION STRUCTURE & RELOCATE LIGHT	VSN	10-21-81

DESIGNED BY R.M. DRAWN BY R.M. CHECKED BY KNB

RIVERSIDE SCHOOL DIST.
BY: DATE

CITY OF RIVERSIDE
ELECTRICAL DEPARTMENT
BY: CHIEF UTILITIES ENGR-ELECT DATE

CITY OF RIVERSIDE
DOMESTIC WATER SYSTEM
BY: CHIEF UTILITIES ENGR-WATER DATE

CITY OF RIVERSIDE
PUBLIC WORKS DEPARTMENT

APPROVED BY		
PRINCIPAL ENGINEER		
PARK DEPARTMENT		
TRAFFIC DIVISION		
CHIEF P.W. ENGINEER		

APPROVED BY: PUBLIC WORKS DIRECTOR
DATE 7/21/80

STREET PLAN & PROFILE
13TH STREET
CHESTNUT STREET TO ALMOND STREET
(IN CONNECTION WITH GRANT SCHOOL ETCHM DRAIN)

ACCOUNT NO. R-2298
SHEET 1 OF 3
FILE NO. 149-5

HORIZ. SCALE: 1" = 20' VERT. SCALE: 1" = 4'

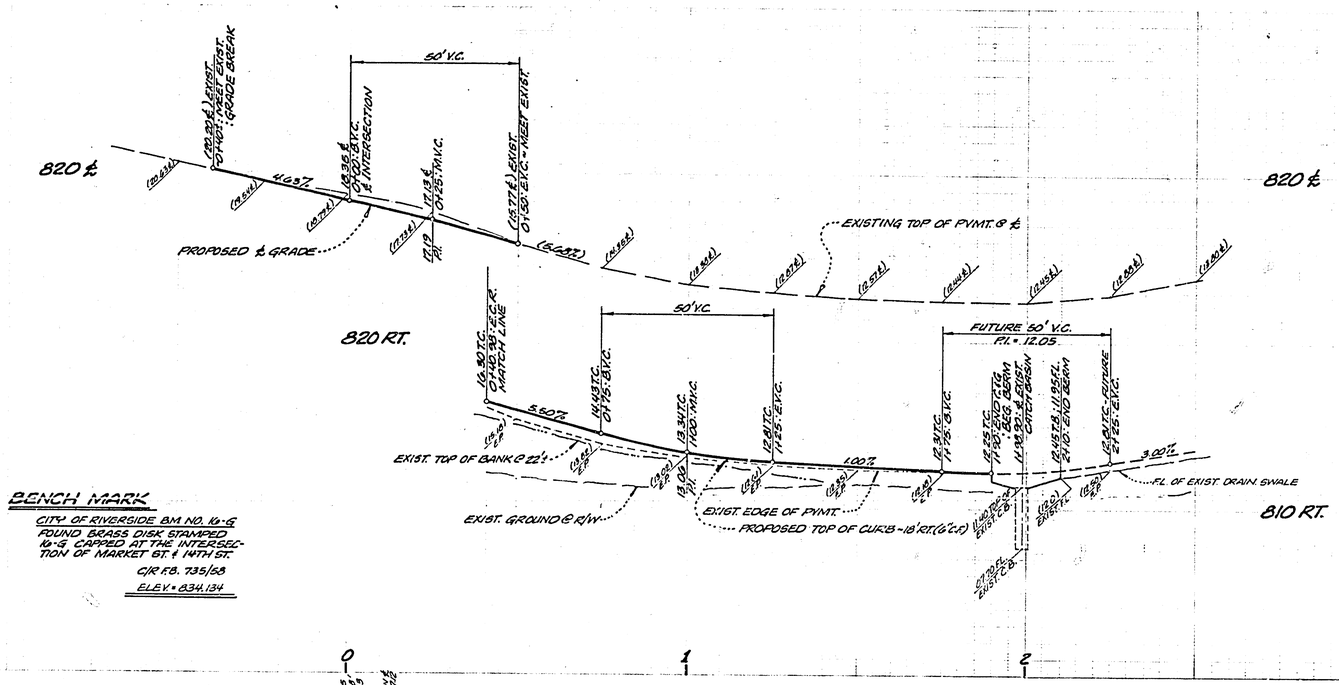

BENCH MARK

C/R F.B. 735/58
ELEV. = 834.134

INLET DETAIL

(0+60.09, 13TH STREET)

NOTE:
THIS DRAINAGE SYSTEM IS DESIGNED TO CARRY NUISANCE FLOWS ONLY AT THIS TIME. CONSTRUCTION OF "GRANT SCHOOL STORM DRAIN" & MODIFICATION OF THIS INLET REQUIRED TO PROVIDE PROTECTION FOR Q_{10} = 10 CFS.

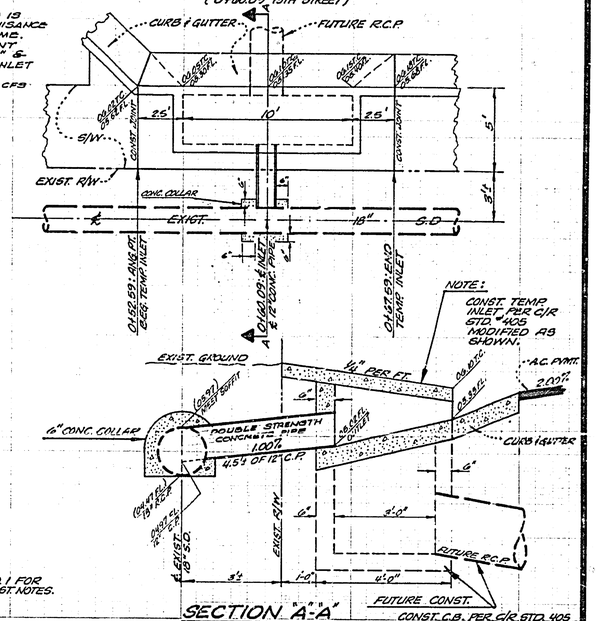

NOTE:
SEE SHEET NO. 1 FOR GENERAL & CONST. NOTES.

SECTION A-A

NO SCALE

NOTE:
STRAIGHT GRADE NEW PAVING FROM GUTTER LIP OR SAWCUT LINE TO ℄ WITHIN INTERSECTION AS DIRECTED BY CITY CONST. INSPECTOR, BOTH ℄ OF ALMOND ST. & ℄ OF 13TH ST. TO BE STAKED BY THE PRIVATE ENGINEER FOR PAVING CONTROL.

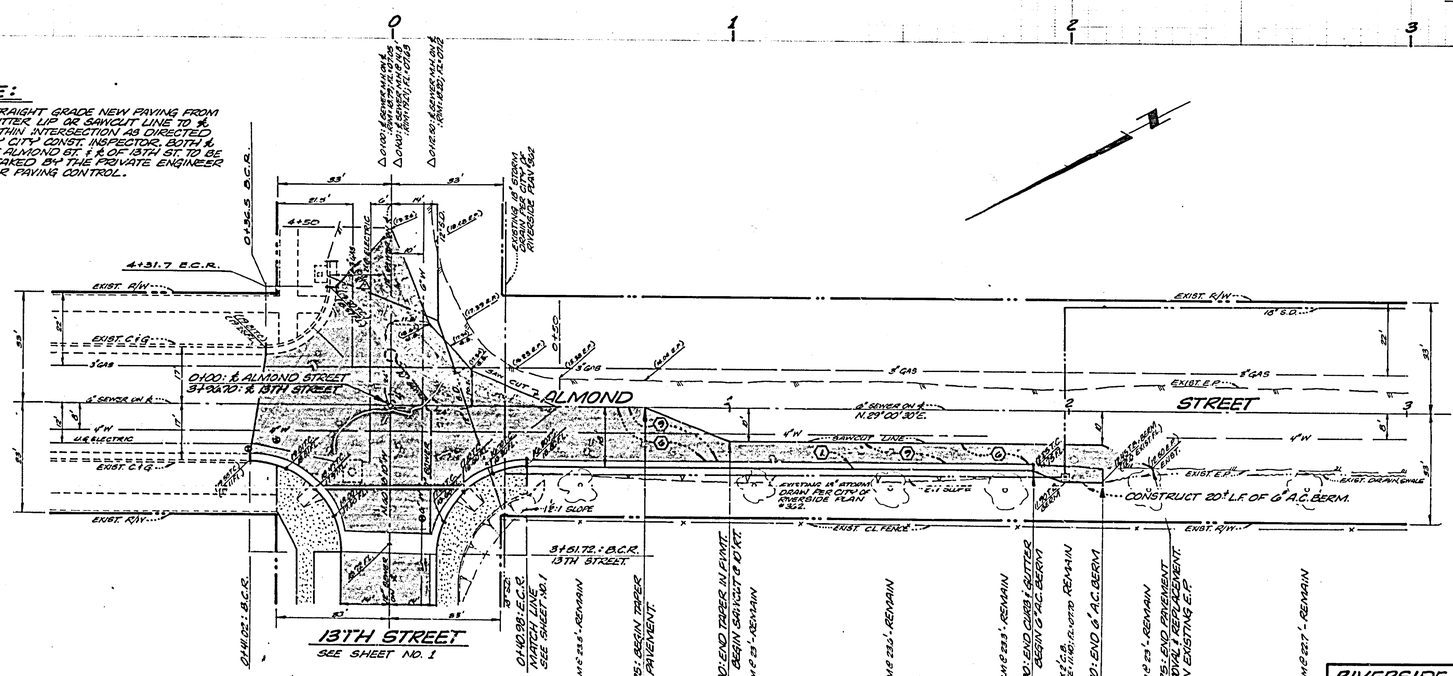

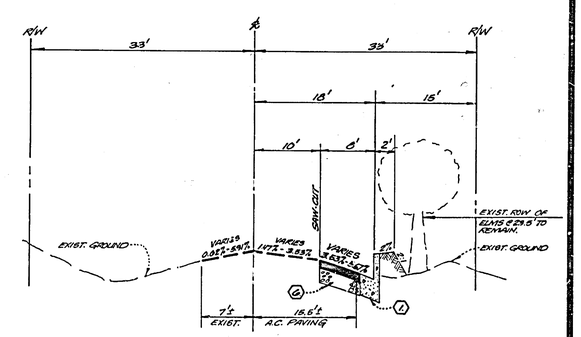

TYPICAL SECTION
ALMOND STREET
NO SCALE T.I. = 5

Contractor agrees that he shall assume sole and complete responsibility for job site conditions during the course of construction of this Project, including safety of all persons and property; that this requirement shall apply continuously and not be limited to normal working hours; and that the Contractor shall defend, indemnify and hold the Owner and the Engineer harmless from any and all liability, real or alleged, in connection with the performance of work on this Project, excepting for liability arising from the sole negligence of the Owner or the Engineer.

HEELER, KRIEGER & STEWART
LAND SURVEYORS – CIVIL ENGINEERS
3602 UNIVERSITY AVE., SUITE 201
RIVERSIDE, CALIFORNIA 92501
(714) 684-6900

APPROVED BY: Mark L. Hanemann
REGISTERED ENGINEER NO. 22020 — 5-28-80 DATE

MARK	REVISIONS	APPR.	DATE

DESIGNED BY: R.M. DRAWN BY: R.M. CHECKED BY: J.N.G.

CITY OF RIVERSIDE, CALIFORNIA
DEPARTMENT OF PUBLIC WORKS

APPROVED BY	BY	DATE
PRINCIPAL ENGINEER		7/1/80
PARK DEPARTMENT		7/1/80
TRAFFIC DIVISION		7/2/80
CHIEF P. W. ENGR.		7-1-80
Planning		7-1-80

APPROVED BY: DIRECTOR OF PUBLIC WORKS
DATE 7/1/80

* AS BUILT 10/26/81 BRET

RIVERSIDE SCHOOL DIST. BY: 7-8-80 DATE

CITY OF RIVERSIDE ELECTRICAL DEPARTMENT BY: 7-1-80 CHIEF UTILITIES ENGR.-ELECT. DATE

SO. CALIF. GAS CO. BY: 7/1/80 DATE

CITY OF RIVERSIDE DOMESTIC WATER SYSTEM BY: 7-1-80 CHIEF UTILITIES ENGR.-WATER DATE

STREET PLAN AND PROFILE
ALMOND STREET
13TH STREET TO 210'± GO.
(IN CONNECTION WITH GRANT SCHOOL STORM DRAIN)

PROJECT NO. R-2298
SHEET 2 OF 2
HORIZ. SCALE: 1" = 20' VERT. SCALE: 1" = 4'
FILE NO. 148-5