MISSING

MISSING

PRELIMINARY

PLATE 1 - PLAN-PROFILE O.P.R.R.E. SYSTEMS
REVISED & EDITED BY CITY OF RIVERSIDE

K & E CO. NO. 359-10

MAGNOLIA
HARRISON TO MILL

STD. CURB

MAGNOLIA BET. MILL & ELY
PROPOSED FUTURE SEWER NOT
INCLUDED WITH CONSTRUCTION
OF TRUNK SEWER.

IDENTICAL POINTS

STD. CURB

MH 7

MH 8

Boyd E. Low Sept. 1, 1959

PROD. TOP CURB GRADE

EL SIDE

.220%

452.59' E.S.V.C.P. (18")
F.L. 0.126%

452.58' 18" E.S.V.C.P.
F.L. 0.126%

SCALES: HOR. 1" = 50'
VERT. 1" = 5'

B.M. ELEV. 777.95 P.K. NAIL IN S.E.
CB RET. MILL & MAGNOLIA

F.B. 60 (6)

PROFILE
SURVEYED
PLOTTED
CALCULATED
NOTES CHECKED
ST. STRUCTURE INSPECTION CHECKED

PROPOSED FUTURE SEWER NOT
INCLUDED WITH CONSTRUCTION
OF TRUNK SEWER

VILLAGE OF
ARLINGTON
M.B. 1/62 REC. S.B. CO.

LOT
BARN

BLOCK

LOT

R/S

MH 7

MH 8

MH 9

NO PAVING

452.59' 18" E.S.V.C.P.

452.58' 18" E.S.V.C.P.

4" WATER

GAS

MILL STREET

12" CULVERT

3774
3772 APTS.
3750
3742
3736
3730
3722
3712
3702
3606
B.B. Low

.26
13/38
11
6

0.22 OK MJFM 9/2/59
wdy

PROPOSED FUTURE SEWER NOT
INCLUDED WITH CONSTRUCTION
OF TRUNK SEWER

PROPOSED FUTURE SEWER NOT
INCLUDED WITH CONSTRUCTION
OF TRUNK SEWER

MAGNOLIA AVENUE

HARRISON STREET

PRIMROSE DRIVE (HOAG ST.)

9757
9758
9759
9761
9760
9772
9775A

NOTE:
1 - LOCATE CHIMNEYS IN FIELD
2 - TOPS OF CHIMNEYS TO BE 6' ±3" BELOW SURFACE

SCALE (N) 1" = 50'

REVISIONS		
MARK	DATE	DESCRIPTION
*	12-11-37	As Built changes H.Ball
11	11	St. Paving
		Study Sheet

CITY OF RIVERSIDE, CALIFORNIA
DEPARTMENT OF PUBLIC WORKS

HARRISON - INDIANA
TRUNK SEWER

RELOCATION FROM THIRD STAGE
NORTH-SOUTH FREEWAY CONSTRUCTION
MAGNOLIA, HARRISON TO MILL
AND
MILL, MAGNOLIA TO PRIMROSE

DESIGNED BY
DRAWN BY
CHECKED BY H.H.
RECOMMENDED BY ASSISTANT CITY ENGINEER
APPROVED BY DIRECTOR OF PUBLIC WORKS
DATE
SHEET 3 OF 10

A-319

MISSING

MISSING

MISSING

MISSING

MISSING

MISSING

MISSING

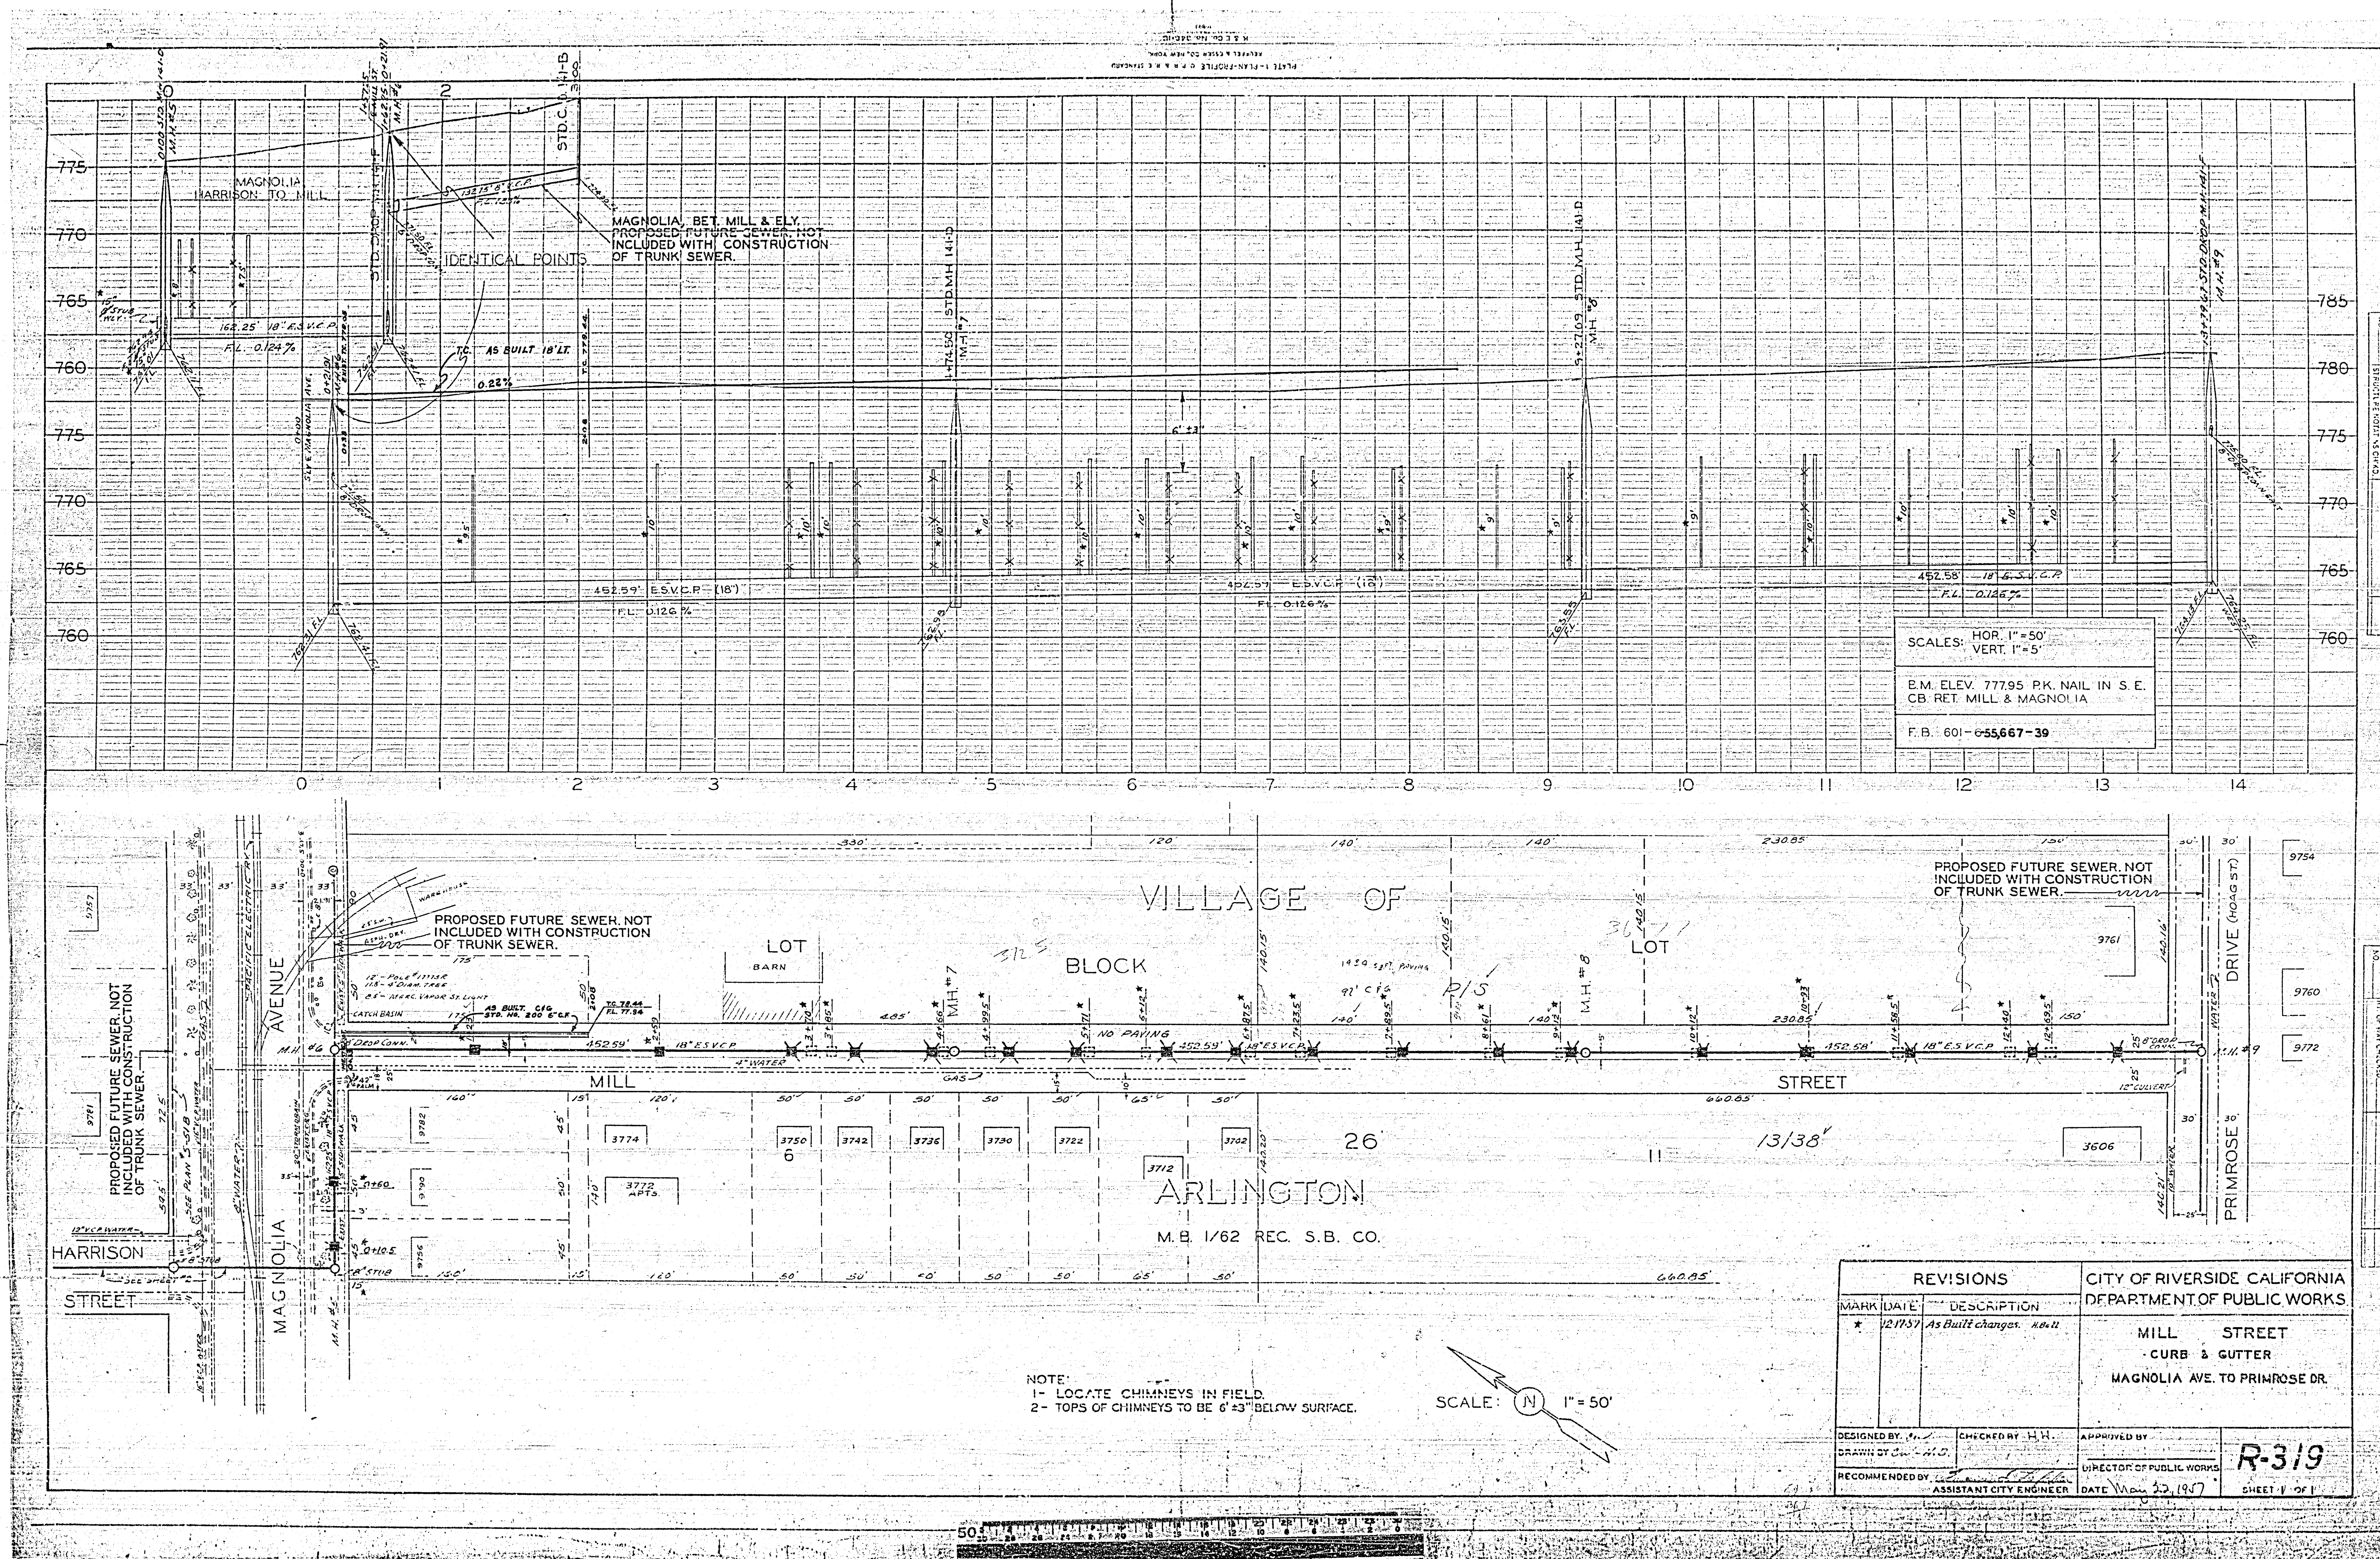

MAGNOLIA HARRISON TO MILL
0+00 STD. M.H. 141-0
M.H. #5
STD. DROP M.H. 141-F
STD. C. D. 141-B
MAGNOLIA, BET. MILL & ELY. PROPOSED FUTURE SEWER. NOT INCLUDED WITH CONSTRUCTION OF TRUNK SEWER.
IDENTICAL POINTS
162.25' 18" E.S.V.C.P.
F.L. 0.124%
T.C. AS BUILT 18' LT.
0.22%
4+74.50 STD. M.H. 141-D
M.H. #7
9+27.09 STD. M.H. 141-D
M.H. #8
13+79.67 STD. DROP M.H. 141-F
M.H. #9
6' ±3"
452.59' E.S.V.C.P. (18")
F.L. 0.126%
452.58' 18" E.S.V.C.P.
F.L. 0.126%
SCALES: HOR. 1" = 50' VERT. 1" = 5'
B.M. ELEV. 777.95 P.K. NAIL IN S.E. CB. RET. MILL & MAGNOLIA
F.B. 601-6 55,667-39
PROFILE
PROPOSED FUTURE SEWER. NOT INCLUDED WITH CONSTRUCTION OF TRUNK SEWER.
VILLAGE OF
LOT
BARN
BLOCK
LOT
M.H. #6
M.H. #7
M.H. #8
M.H. #9
452.59' 18" E.S.V.C.P.
452.58' 18" E.S.V.C.P.
NO PAVING
4" WATER
GAS
MILL
STREET
660.85'
26
ARLINGTON
M.B. 1/62 REC. S.B. CO.
13/38
HARRISON
STREET
MAGNOLIA
AVENUE
PACIFIC ELECTRIC RY.
PRIMROSE
DRIVE (HOAG ST.)
12" CULVERT
PLAN
NOTE:
1- LOCATE CHIMNEYS IN FIELD.
2- TOPS OF CHIMNEYS TO BE 6' ±3" BELOW SURFACE.
SCALE: N 1" = 50'
REVISIONS
MARK | DATE | DESCRIPTION
★ | 12-17-57 | As Built changes. H. Bell
CITY OF RIVERSIDE CALIFORNIA
DEPARTMENT OF PUBLIC WORKS
MILL STREET
CURB & GUTTER
MAGNOLIA AVE. TO PRIMROSE DR.
DESIGNED BY
CHECKED BY H.H.
DRAWN BY
RECOMMENDED BY
ASSISTANT CITY ENGINEER
APPROVED BY
DIRECTOR OF PUBLIC WORKS
DATE May 22, 1957
R-319
SHEET 1 OF 1

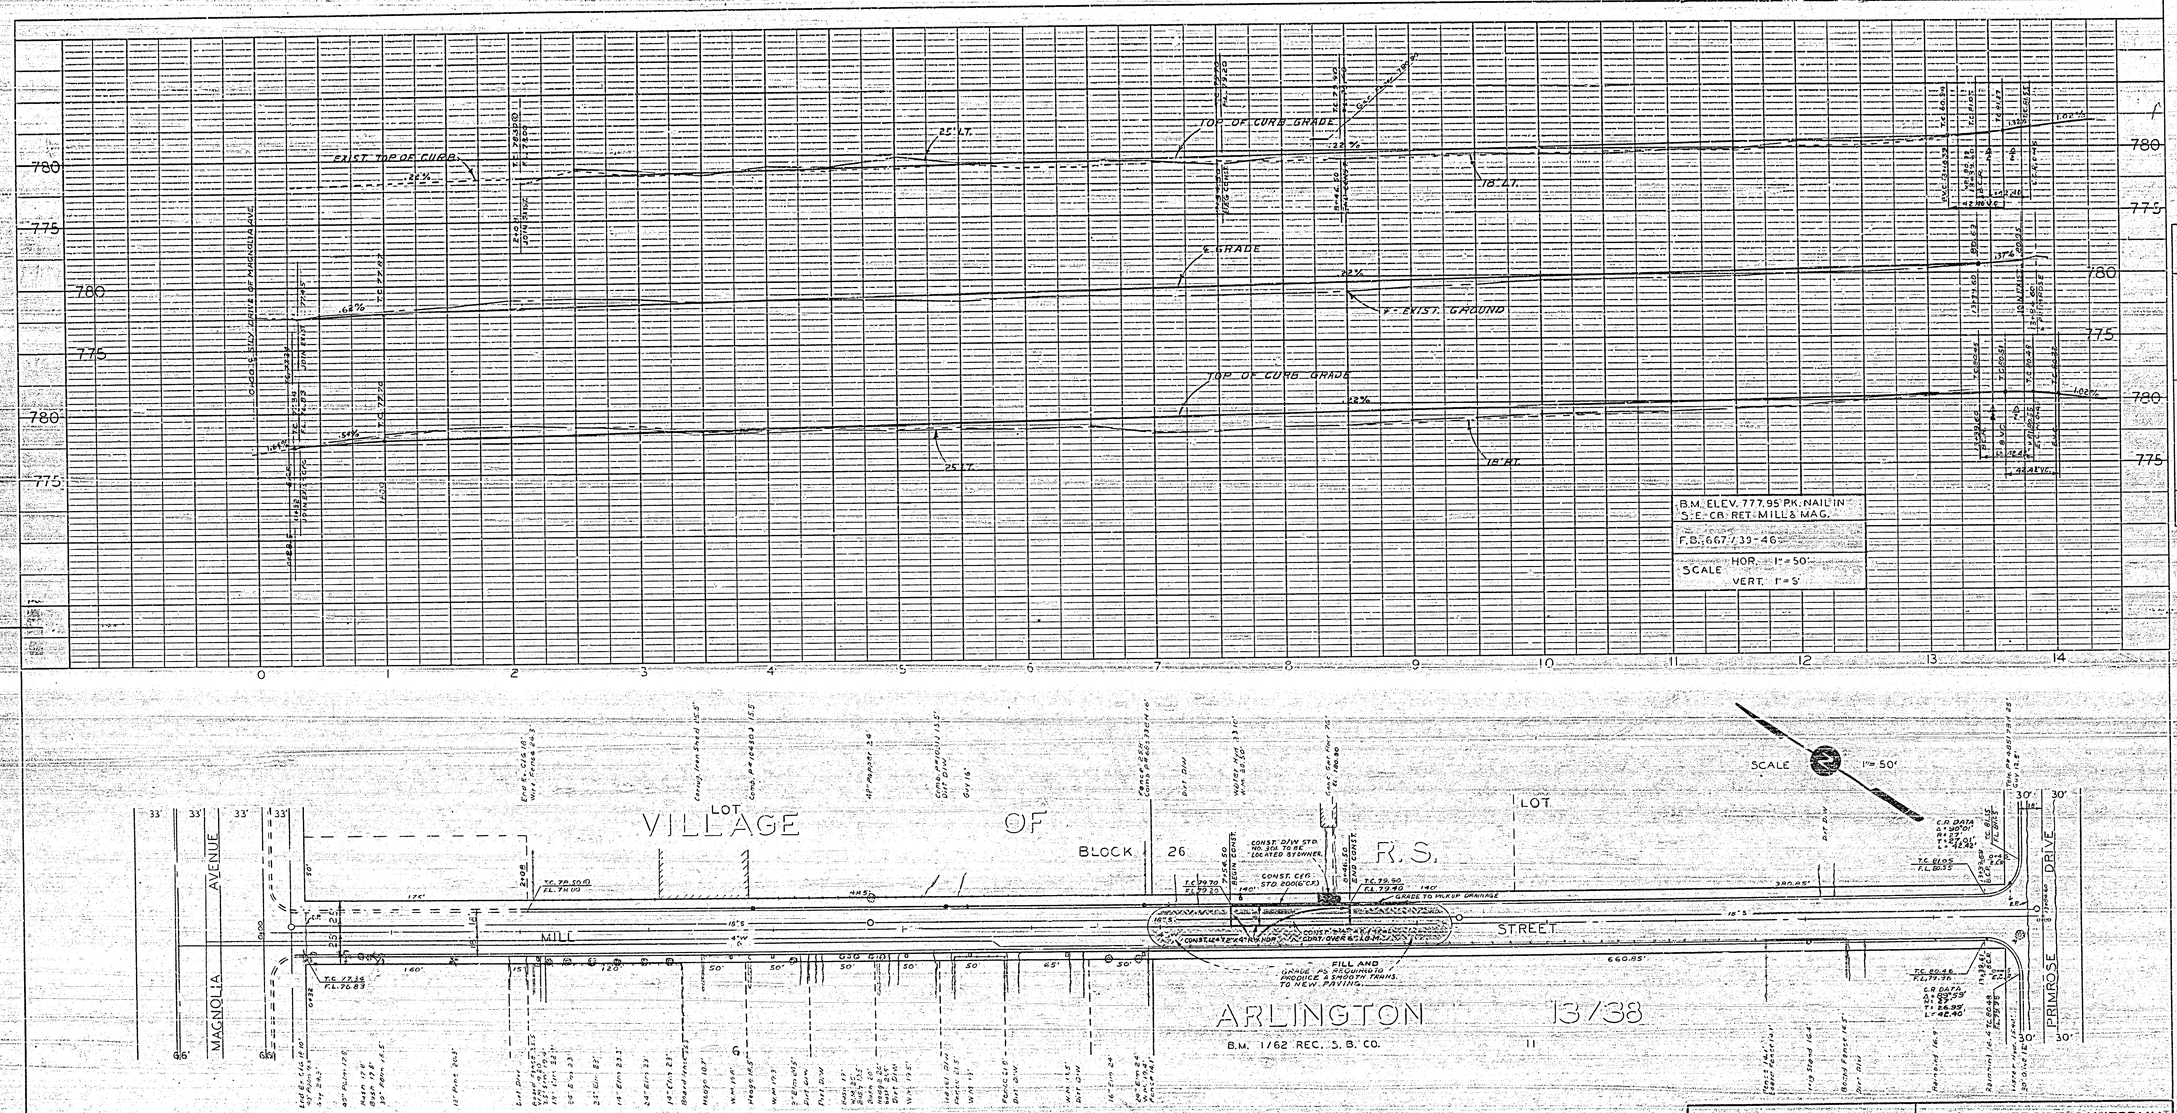

NOTE

1. ALL CONSTRUCTION SHALL BE IN ACCORDANCE WITH THE STANDARDS & SPECIFICATIONS NO. 461 OF THE CITY OF RIVERSIDE, DEPT. OF PUBLIC WORKS.

REVISIONS		
MARK	DATE	DESCRIPTION

CITY OF RIVERSIDE CALIFORNIA
DEPARTMENT OF PUBLIC WORKS

MILL STREET

MAGNOLIA AVENUE TO PRIMROSE DRIVE

DESIGNED BY B.L.
DRAWN BY B.L.
CHECKED BY
RECOMMENDED BY
ASSISTANT CITY ENGINEER
APPROVED BY
DIRECTOR OF PUBLIC WORKS
DATE 11-30-61

R-319

SHEET 1 OF 1