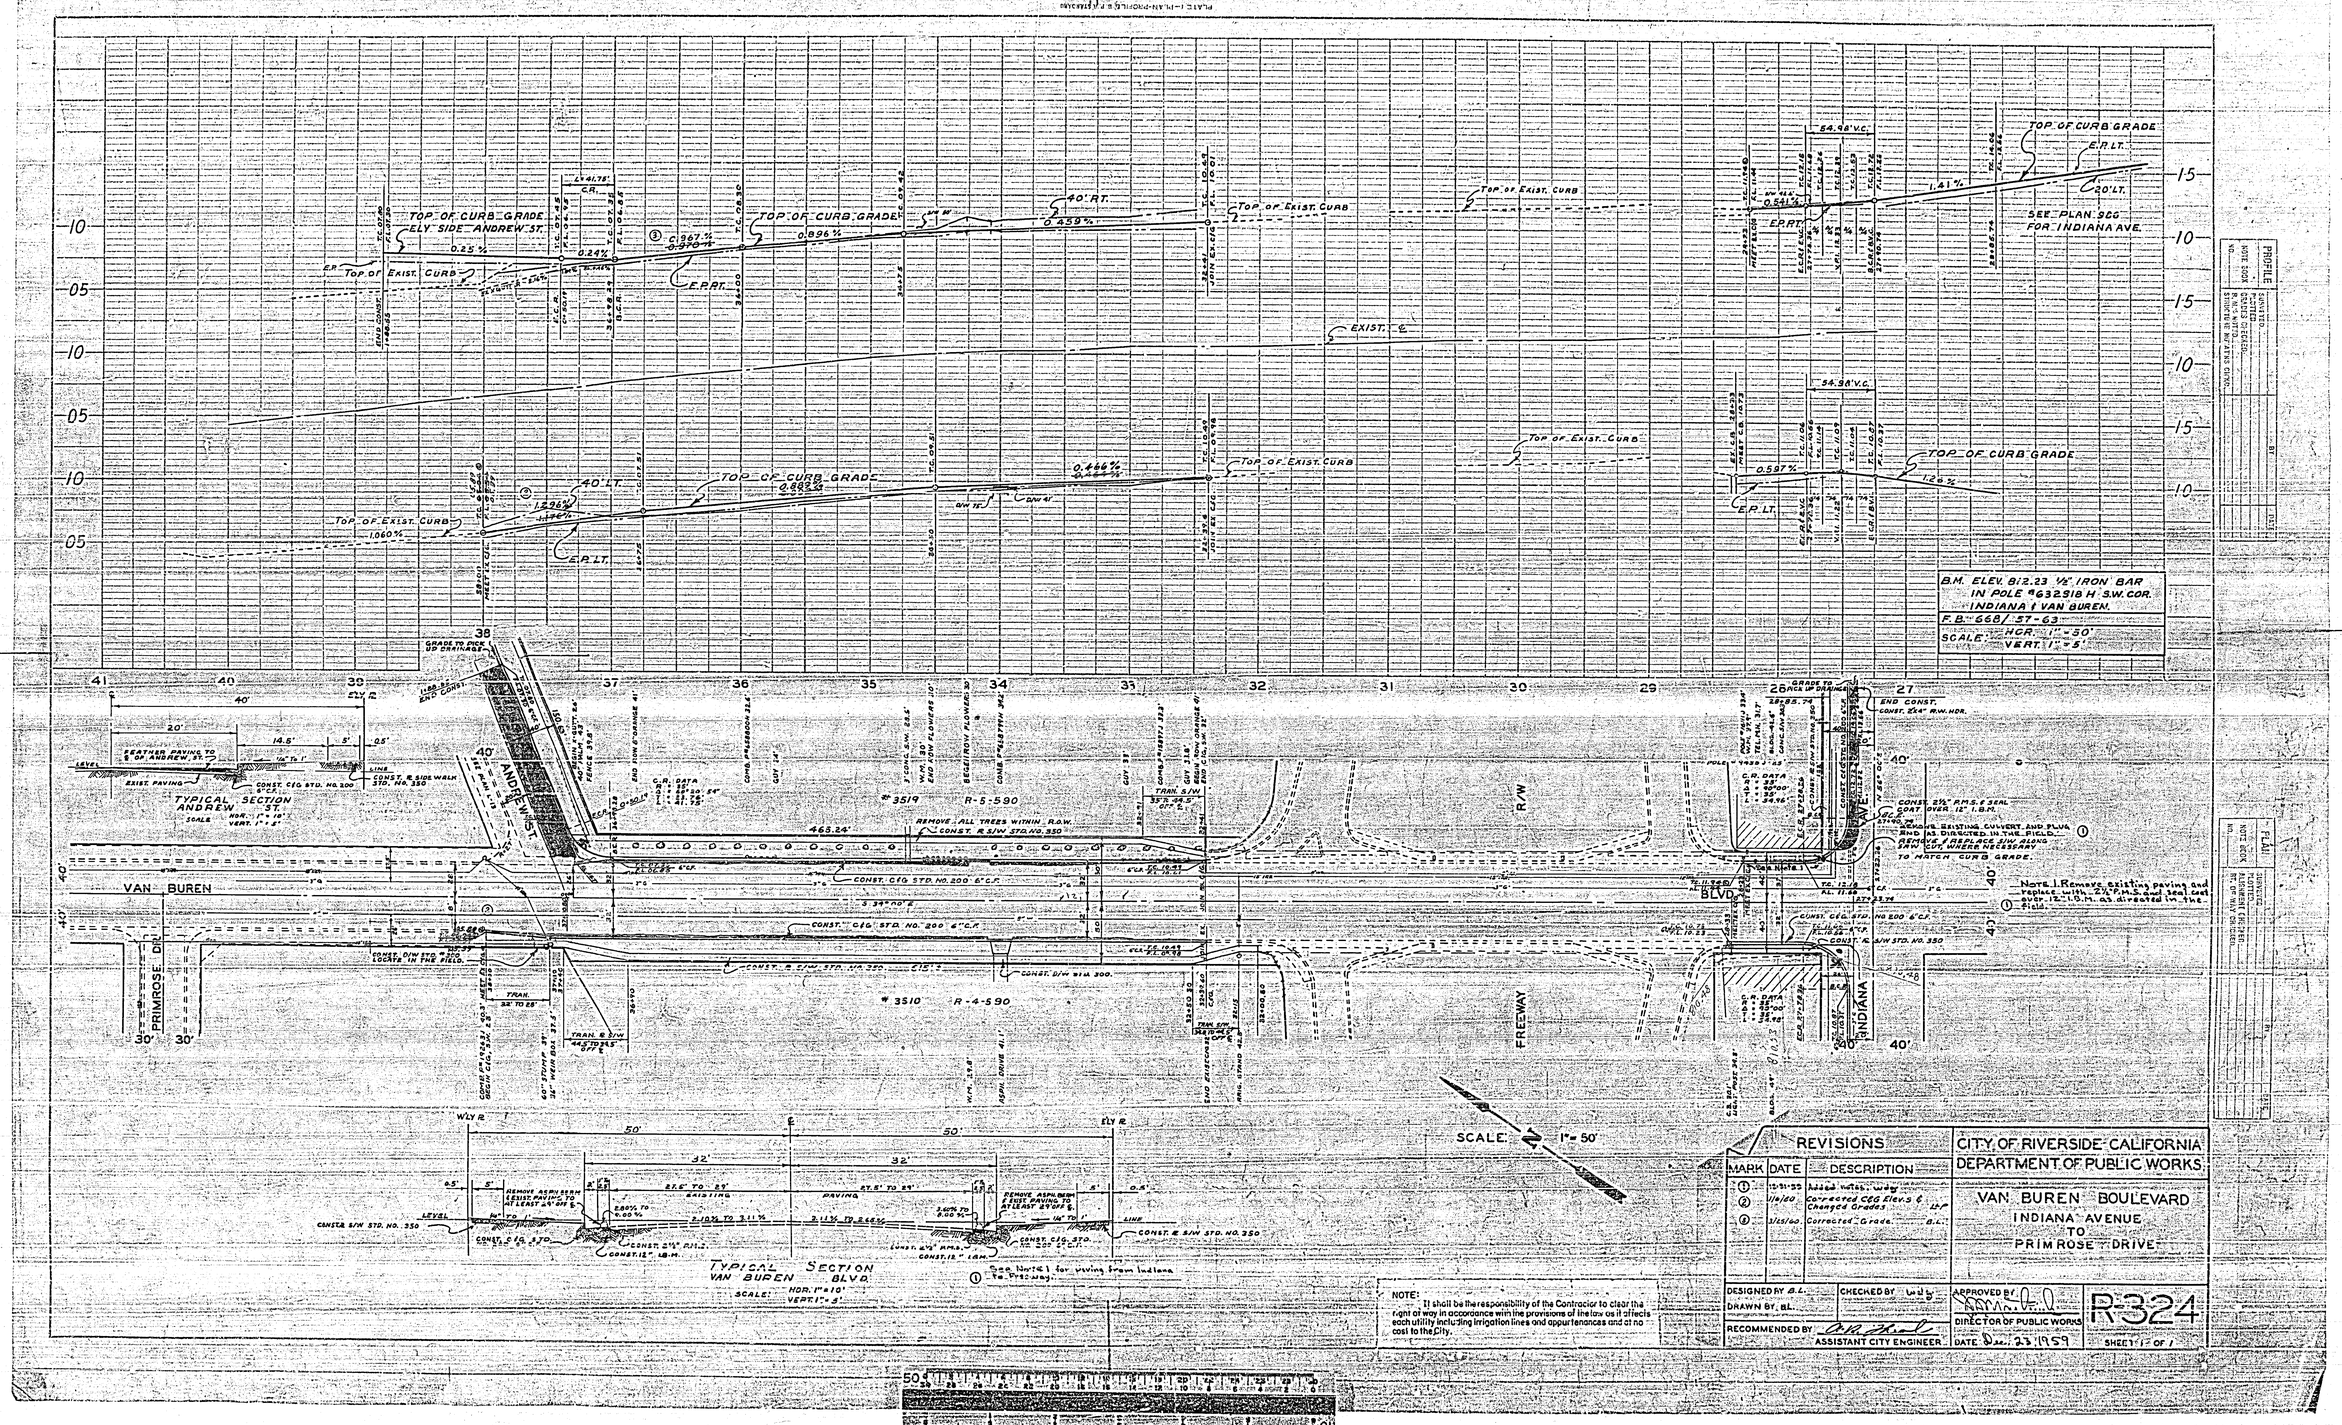

NOTE: It shall be the responsibility of the Contractor to clear the right of way in accordance with the provisions of the law as it affects each utility including irrigation lines and appurtenances and at no cost to the City.

REVISIONS		
MARK	DATE	DESCRIPTION
①	12-31-59	Added notes, wdg
②	1/6/60	Corrected C&G Elev.s & Changed Grades L.P.
③	3/25/60	Corrected Grade B.L.

CITY OF RIVERSIDE CALIFORNIA
DEPARTMENT OF PUBLIC WORKS

VAN BUREN BOULEVARD
INDIANA AVENUE
TO
PRIMROSE DRIVE

DESIGNED BY B.L. CHECKED BY wdg
DRAWN BY B.L.
RECOMMENDED BY [signature] ASSISTANT CITY ENGINEER
APPROVED BY [signature] DIRECTOR OF PUBLIC WORKS
DATE Dec. 23, 1959

R-324

SHEET 1 OF 1