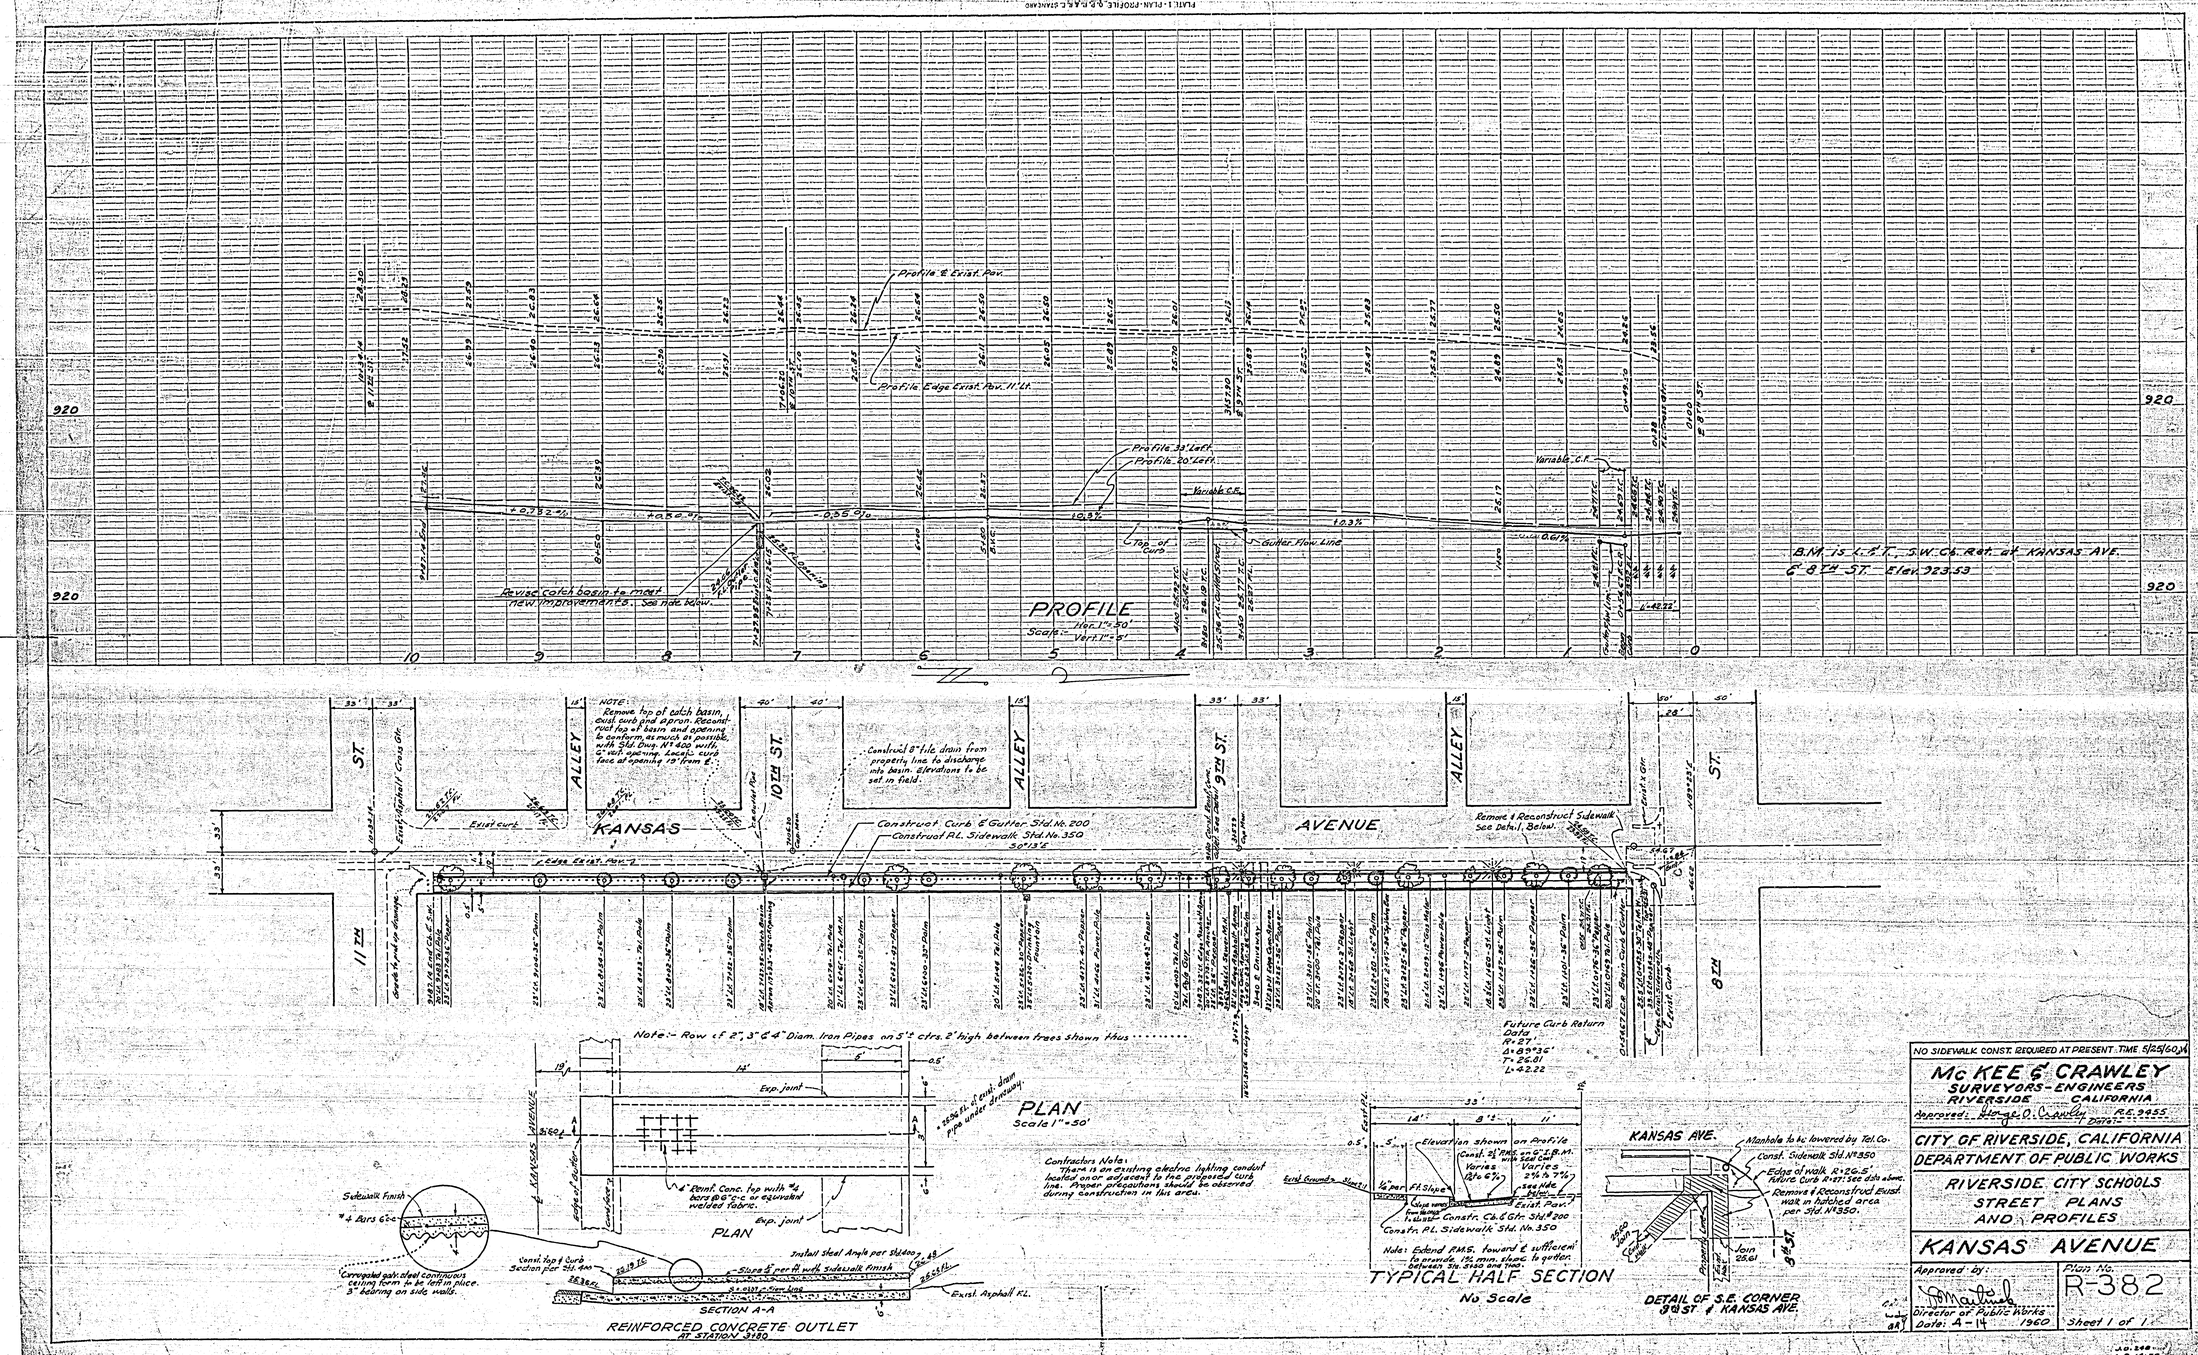

NO SIDEWALK CONST. REQUIRED AT PRESENT TIME 5/25/60

McKEE & CRAWLEY
SURVEYORS-ENGINEERS
RIVERSIDE CALIFORNIA

Approved: George O. Crawley R.E. 9455
Date:-

CITY OF RIVERSIDE, CALIFORNIA
DEPARTMENT OF PUBLIC WORKS

RIVERSIDE CITY SCHOOLS
STREET PLANS
AND PROFILES

KANSAS AVENUE

Approved by: [signature]
Director of Public Works
Date: A-14 1960

Plan No. R-382
Sheet 1 of 1

PROFILE
NOTE BOOK
NO.
SURVEYED
PLOTTED
GRADES CHECKED
B.M. NOTED
STRUCTURE NOTATIONS CHKD.
BY
DATE

PLAN
NOTE BOOK
NO.
SURVEYED
PLOTTED
ALIGNMENT CHECKED
RT. OF WAY CHECKED
BY
DATE