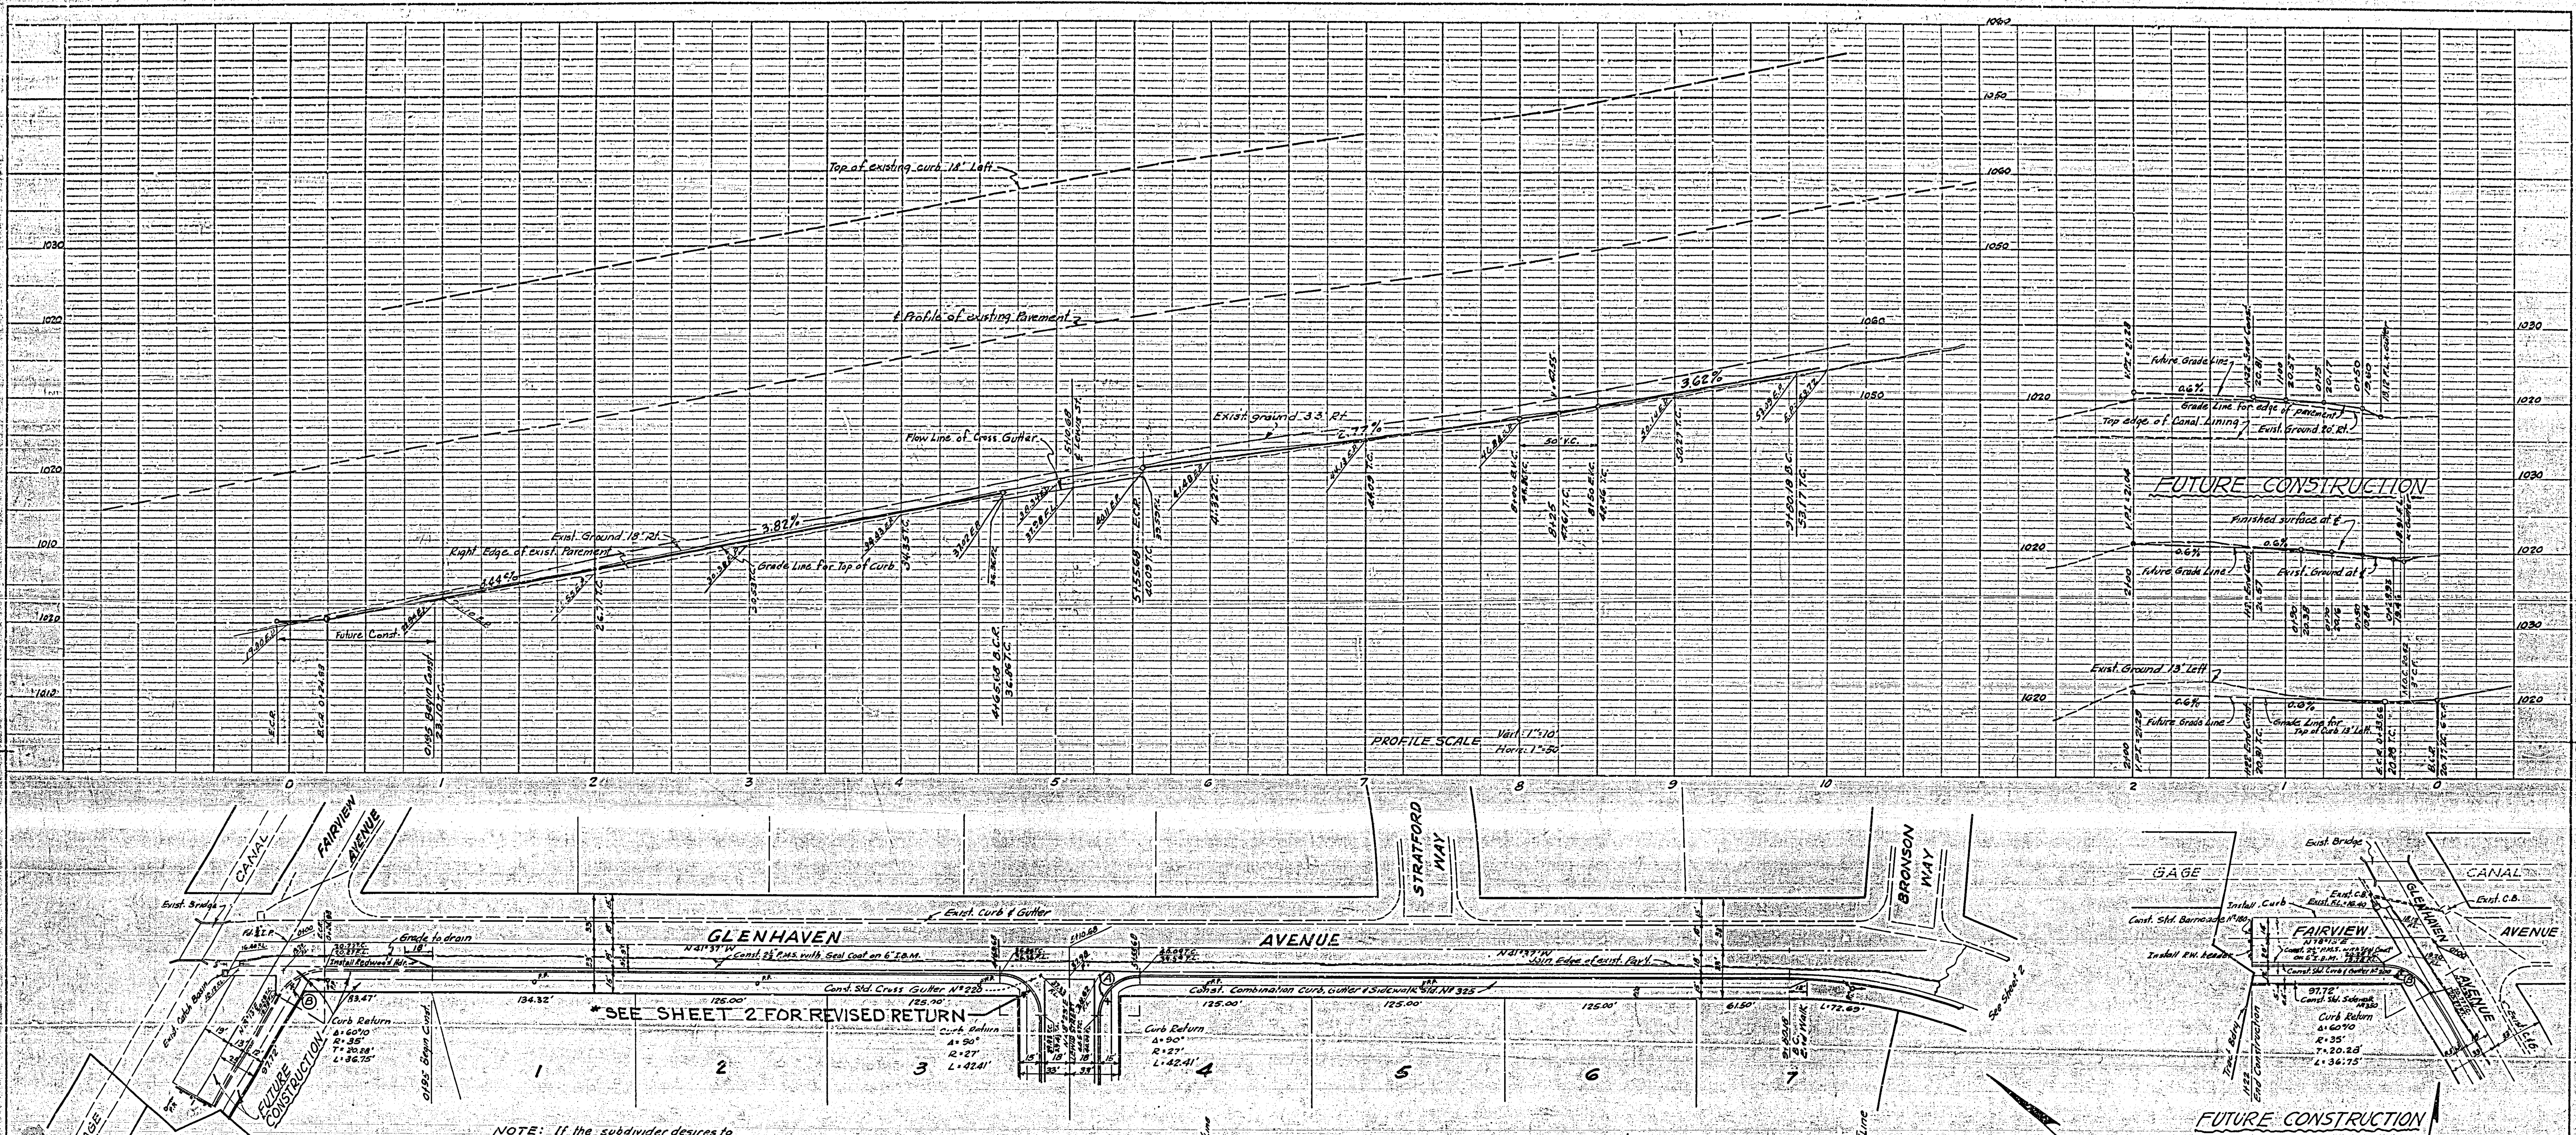


**NOTE:** If the subdivider desires to reduce the requirements for Imported Base Material, additional soil tests may be taken at subdividers expense after streets are prepared to rough grade. Subdivider will contact Inspection Div., City of Riverside, before taking tests. The City of Riverside will make a test of base material in place. Before paving can be installed, results of this test must indicate the Base Material is satisfactory to the Inspection Division.

**STREET NAME SIGN SCHEDULE**

| LOCATION | STREET NAME | BLOCK NO. | CORNER |
|---|---|---|---|
| A | Glenhaven Avenue<br>Lewis Street | 5400<br>2100 | SW |
| B | (Future) | | |

Street name signs and posts to be furnished and installed by subdivider per City of Riverside Specifications & Std. Dwg. Nº 662.

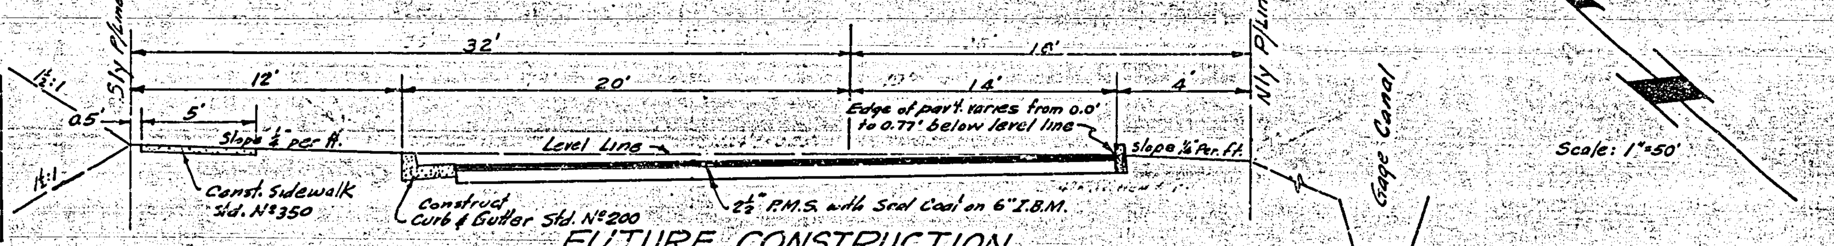


FUTURE CONSTRUCTION
**TYPICAL SECTION**
FAIRVIEW AVENUE
from 0+50 to 1+22

**NOTE:** All construction shall be in accordance with City Standard Specifications Nº 460.

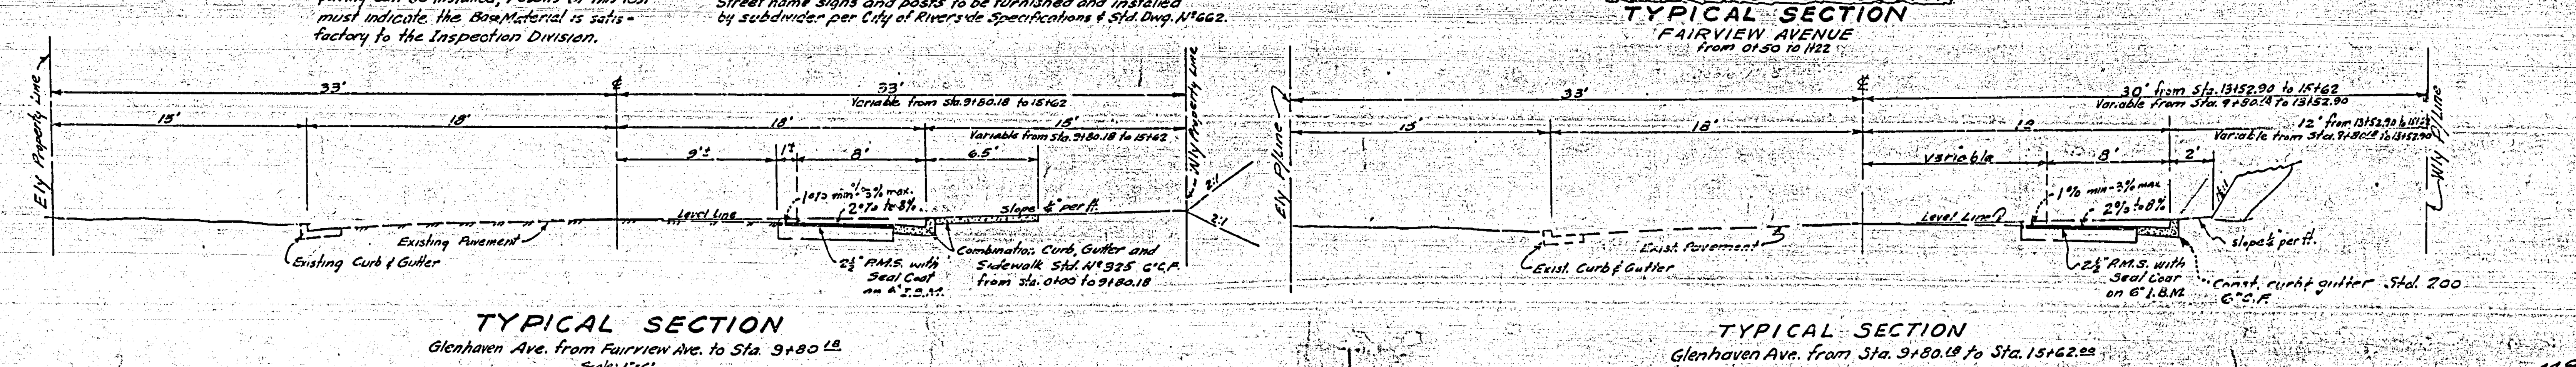


TYPICAL SECTION
Glenhaven Ave. from Fairview Ave. to Sta. 9+80.18
Scale: 1"=6'

TYPICAL SECTION
Glenhaven Ave. from Sta. 9+80.18 to Sta. 15+62.00

*SEE REVISION NOTES ON SHEET 2. F.B. 52 L14

**McKEE & CRAWLEY**
SURVEYORS AND ENGINEERS
APPROVED BY: George O. Crawley R.E. 9455 Date 11-19-59

CITY OF RIVERSIDE, CALIFORNIA
DEPARTMENT OF PUBLIC WORKS

GLENHAVEN KNOLLS
UNIT Nº 1
STREET PLANS AND PROFILES
GLENHAVEN AVENUE
FAIRVIEW AVENUE

APPROVED BY: [signature]
Director of Public Works
Date: 5-2-60

PLAN NO. R-384
Sheet 1 of 2

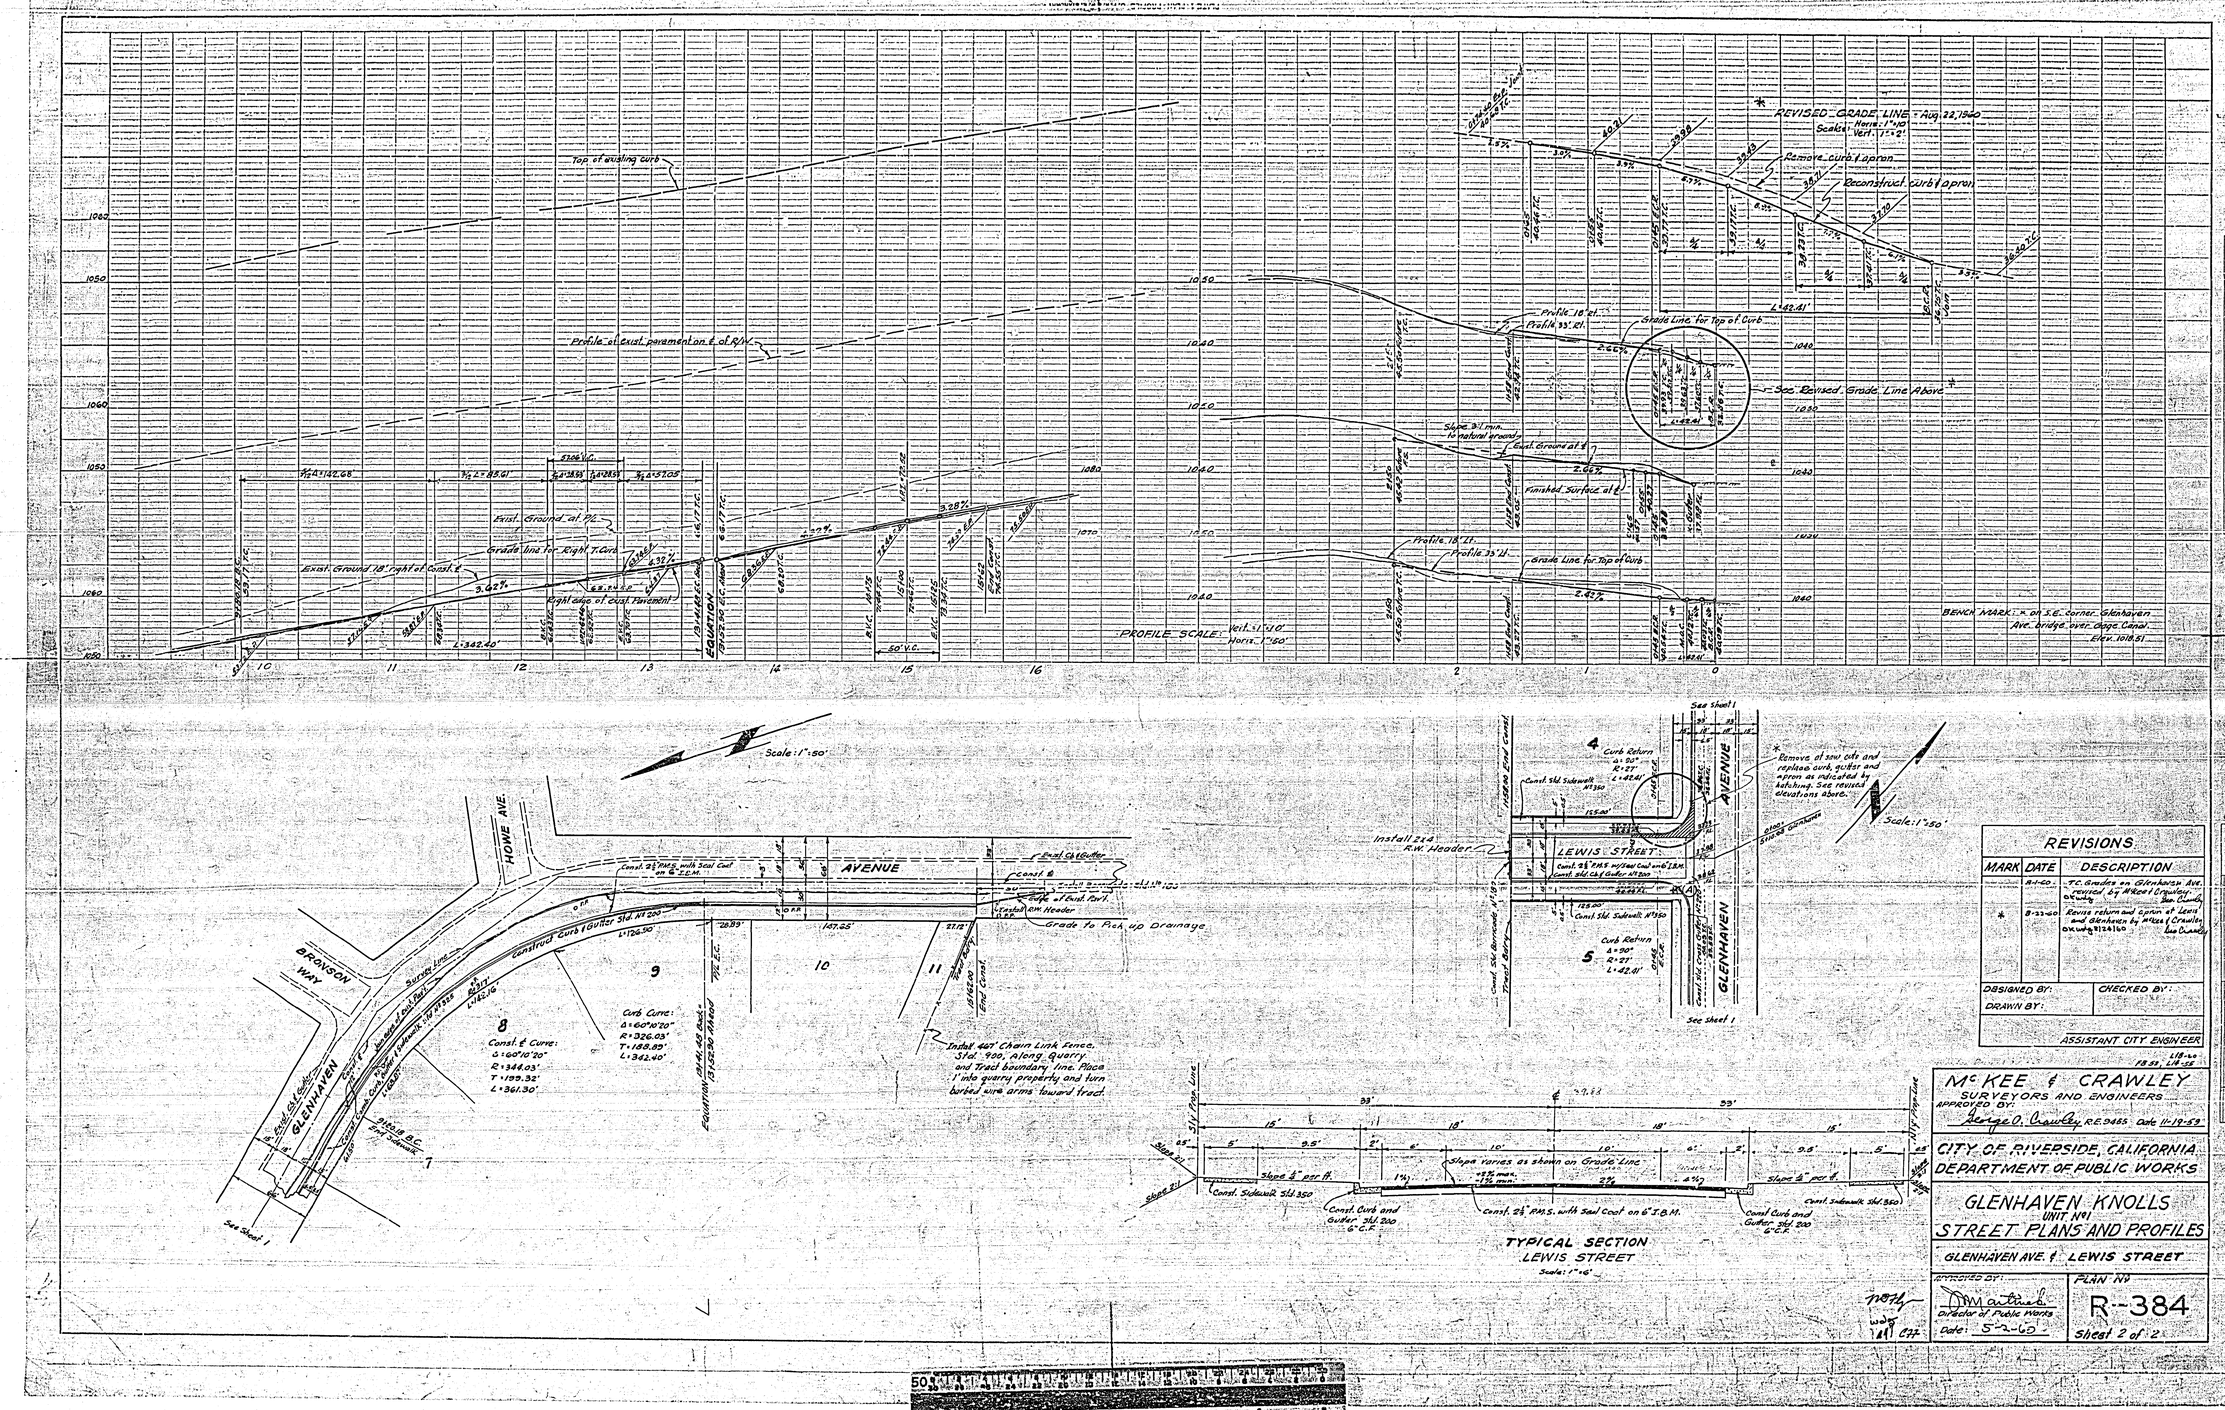


| REVISIONS | | |
|---|---|---|
| MARK | DATE | DESCRIPTION |
| | 8-1-60 | T.C. Grades on Glenhaven Ave. revised by McKee & Crawley. OK Wdg 8/24/60 |
| * | 8-22-60 | Revise return and apron at Lewis and Glenhaven by McKee & Crawley. OK Wdg 8/24/60 |

DESIGNED BY: CHECKED BY:
DRAWN BY:
ASSISTANT CITY ENGINEER

McKEE & CRAWLEY
SURVEYORS AND ENGINEERS
APPROVED BY: George O. Crawley R.E. 9455 Date 11-19-59

CITY OF RIVERSIDE, CALIFORNIA
DEPARTMENT OF PUBLIC WORKS

GLENHAVEN KNOLLS
UNIT No. 1
STREET PLANS AND PROFILES

GLENHAVEN AVE. & LEWIS STREET

APPROVED BY: D. Martinek
Director of Public Works
Date: 5-2-60

PLAN No. R-384
Sheet 2 of 2