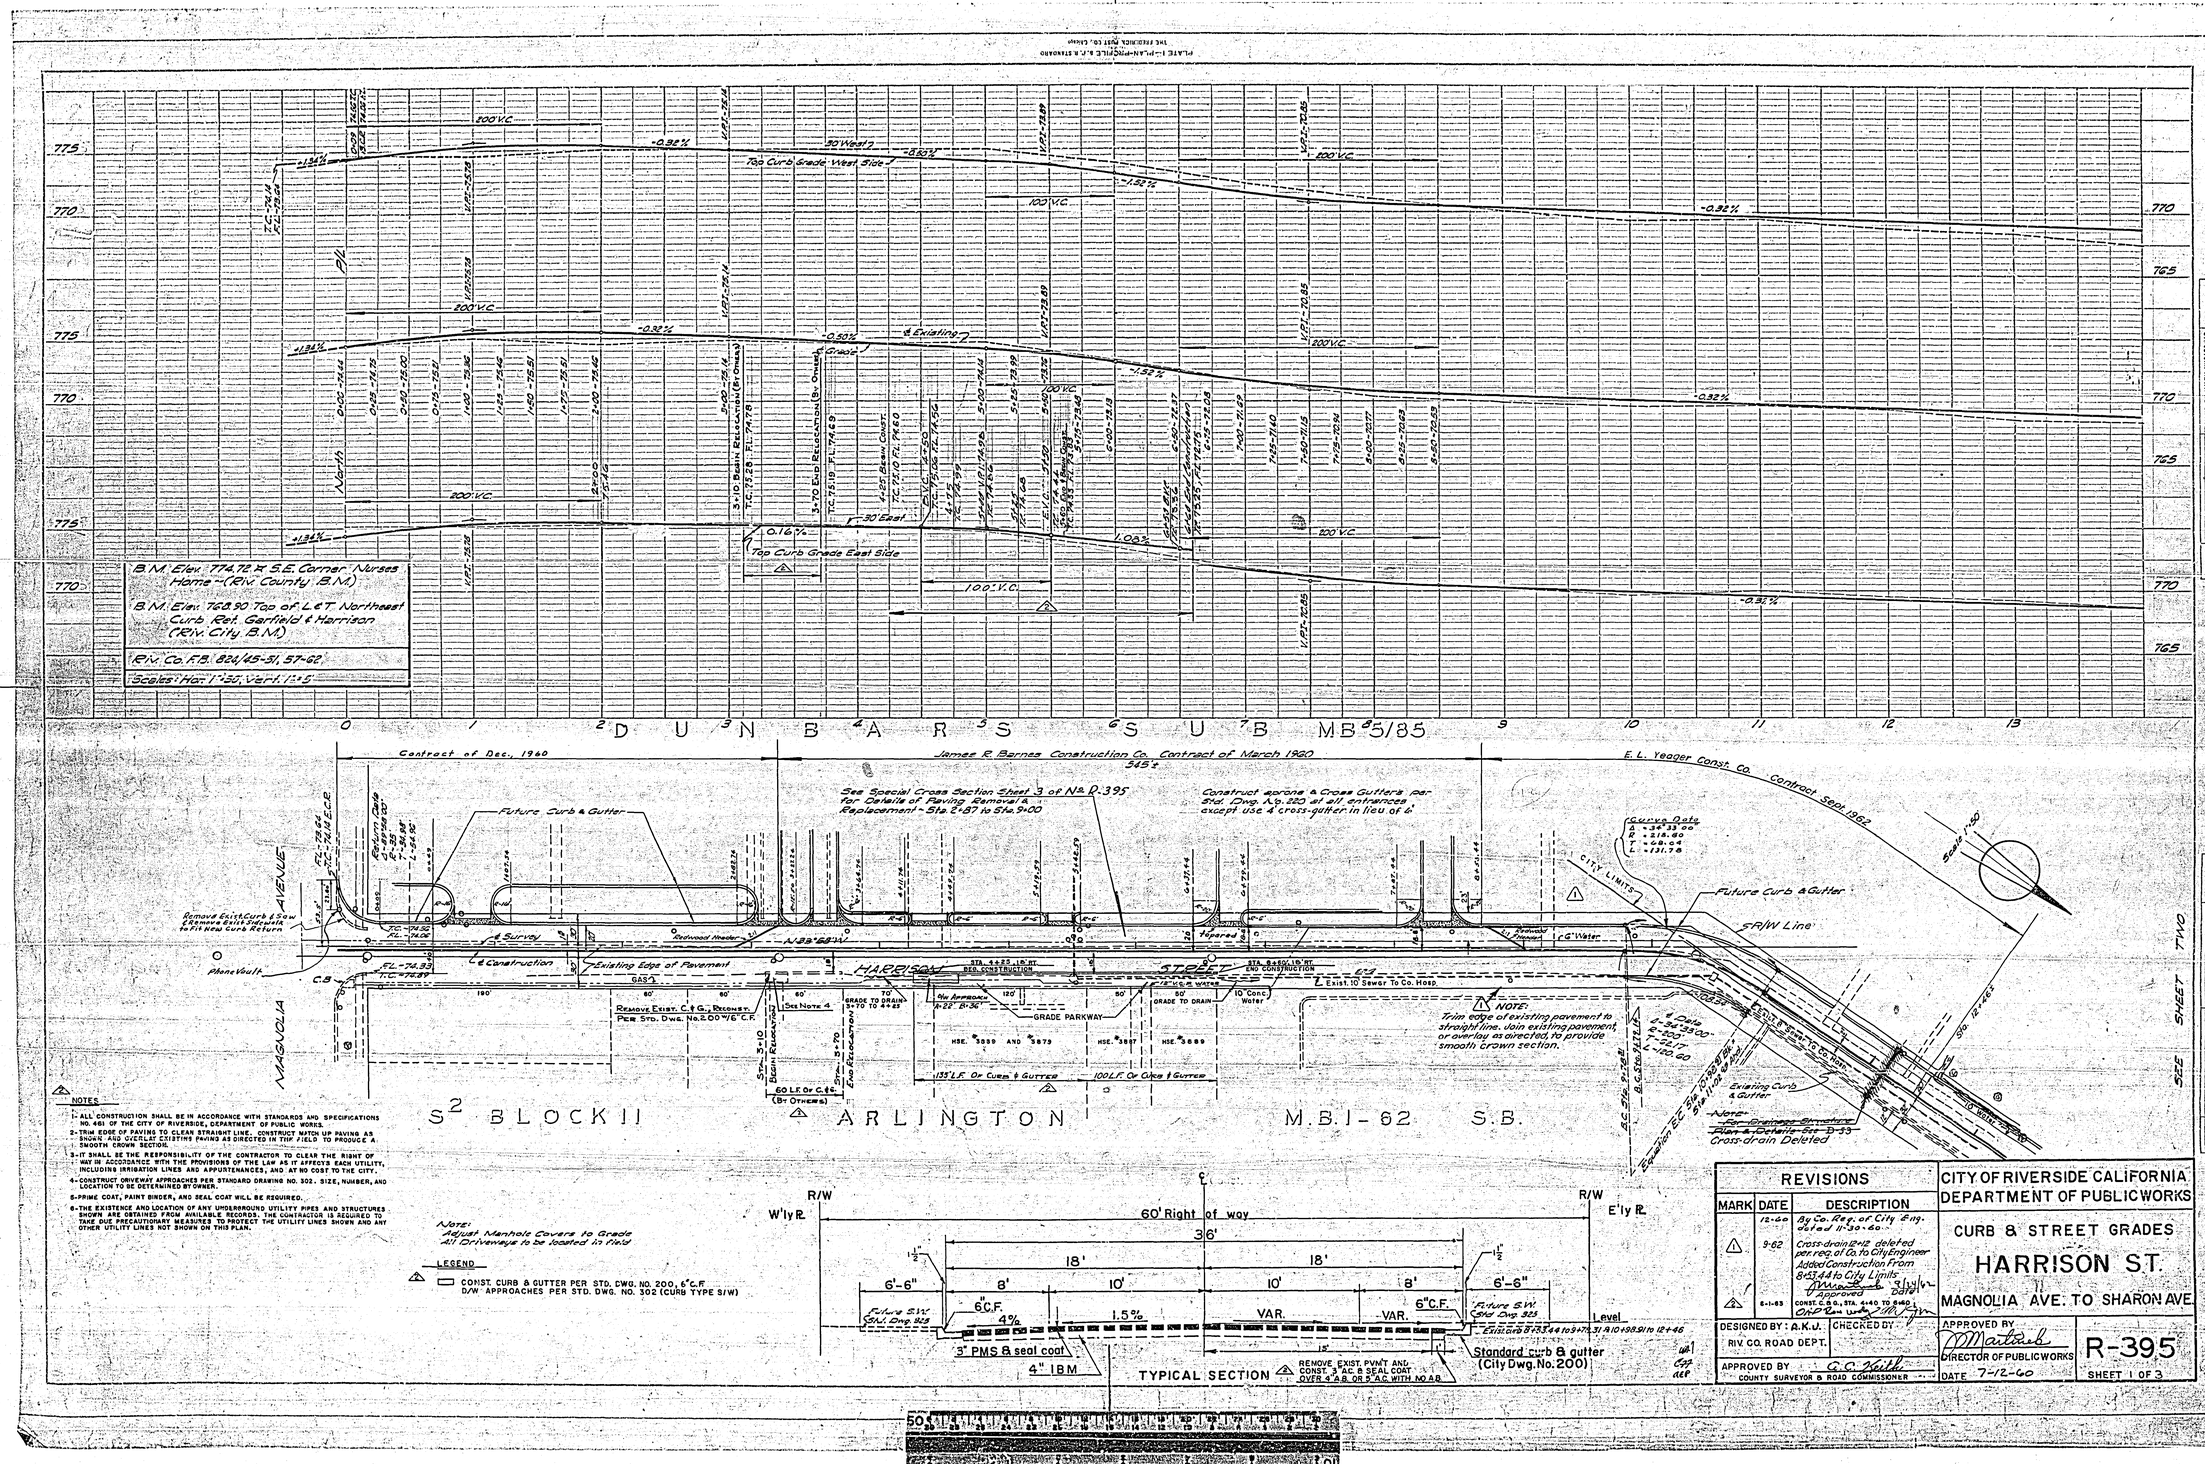

NOTES

1- ALL CONSTRUCTION SHALL BE IN ACCORDANCE WITH STANDARDS AND SPECIFICATIONS NO. 461 OF THE CITY OF RIVERSIDE, DEPARTMENT OF PUBLIC WORKS.

2- TRIM EDGE OF PAVING TO CLEAN STRAIGHT LINE. CONSTRUCT MATCH UP PAVING AS SHOWN AND OVERLAY EXISTING PAVING AS DIRECTED IN THE FIELD TO PRODUCE A SMOOTH CROWN SECTION.

3- IT SHALL BE THE RESPONSIBILITY OF THE CONTRACTOR TO CLEAR THE RIGHT OF WAY IN ACCORDANCE WITH THE PROVISIONS OF THE LAW AS IT AFFECTS EACH UTILITY, INCLUDING IRRIGATION LINES AND APPURTENANCES, AND AT NO COST TO THE CITY.

4- CONSTRUCT DRIVEWAY APPROACHES PER STANDARD DRAWING NO. 302. SIZE, NUMBER, AND LOCATION TO BE DETERMINED BY OWNER.

5- PRIME COAT, PAINT BINDER, AND SEAL COAT WILL BE REQUIRED.

6- THE EXISTENCE AND LOCATION OF ANY UNDERGROUND UTILITY PIPES AND STRUCTURES SHOWN ARE OBTAINED FROM AVAILABLE RECORDS. THE CONTRACTOR IS REQUIRED TO TAKE DUE PRECAUTIONARY MEASURES TO PROTECT THE UTILITY LINES SHOWN AND ANY OTHER UTILITY LINES NOT SHOWN ON THIS PLAN.

REVISIONS		
MARK	DATE	DESCRIPTION
1	12-60	By Co. Req. of City Eng. dated 11-30-60.
2	9-62	Cross-drain 12"-12" deleted per req. of Co. to City Engineer. Added Construction From 8+53.44 to City Limits. Approved 9/24/62 Date. CONST. C.&G., STA. 4+40 TO 8+60
	6-1-63	

CITY OF RIVERSIDE CALIFORNIA
DEPARTMENT OF PUBLIC WORKS

CURB & STREET GRADES

HARRISON ST.

MAGNOLIA AVE. TO SHARON AVE.

DESIGNED BY: A.K.J. RIV. CO. ROAD DEPT.
CHECKED BY:
APPROVED BY: C.C. Keith, COUNTY SURVEYOR & ROAD COMMISSIONER
APPROVED BY: [signature], DIRECTOR OF PUBLIC WORKS
DATE 7-12-60

R-395

SHEET 1 OF 3

PROFILE
NOTE BOOK NO.
SURVEYED
PLOTTED
CHECKED
STRUCTURE NOTATIONS CHECKED
18
DATE

PLAN
NOTE BOOK NO.
SURVEYED
PLOTTED
ALIGNMENT CHECKED
R.T. OF WAY CHECKED
18
DATE

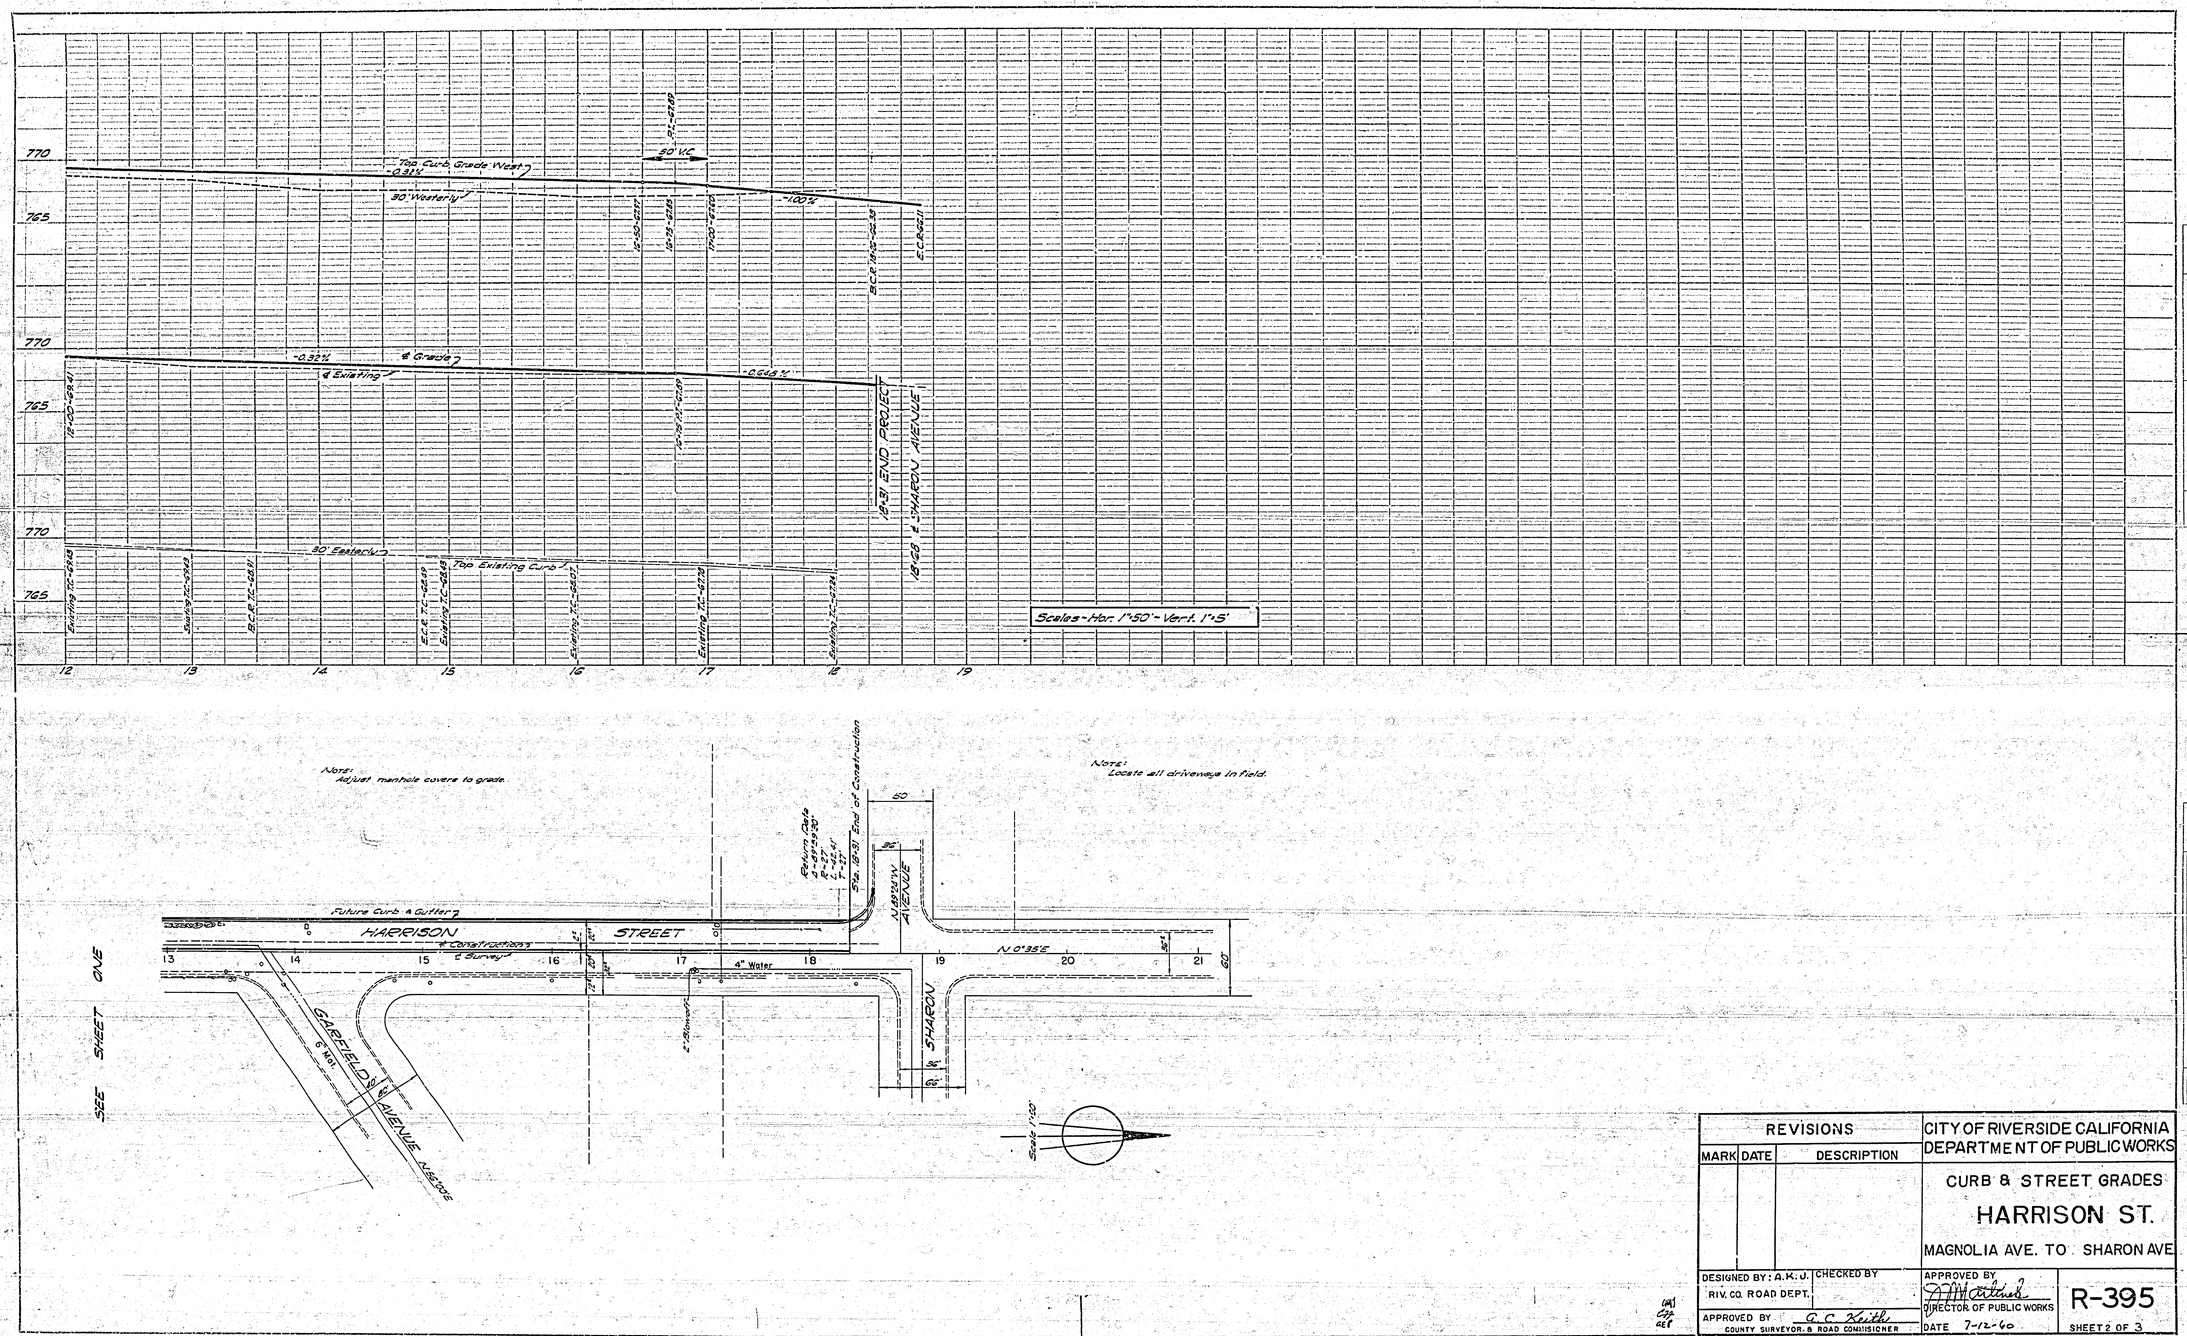

REVISIONS		
MARK	DATE	DESCRIPTION

CITY OF RIVERSIDE CALIFORNIA
DEPARTMENT OF PUBLIC WORKS

CURB & STREET GRADES

HARRISON ST.

MAGNOLIA AVE. TO SHARON AVE.

DESIGNED BY: A.K.J. RIV. CO. ROAD DEPT.
CHECKED BY
APPROVED BY A. C. Keith COUNTY SURVEYOR & ROAD COMMISSIONER
APPROVED BY [signature] DIRECTOR OF PUBLIC WORKS
DATE 7-12-60

R-395

SHEET 2 OF 3

PROFILE
SURVEYED
PLOTTED
GRADES CHECKED
R. M. NOTED
STRUCTURE SYSTEMS CHKD.
NOTE BOOK NO.
BY
DATE

PLAN
SURVEYED
PLOTTED
ALIGNMENT CHECKED
RT. OF WAY CHECKED
NOTE BOOK NO.
BY
DATE

CROSS SECTIONS

Scale: 1 Inch = 5 feet

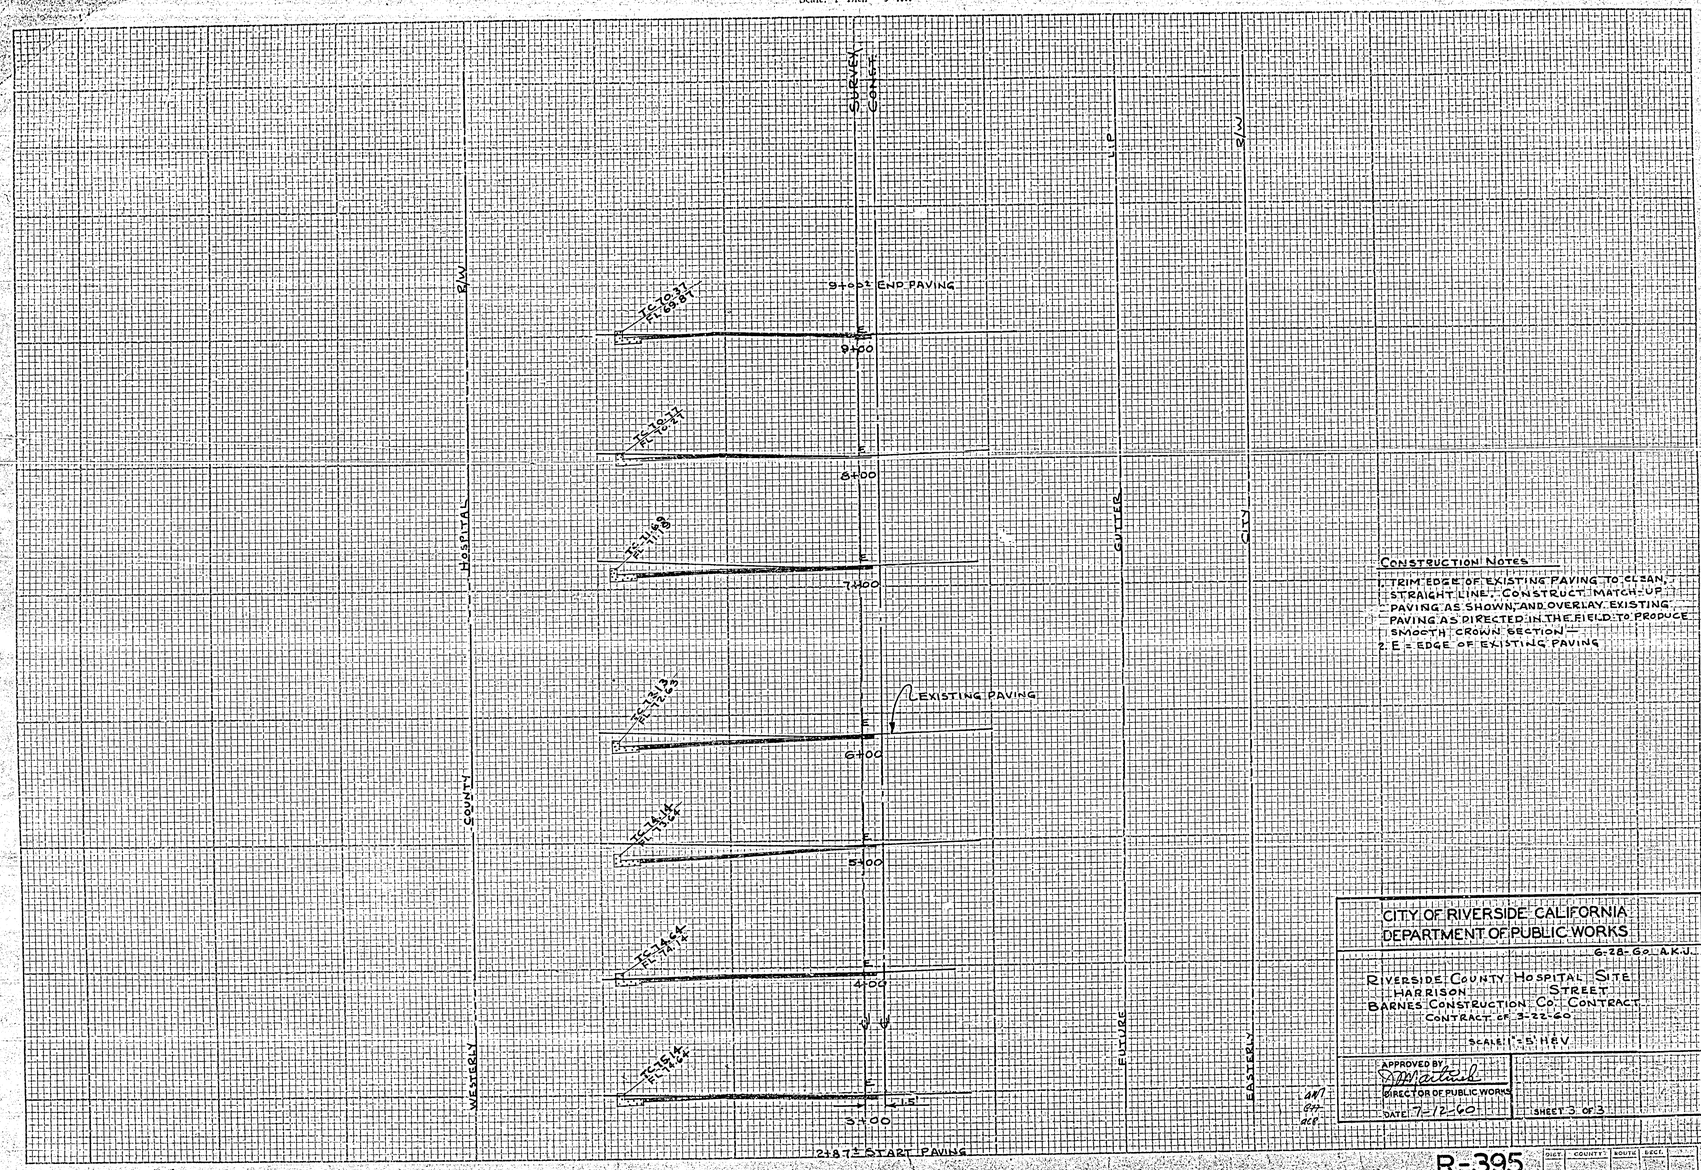

CONSTRUCTION NOTES

1. TRIM EDGE OF EXISTING PAVING TO CLEAN, STRAIGHT LINE. CONSTRUCT MATCH-UP PAVING AS SHOWN, AND OVERLAY EXISTING PAVING AS DIRECTED IN THE FIELD TO PRODUCE SMOOTH CROWN SECTION
2. E = EDGE OF EXISTING PAVING

CITY OF RIVERSIDE CALIFORNIA
DEPARTMENT OF PUBLIC WORKS

6-28-60 A.K.J.

RIVERSIDE COUNTY HOSPITAL SITE
HARRISON STREET
BARNES CONSTRUCTION CO. CONTRACT
CONTRACT OF 3-22-60

SCALE: 1" = 5' H & V

APPROVED BY
DIRECTOR OF PUBLIC WORKS
DATE 7-12-60

SHEET 3 OF 3

R-395