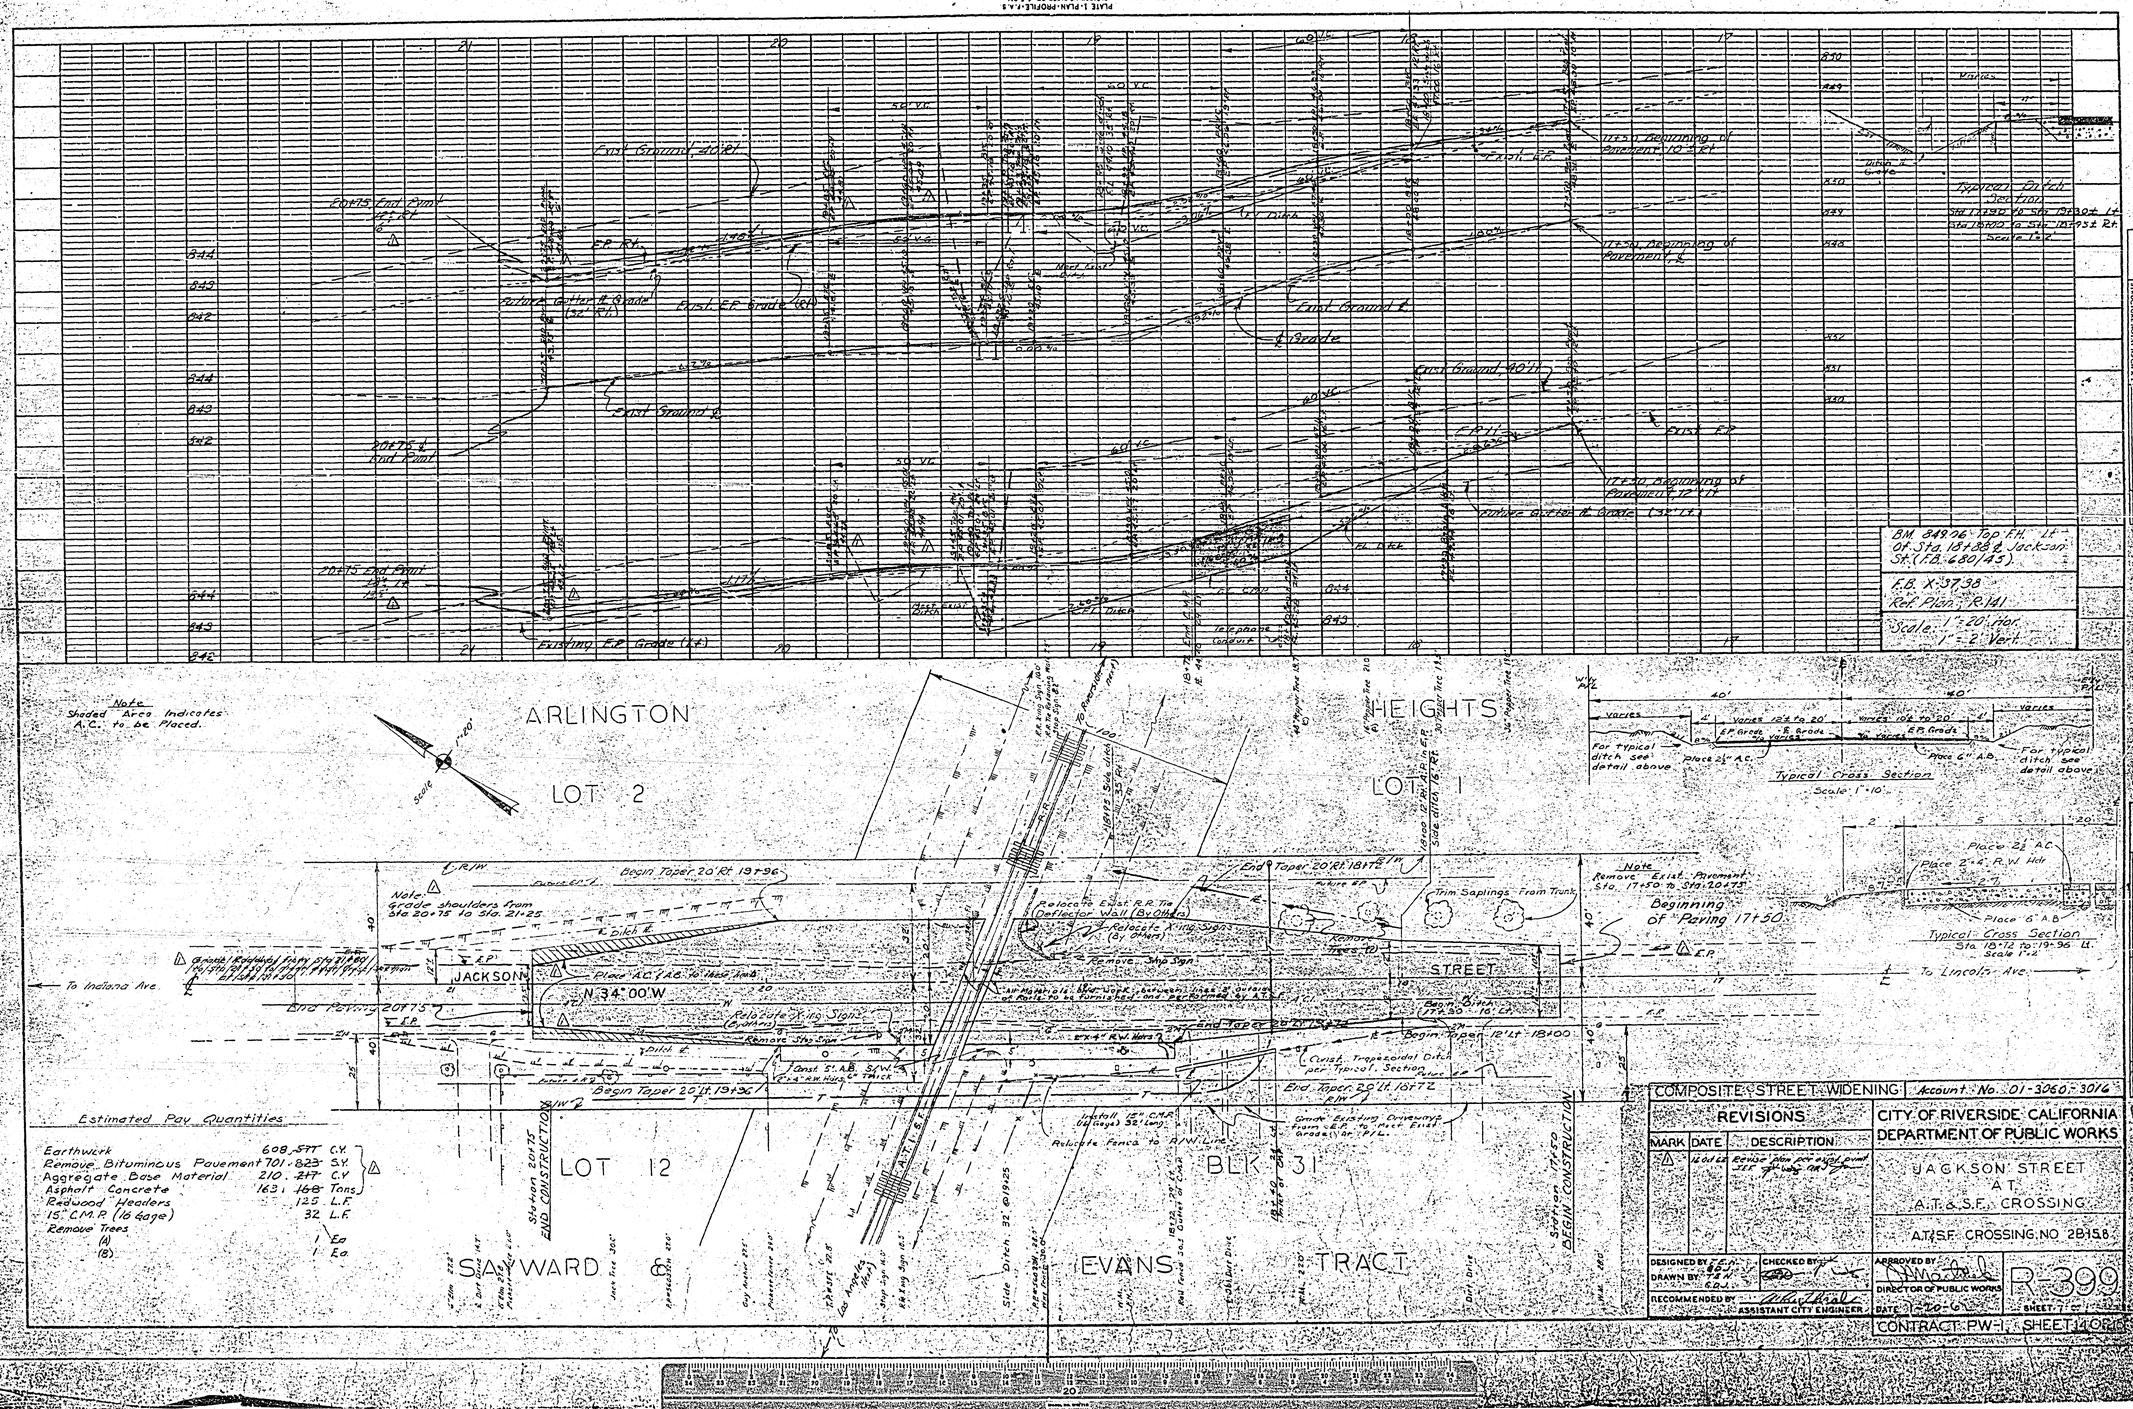

Estimated Pay Quantities

Earthwork	608 ~~577~~	C.Y.
Remove Bituminous Pavement	701 ~~823~~	S.Y.
Aggregate Base Material	210 ~~217~~	C.Y.
Asphalt Concrete	163 ~~168~~	Tons
Redwood Headers	125	L.F.
15" C.M.P. (16 Gage)	32	L.F.
Remove Trees		
(A)	1	Ea.
(B)	1	Ea.

COMPOSITE STREET WIDENING Account No. 01-3060-3016

REVISIONS		
MARK	DATE	DESCRIPTION
1	12-20-62	Revise plan per revised pond

CITY OF RIVERSIDE, CALIFORNIA
DEPARTMENT OF PUBLIC WORKS

JACKSON STREET AT A.T.&S.F. CROSSING

A.T.&S.F. CROSSING NO. 2B158

DESIGNED BY E.A.
DRAWN BY E.D.J.
CHECKED BY
RECOMMENDED BY ASSISTANT CITY ENGINEER
APPROVED BY DIRECTOR OF PUBLIC WORKS
DATE 12-20-62

R-399

SHEET 7 OF 8

CONTRACT PW-1 SHEET 14 OF 18

PROFILE
SURVEYED
PLOTTED
GRADES CHECKED
STRUCTURE INVITING CHECK
NOTE BOOK NO.
NO. REVISION BY DATE

PLAN
SURVEYED
PLOTTED
GRADES CHECKED
STRUCTURE INVITING CHECK
NOTE BOOK NO.
NO. REVISION BY DATE

PLATE 1-PLAN-PROFILE-F.A.S.
CLEARWATER PAPER CO., L.T.D., L.
No. 2006-1