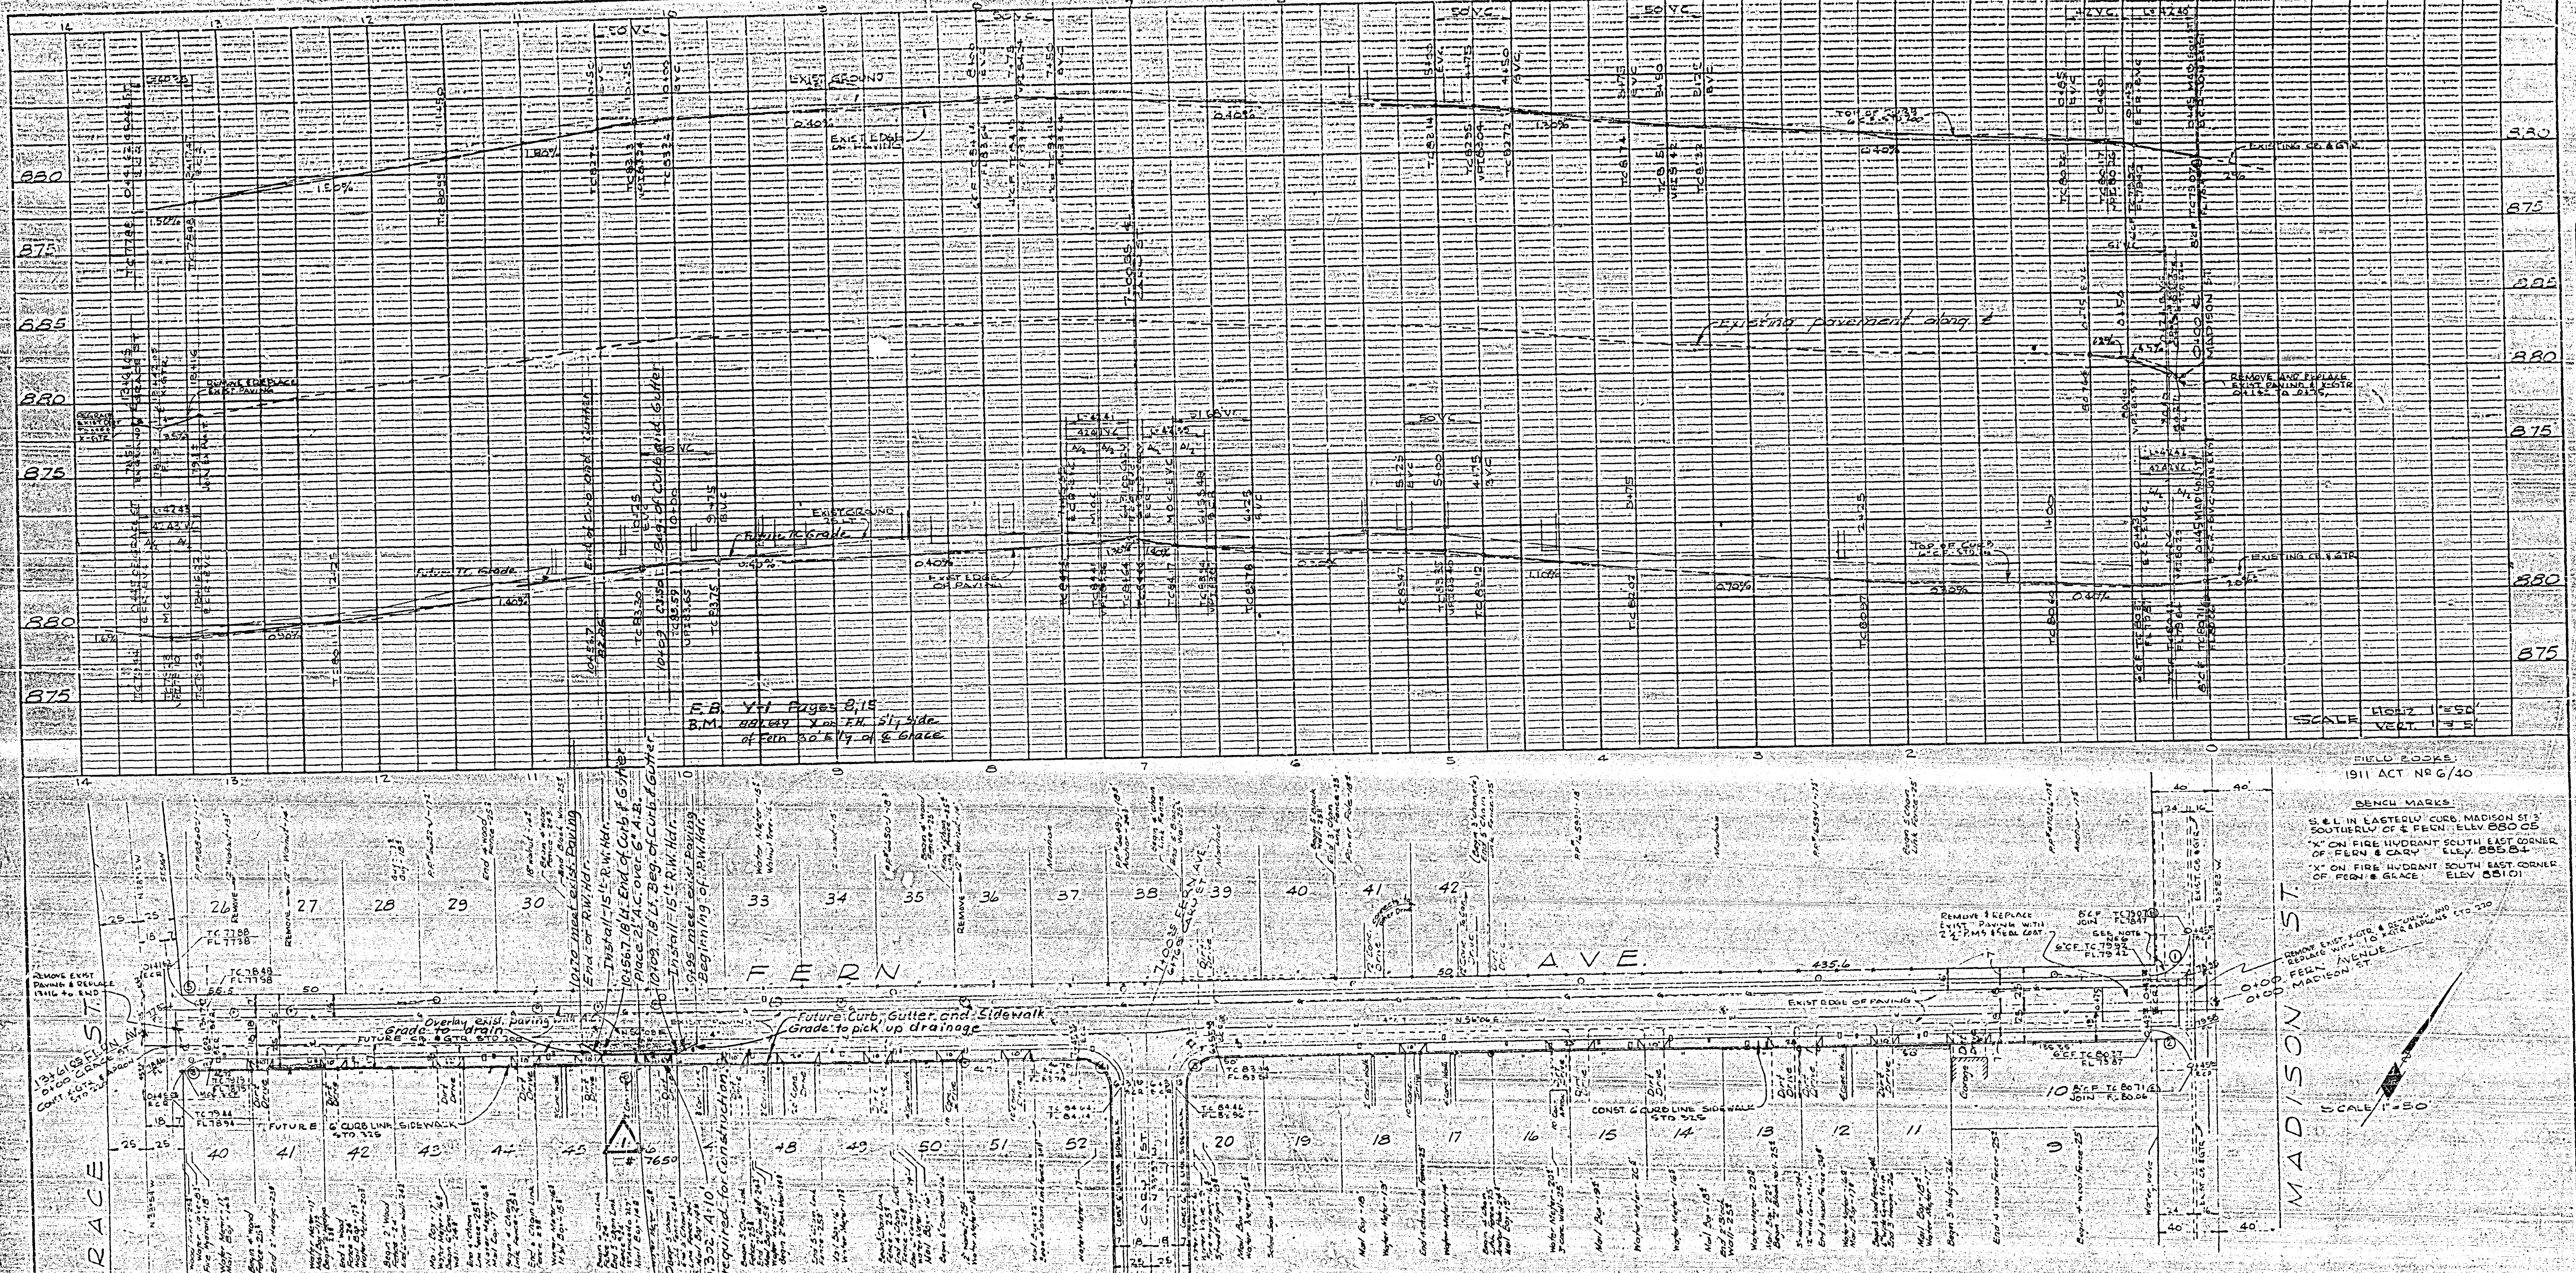

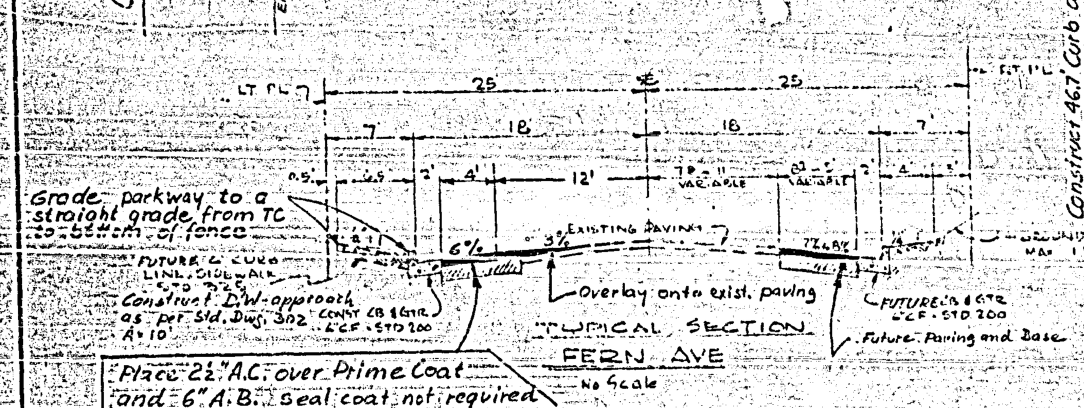

TYPICAL SECTION
FERN AVE
No Scale

CURB RETURN DATA

NO	R	Δ	T	L
1	27	83°55'00"	21.60	42.40
2	27	90°01'00"	27.00	42.42
3	27	89°57'00"	26.98	42.39
4	27	90°00'00"	27.00	42.41
5	27	85°30'00"	25.02	40.36
6	27	90°03'00"	27.02	42.43

GENERAL NOTES

1. IT SHALL BE RESPONSIBILITY OF THE CONTRACTOR TO CLEAR THE RIGHT OF WAY IN ACCORDANCE WITH THE PROVISIONS OF LAW AS IT AFFECTS EACH UTILITY INCLUDING IRRIGATION LINES AND APPURTENANCES AND AT NO EXTRA COST TO THE CITY.

2. CONSTRUCTION SHALL BE IN ACCORDANCE WITH THE CITY OF RIVERSIDE DEPT OF PUBLIC WORKS, SPECIFICATIONS NO 461 AND STANDARD DRAWINGS.

3. TRIM EDGE OF EXISTING PAVING WHERE NEW PAVING JOINS EXISTING PAVEMENT TO CLEAN, STRAIGHT LINE. CONSTRUCT MATCH-UP PAVING AS SHOWN, AND OVERLAY EXISTING PAVING AS DIRECTED IN FIELD TO PRODUCE SMOOTH CROWN SECTION.

5. RELOCATE EXISTING SIGNS AND MAIL BOXES AS REQ'D. AS DIRECTED IN FIELD. REMOVE AND DISPOSE OF ANY TOPO WITHIN GRADING AREA THAT INTERFERES WITH CONST.

Note Approval of this Sheet is from Sta. 10+09 to 10+56.7 Lt. only.

REVISIONS		
MARK	DATE	DESCRIPTION
△1	9-16-64	Adapted from Plan R-431 to show Improvements for House 7650 Fern St. in Connection for a Building Permit.

DESIGNED BY dib
DRAWN BY dib / ABT
CHECKED BY [signature] R.E. 9076
RECOMMENDED BY A. R. Theal ASSISTANT CITY ENGINEER

CITY OF RIVERSIDE CALIFORNIA
DEPARTMENT OF PUBLIC WORKS

FERN AVE. - CARY ST. IMPROVEMENT DISTRICT

FERN AVE.

GRACE ST. to MADISON ST.

APPROVED BY [signature]
DIRECTOR OF PUBLIC WORKS
DATE 9-24-64

R-431-C

SHEET 1 OF 1

Dwg No. 60-220 A