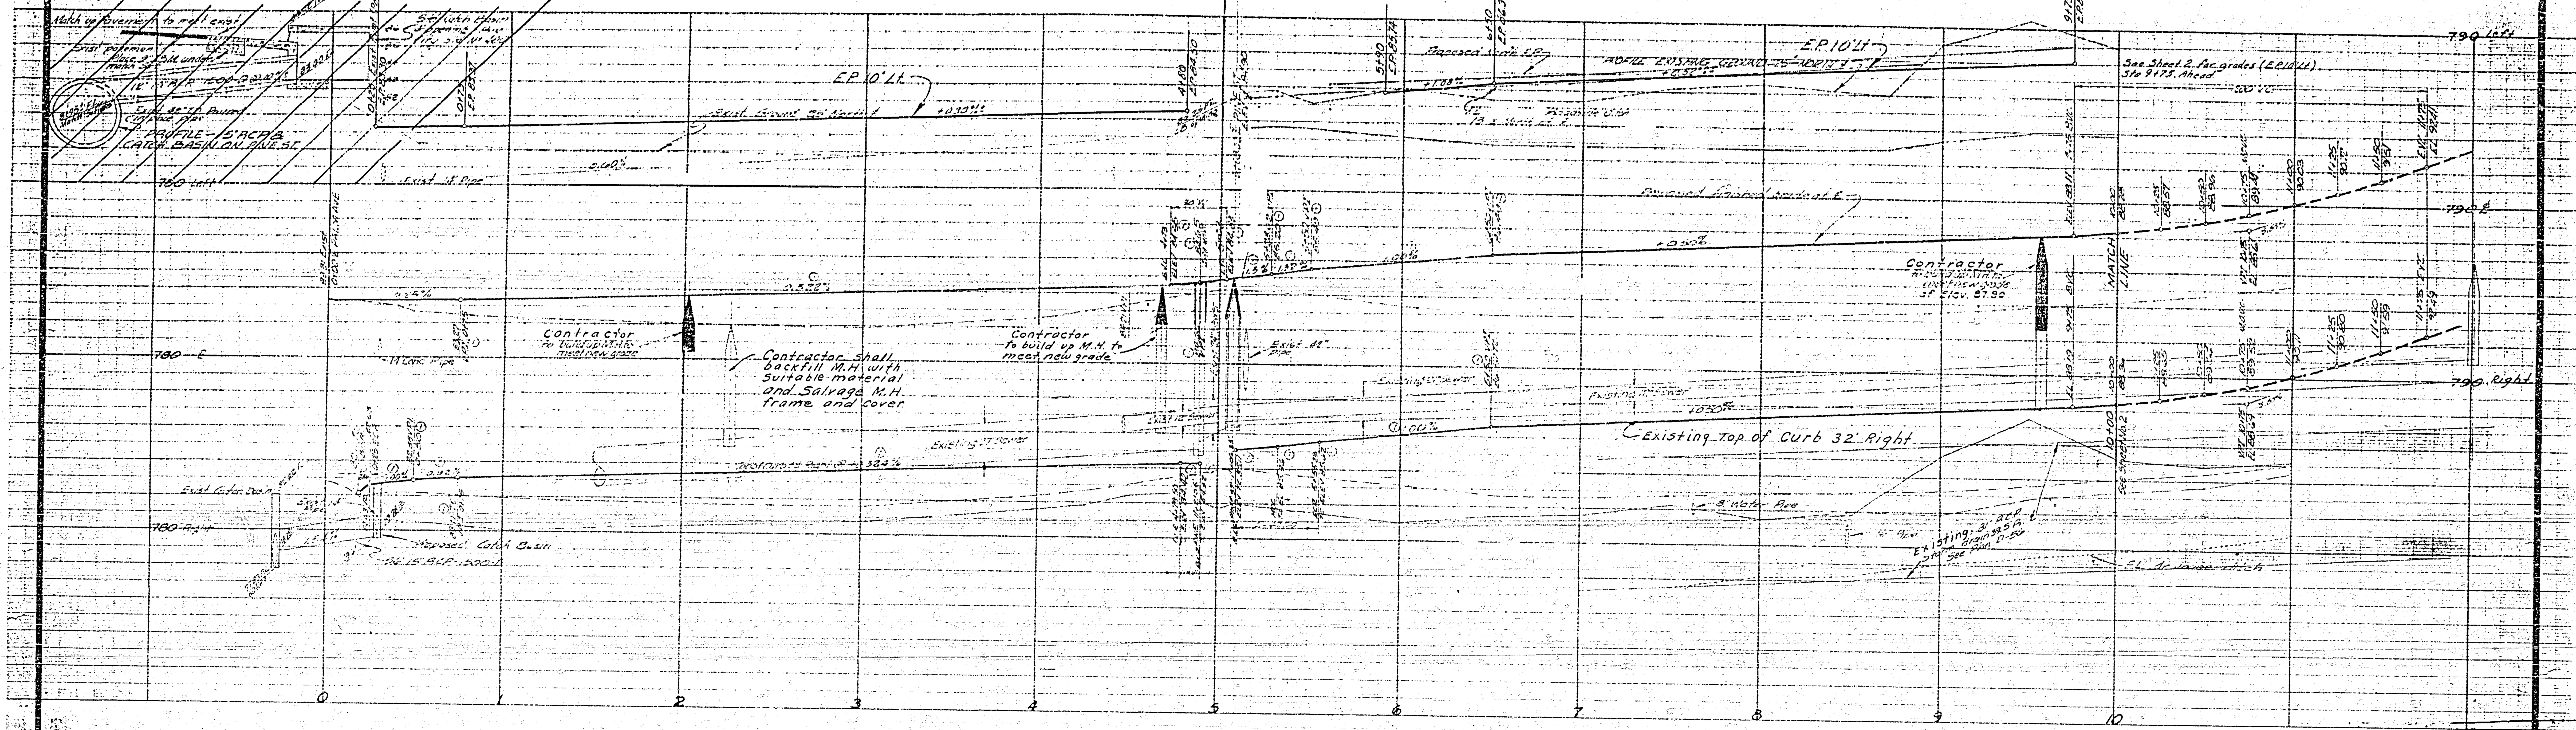


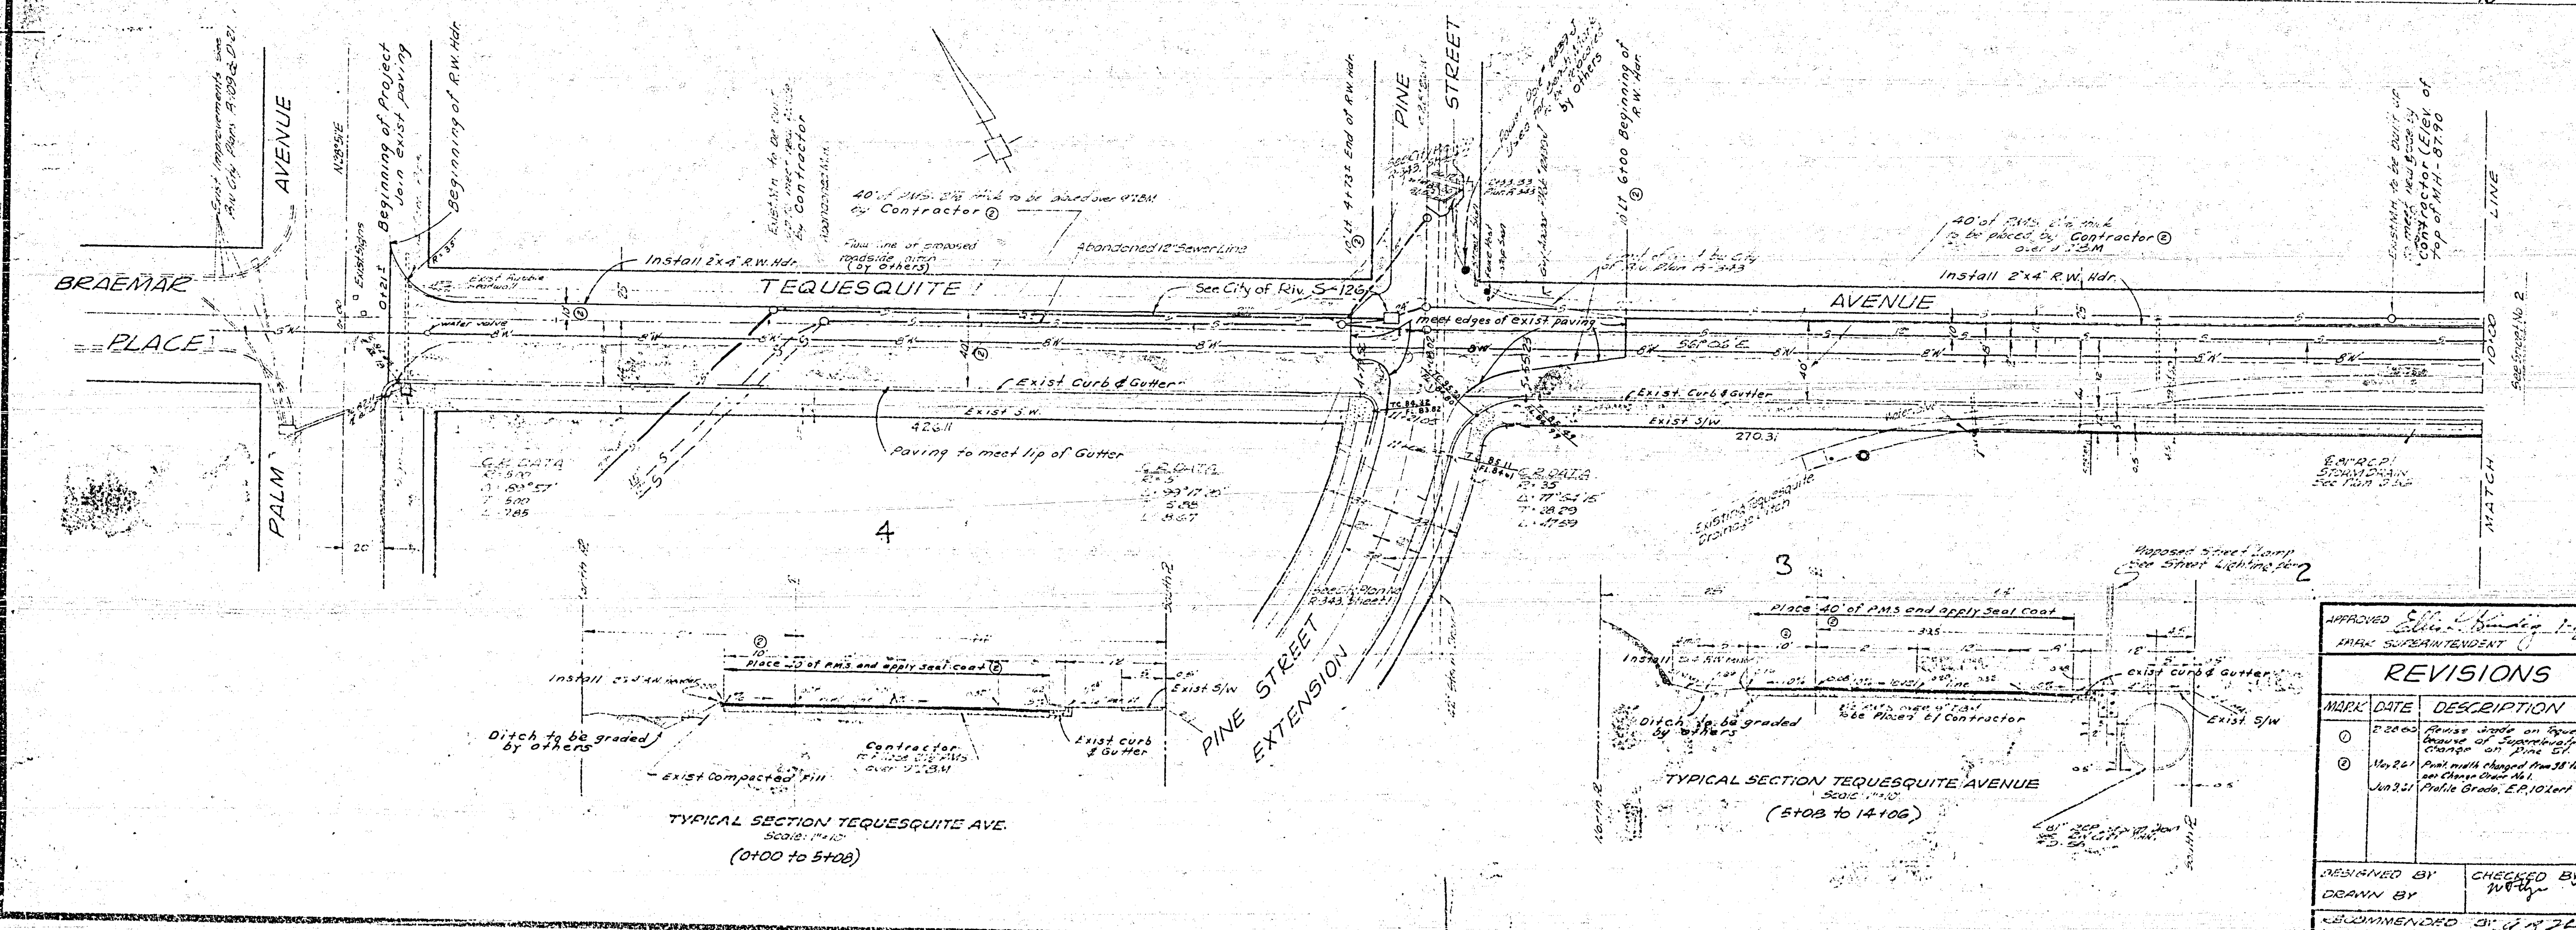


## NOTES

① Adopted from Plan R-422 prepared by J. F. Davidson - Civil Engineer, Riverside, California.

② This Contract includes, I.B.M., P.M.S., Seal Coat, Redwood Headers, and Raising manholes to grade.

③ Shaded area indicates present construction.

BENCH MARK
R.R. spike in power pole #124341, N.E. cor. Pine St. and Tequesquite Ave. ELEV. 785.01

FB 451-76 717-41 739-24

APPROVED Ellis L. Hinding 1-10-61 DATE
PARK SUPERINTENDENT

REVISIONS

| MARK | DATE | DESCRIPTION |
|---|---|---|
| ① | 2-28-63 | Revise Grade on Tequesquite because of Superelevation Change on Pine St. |
| ② | May 2-61 | Pvmt. width changed from 38' to 40', per Change Order No. 1. |
| | Jun 3-61 | Profile Grade, E.P. 10' Left added |

DESIGNED BY
DRAWN BY
CHECKED BY
RECOMMENDED BY — ASST. CITY ENGINEER

CITY OF RIVERSIDE, CALIFORNIA
DEPARTMENT OF PUBLIC WORKS

TEQUESQUITE AVENUE PAVING

FROM PALM AVE. TO BROCKTON AVENUE

HORIZ. SCALE 1"=40' VERT. SCALE 1"=4'

APPROVED BY
Director of Public Works

DATE 3-7-61

NO. R-448

SHEET 1 OF 2

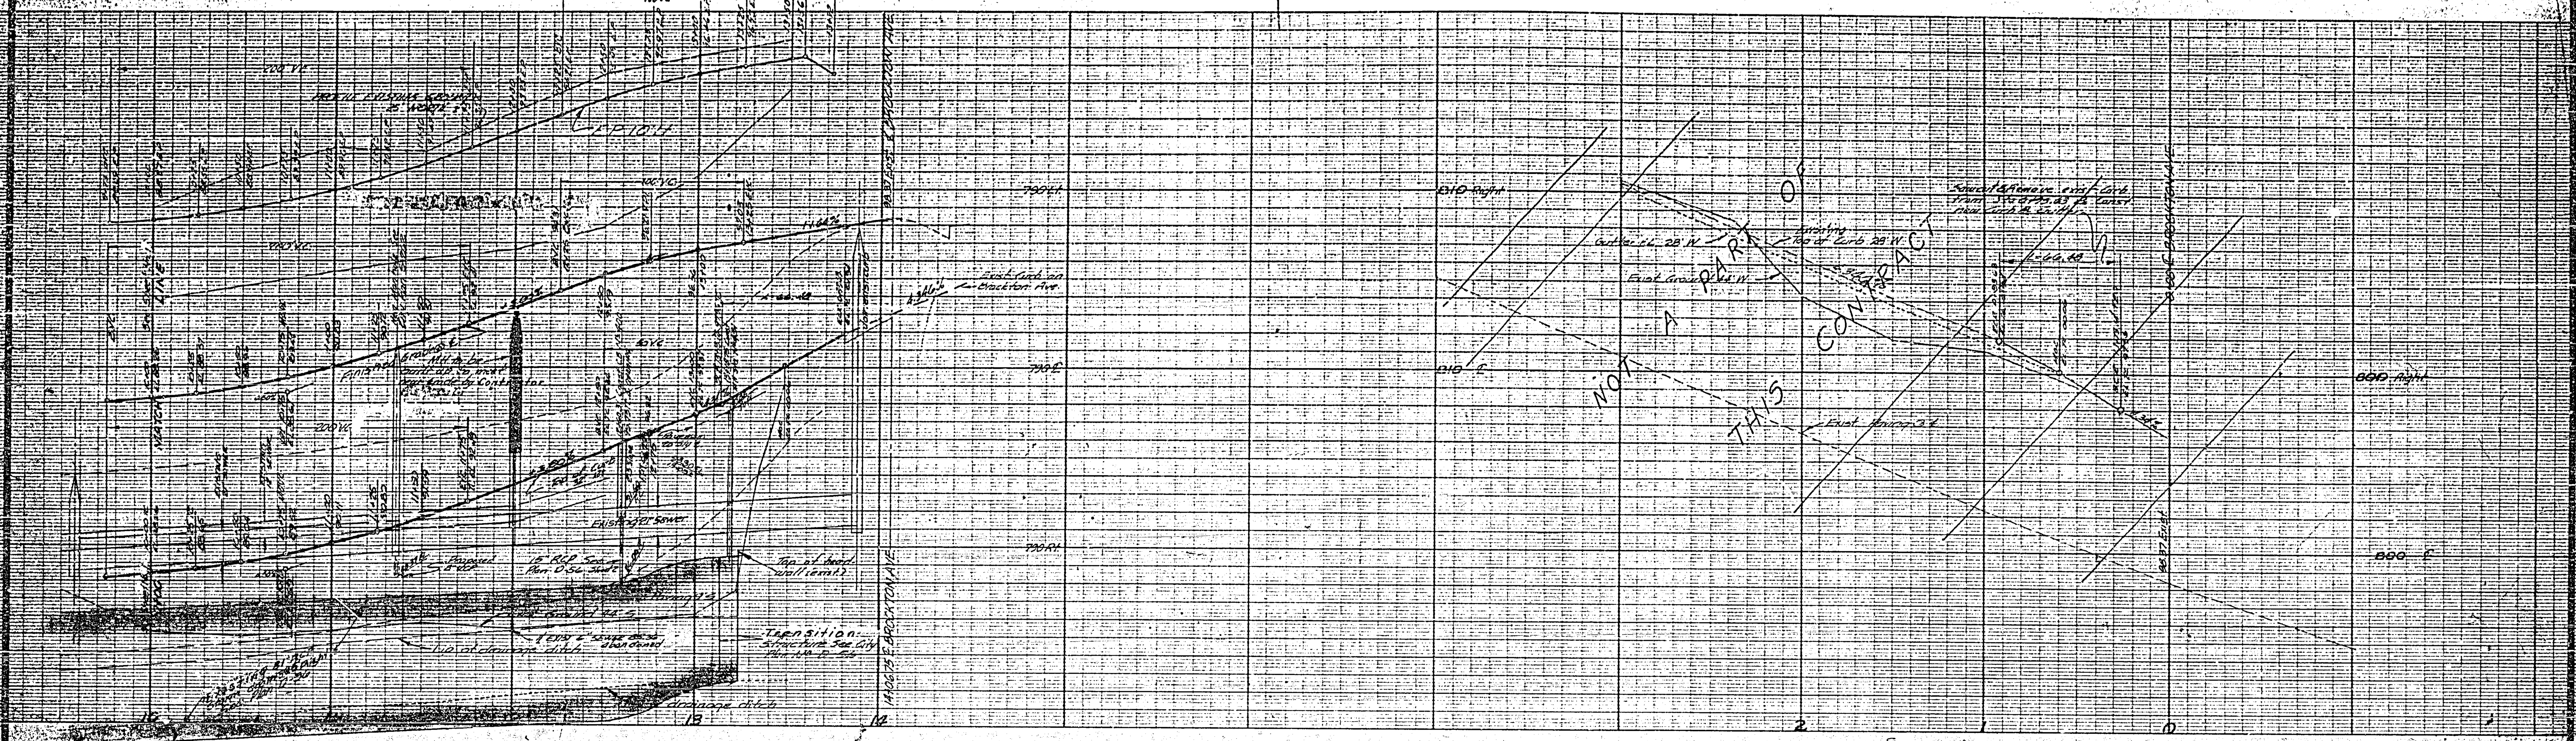


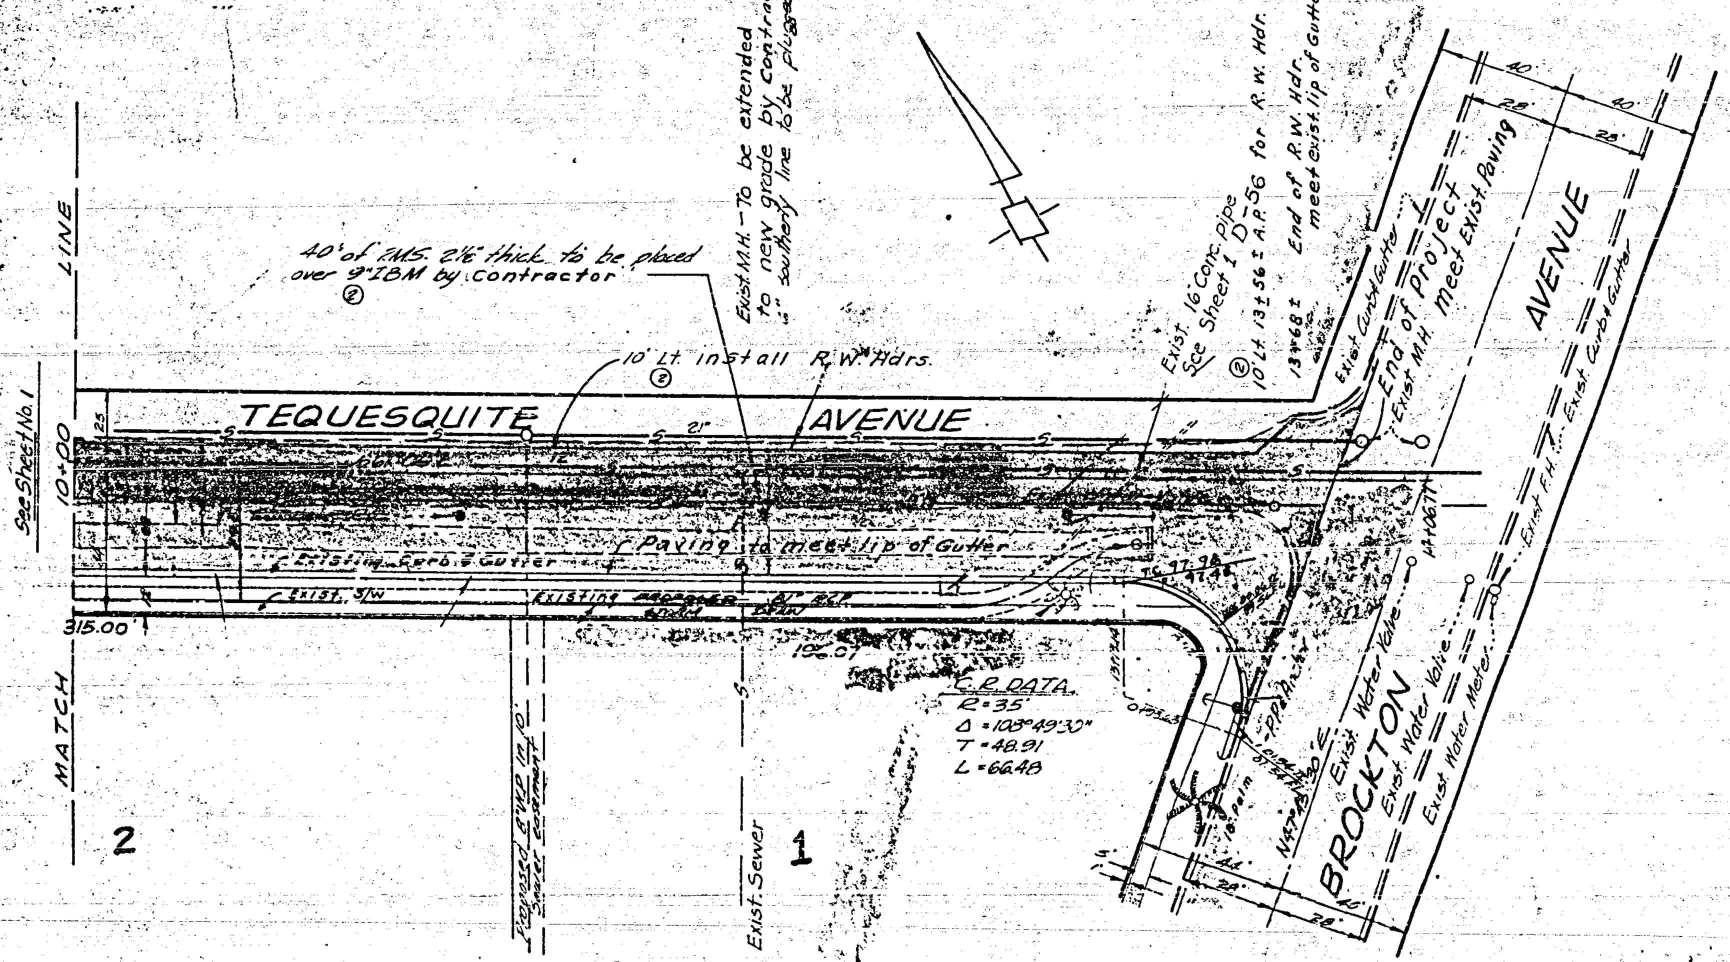


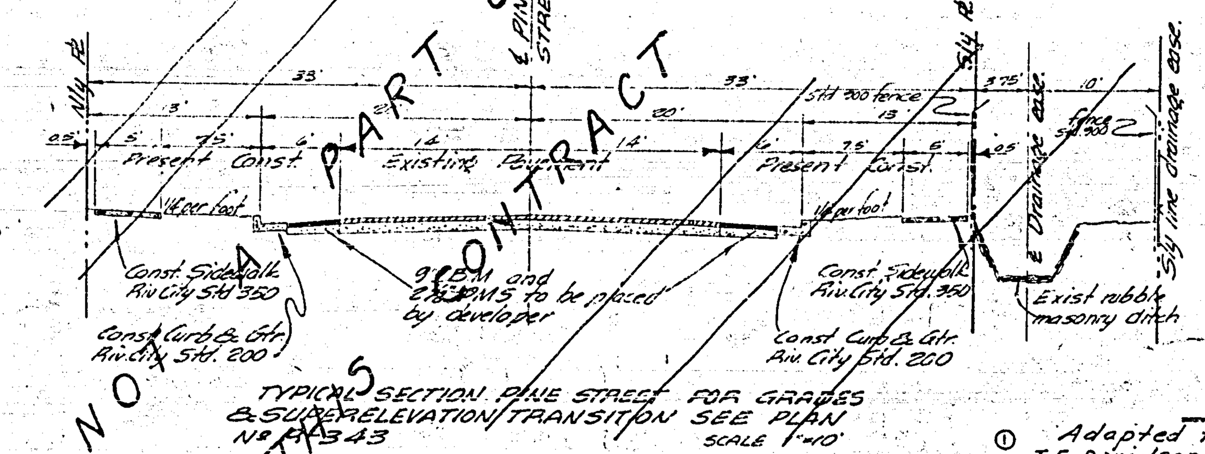


TYPICAL SECTION PINE STREET FOR GRADES & SUPERELEVATION TRANSITION SEE PLAN No R-343
SCALE 1"=10'

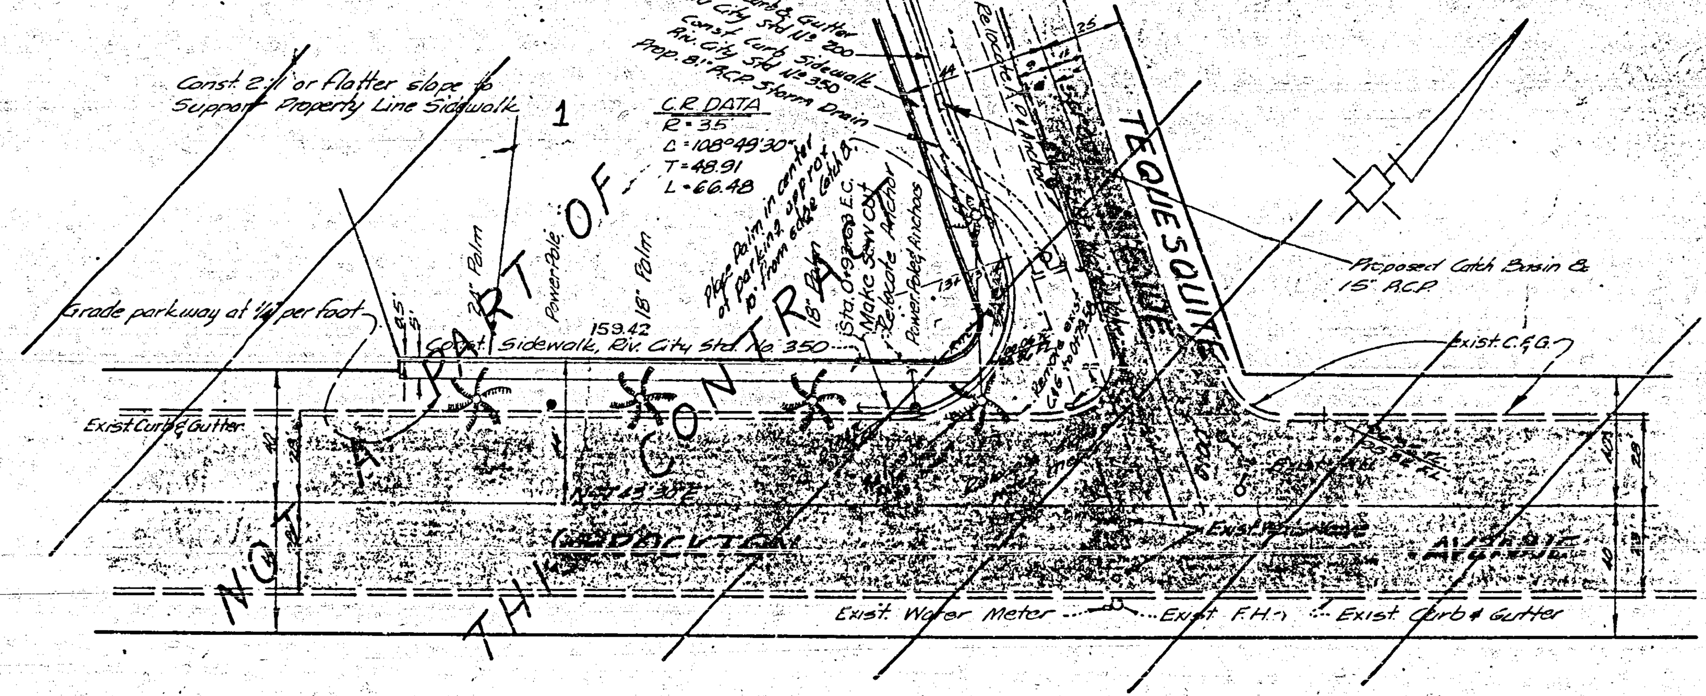


BENCH MARK
R.R. spike in power pole #12439 J N.E. cor. Pine St. and Tequesquite Ave. ELEV. 785.61

F.B. 651-76 & 717-31

## NOTES

① Adapted from Plan R-422 prepared by J.F. Davidson - Civil Engineer, Riverside, California.

② This Contract includes I.B.M., P.M.S. Seal Coat, Redwood headers, and raising manholes to grade.

③ Shaded area indicates present construction. To be 9" IBM, 2½" P.M.S. and seal coat.

APPROVED *Ellis L. Kinsley* 1-10-61
PARK SUPERINTENDENT DATE

| REVISIONS | | |
|---|---|---|
| MARK | DATE | DESCRIPTION |
| ② | May 2, 61 | Pvmt width changed from 38' to 40' per Change Order No. 1. T&H |
| | Jun 9, 61 | Profile Grade EP 10' Lt. added. T&H |

DESIGNED BY
DRAWN BY
CHECKED BY W.T.F.
RECOMMENDED BY A.R.H. ASST. CITY ENGINEER

CITY OF RIVERSIDE, CALIFORNIA
DEPARTMENT OF PUBLIC WORKS

TEQUESQUITE AVENUE
PAVING
FROM PALM AVE. TO BROCKTON AVENUE

HORIZ. SCALE 1"=40' VERT. SCALE 1"=4'

APPROVED BY *D. Martinez*
Director of Public Works
DATE 3-7-61

NO. R-448
SHEET 2 OF 2

2147