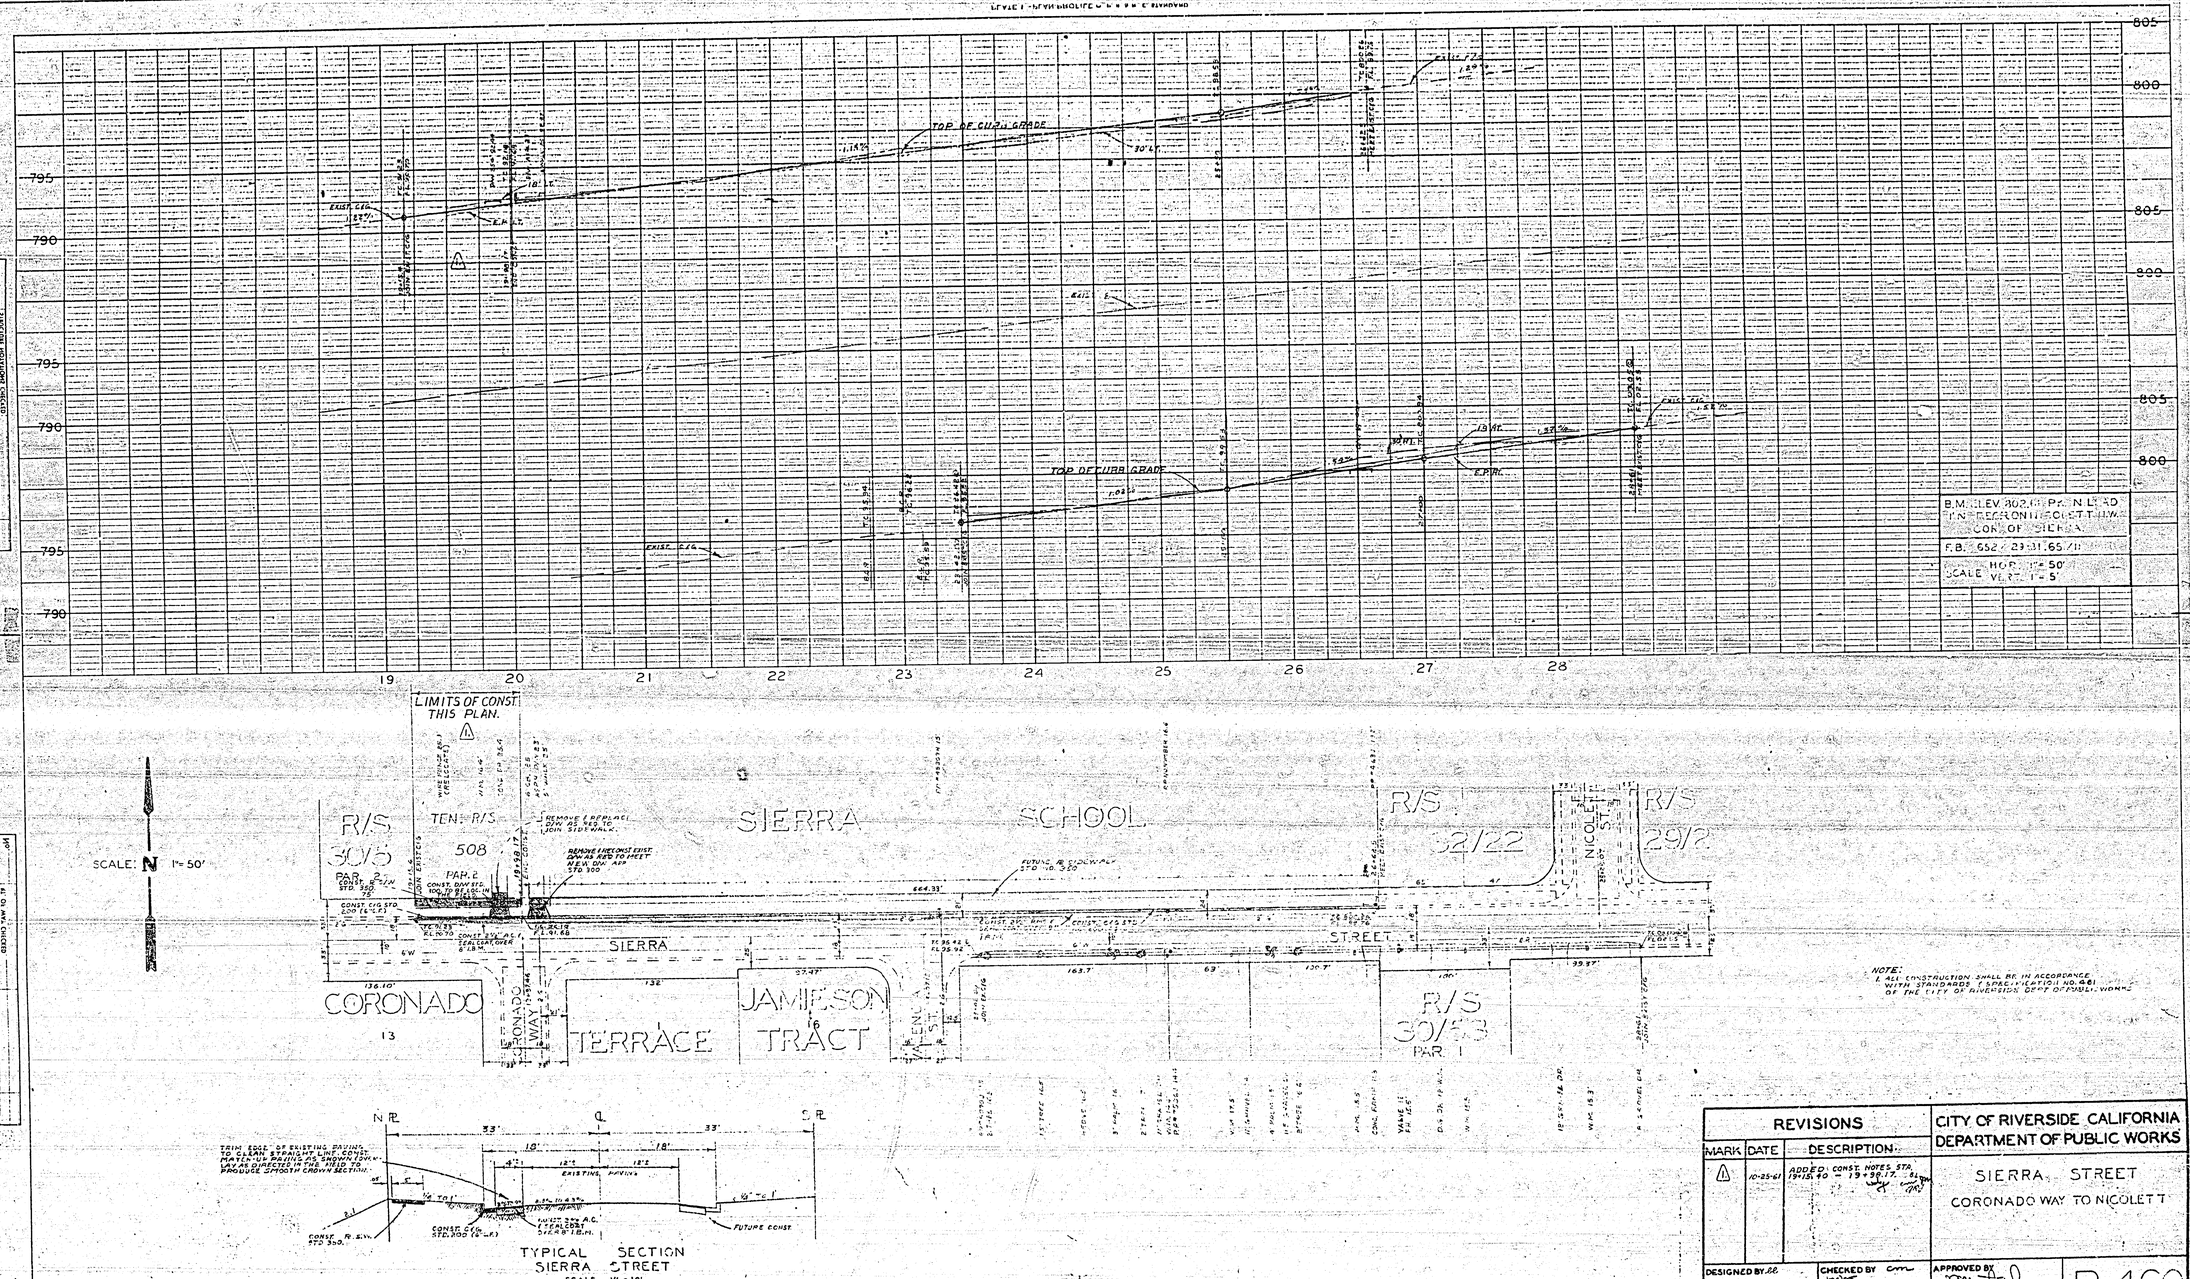

REVISIONS			CITY OF RIVERSIDE CALIFORNIA DEPARTMENT OF PUBLIC WORKS
MARK	DATE	DESCRIPTION	SIERRA STREET CORONADO WAY TO NICOLETT
1	10-25-61	ADDED CONST. NOTES STA. 19+15.40 - 19+98.17	

DESIGNED BY ee
DRAWN BY ee
CHECKED BY cm
RECOMMENDED BY A. R. Thiel ASSISTANT CITY ENGINEER
APPROVED BY [signature] DIRECTOR OF PUBLIC WORKS
DATE June 2, 1961
R-460A
SHEET 1 OF 1