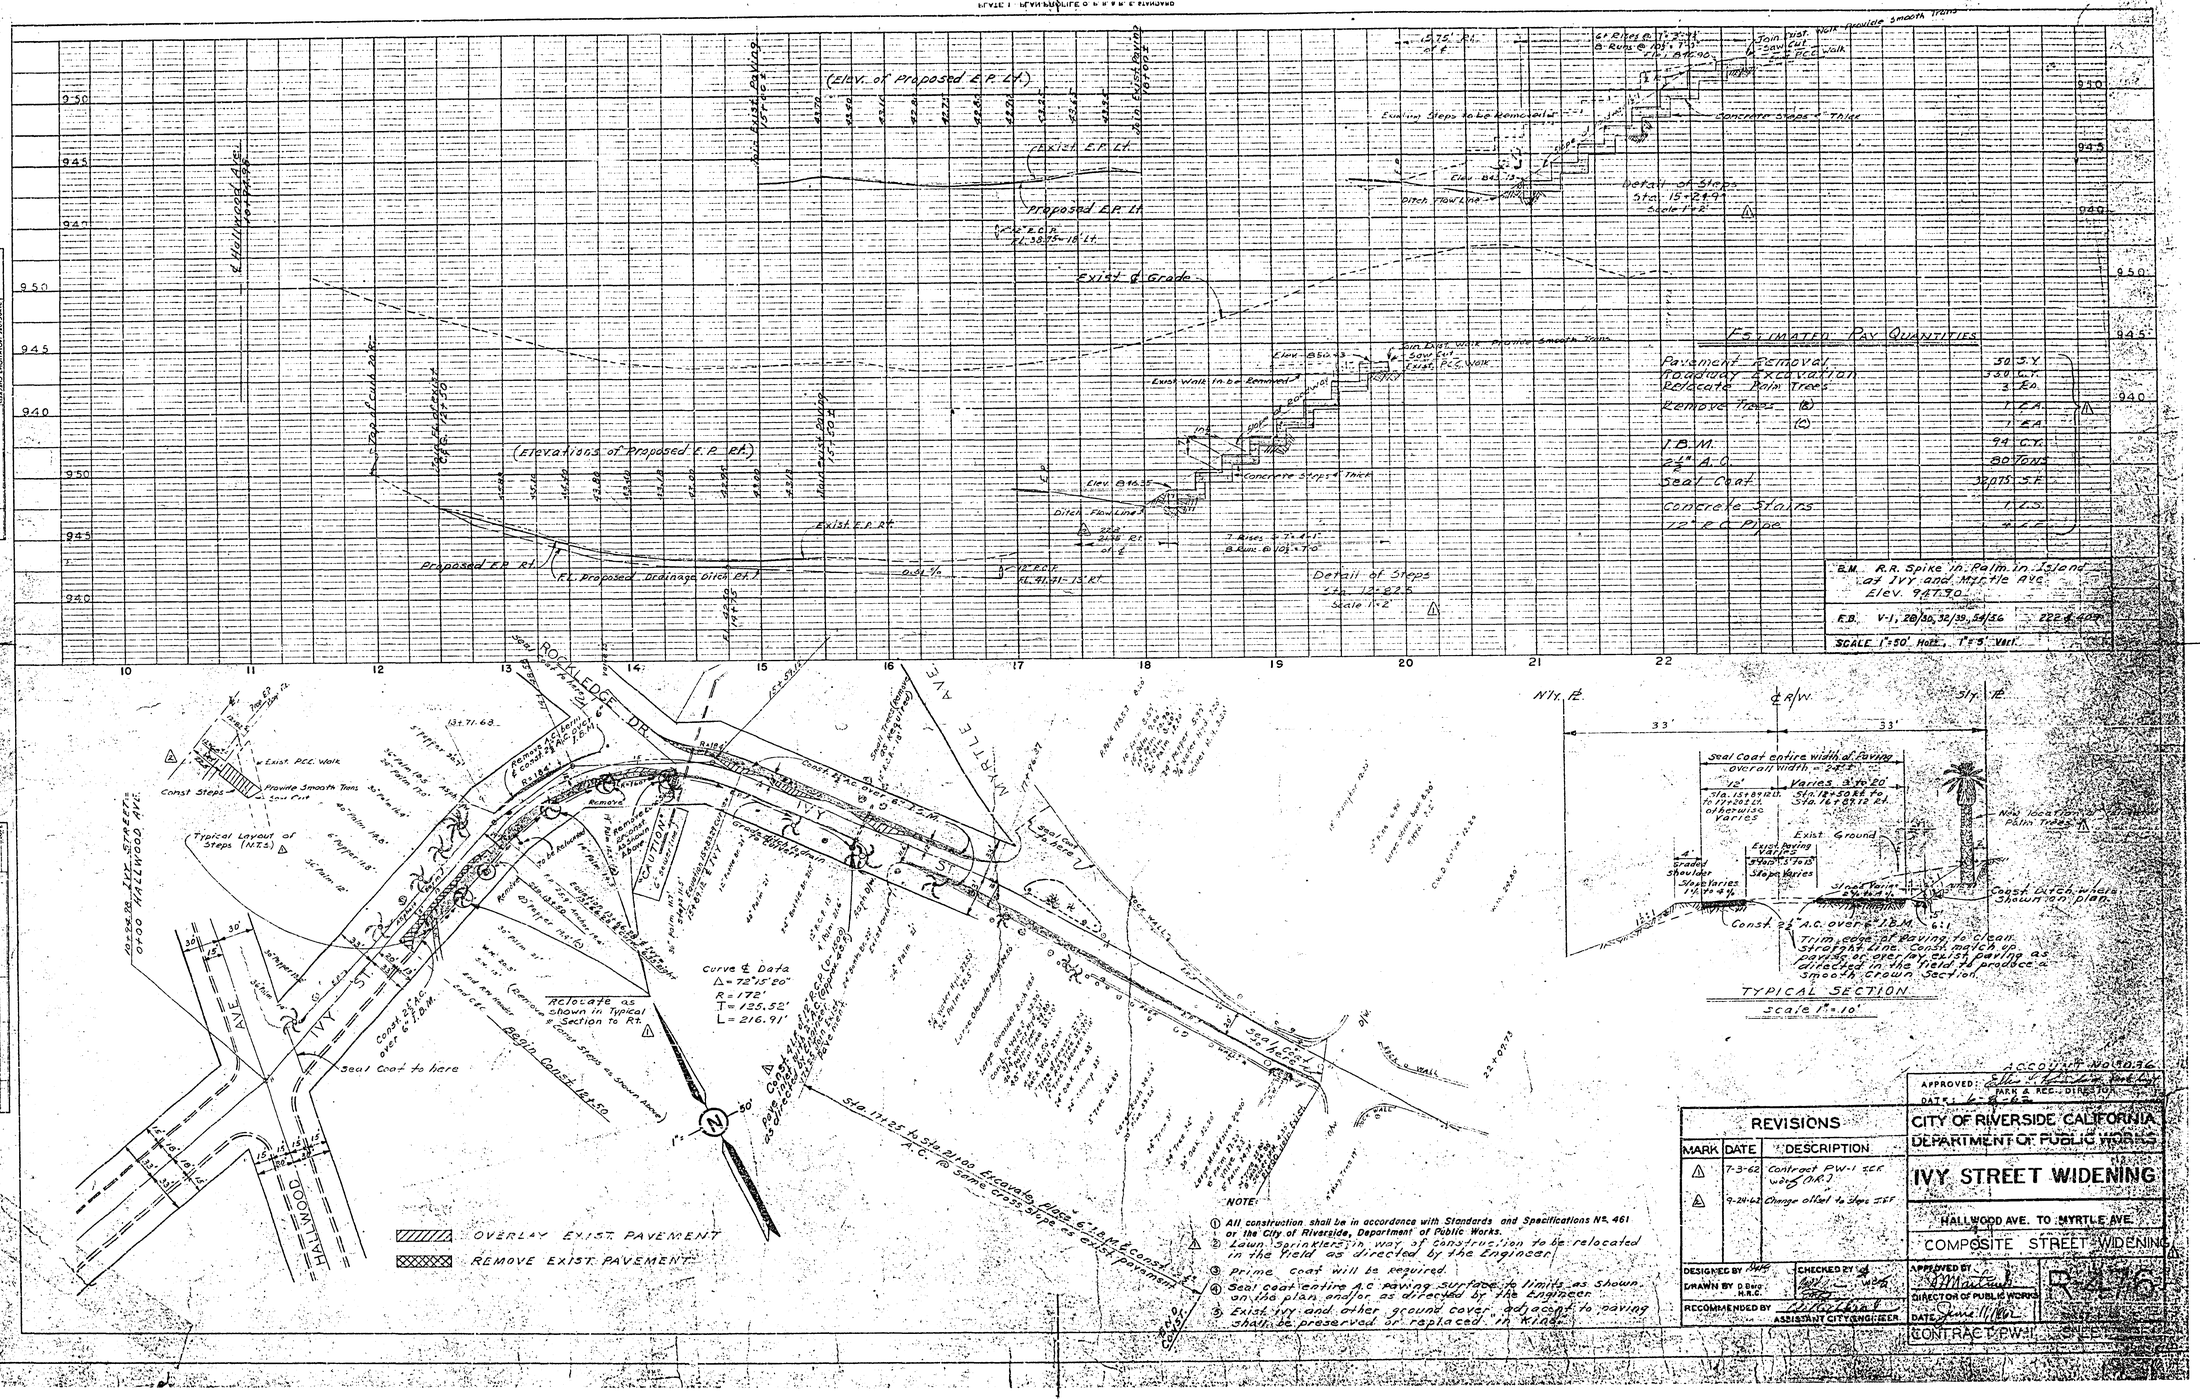

NOTE:

1. All construction shall be in accordance with Standards and Specifications No. 461 or the City of Riverside, Department of Public Works.
2. Lawn sprinklers in way of construction to be relocated in the field as directed by the Engineer.
3. Prime coat will be required.
4. Seal coat entire A.C. paving surface to limits as shown on the plan and/or as directed by the Engineer.
5. Exist. ivy and other ground cover adjacent to paving shall be preserved or replaced in kind.

REVISIONS		
MARK	DATE	DESCRIPTION
1	7-3-62	Contract PW-1 ser. way (D.R.)
2	9-24-62	Change align to Sta. 15+

DESIGNED BY
DRAWN BY D. Bro H.R.C.
CHECKED BY
RECOMMENDED BY ASSISTANT CITY ENGINEER

APPROVED: PARK & REC. DIRECTOR
DATE: 6-8-62

CITY OF RIVERSIDE, CALIFORNIA
DEPARTMENT OF PUBLIC WORKS

IVY STREET WIDENING

HALLWOOD AVE. TO MYRTLE AVE.

COMPOSITE STREET WIDENING

APPROVED BY
DIRECTOR OF PUBLIC WORKS
DATE June 11, 1962

CONTRACT PW-1