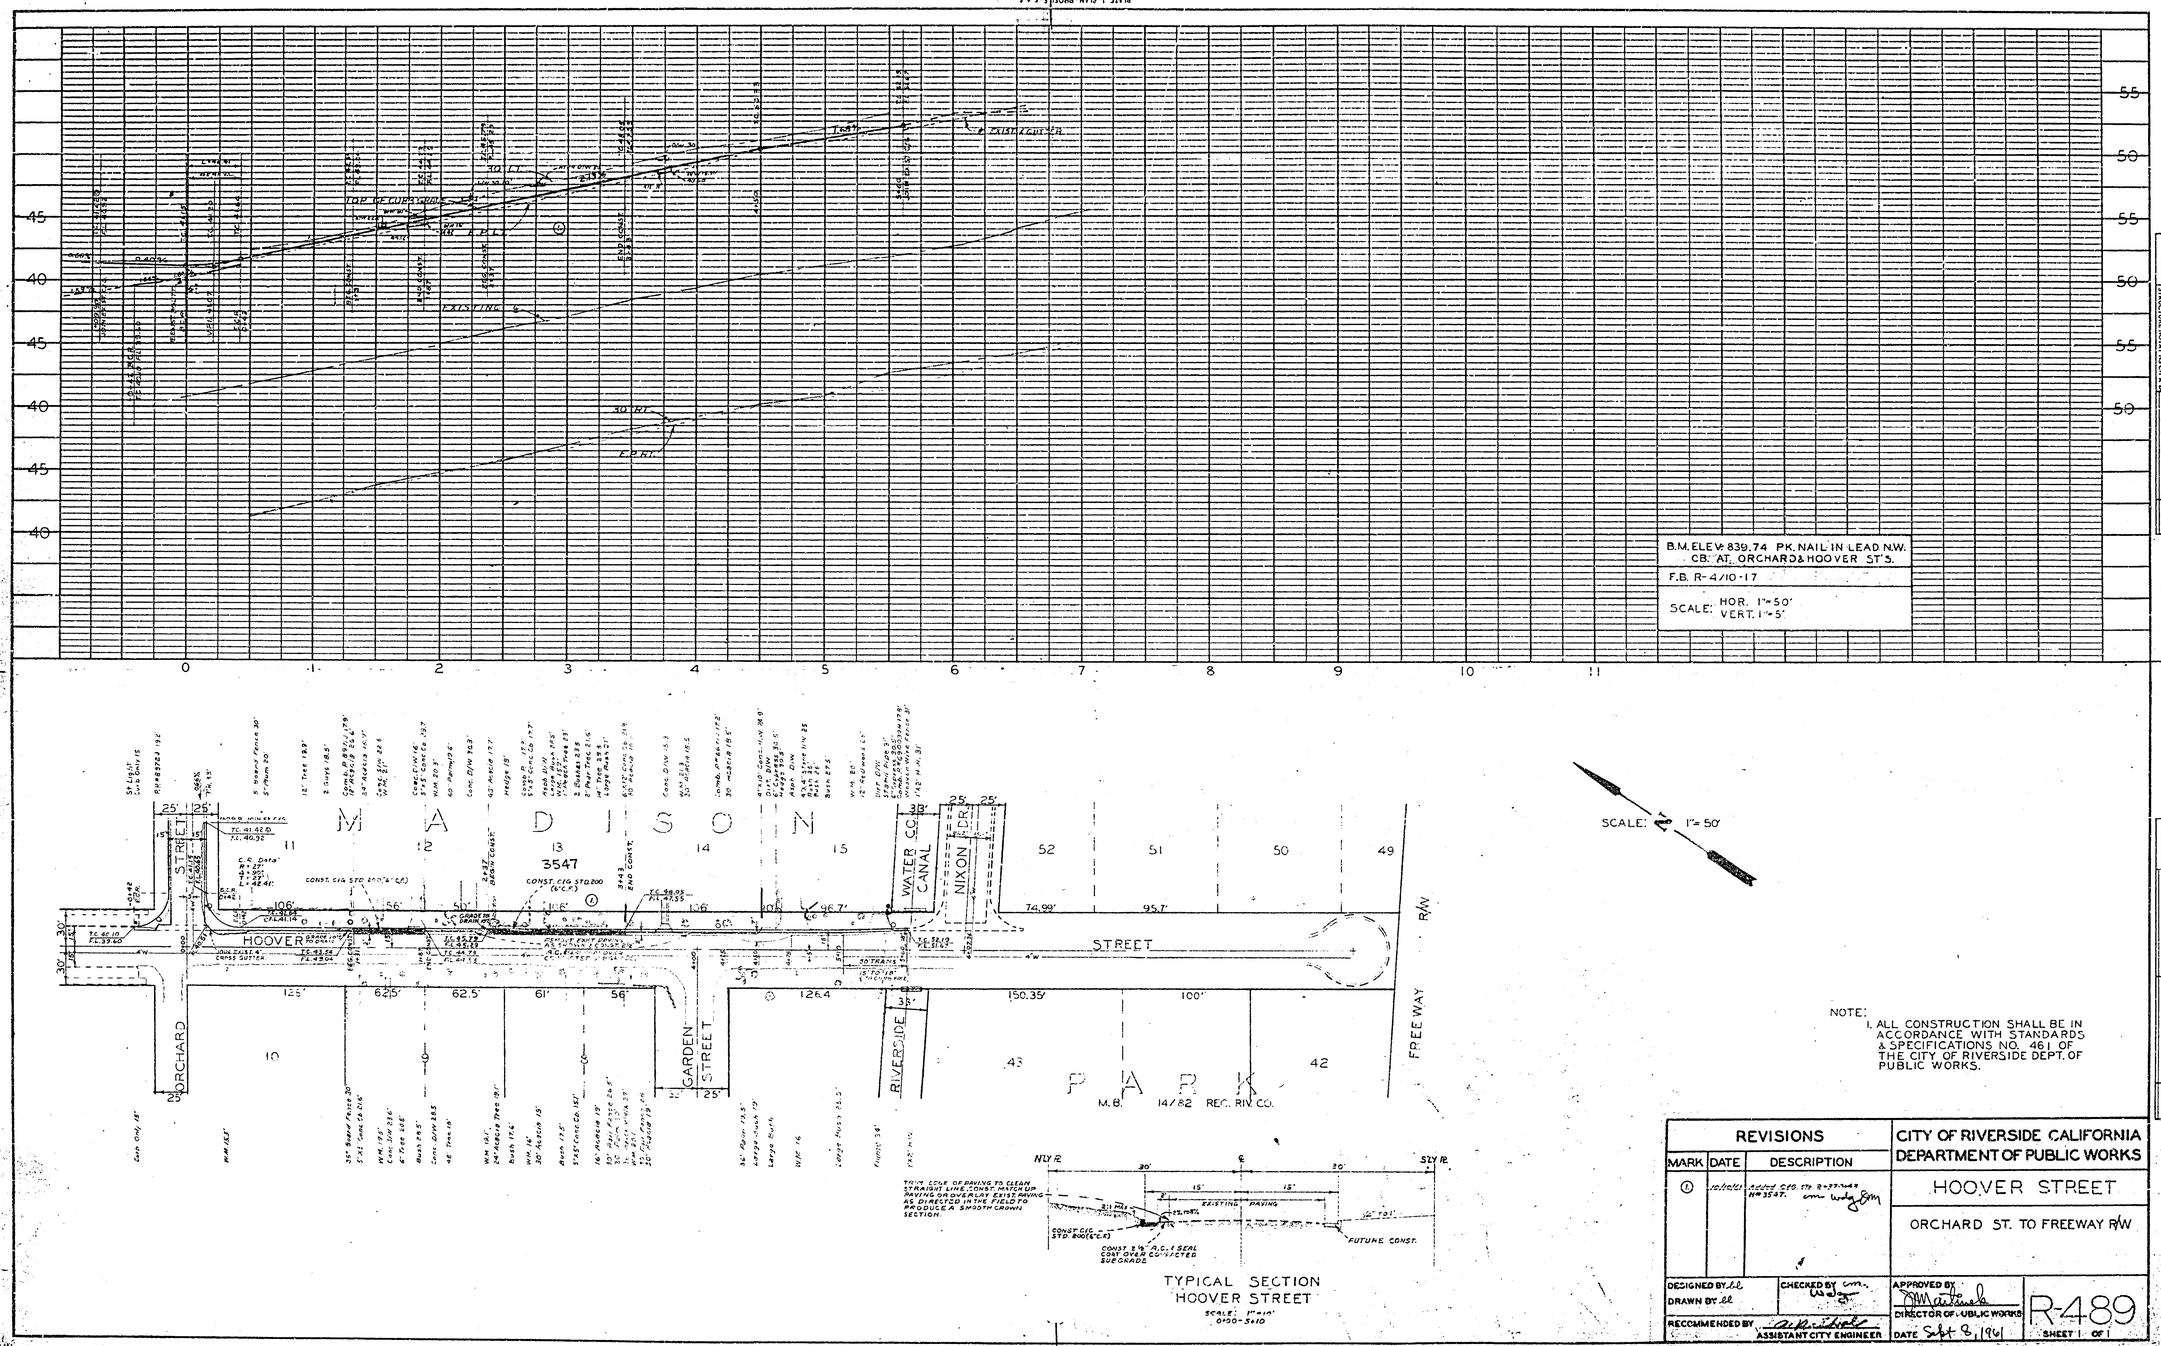

NOTE:
1. ALL CONSTRUCTION SHALL BE IN ACCORDANCE WITH STANDARDS & SPECIFICATIONS NO. 461 OF THE CITY OF RIVERSIDE DEPT. OF PUBLIC WORKS.

REVISIONS			CITY OF RIVERSIDE CALIFORNIA DEPARTMENT OF PUBLIC WORKS
MARK	DATE	DESCRIPTION	HOOVER STREET
1	10/10/61	Added C/G. Sta. R-37-N4 N#3547. cm wdg Gm	ORCHARD ST. TO FREEWAY R/W

DESIGNED BY ll
DRAWN BY ll
CHECKED BY cm. wdg
RECOMMENDED BY [signature] ASSISTANT CITY ENGINEER
APPROVED BY [signature] DIRECTOR OF PUBLIC WORKS
DATE Sept 8, 1961
R-489
SHEET 1 OF 1

PROFILE
NOTE BOOK NO.
SURVEYED
PLOTTED
GRADES CHECKED
B. M. & NOTED
STRUCTURE NOTATIONS CH'K'D
BY
DATE

PLAN
NOTE BOOK NO.
SURVEYED
PLOTTED
ALIGNMENT CHECKED
RT. OF WAY CHECKED
BY
DATE