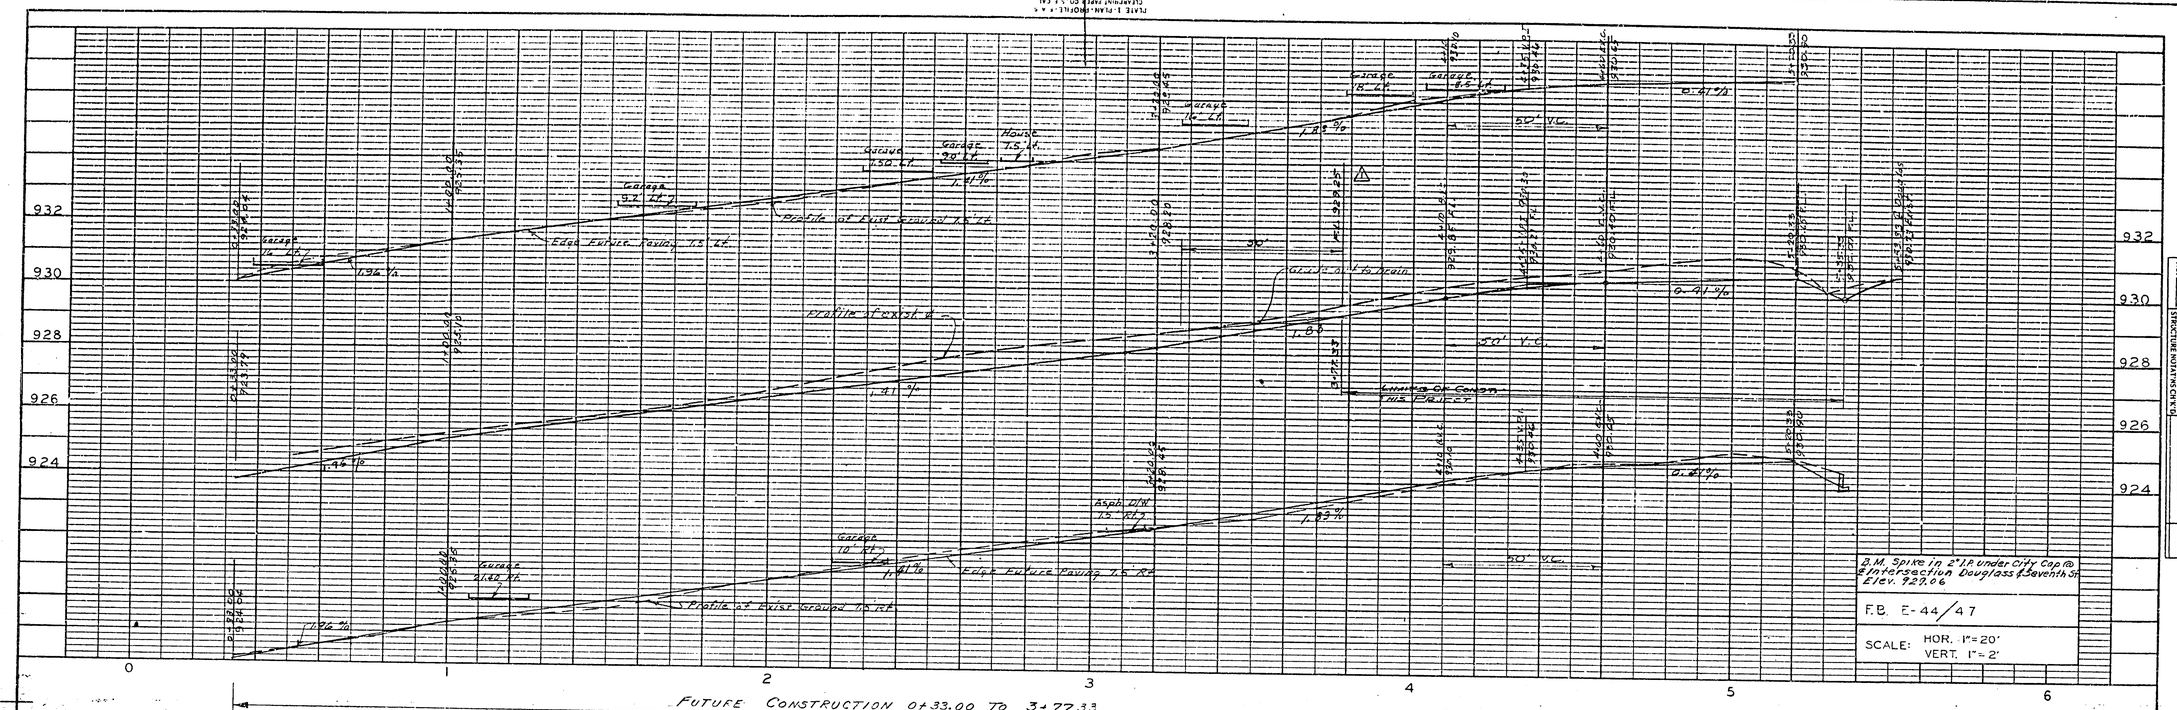

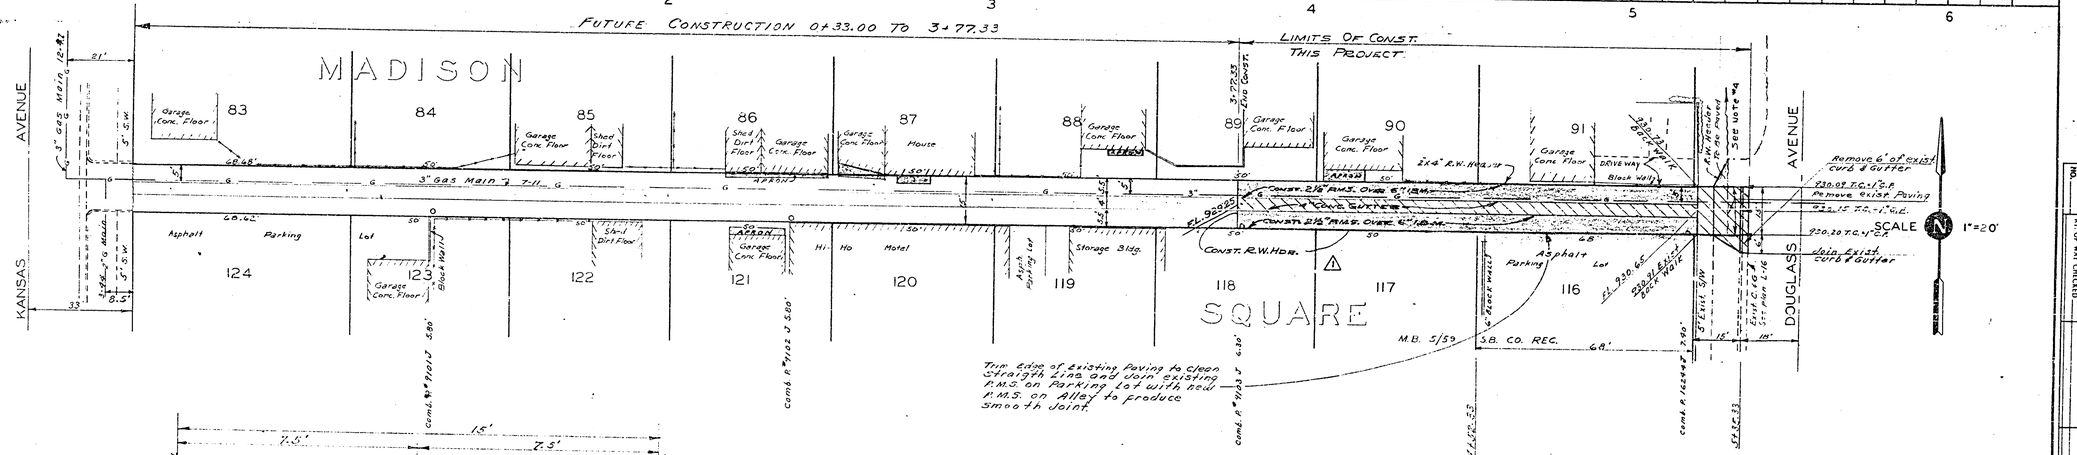

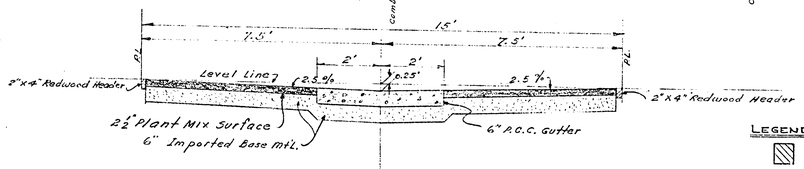

Typical Cross Section
Scale 1" = 2.0'

LEGEND

- Const. Conc. Valley Gutter
- Const. 2½" P.M.S. Over 6" I.B.M.

NOTES:

1. All construction shall be in accordance with Standards and Specifications No 461 of the City of Riverside Dept of Public Works.
2. Redwood Headers required at edge of P.M.S. wherever edge is not protected by other Structural materials, such as existing pavement, concrete, etc.
3. Prime Coat and Paint Binder will be required.
4. Grade to Drain to Exist. Curb Return at 7th Street.
5. Const. D/W Approach per Std. Dwg. #302 A=15', B=29'

REVISIONS		
MARK	DATE	DESCRIPTION
1	3-27-62	Extend Limits of Const. To Sta. 3+77.33 A.W. [illegible]

CITY OF RIVERSIDE CALIFORNIA
DEPARTMENT OF PUBLIC WORKS

ALLEY
KANSAS AVE. TO DOUGLASS AVE.
BETWEEN
SEVENTH ST. & EIGHTH ST.

DESIGNED BY D.R.B.
DRAWN BY W.J.G.-D.R.B.
CHECKED BY [illegible]
RECOMMENDED BY [illegible]
ASSISTANT CITY ENGINEER
APPROVED BY [illegible]
DIRECTOR OF PUBLIC WORKS
DATE NOV 5 1961

R-493

SHEET 1 OF 1

PROFILE
NOTE BOOK
NO.
SURVEYED
PLOTTED
GRADES CHECKED
B.M.'S NOTED
STRUCTURE NOTATIONS CH'K'D
BY
DATE

PLAN
NOTE BOOK
NO.
SURVEYED
PLOTTED
ALIGNMENT CHECKED
RT. OF WAY CHECKED
BY
DATE