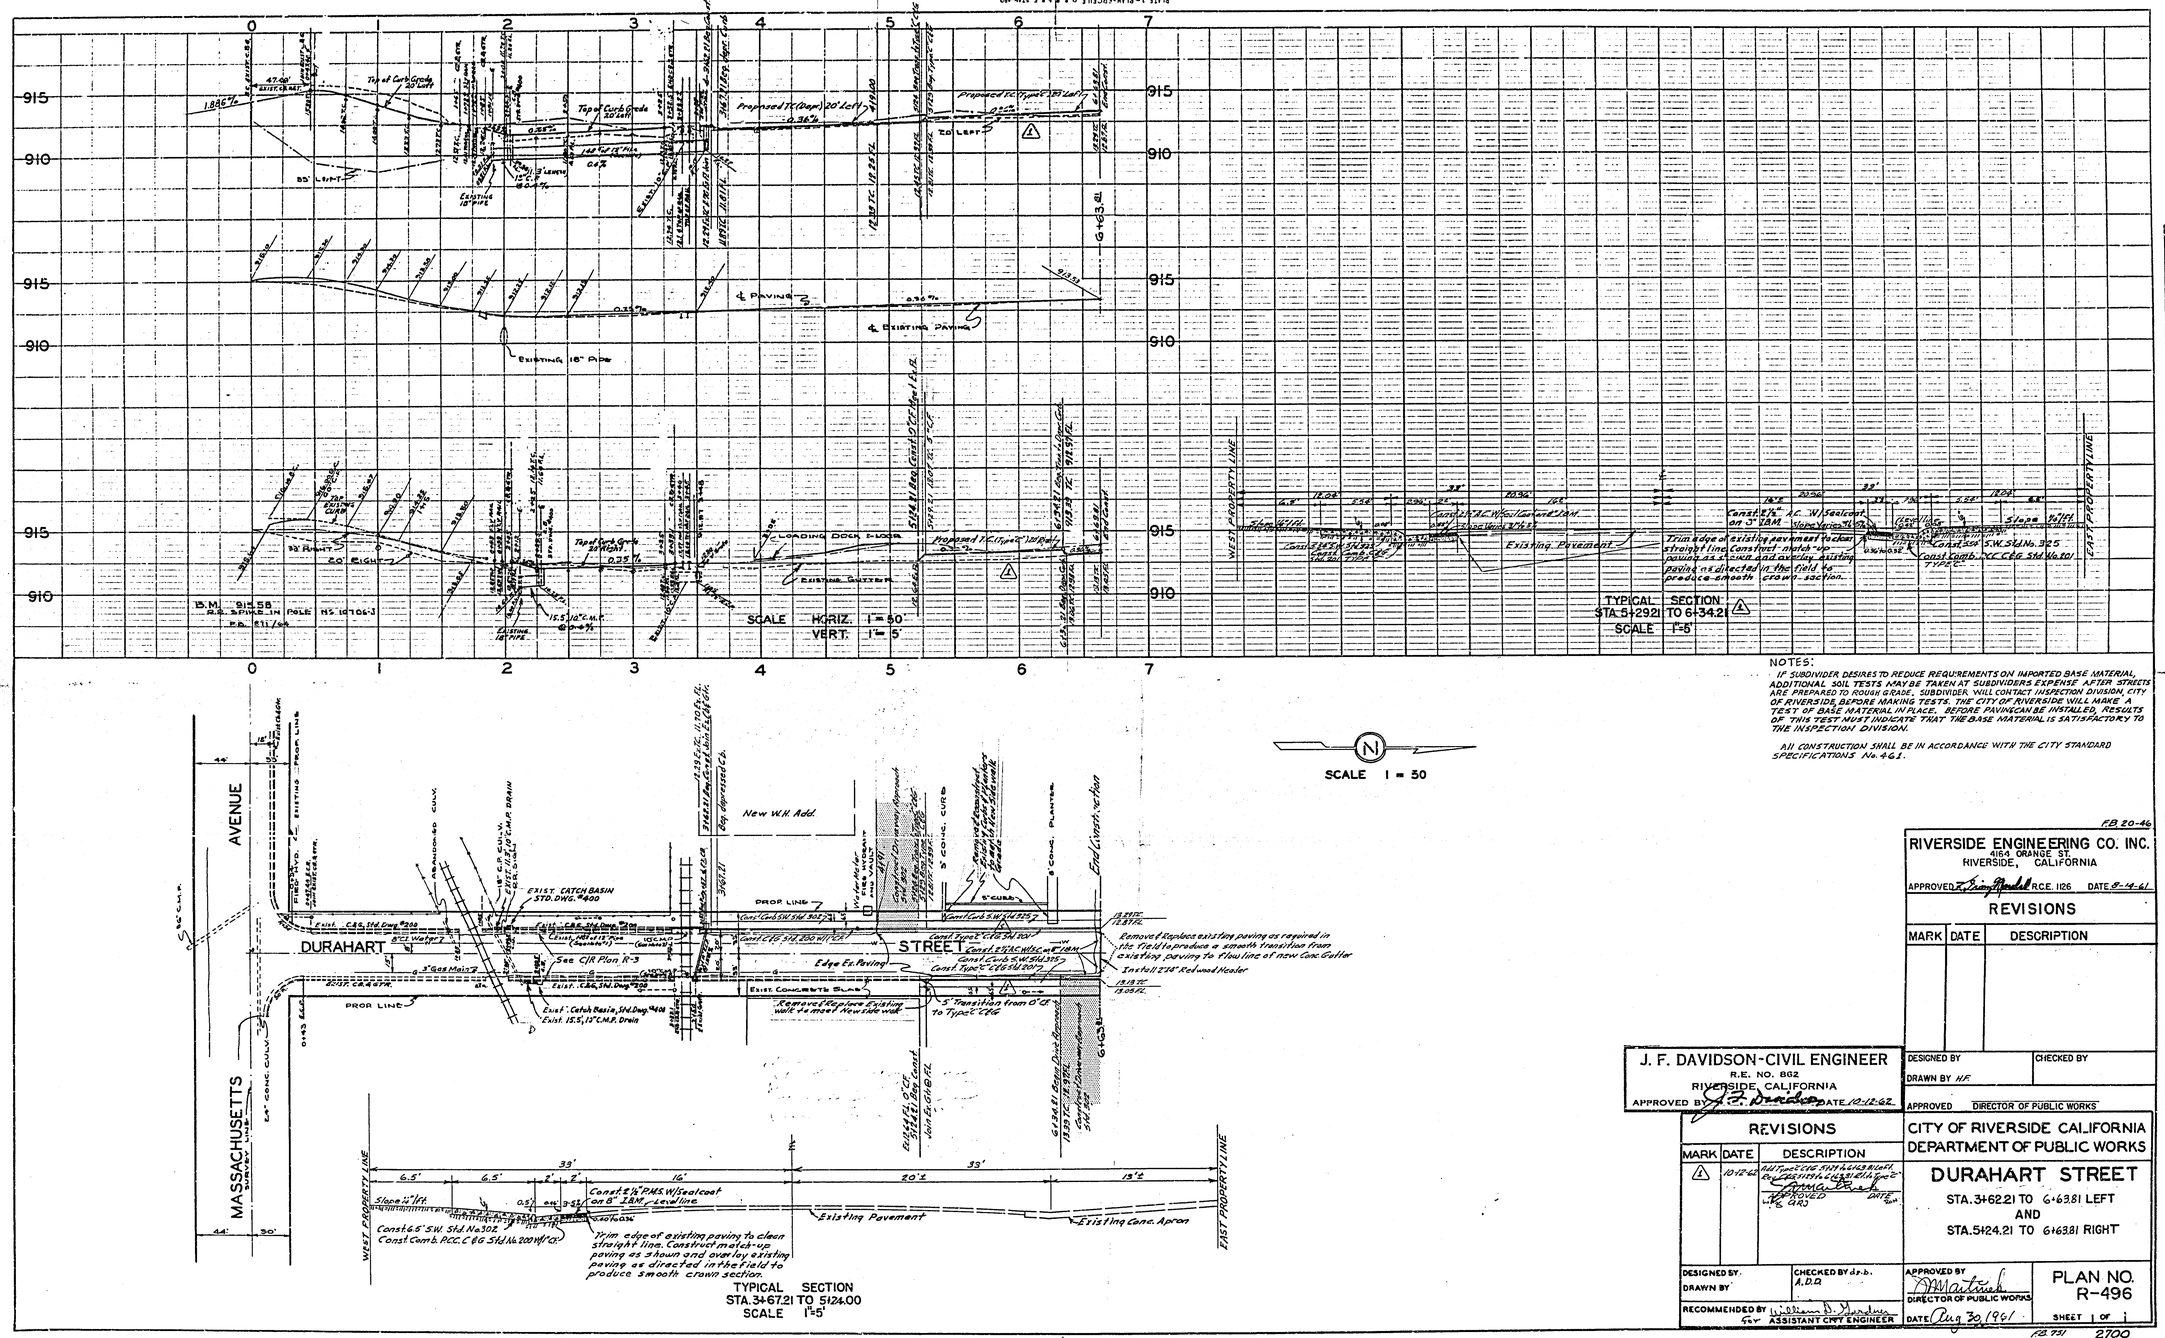

NOTES:

IF SUBDIVIDER DESIRES TO REDUCE REQUIREMENTS ON IMPORTED BASE MATERIAL, ADDITIONAL SOIL TESTS MAY BE TAKEN AT SUBDIVIDERS EXPENSE AFTER STREETS ARE PREPARED TO ROUGH GRADE. SUBDIVIDER WILL CONTACT INSPECTION DIVISION, CITY OF RIVERSIDE, BEFORE MAKING TESTS. THE CITY OF RIVERSIDE WILL MAKE A TEST OF BASE MATERIAL IN PLACE. BEFORE PAVING CAN BE INSTALLED, RESULTS OF THIS TEST MUST INDICATE THAT THE BASE MATERIAL IS SATISFACTORY TO THE INSPECTION DIVISION.

ALL CONSTRUCTION SHALL BE IN ACCORDANCE WITH THE CITY STANDARD SPECIFICATIONS No. 461.

F.B. 20-46

RIVERSIDE ENGINEERING CO. INC.
4164 ORANGE ST.
RIVERSIDE, CALIFORNIA
APPROVED [signature] R.C.E. 1126 DATE 8-14-61

REVISIONS

MARK	DATE	DESCRIPTION

DESIGNED BY
DRAWN BY H.F.
CHECKED BY
APPROVED DIRECTOR OF PUBLIC WORKS

J. F. DAVIDSON-CIVIL ENGINEER
R.E. NO. 862
RIVERSIDE, CALIFORNIA
APPROVED BY [signature] DATE 10-12-62

REVISIONS

MARK	DATE	DESCRIPTION
1	10-12-62	Add Type "C" C&G 5+24 to 6+63.81 Left, Rev. C&G 5+29 to 6+63.81 Rt. to Type "C" [signature] APPROVED DATE

CITY OF RIVERSIDE CALIFORNIA
DEPARTMENT OF PUBLIC WORKS

DURAHART STREET
STA. 3+62.21 TO 6+63.81 LEFT
AND
STA. 5+24.21 TO 6+63.81 RIGHT

DESIGNED BY
DRAWN BY
CHECKED BY d.r.b. A.D.D.
RECOMMENDED BY [signature] for ASSISTANT CITY ENGINEER
APPROVED BY [signature] DIRECTOR OF PUBLIC WORKS
DATE Aug 30, 1961

PLAN NO. R-496
SHEET 1 OF 1

F.B. 751 2700