FED. ROAD DIST. No.	STATE	PROJ. NO.	FISCAL YEAR	SHEET No.	TOTAL SHEETS
2	CAL.				

PENNSYLVANIA AVE.

ROAD No 3062-2 WORK ORDER No 509
SURVEY No 1989 FIELD BOOK No 642
A.C. Keith, County Surveyor
Riverside County
1950

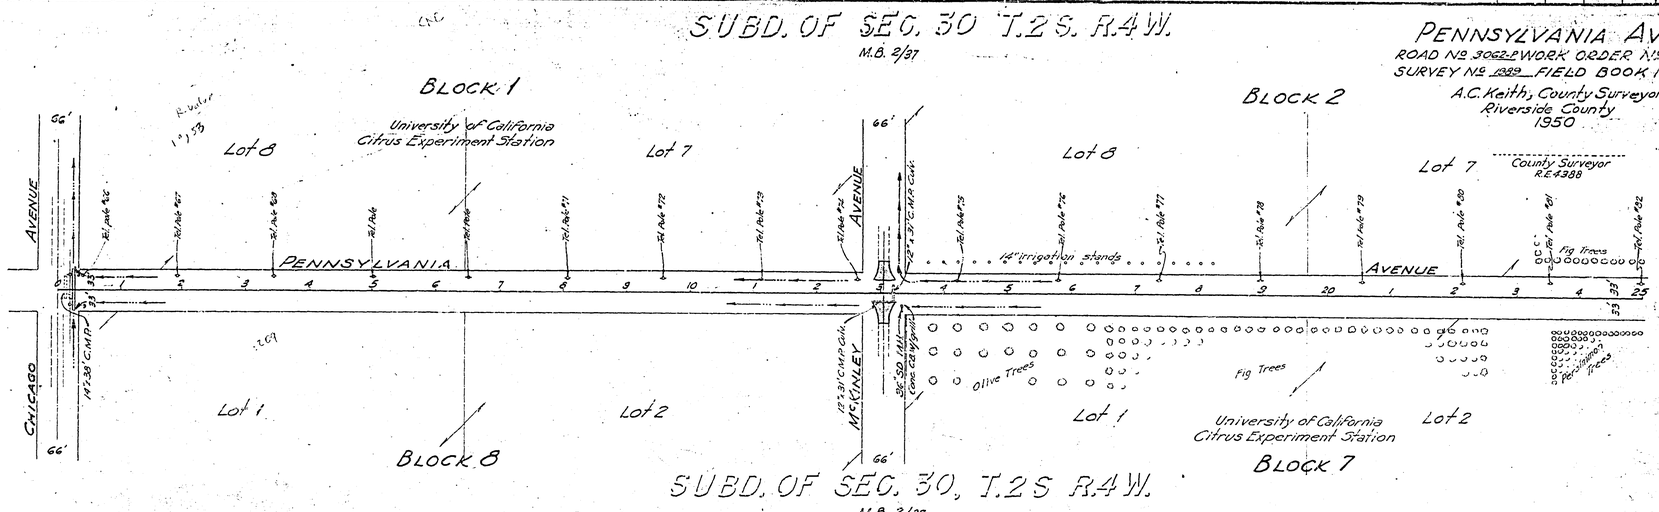

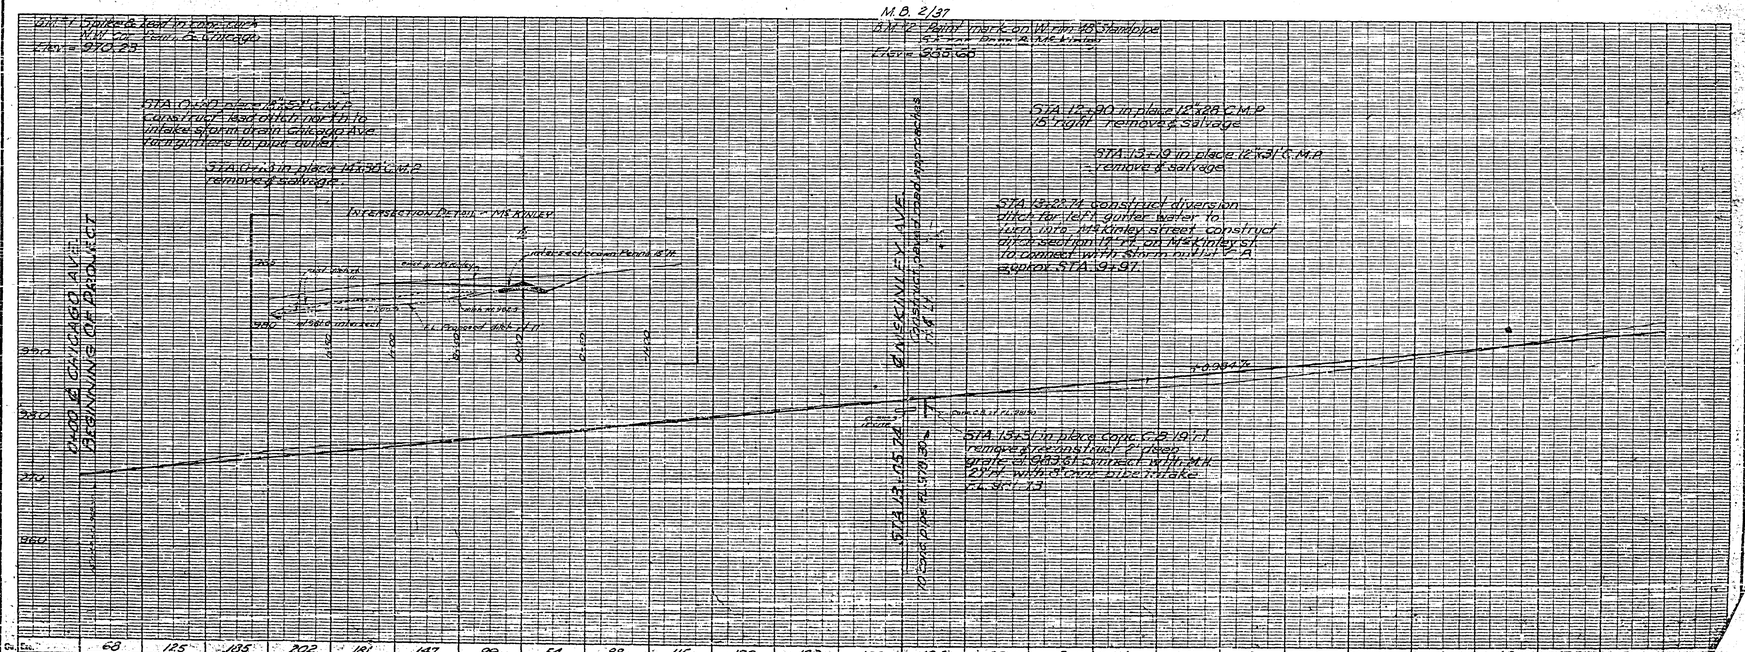

R-501

FED. ROAD DIST. No.	STATE	FED. AID PROJ. No.	FISCAL YEAR	SHEET No.	TOTAL SHEETS
2	CAL.				

SUBD. OF SEC. 30, T.2 S. R.4 W.

M.B. 2/37

PENNSYLVANIA AVE.
ROAD No. 3262 WORK ORDER No. 529
SURVEY No. 1289 FIELD BOOK No. 642

A.C. Keith, County Surveyor
Riverside County
1950

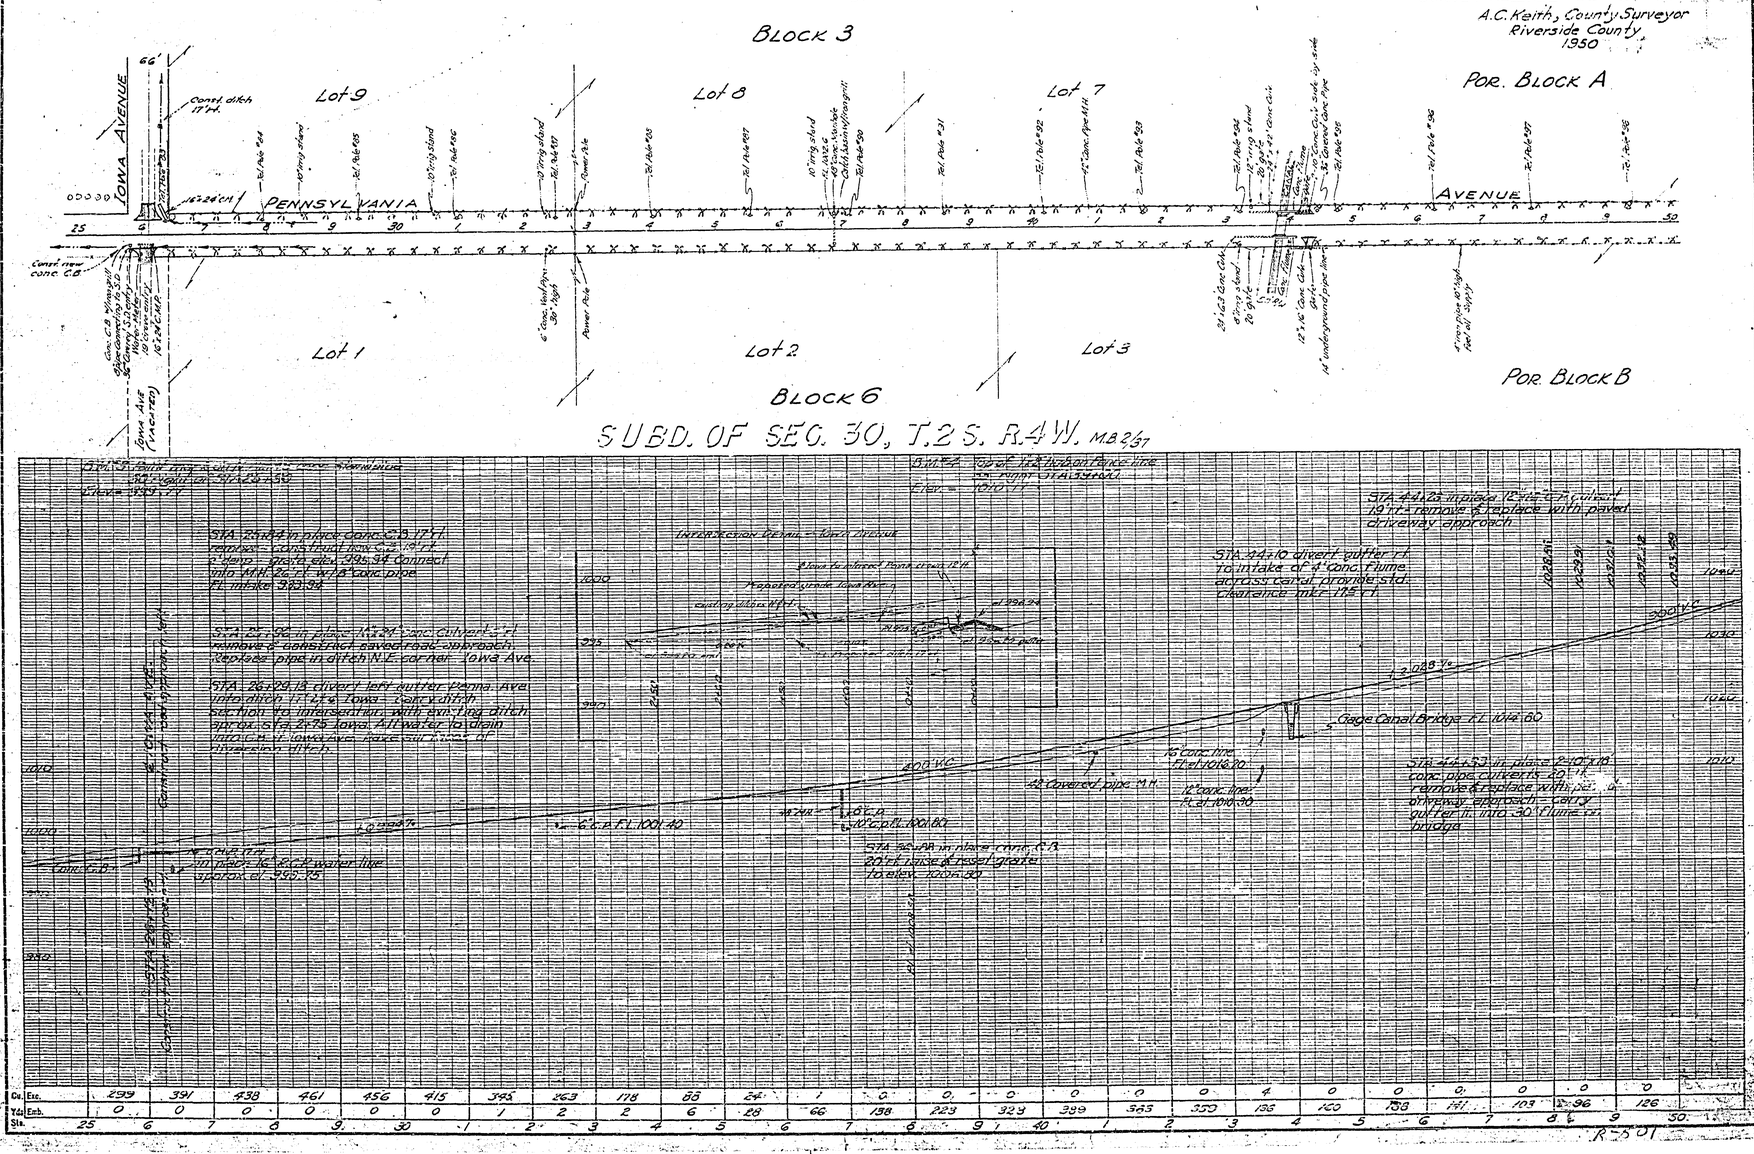

R-501

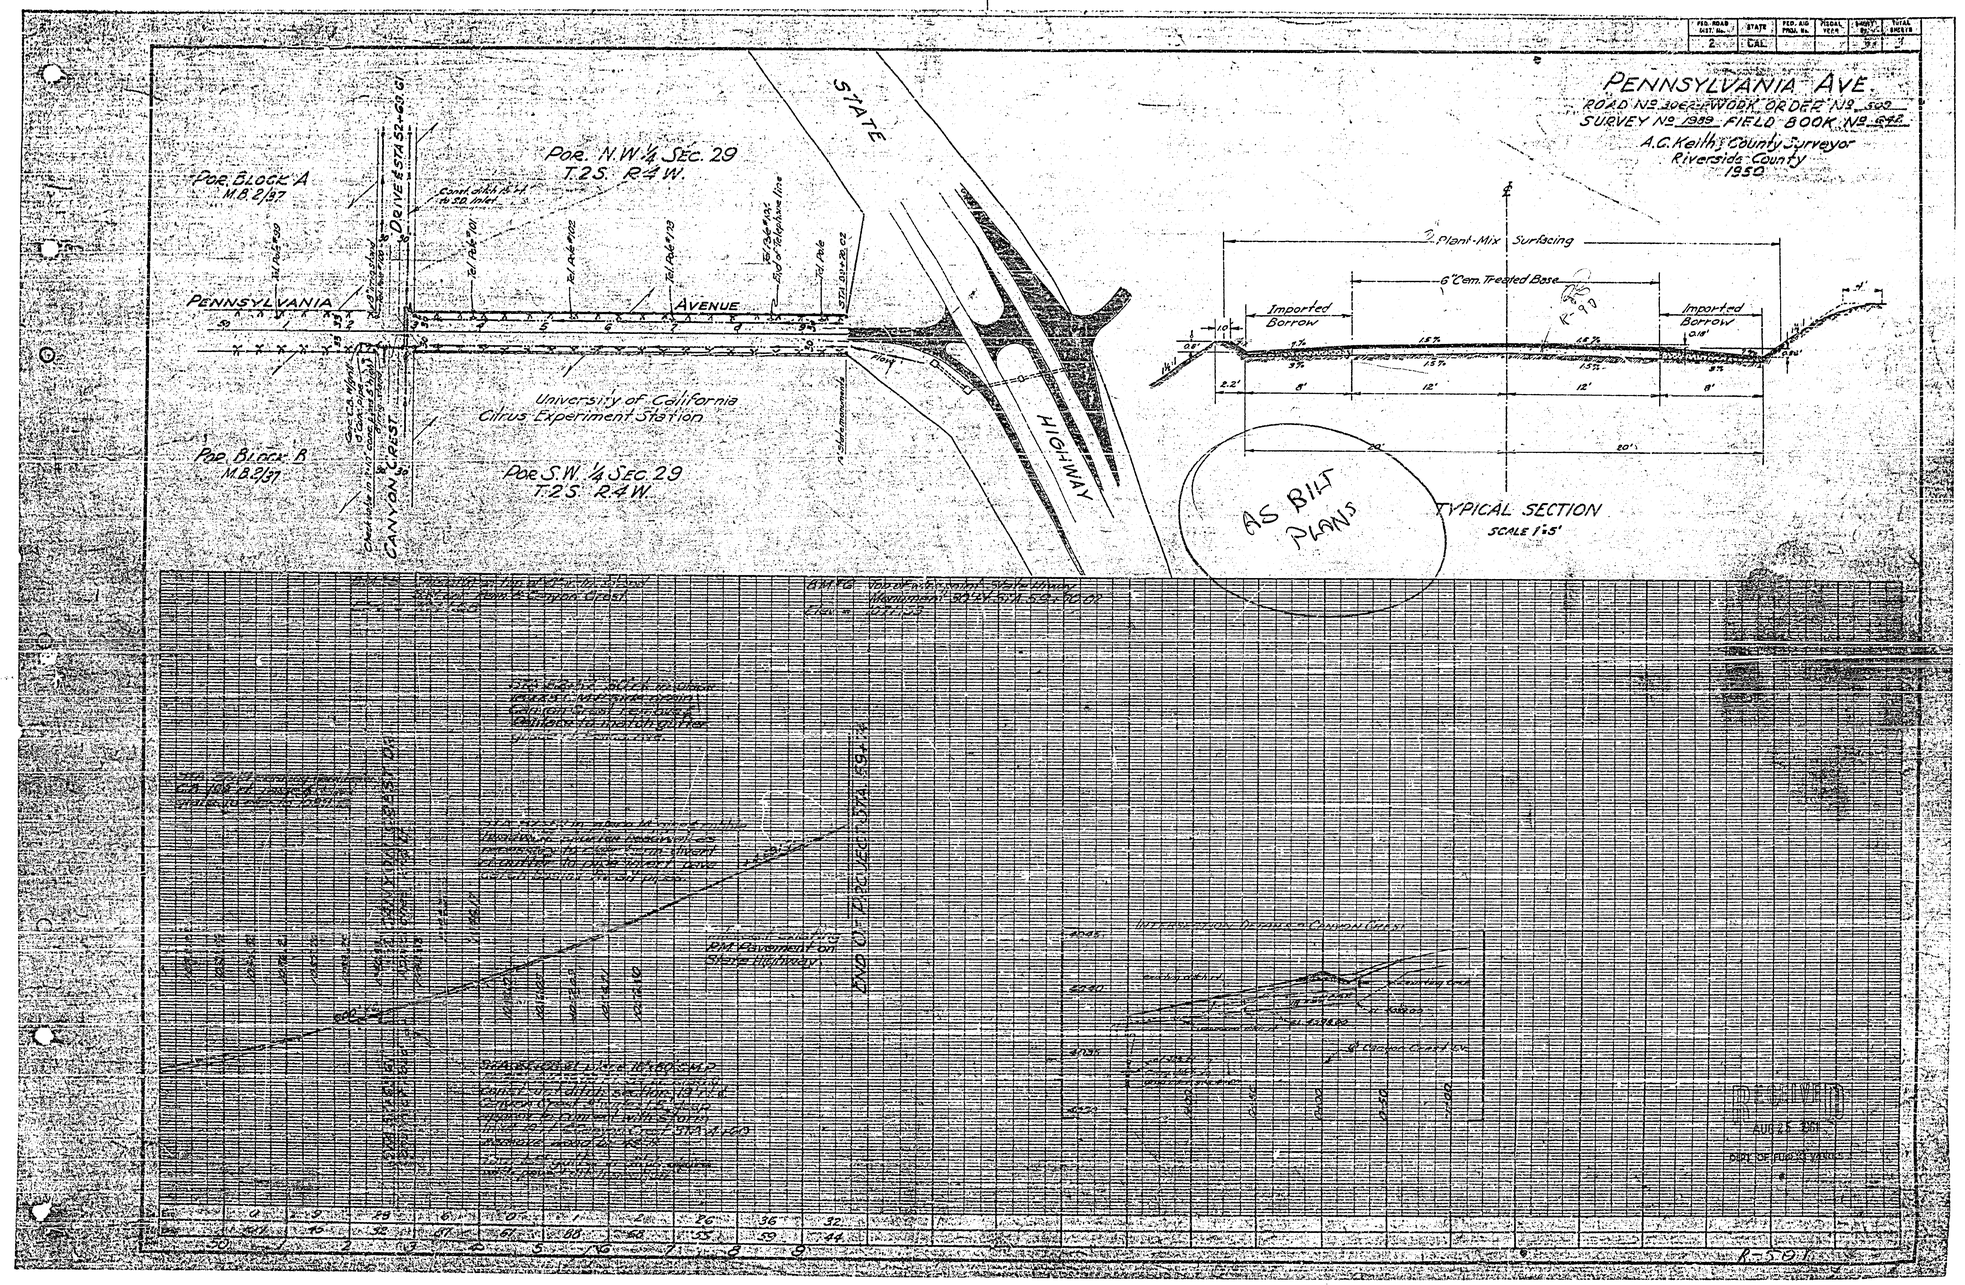
PENNSYLVANIA AVE.
ROAD No. 30E2-F WORK ORDER No. 500
SURVEY No. 1989 FIELD BOOK No. 642
A.C. Keith, County Surveyor
Riverside County
1950
STATE
HIGHWAY
POR. N.W. 1/4 SEC. 29
T.2S. R.4W.
POR. BLOCK A
M.B. 2/37
PENNSYLVANIA
AVENUE
DRIVE
University of California
Citrus Experiment Station
POR. BLOCK B
M.B. 2/37
POR. S.W. 1/4 SEC. 29
T.2S. R.4W.
CANYON CREST
Plant-Mix Surfacing
6" Cem. Treated Base
Imported Borrow
Imported Borrow
TYPICAL SECTION
SCALE 1"=5'
AS BILT PLANS
END OF PROJECT STA. 59+74
RM Pavement on State Highway
INTERSECTION DETAILS - CANYON CREST
RECEIVED
AUG 25 1961
DIST. OF FUND & VARIES
R-501