WATKINS DRIVE

BETWEEN

~~BROKAW DR.~~ / GERNER RD.
PICACHO

ROAD NO.
SURVEY NO. S-2806

WORK ORDER NO.
FIELD BOOK NO. 790, 812

C. KEITH, COUNTY SURVEYOR AND ROAD COMMISSIONER
RIVERSIDE COUNTY

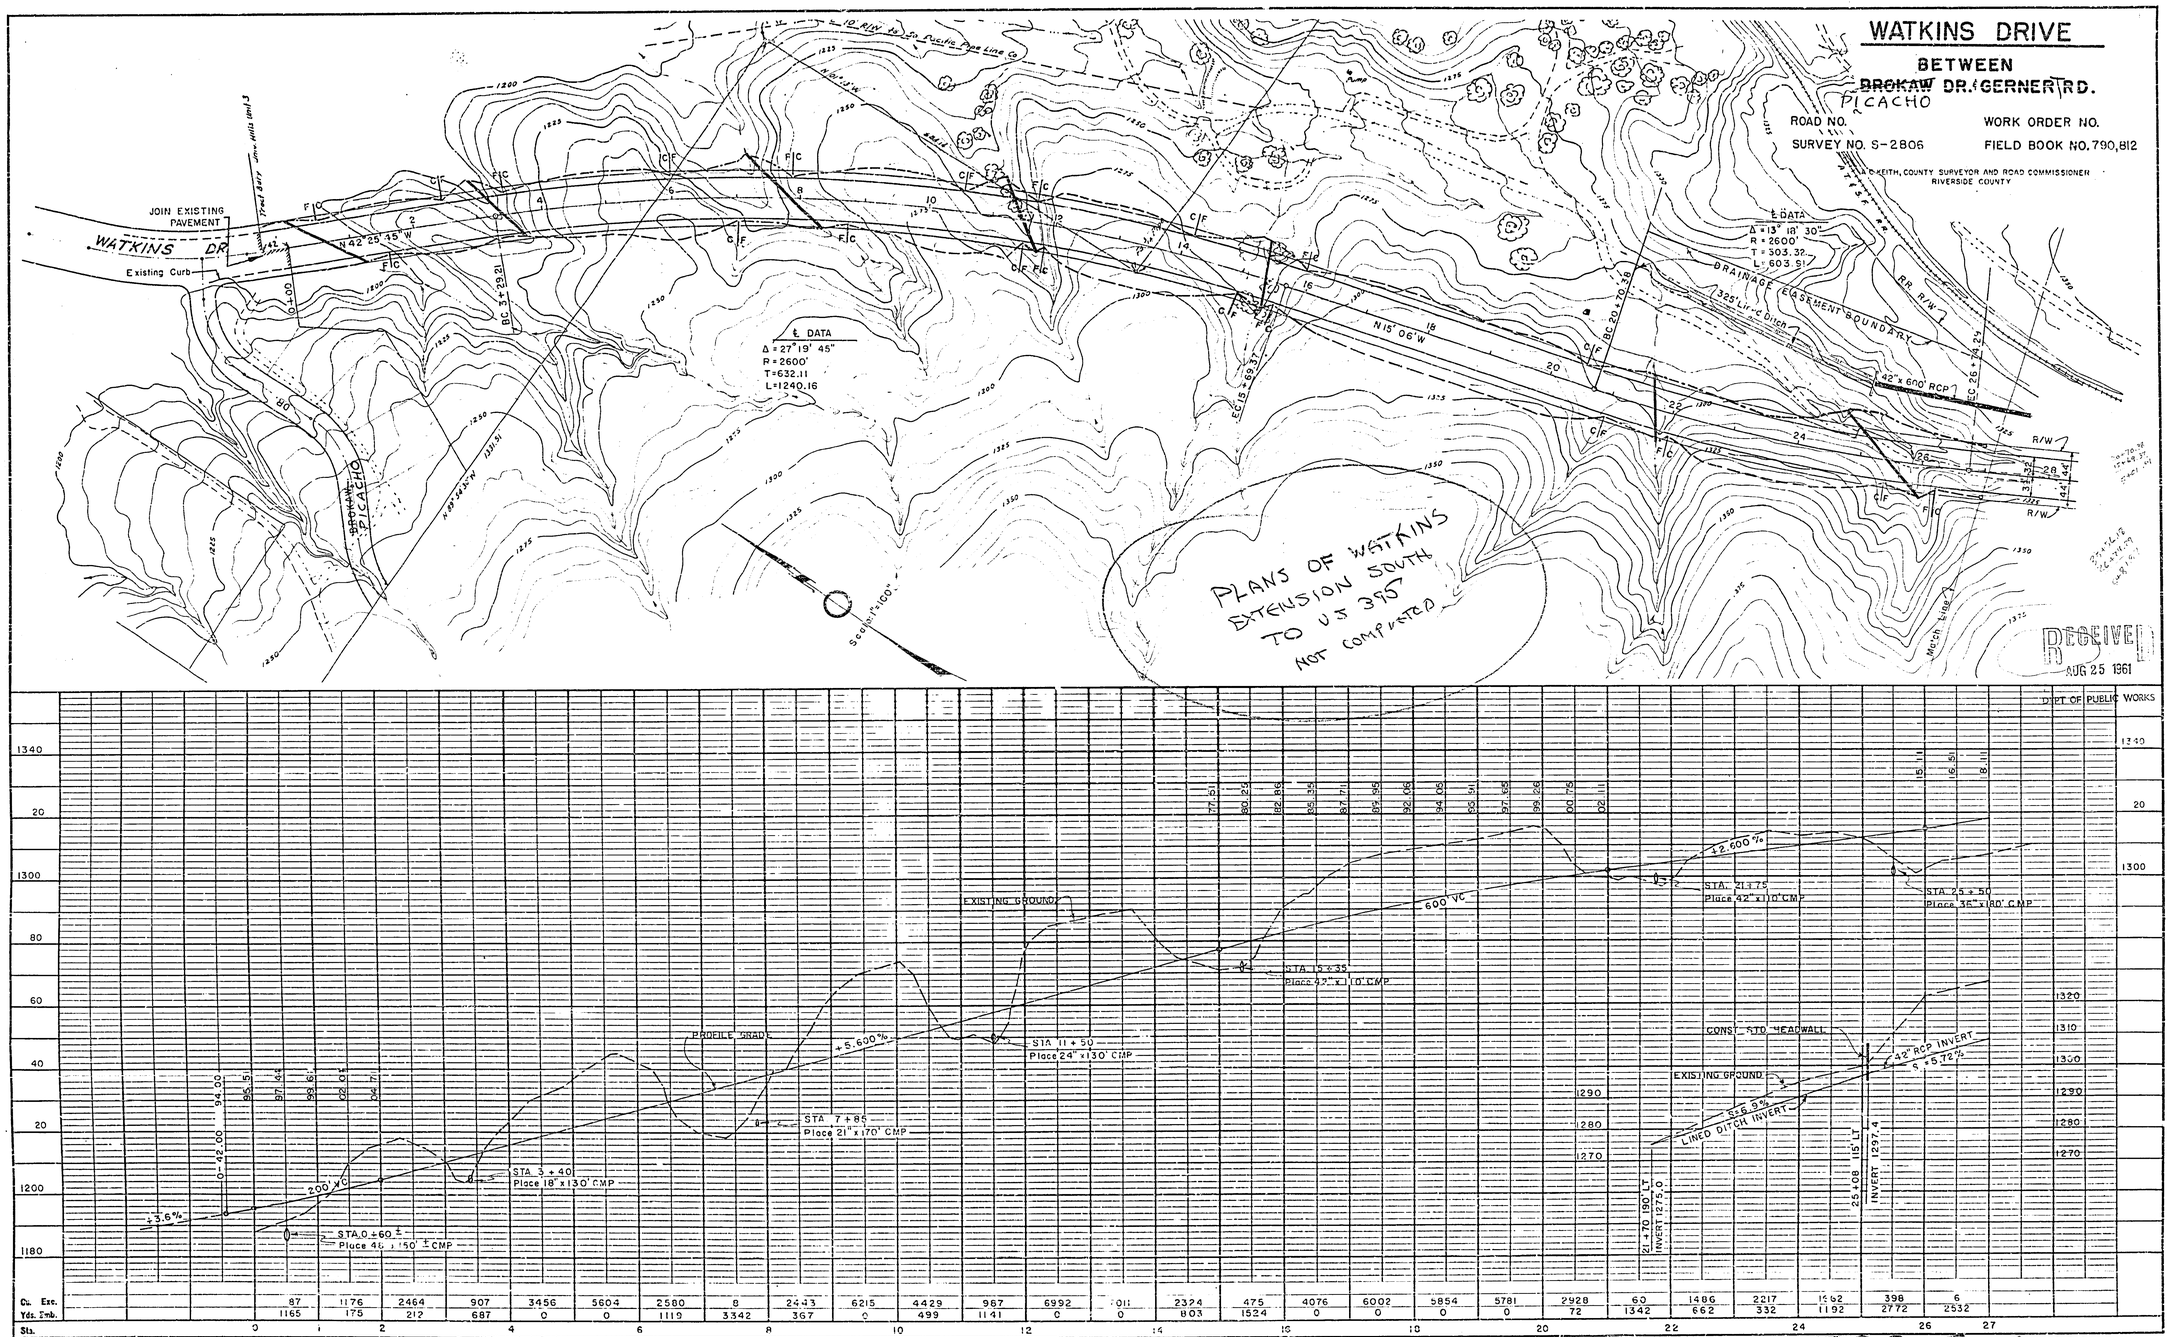

738-E R-502

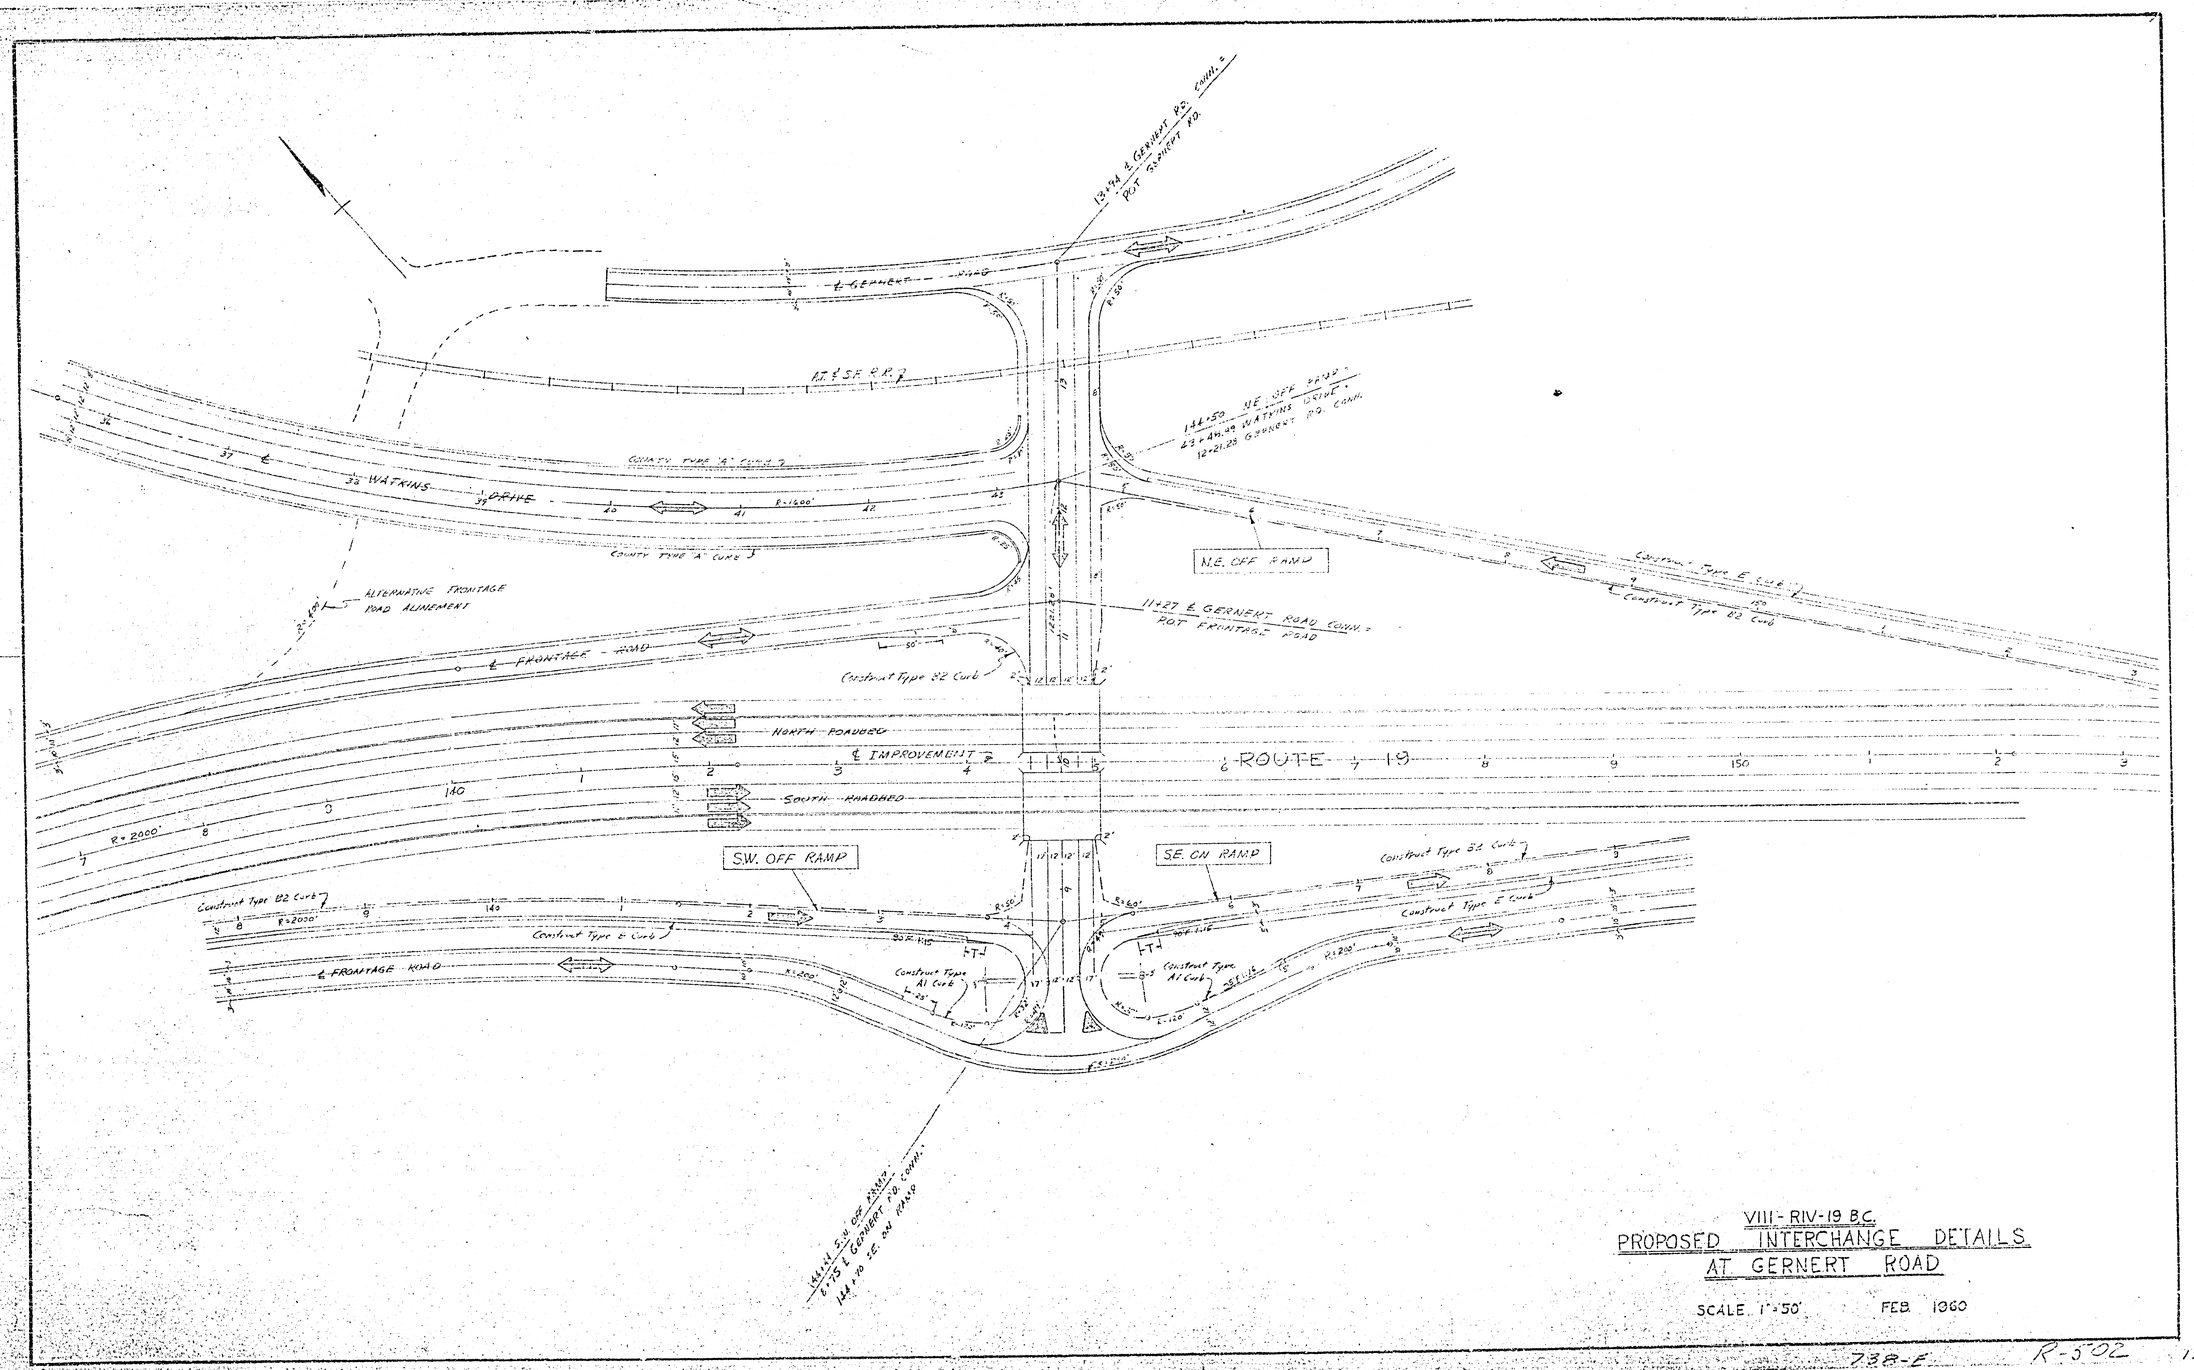

VIII-RIV-19 B.C.

PROPOSED INTERCHANGE DETAILS

AT GERNERT ROAD

SCALE 1"=50' FEB. 1960

73B-E R-502

WATKINS DRIVE

BETWEEN PICACHO ~~BROKAW~~ DR. & GERNERT RD.

ROAD NO. WORK ORDER NO.

SURVEY NO. S-2806 FIELD BOOK NO. 790, 812

A.C. KEITH, COUNTY SURVEYOR AND ROAD COMMISSIONER
RIVERSIDE COUNTY

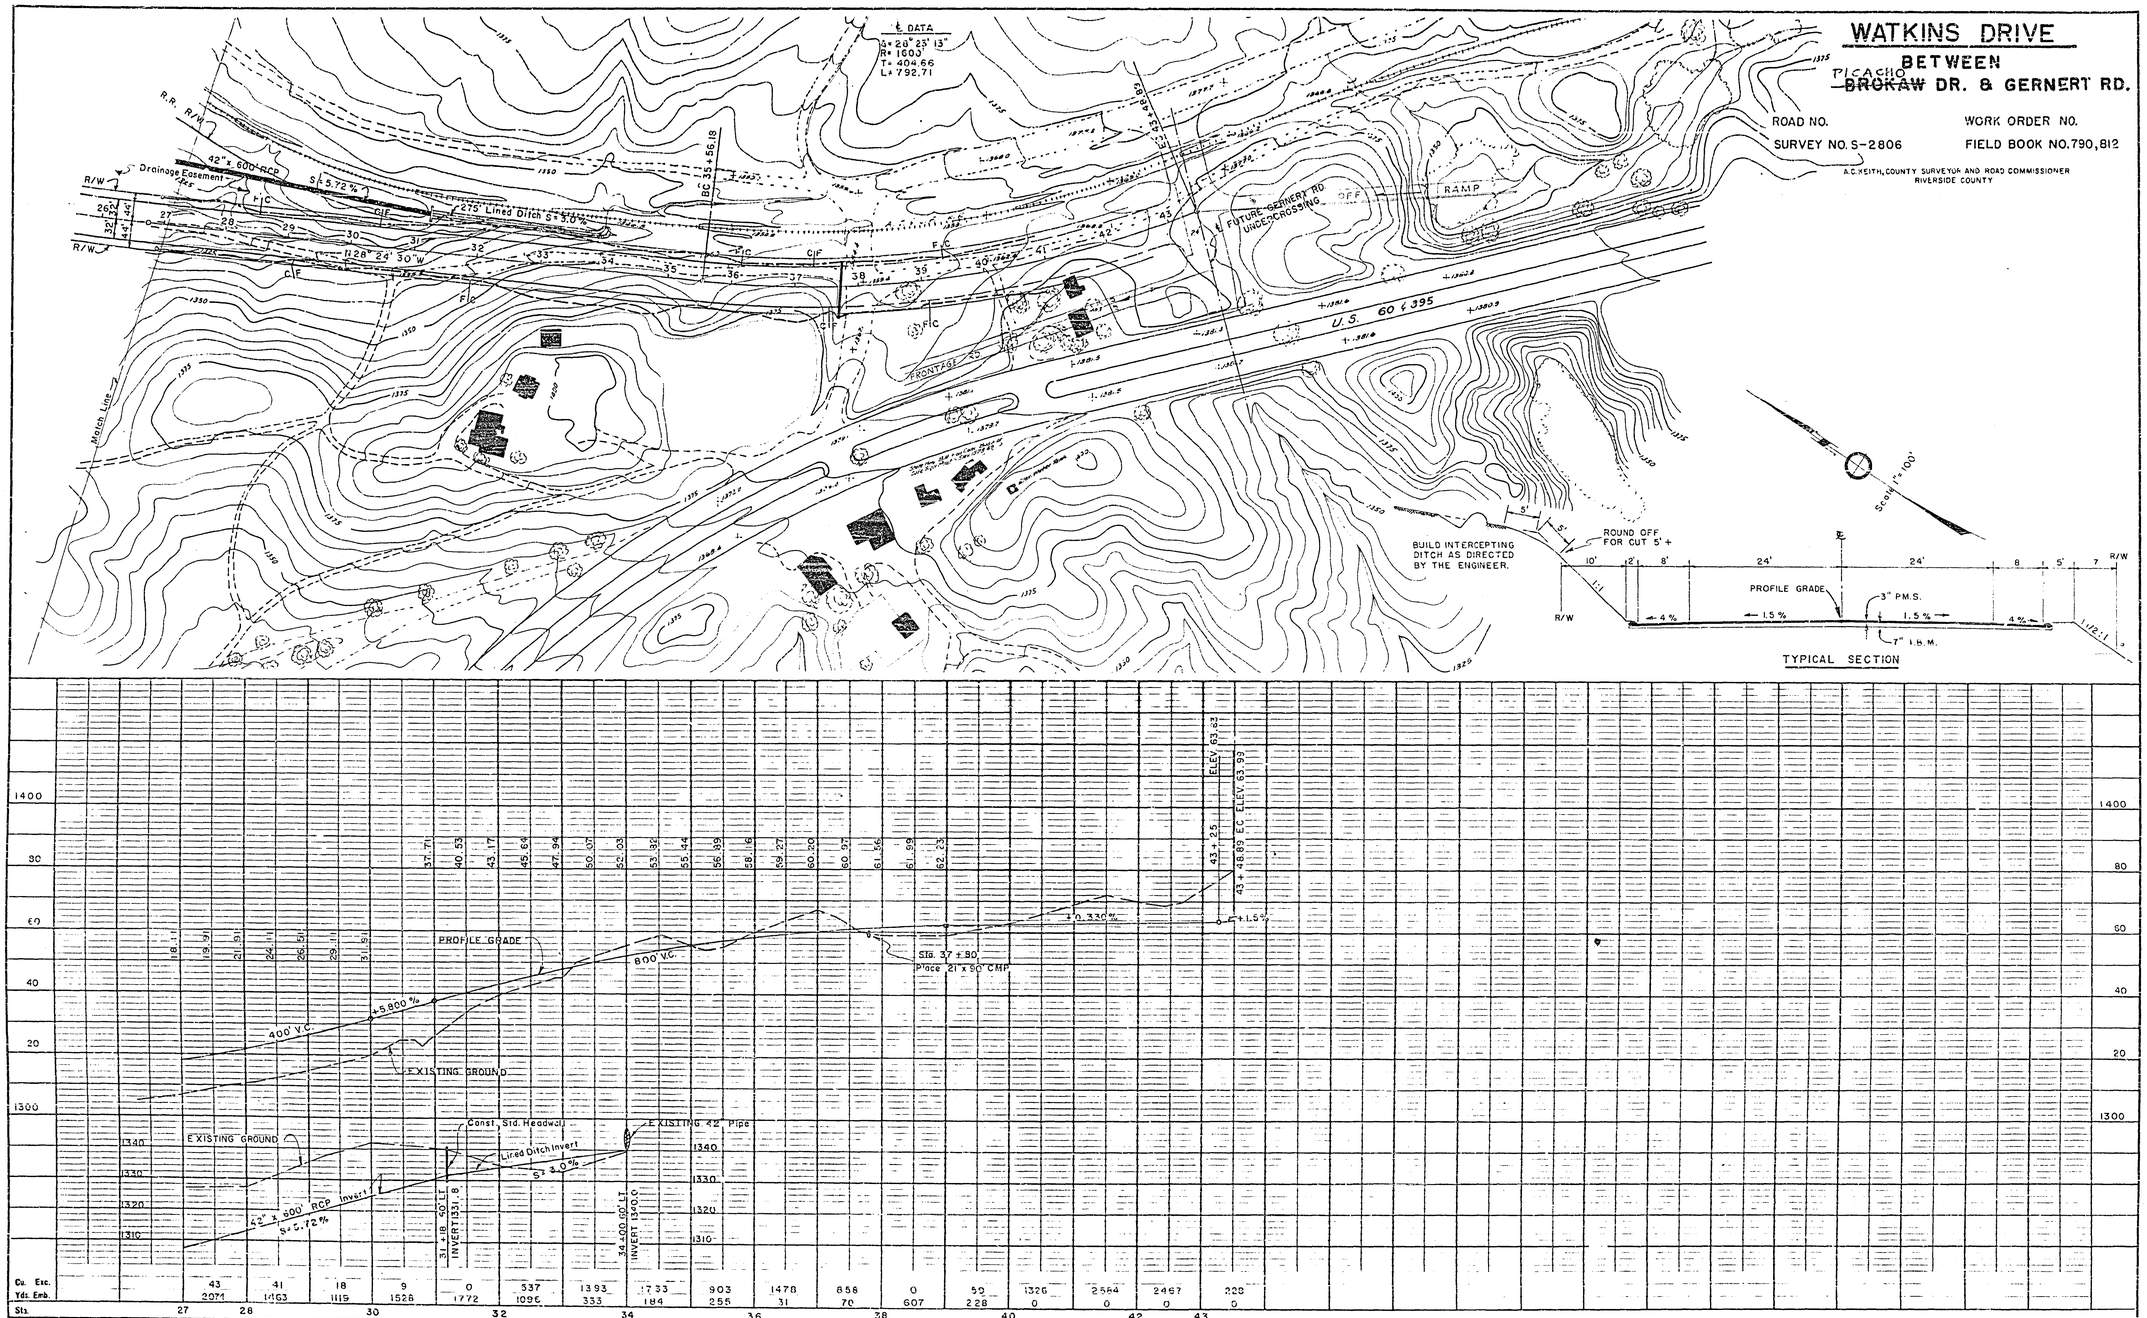

738-E R-502