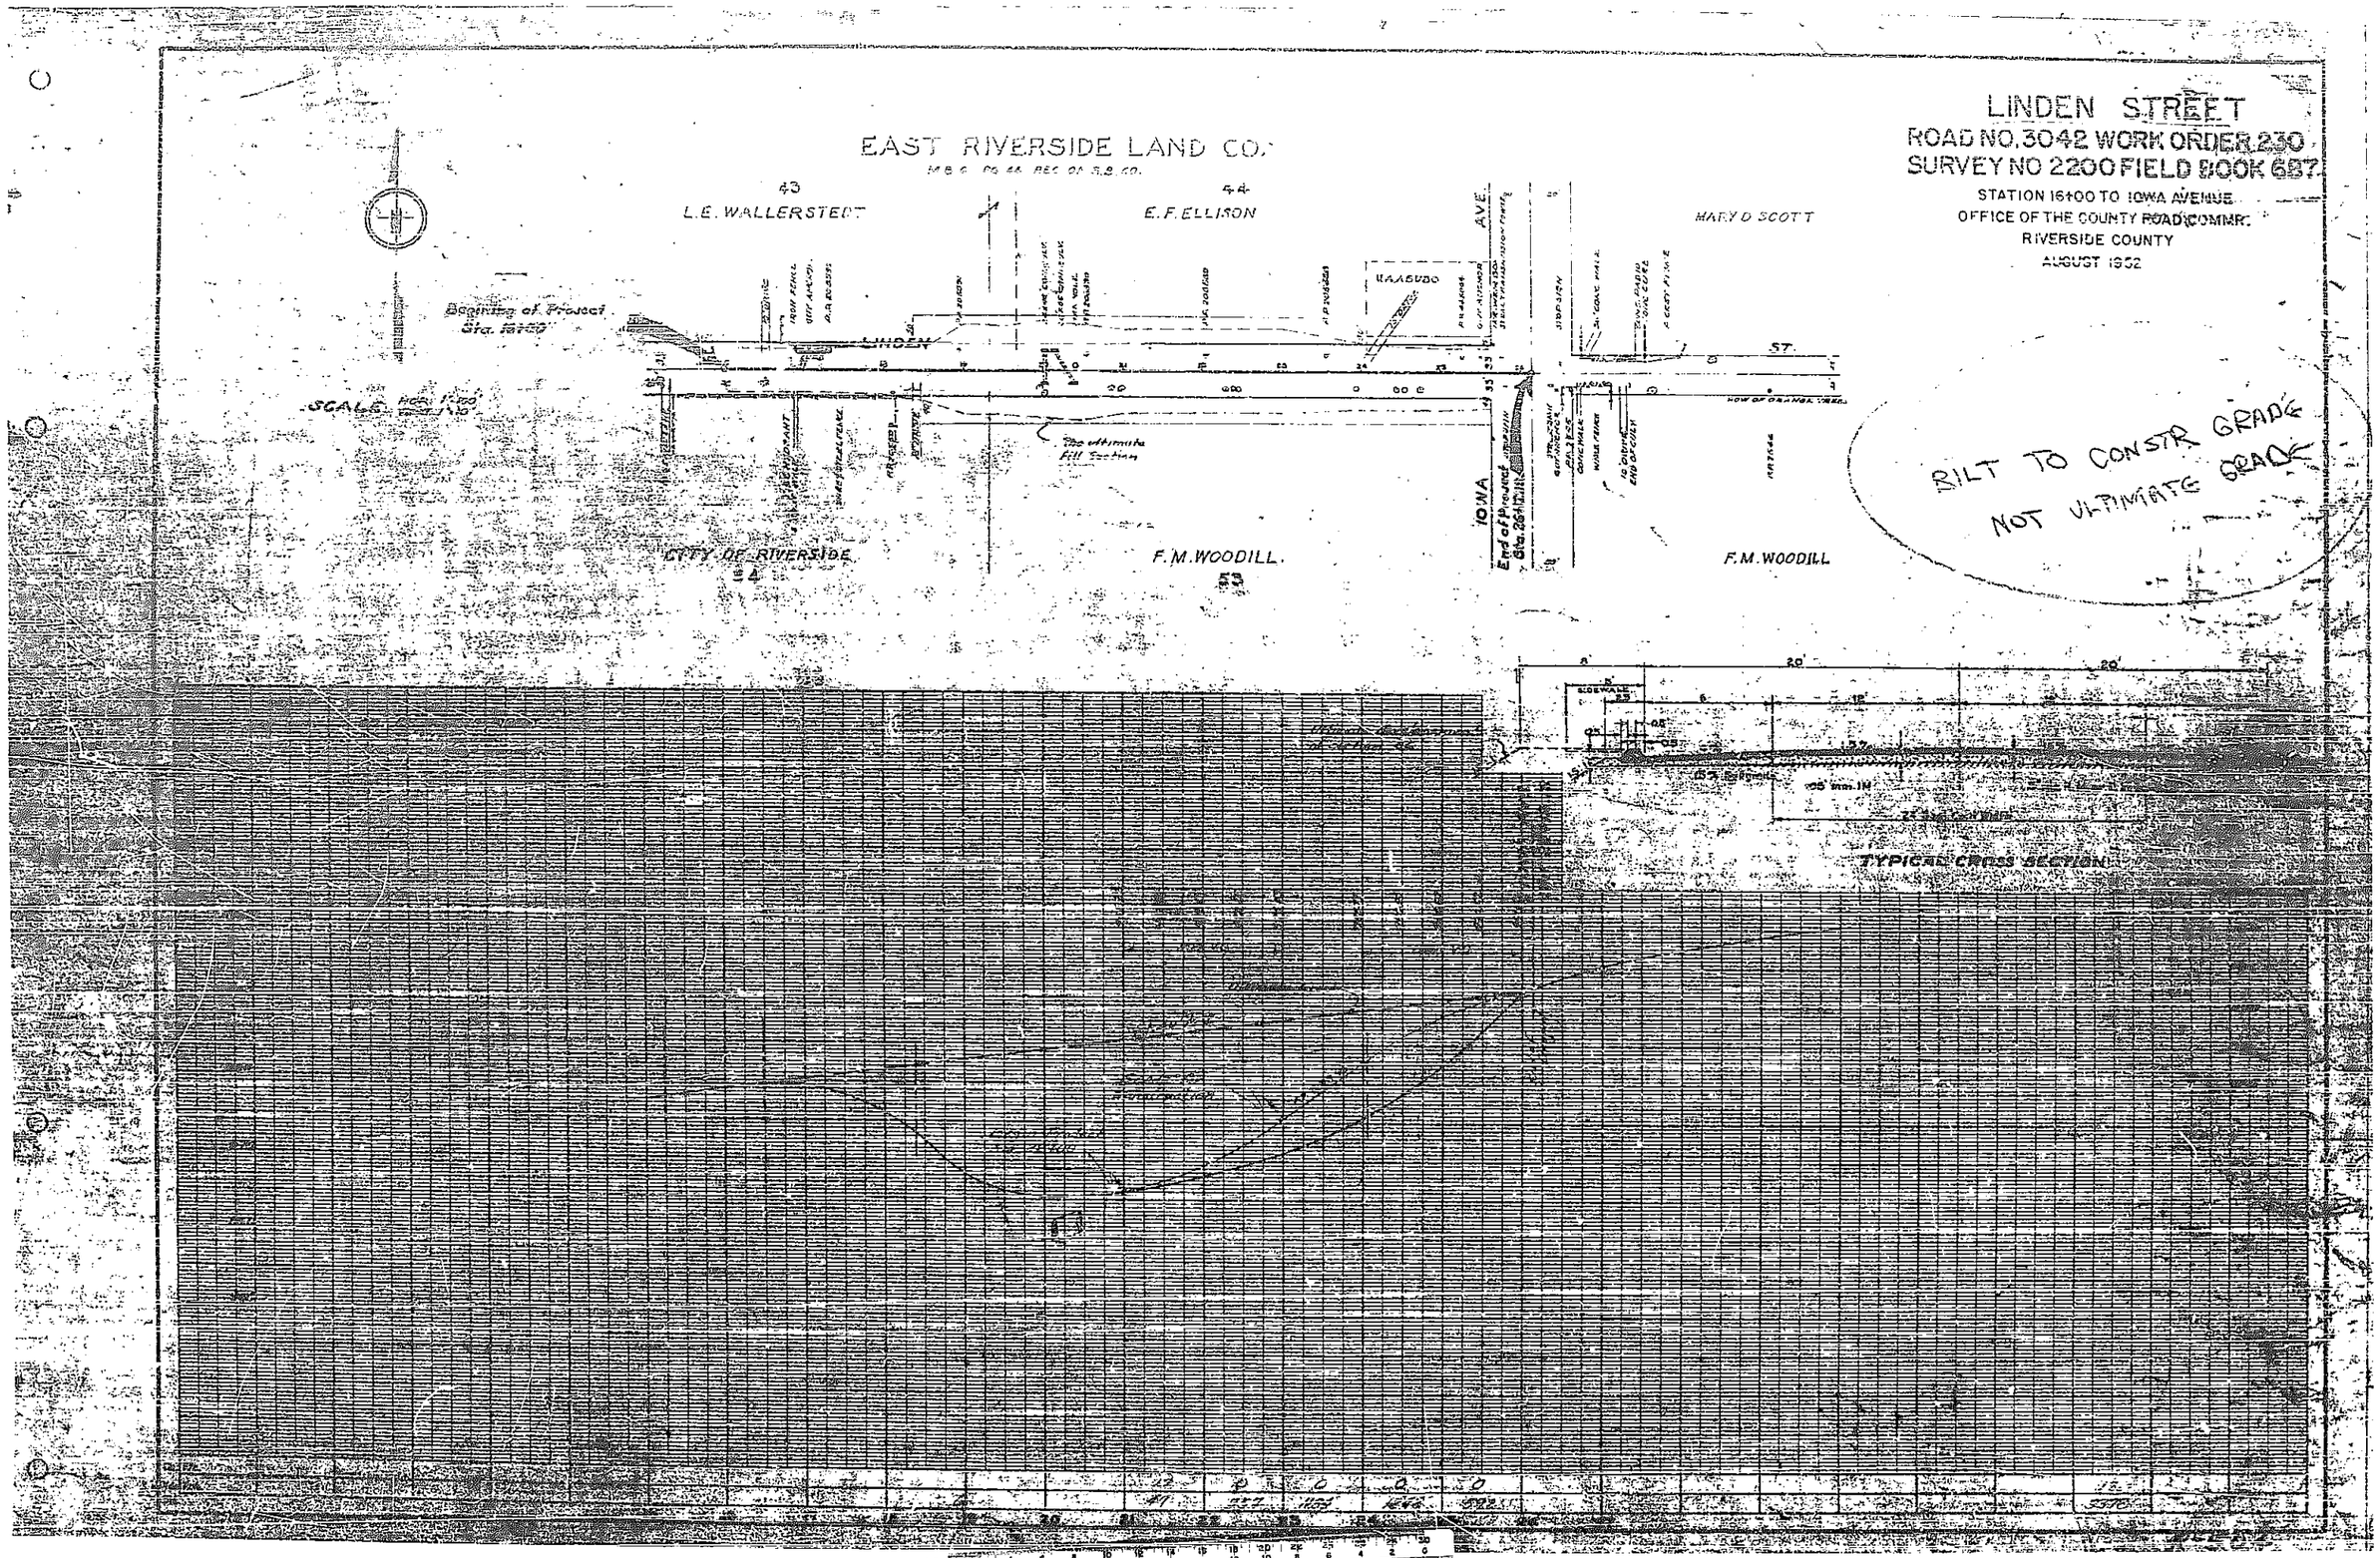
LINDEN STREET
ROAD NO. 3042 WORK ORDER 230
SURVEY NO 2200 FIELD BOOK 687
STATION 16+00 TO IOWA AVENUE
OFFICE OF THE COUNTY ROAD COMMR.
RIVERSIDE COUNTY
AUGUST 1952
EAST RIVERSIDE LAND CO.
L.E. WALLERSTEDT
E.F. ELLISON
MARY D SCOTT
Beginning of Project
LINDEN
ST.
SCALE
The ultimate Fill Section
IOWA
AVE.
End of Project
CITY OF RIVERSIDE
F.M. WOODILL
F.M. WOODILL
BILT TO CONSTR GRADE
NOT ULTIMATE GRADE
TYPICAL CROSS SECTION