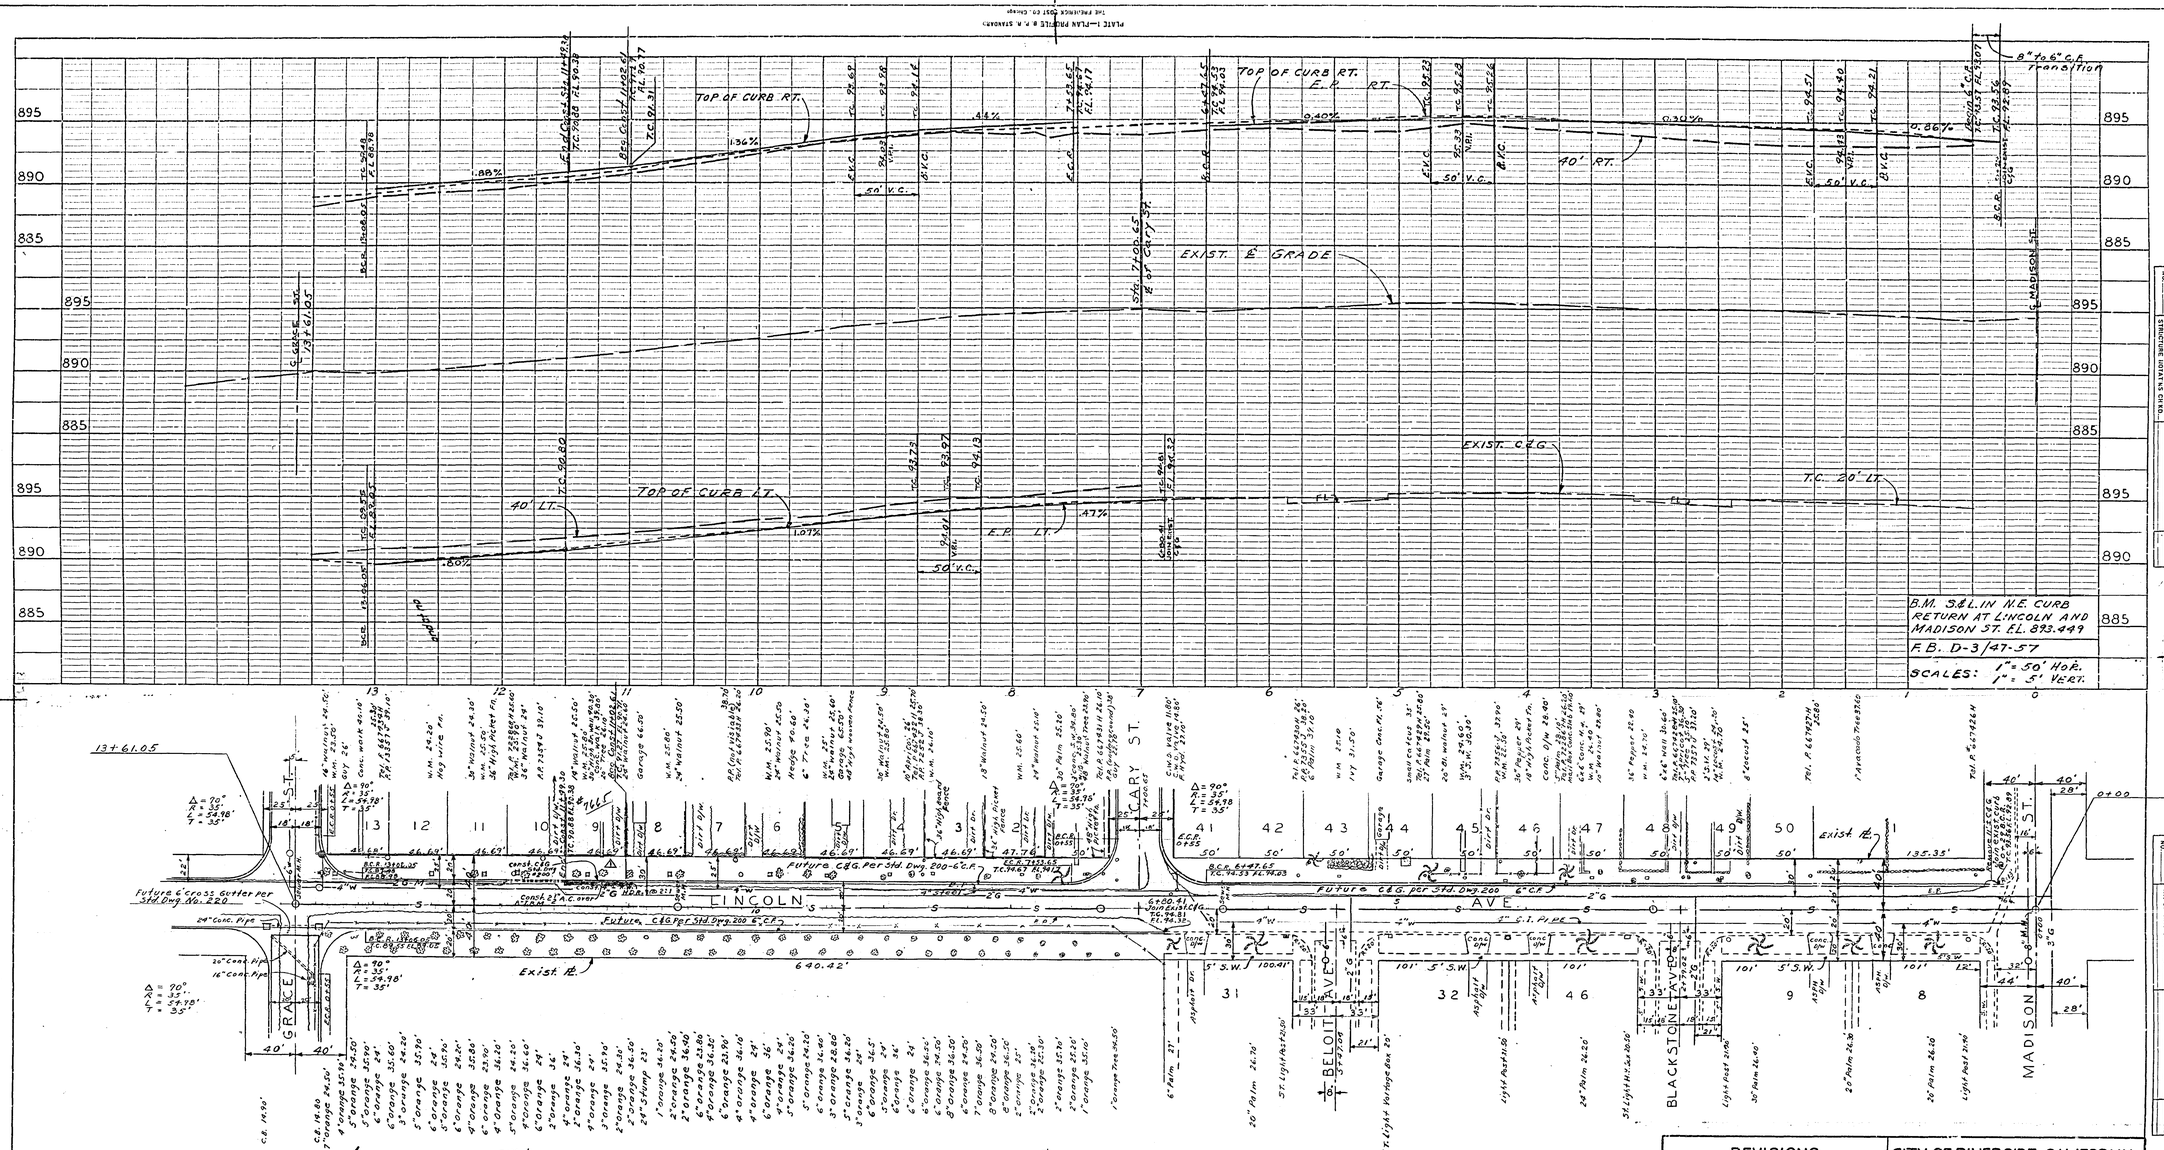

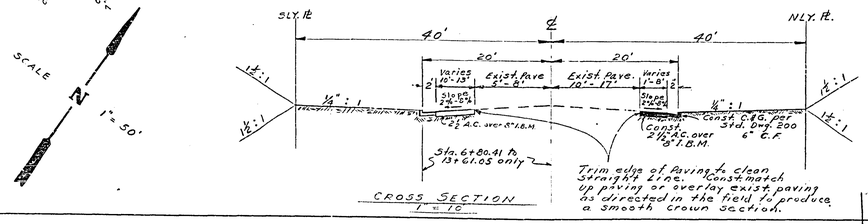

CROSS SECTION 1" = 10'

NOTE:
All Construction shall be in accordance with Standard Drawings, & Specifications No. 461 of the Department of Public Works, City of Riverside.

REVISIONS		
MARK	DATE	DESCRIPTION
△	6-28-62	Rev. Const. Limits Sta. 11+32.61 to 11+49.30

CITY OF RIVERSIDE CALIFORNIA
DEPARTMENT OF PUBLIC WORKS

LINCOLN AVENUE

MADISON TO GRACE

DESIGNED BY R.M.C. CHECKED BY
DRAWN BY H.R.C.
RECOMMENDED BY ASSISTANT CITY ENGINEER
APPROVED BY DIRECTOR OF PUBLIC WORKS
DATE July 17, 1962

R-534
SHEET 1 OF 1

PROFILE
NOTE BOOK
NO.
SURVEYED
PLOTTED
GRADES CHECKED
R.M.S. NOTED
STRUCTURE NOTATIONS CHKD.
BY
DATE

PLAN
NOTE BOOK
NO.
SURVEYED
PLOTTED
ALIGNMENT CHECKED
RT. OF WAY CHECKED
BY
DATE