
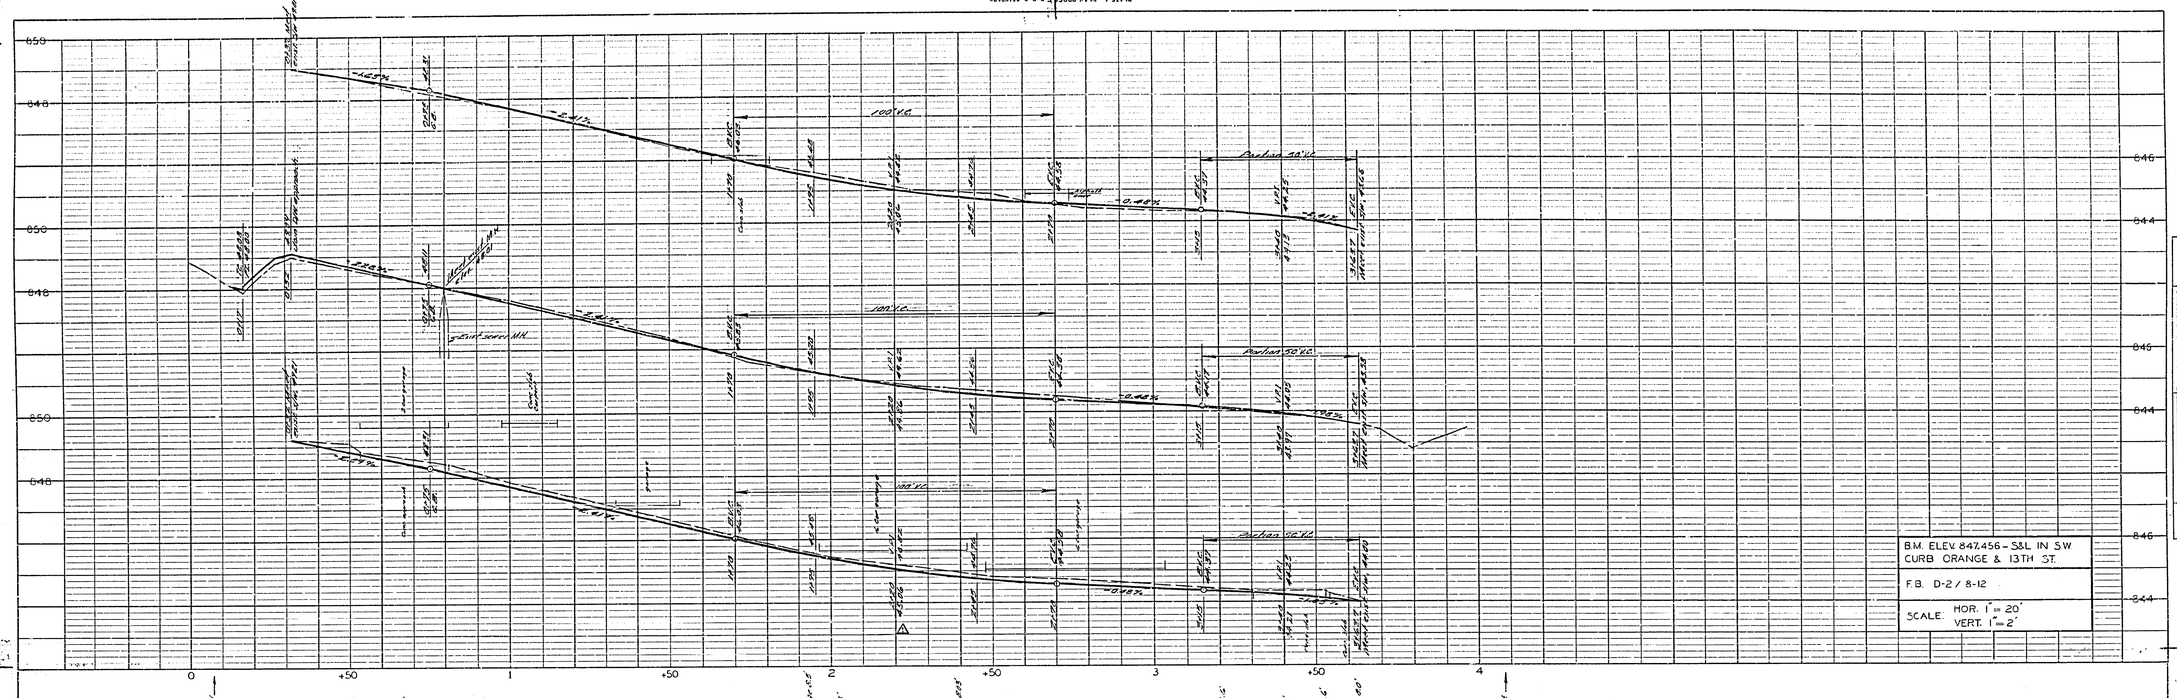

PROFILE
NOTE BOOK NO.
PLOTTED
GRADES CHECKED
STRUCTURE NOTATIONS CHKD.
BY
DATE

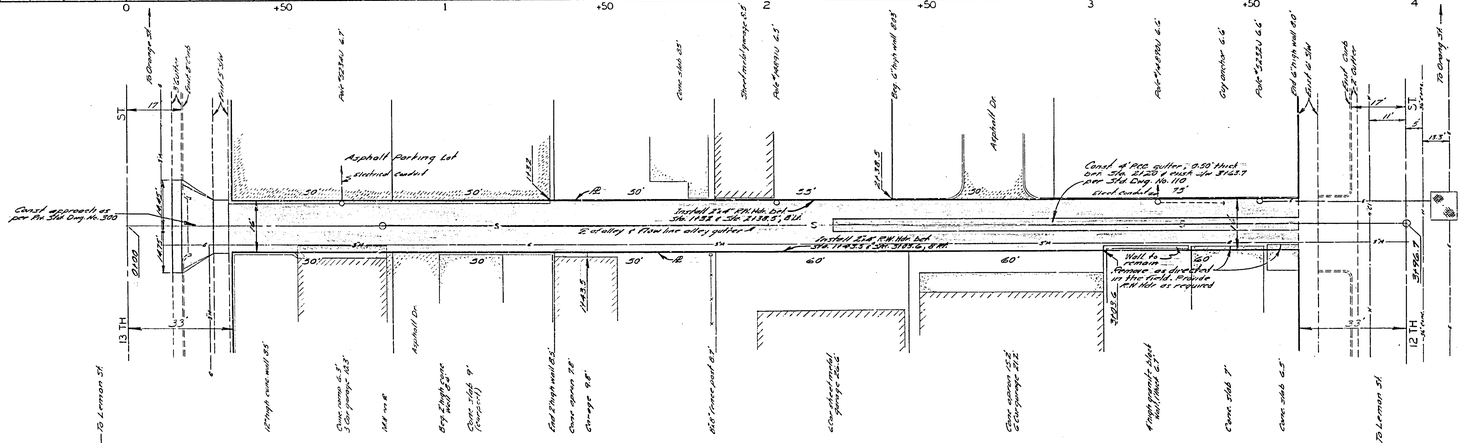

Note:

(1.) Construction shall conform to Standard Specifications No. 461.

(2) Provide a smooth paved transition to parking lots, drives, and garages as directed in the field.

PLAN
NOTE BOOK NO.
SURVEYED
PLOTTED
ALIGNMENT CHECKED
ALL OF WAY CHECKED
BY
DATE

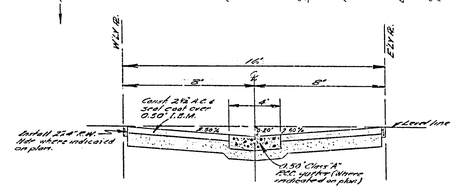

TYPICAL CROSS SECTION
Per Std. Dwg. No. 110 (Modified)
No Scale

REVISIONS			CITY OF RIVERSIDE CALIFORNIA DEPARTMENT OF PUBLIC WORKS
MARK	DATE	DESCRIPTION	
1	6-6-62	Corrected El. & V.S. @ 2+20 D.H.B. – W.	ALLEY PAVING FROM 12TH TO 13TH ST. BET ORANGE & LEMON ST.
DESIGNED BY		CHECKED BY	APPROVED BY
DRAWN BY			DIRECTOR OF PUBLIC WORKS
RECOMMENDED BY		ASSISTANT CITY ENGINEER	DATE Jan 11, 1962

R-535
SHEET 1 OF 1

[redacted]