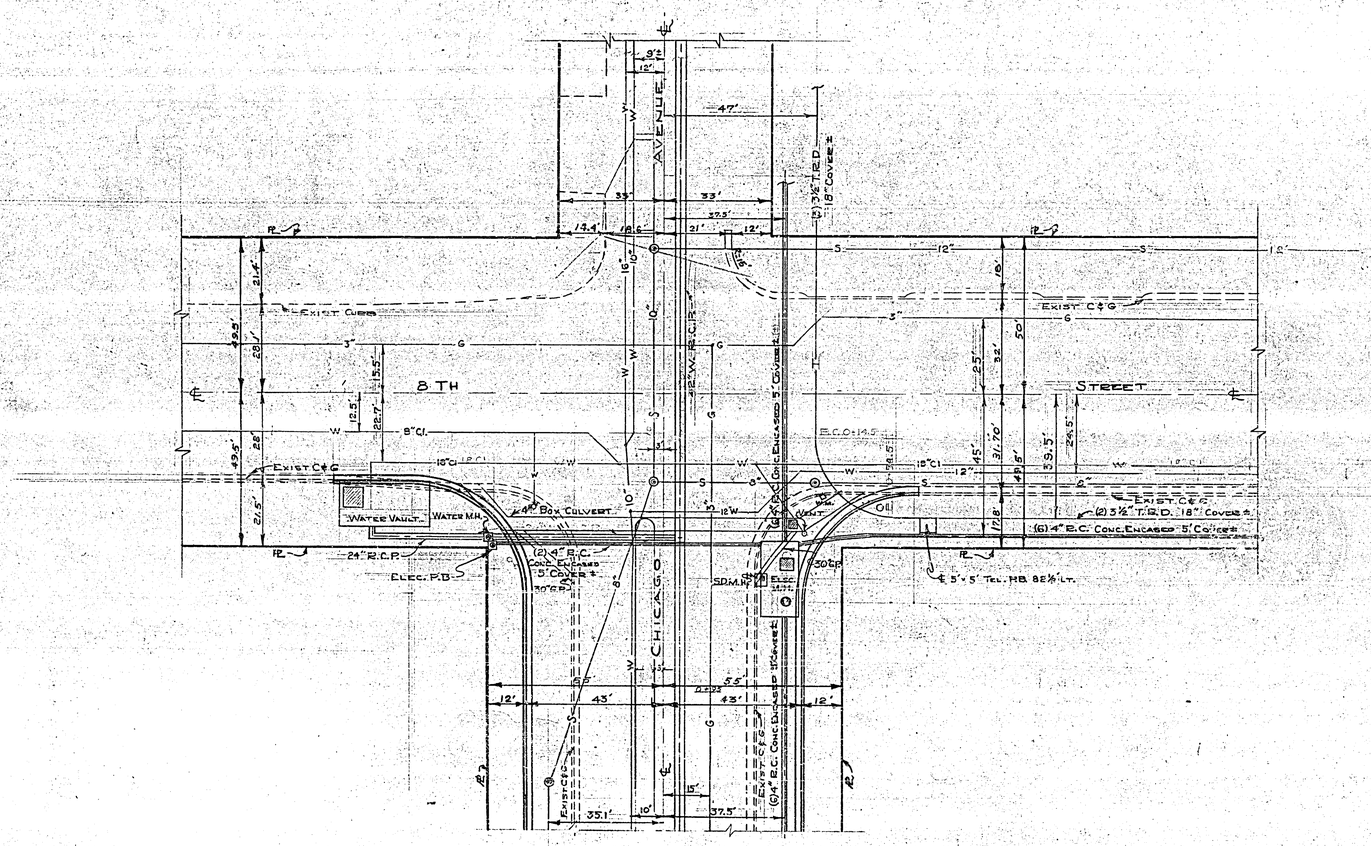

SCALE: 1" = 20'

REVISIONS		
MARK	DATE	DESCRIPTION

CITY OF RIVERSIDE, CALIFORNIA
DEPARTMENT OF PUBLIC WORKS

INTERSECTION
8TH. ST. — CHICAGO AVE.
UNDERGROUND LOCATIONS
(NOT PART OF CHICAGO AVE. CONT.)

DESIGNED BY
DRAWN BY A.F.W.
CHECKED BY
RECOMMENDED BY
ASSISTANT CITY ENGINEER
APPROVED BY
DIRECTOR OF PUBLIC WORKS
DATE
R. 536 A
SHEET OF