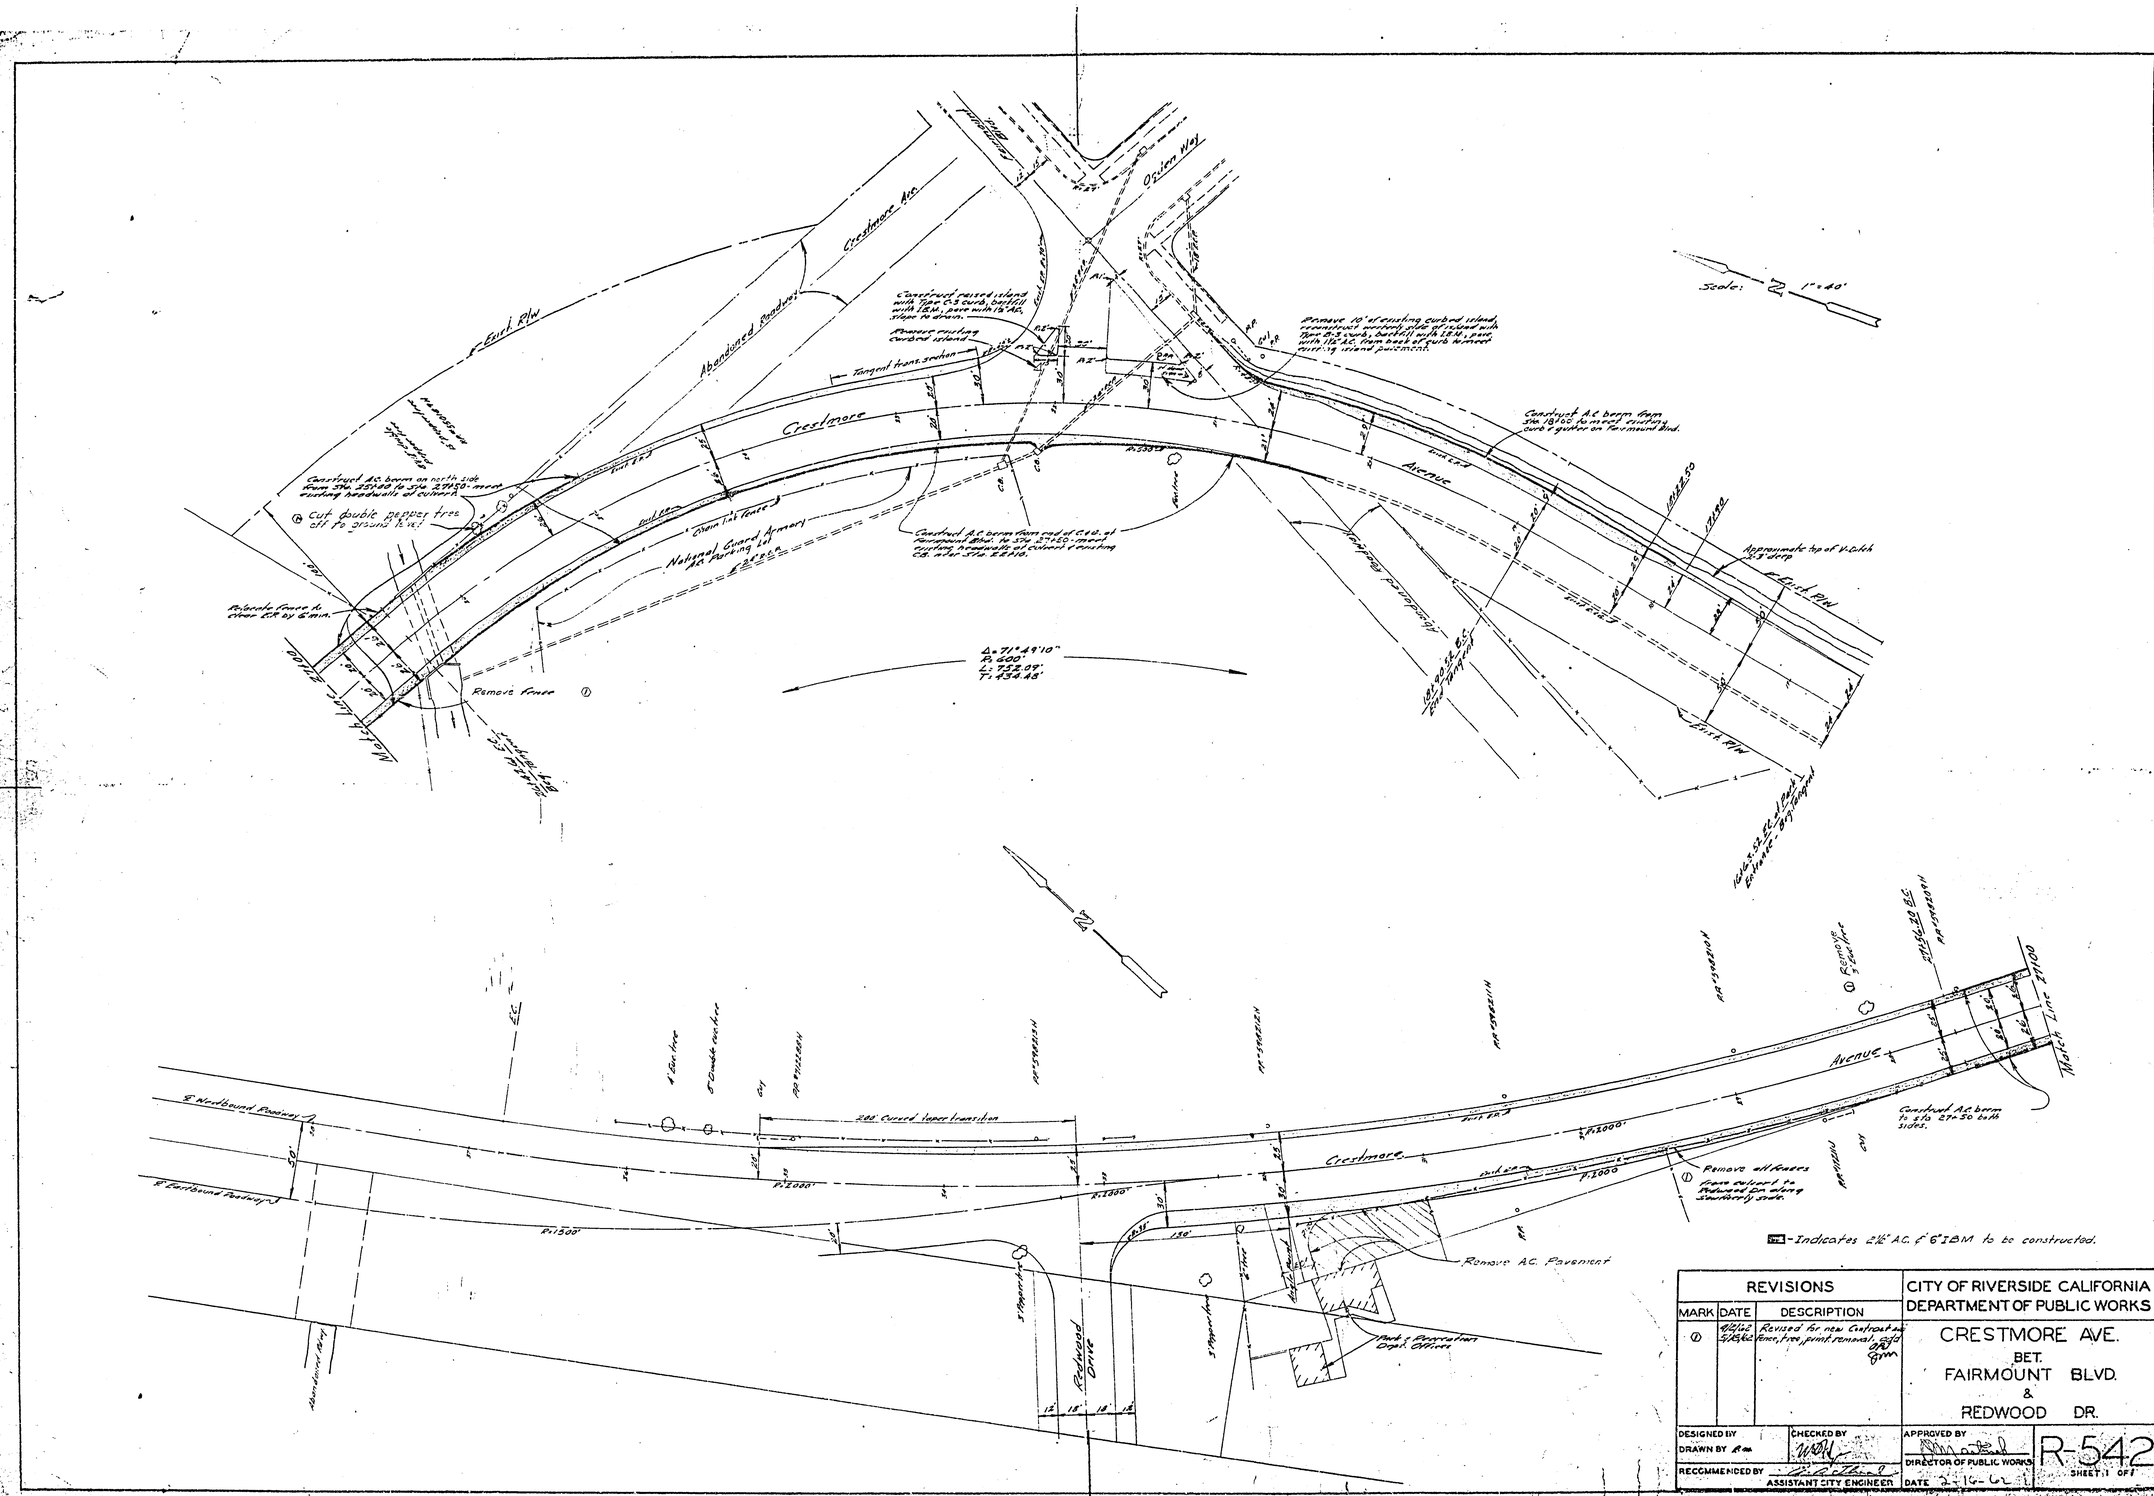

REVISIONS			CITY OF RIVERSIDE CALIFORNIA DEPARTMENT OF PUBLIC WORKS
MARK	DATE	DESCRIPTION	CRESTMORE AVE. BET. FAIRMOUNT BLVD. & REDWOOD DR.
①	4/11/62 5/15/62	Revised for new Contract no. tree, tree point removal, add Park & Rec.	
DESIGNED BY	CHECKED BY	APPROVED BY	R-542
DRAWN BY R.m.		DIRECTOR OF PUBLIC WORKS	
RECOMMENDED BY	ASSISTANT CITY ENGINEER	DATE 2-16-62	SHEET 11 OF