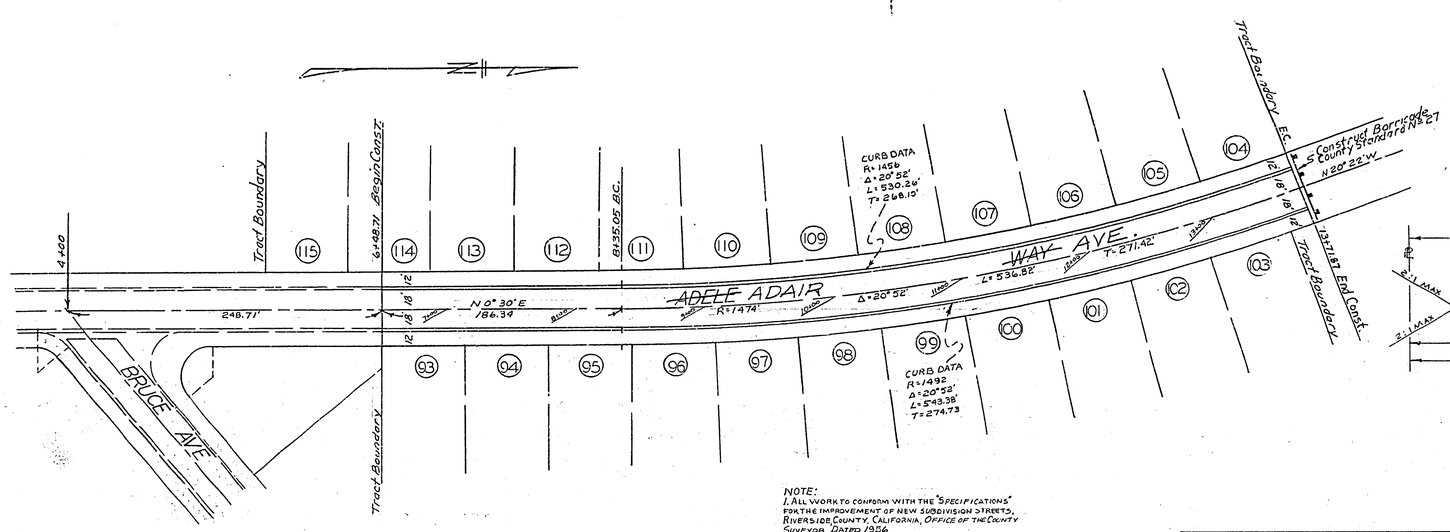

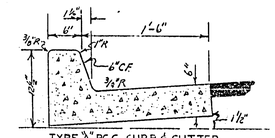

TYPE "A" P.C.C. CURB & GUTTER
COUNTY STANDARD NO. 10

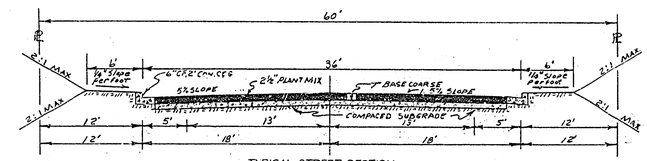

TYPICAL STREET SECTION

NOTE:
1. ALL WORK TO CONFORM WITH THE "SPECIFICATIONS" FOR THE IMPROVEMENT OF NEW SUBDIVISION STREETS, RIVERSIDE COUNTY, CALIFORNIA, OFFICE OF THE COUNTY SURVEYOR, DATED 1956
2. RELOCATION OF EXISTING UTILITIES WILL BE DONE BY THE SUBDIVIDER.
3. INSTALL ALL STREET NAME SIGNS (CO. STD. No. 28) AS DIRECTED. V.C.

QUANTITIES	
ROADWAY EXCAVATION	3620 CU.YDS.
IMPORT MATERIAL	515 CU.YDS.
PLANT MIX SURFACING 23,964.28 S.F.	373 TONS
TYPE "A" P.C.C. CURB & GUTTER (1446.52 Unit 1)	68. CU.YDS.

APPROVED Paul E. Stout 11-29-57
FOR ROAD COMMISSIONER RIVERSIDE COUNTY

STREET PLAN & PROFILE
~~ADELE WAY~~ ADAIR AVE.

RIVERSIDE ENGINEERING CO.
RIVERSIDE, CALIFORNIA
FOR THE HALE COMPANY
MODEL SUBDIVISION UNIT 5
DRAWN BY H.E. CHECKED BY B.M. SCALE 1"=50'
DATE OCT. 1957 REVISED
George O. Crowley CIVIL ENGINEER NO. 2455
JOB NO. 2012 SHEET 1 OF 1

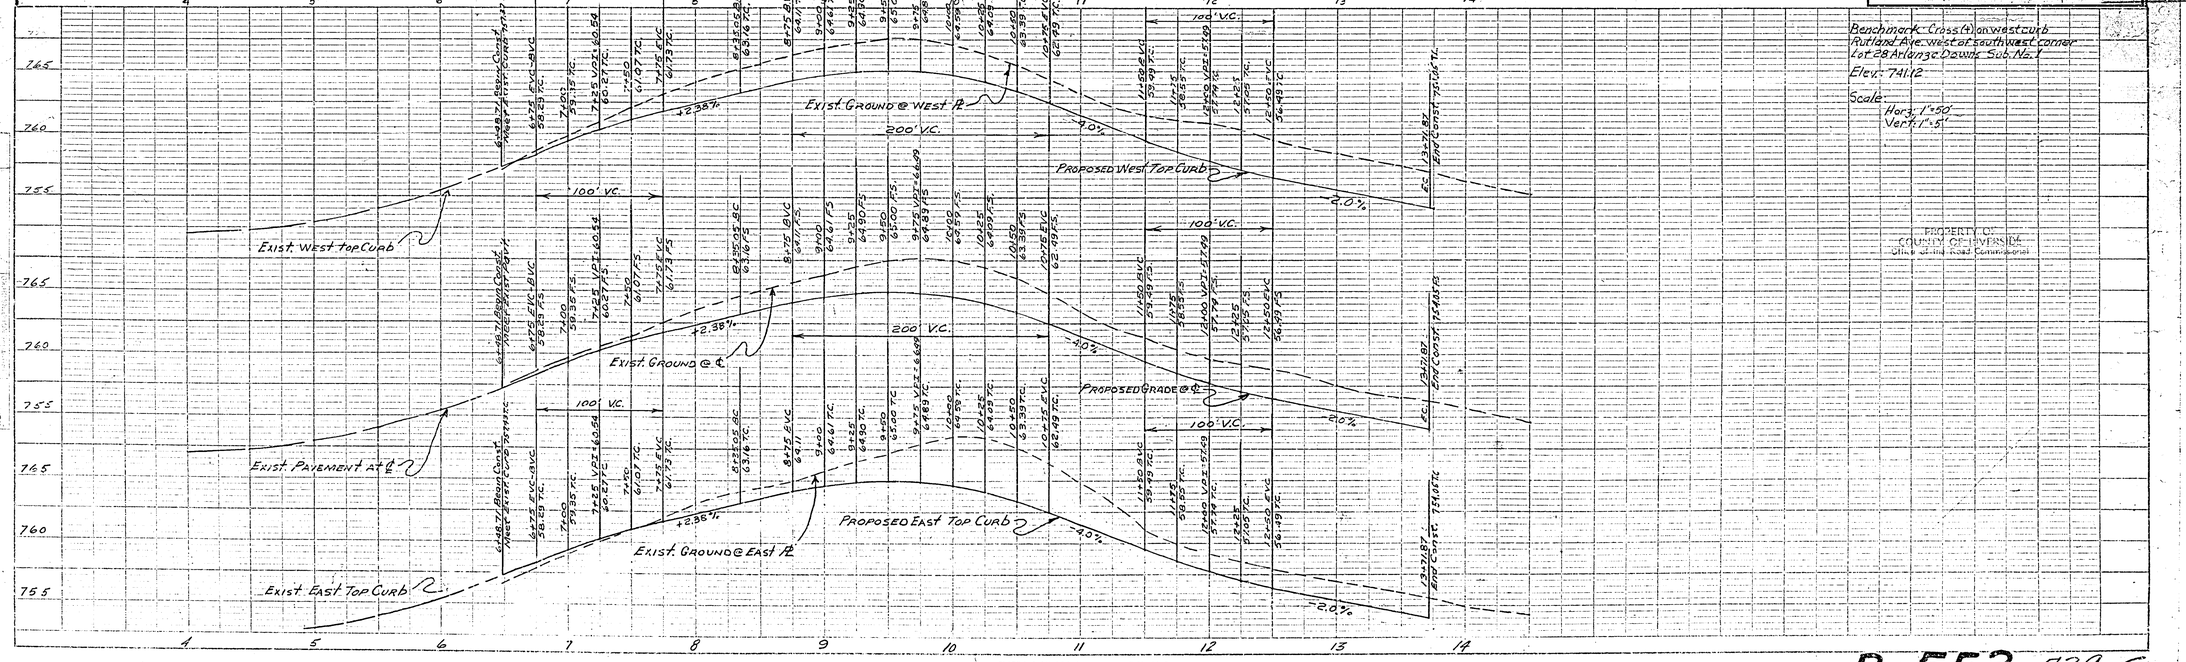

R-553 729-G

[redacted]