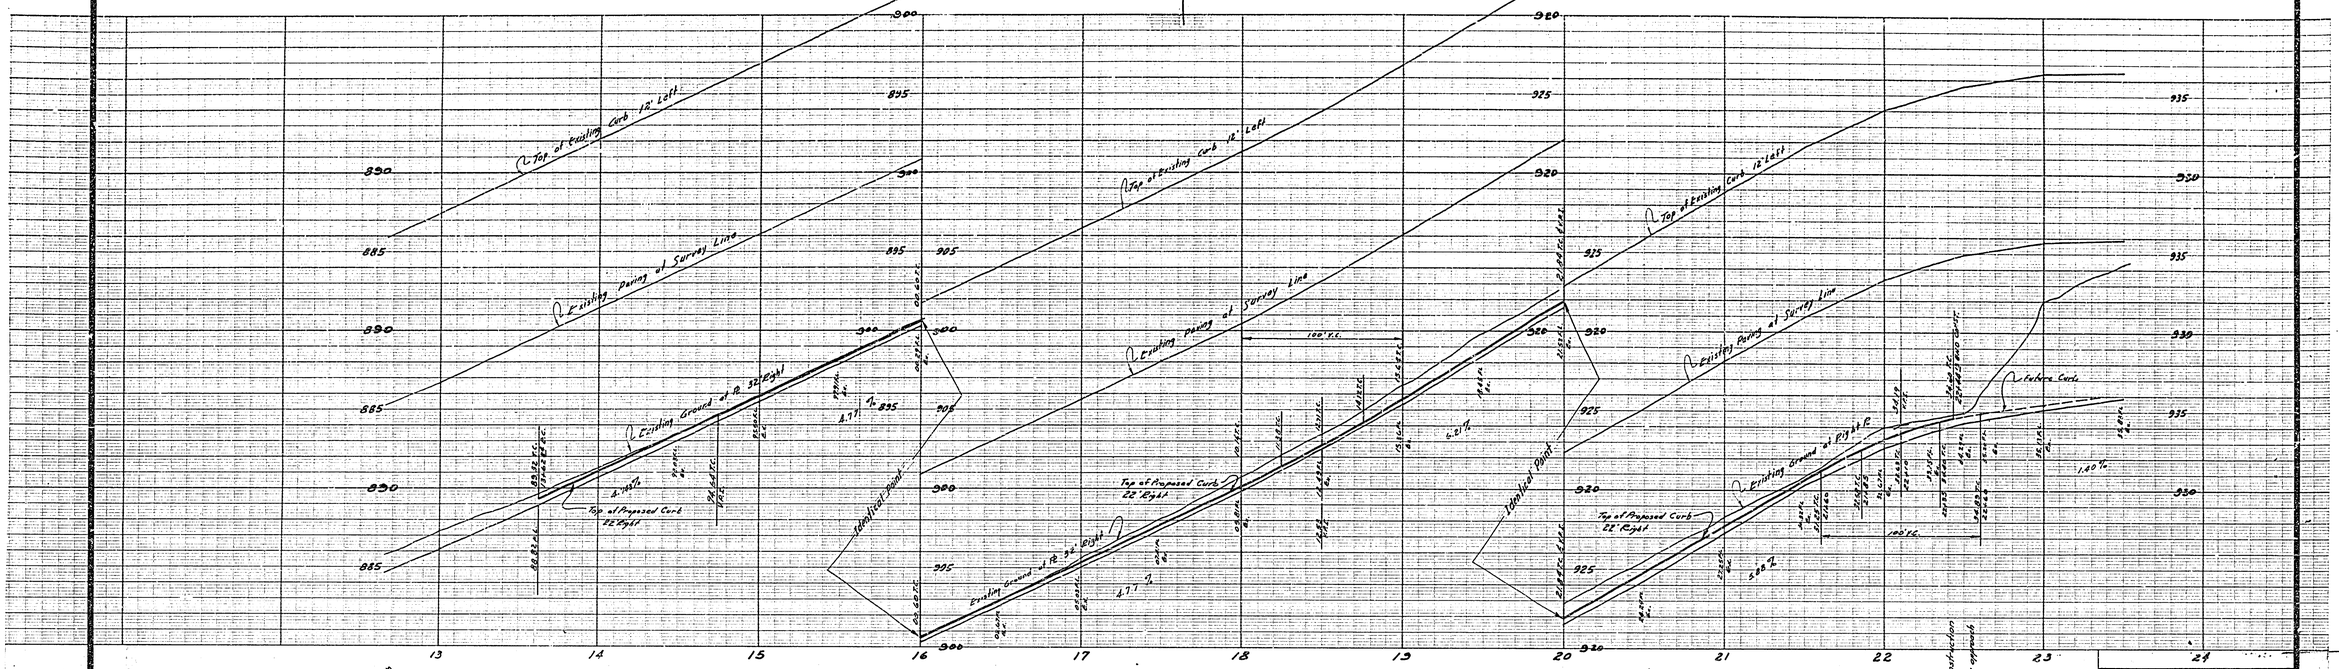

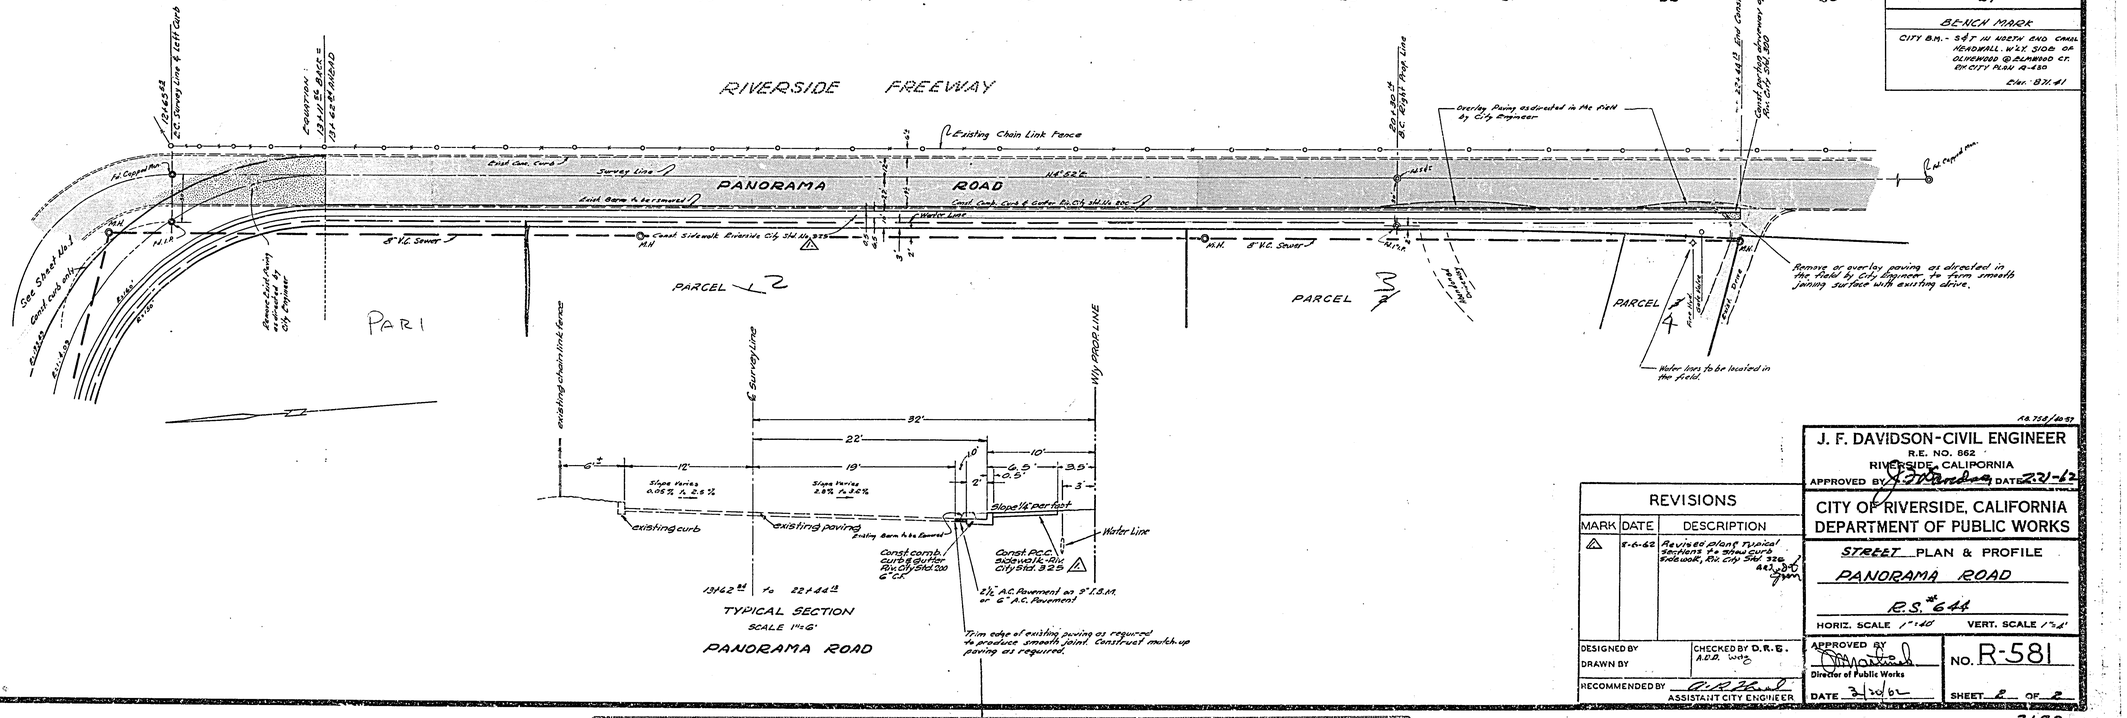

BENCH MARK

CITY B.M. - 3 FT W NORTH END CMKD HEADWALL. W'LY SIDE OF OLIVEWOOD @ ELMWOOD CT. ELEV. CITY DATUM 10.430

Elev. 837.41

REVISIONS		
MARK	DATE	DESCRIPTION
1	8-6-62	Revised plan & typical sections to show curb, sidewalk, Riv. City Std. 220

DESIGNED BY

DRAWN BY

CHECKED BY D.R.E. A.D.D. WHB

RECOMMENDED BY R.R. Thrall ASSISTANT CITY ENGINEER

J. F. DAVIDSON-CIVIL ENGINEER
R.E. NO. 862
RIVERSIDE, CALIFORNIA
APPROVED BY J. Standing DATE 2-21-62

CITY OF RIVERSIDE, CALIFORNIA
DEPARTMENT OF PUBLIC WORKS

STREET PLAN & PROFILE

PANORAMA ROAD

R.S. 644

HORIZ. SCALE 1"=40' VERT. SCALE 1"=4'

APPROVED BY Director of Public Works

DATE 3/30/62

NO. R-581

SHEET 2 OF 2

2182

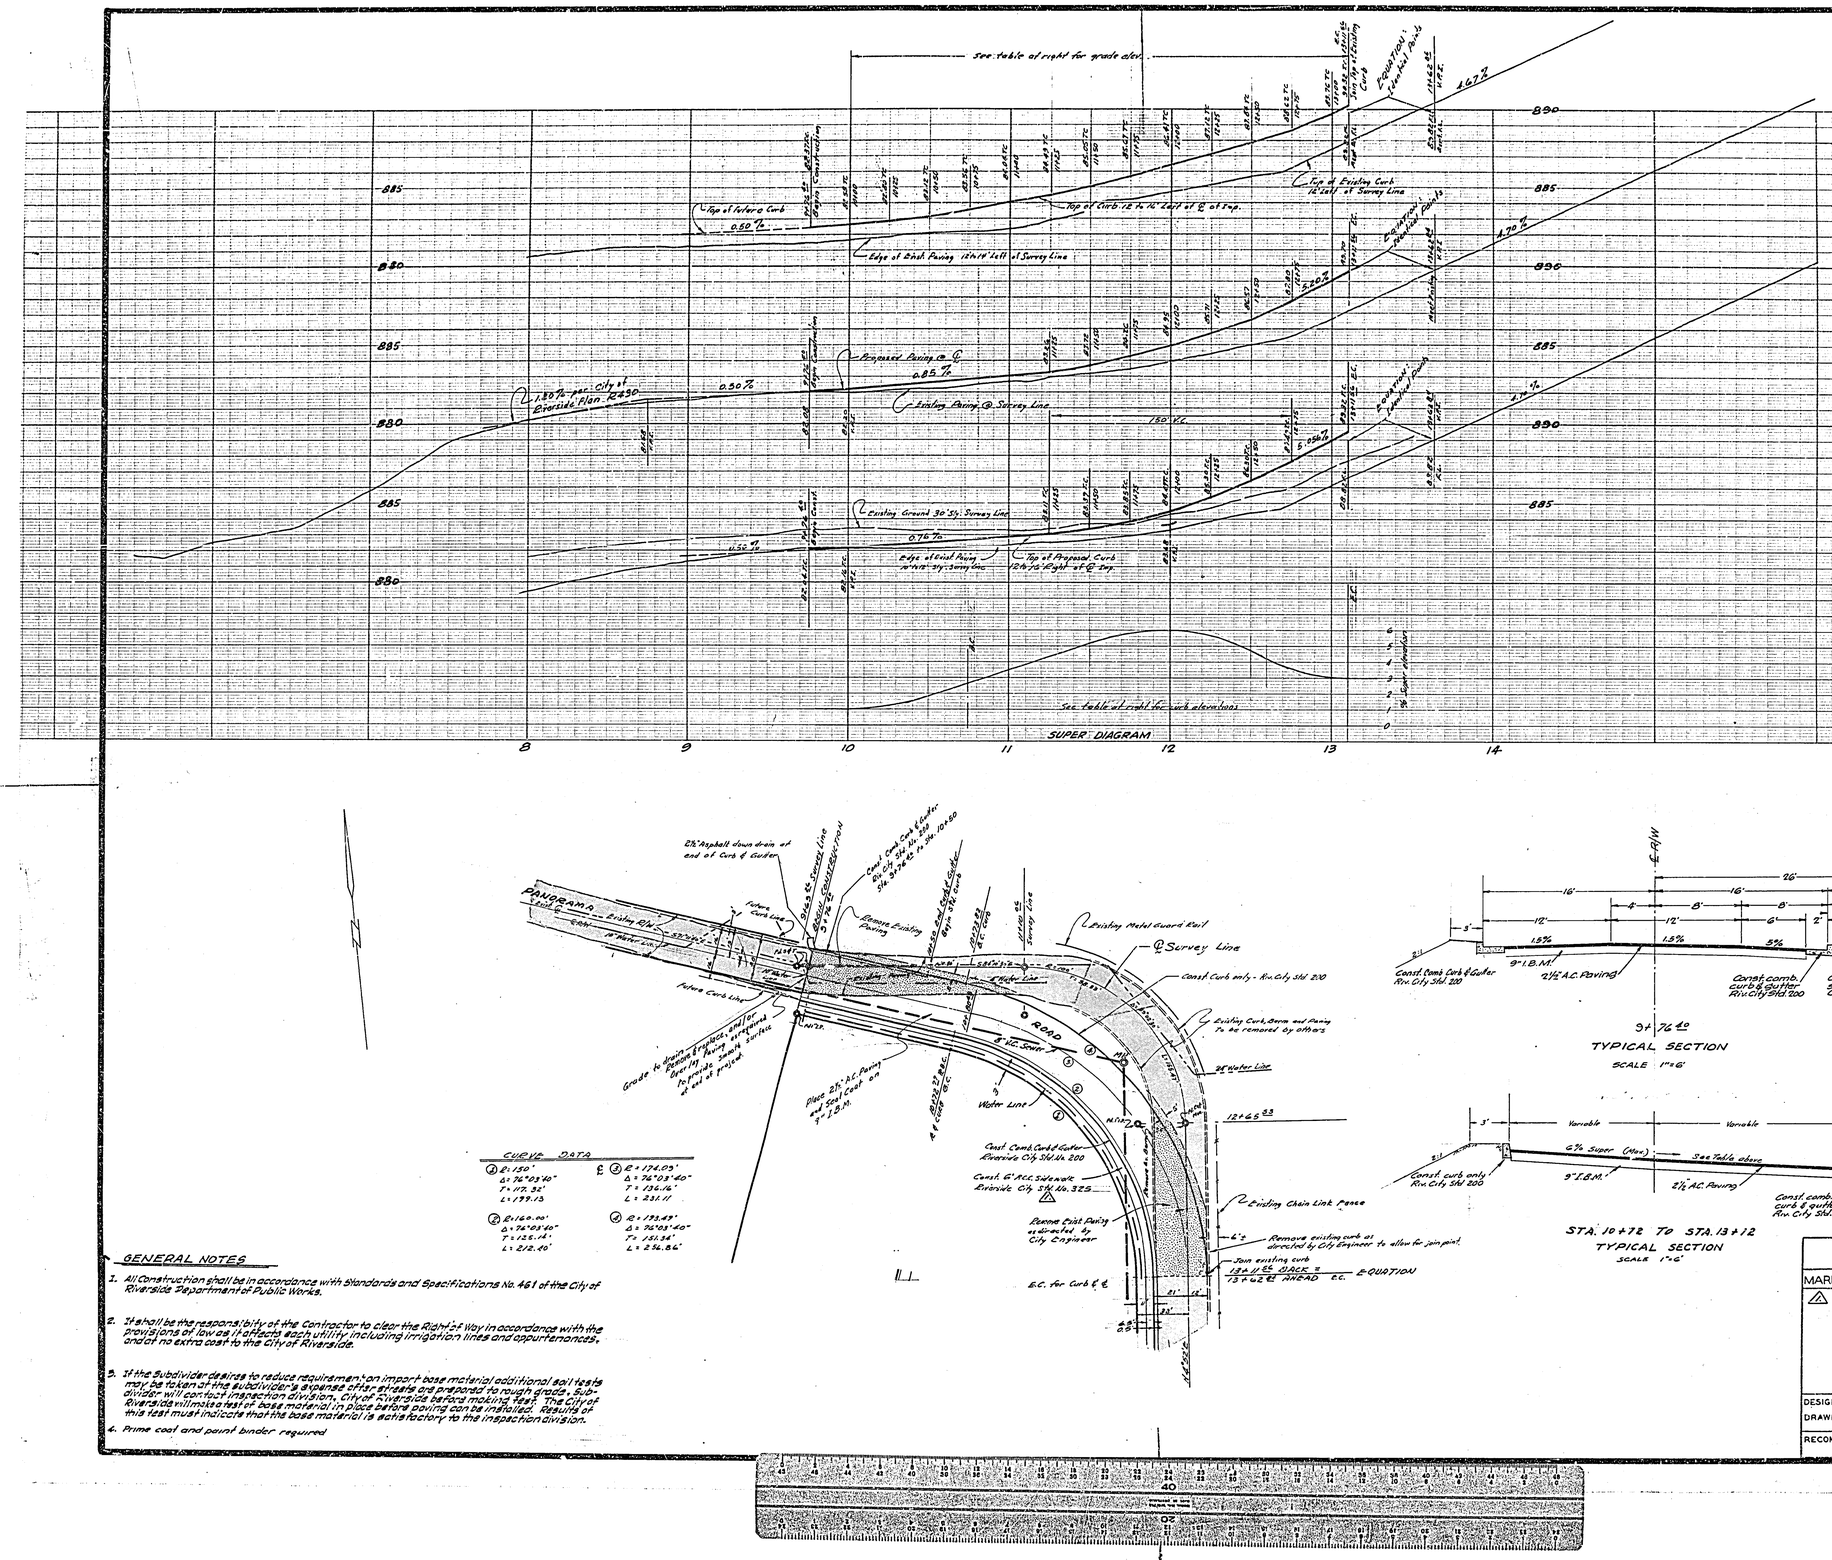

Station	Elev. Sty. Curb	% Super	Super	Elev. Ety. Curb
10+00	82.16			82.58
+25	82.35			82.80
+50	82.54	1.8	0.58	83.12
+75	82.73	2.6	0.81	83.54
11+00	82.92	3.5	1.12	84.04
+25	83.11	4.3	1.38	84.49
+50	83.39	5.2	1.66	85.05
+75	83.85	5.7	1.82	85.67
12+00	84.49	6.0	1.92	86.41
+25	85.30	5.7	1.82	87.12
+50	86.30	4.6	1.54	87.84
+75	87.49	3.6	1.15	88.64
13+00	88.73	2.1	1.03	89.76
+11.5	89.32	2.0	1.00	90.32

PANORAMA ROAD
Existing ℄
Existing Curb
Future Curb Line
Remove Existing Paving
Existing Metal Guard Rail
℄ Survey Line
Const. Curb only - Riv. City Std. 200
Existing Curb, Berm and Paving To be removed by others
8" Water Line
Const. Comb. Curb & Gutter Riverside City Std. No. 200
Const. 6' A.C. Sidewalk Riverside City Std. No. 325
Existing Chain Link Fence
Remove existing curb as directed by City Engineer to allow for join paint
Join existing curb
E.C. for Curb & ℄
