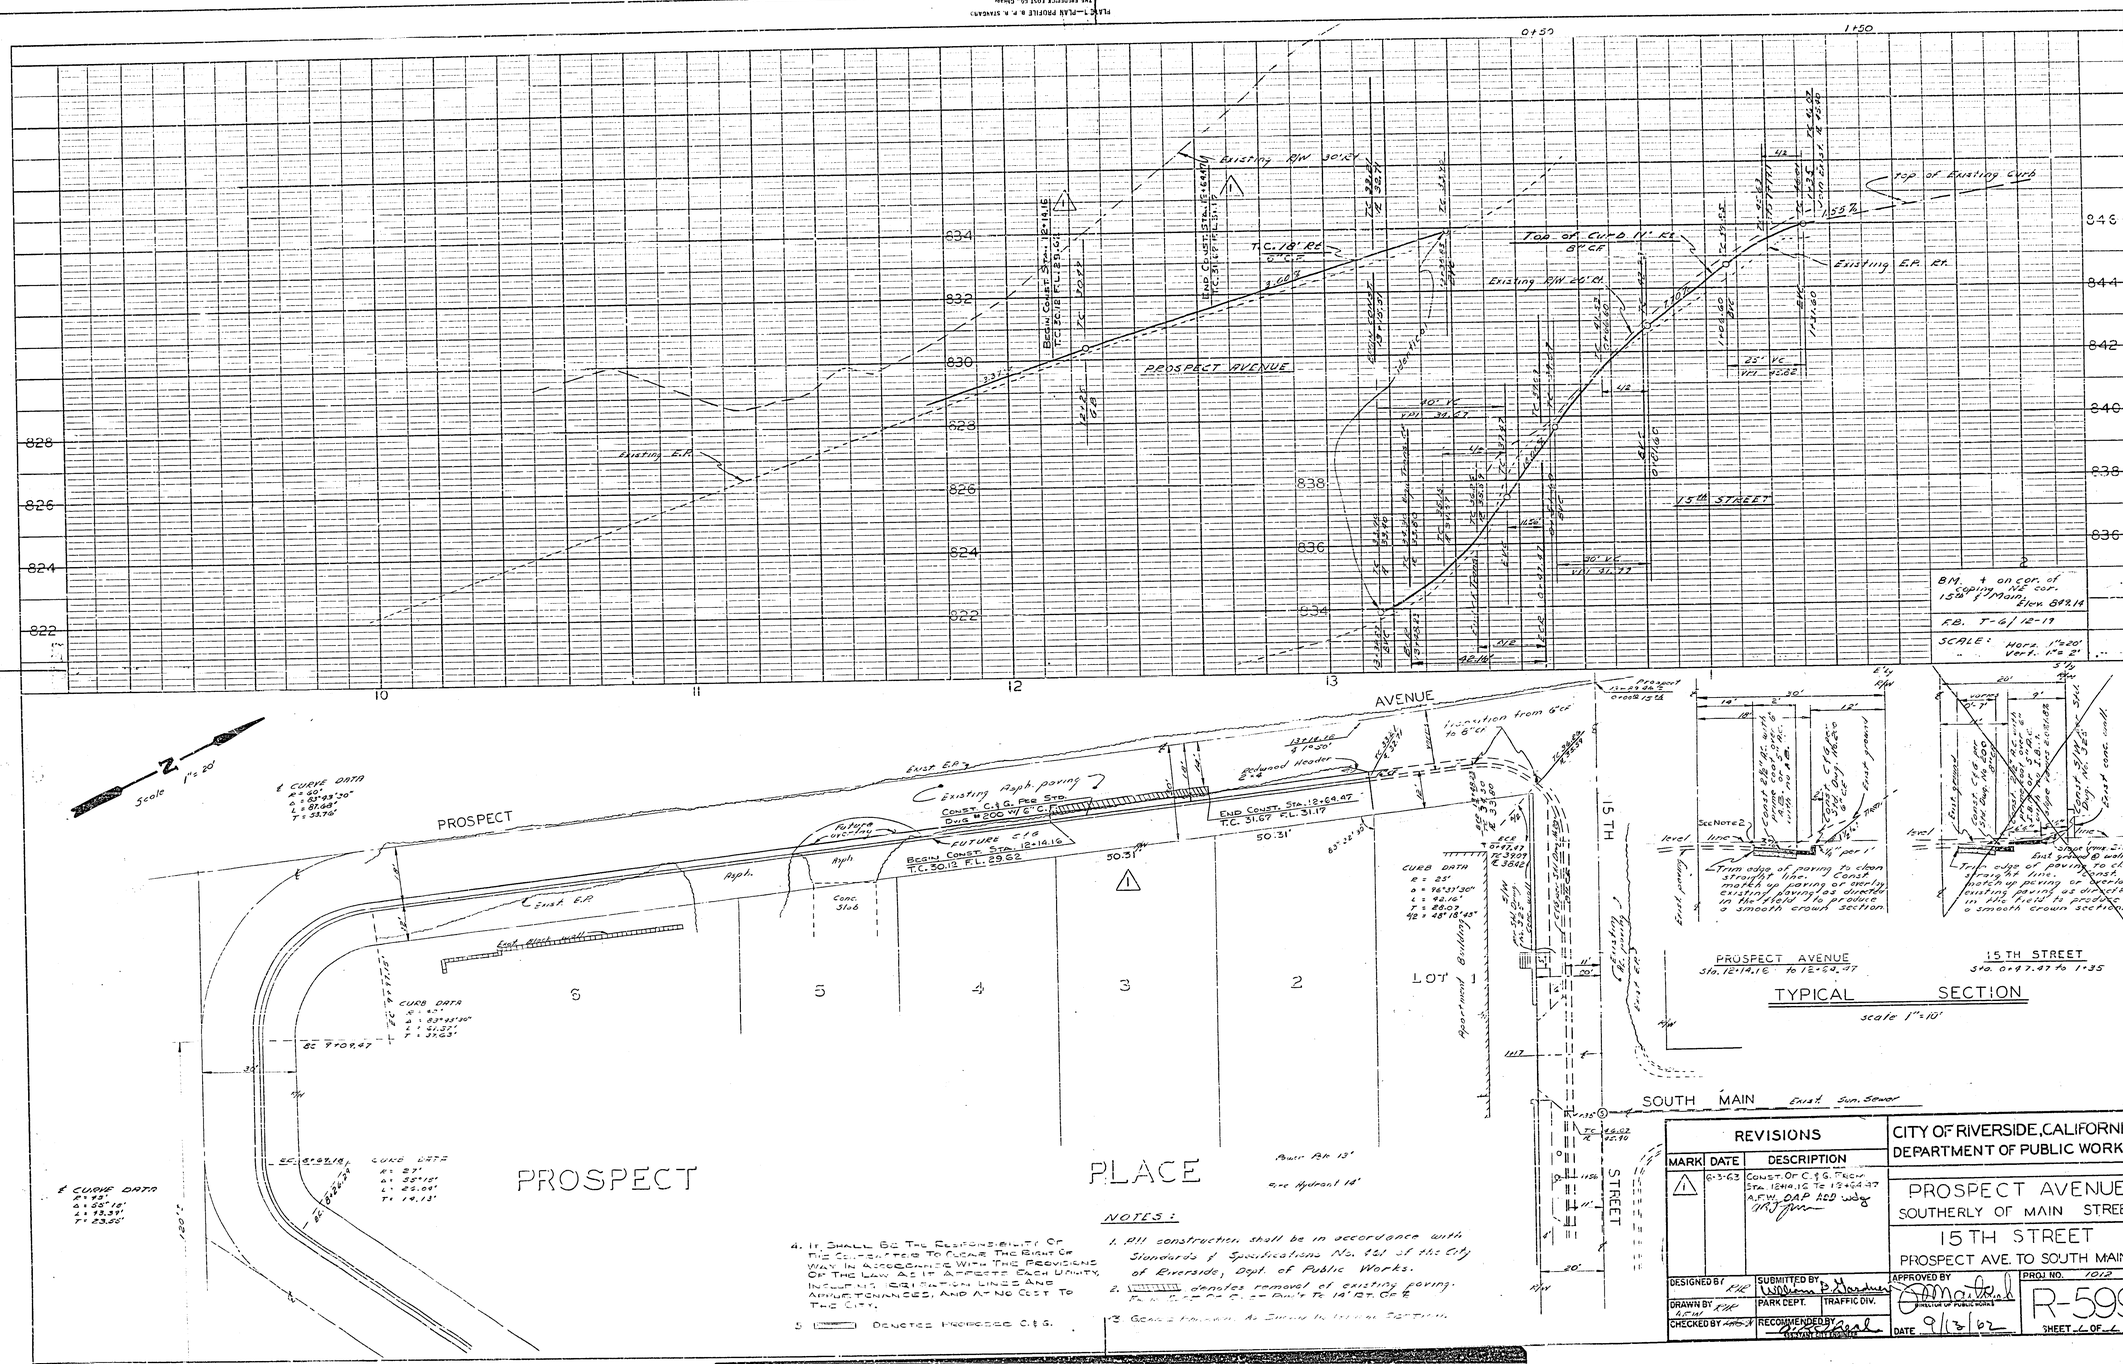

NOTES:

1. All construction shall be in accordance with Standards & Specifications No. 461 of the City of Riverside, Dept. of Public Works.
2. denotes removal of existing paving.
3. Grade Elevation As Shown In Typical Section.
4. It Shall Be The Responsibility Of The Contractor To Clear The Right Of Way In Accordance With The Provisions Of The Law As It Affects Each Utility, Including Irrigation Lines And Appurtenances, And At No Cost To The City.
5. Denotes Proposed C.&G.

REVISIONS		
MARK	DATE	DESCRIPTION
1	6-3-63	Const. Of C.&G. From Sta. 12+14.16 To 12+64.47 A.F.W. OAP ADD wdg

CITY OF RIVERSIDE, CALIFORNIA
DEPARTMENT OF PUBLIC WORKS

PROSPECT AVENUE
SOUTHERLY OF MAIN STREET

15TH STREET
PROSPECT AVE. TO SOUTH MAIN

DESIGNED BY RJR | SUBMITTED BY William B. Gardner | APPROVED BY | PROJ. NO. 1012
DRAWN BY RJR | PARK DEPT. | TRAFFIC DIV. | DIRECTOR OF PUBLIC WORKS
CHECKED BY | RECOMMENDED BY | DATE 9/13/62 | SHEET 1 OF 1

R-599

PROFILE: SURVEYED, PLOTTED, GRADES CHECKED, B.M.'S NOTED, STRUCTURE NOTATIONS CHK'D.

PLAN: SURVEYED, PLOTTED, ALIGNMENT CHECKED, RT. OF WAY CHECKED.