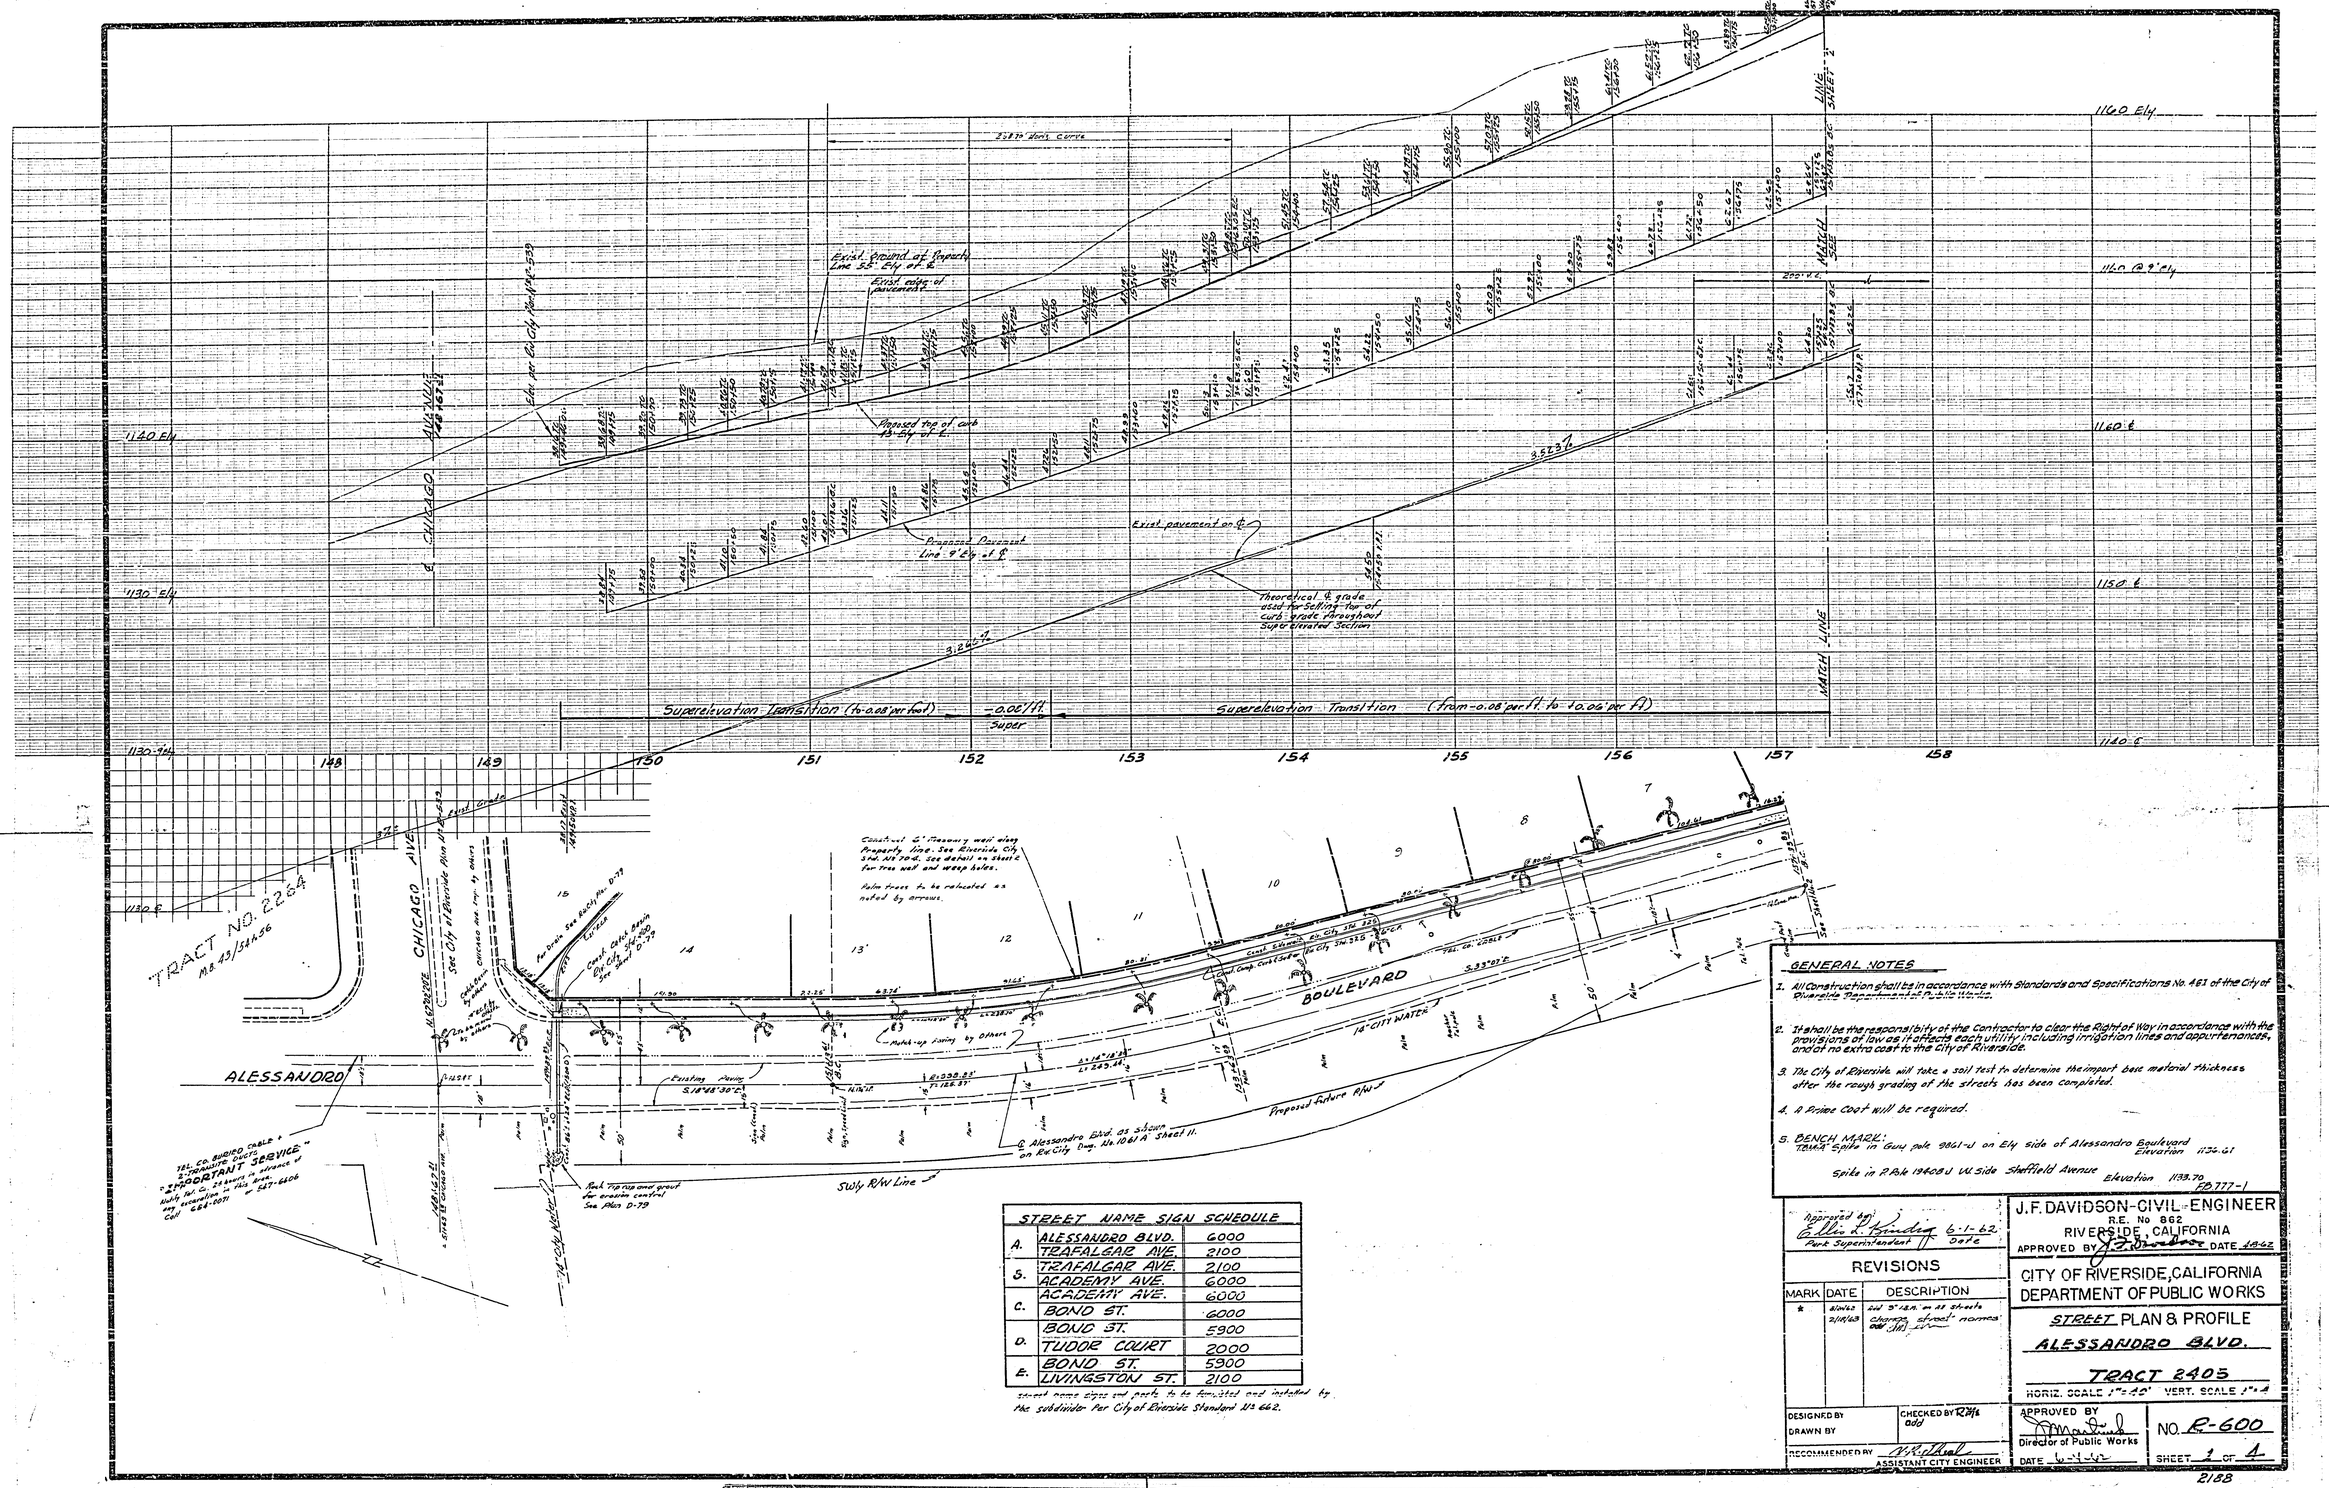

STREET NAME SIGN SCHEDULE		
A.	ALESSANDRO BLVD.	6000
	TRAFALGAR AVE.	2100
B.	TRAFALGAR AVE.	2100
	ACADEMY AVE.	6000
C.	ACADEMY AVE.	6000
	BOND ST.	6000
D.	BOND ST.	5900
	TUDOR COURT	2000
E.	BOND ST.	5900
	LIVINGSTON ST.	2100

Street name signs and posts to be furnished and installed by the subdivider per City of Riverside Standard No. 662.

GENERAL NOTES

1. All Construction shall be in accordance with Standards and Specifications No. 461 of the City of Riverside Department of Public Works.
2. It shall be the responsibility of the Contractor to clear the Right of Way in accordance with the provisions of law as it affects each utility including irrigation lines and appurtenances, and at no extra cost to the City of Riverside.
3. The City of Riverside will take a soil test to determine the import base material thickness after the rough grading of the streets has been completed.
4. A Prime Coat will be required.
5. BENCH MARK: TBM-A Spike in Guy pole 9861-J on Ely side of Alessandro Boulevard Elevation 1136.61

Spike in P Pole 19408 J W. Side Sheffield Avenue Elevation 1139.70 FD.777-1

Approved by: Ellen L. Pinding 6-1-62 Park Superintendent Date

J.F. DAVIDSON-CIVIL-ENGINEER
R.E. No 862
RIVERSIDE, CALIFORNIA
APPROVED BY J.F. Davidson DATE 1-8-62

CITY OF RIVERSIDE, CALIFORNIA
DEPARTMENT OF PUBLIC WORKS

STREET PLAN & PROFILE
ALESSANDRO BLVD.
TRACT 2405

HORIZ. SCALE 1" = 40' VERT. SCALE 1" = 4

REVISIONS

MARK	DATE	DESCRIPTION
*	8/14/62	add 5" I.D.H. on all streets
	2/14/63	change street normal add (16) line

DESIGNED BY
DRAWN BY
CHECKED BY R.W.B. add
RECOMMENDED BY W.R. Schaal ASSISTANT CITY ENGINEER

APPROVED BY Director of Public Works
DATE 6-1-62

NO. R-600

2188

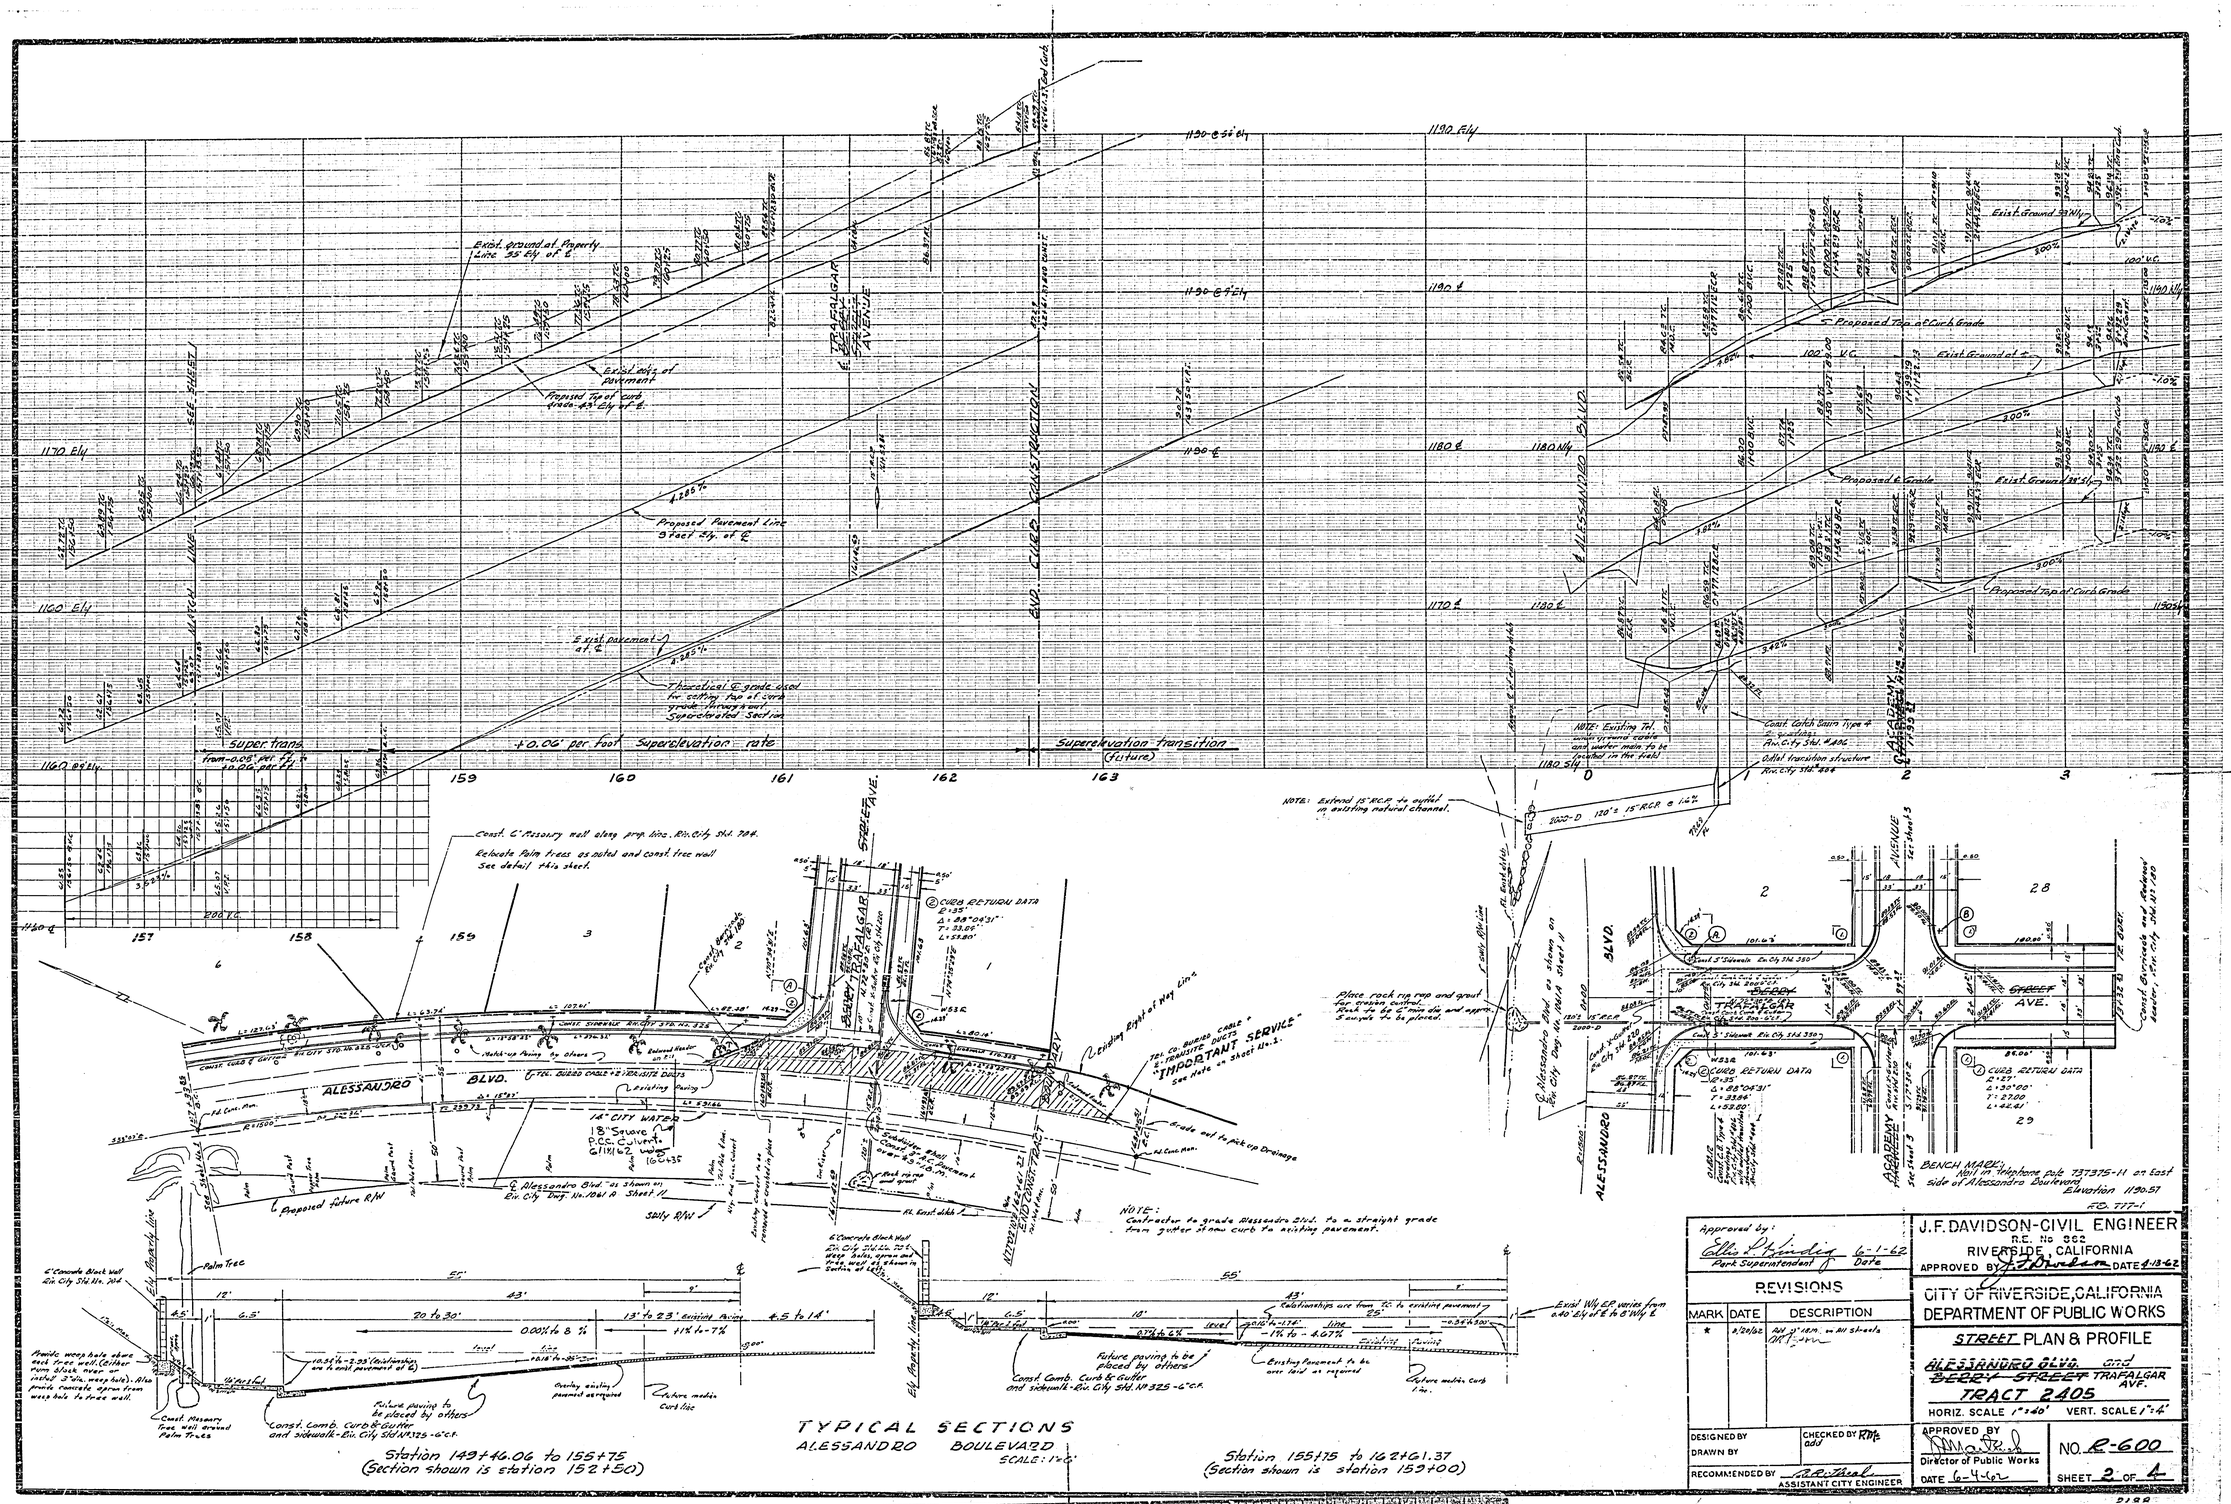

Approved by:
Ellis L. Standing 6-1-62
Park Superintendent Date

REVISIONS		
MARK	DATE	DESCRIPTION
*	8/20/62	Add 3" 1820 in all streets

DESIGNED BY
DRAWN BY
CHECKED BY RMF
RECOMMENDED BY A.R. Thiel ASSISTANT CITY ENGINEER

J.F. DAVIDSON-CIVIL ENGINEER
R.E. No 362
RIVERSIDE, CALIFORNIA
APPROVED BY J.F. Davidson DATE 4-18-62

CITY OF RIVERSIDE, CALIFORNIA
DEPARTMENT OF PUBLIC WORKS

STREET PLAN & PROFILE
ALESSANDRO BLVD. and ~~BERRY STREET~~ TRAFALGAR AVE.
TRACT 2405
HORIZ. SCALE 1"=40' VERT. SCALE 1"=4'

APPROVED BY
Director of Public Works
DATE 6-4-62

NO. R-600
SHEET 2 OF 4

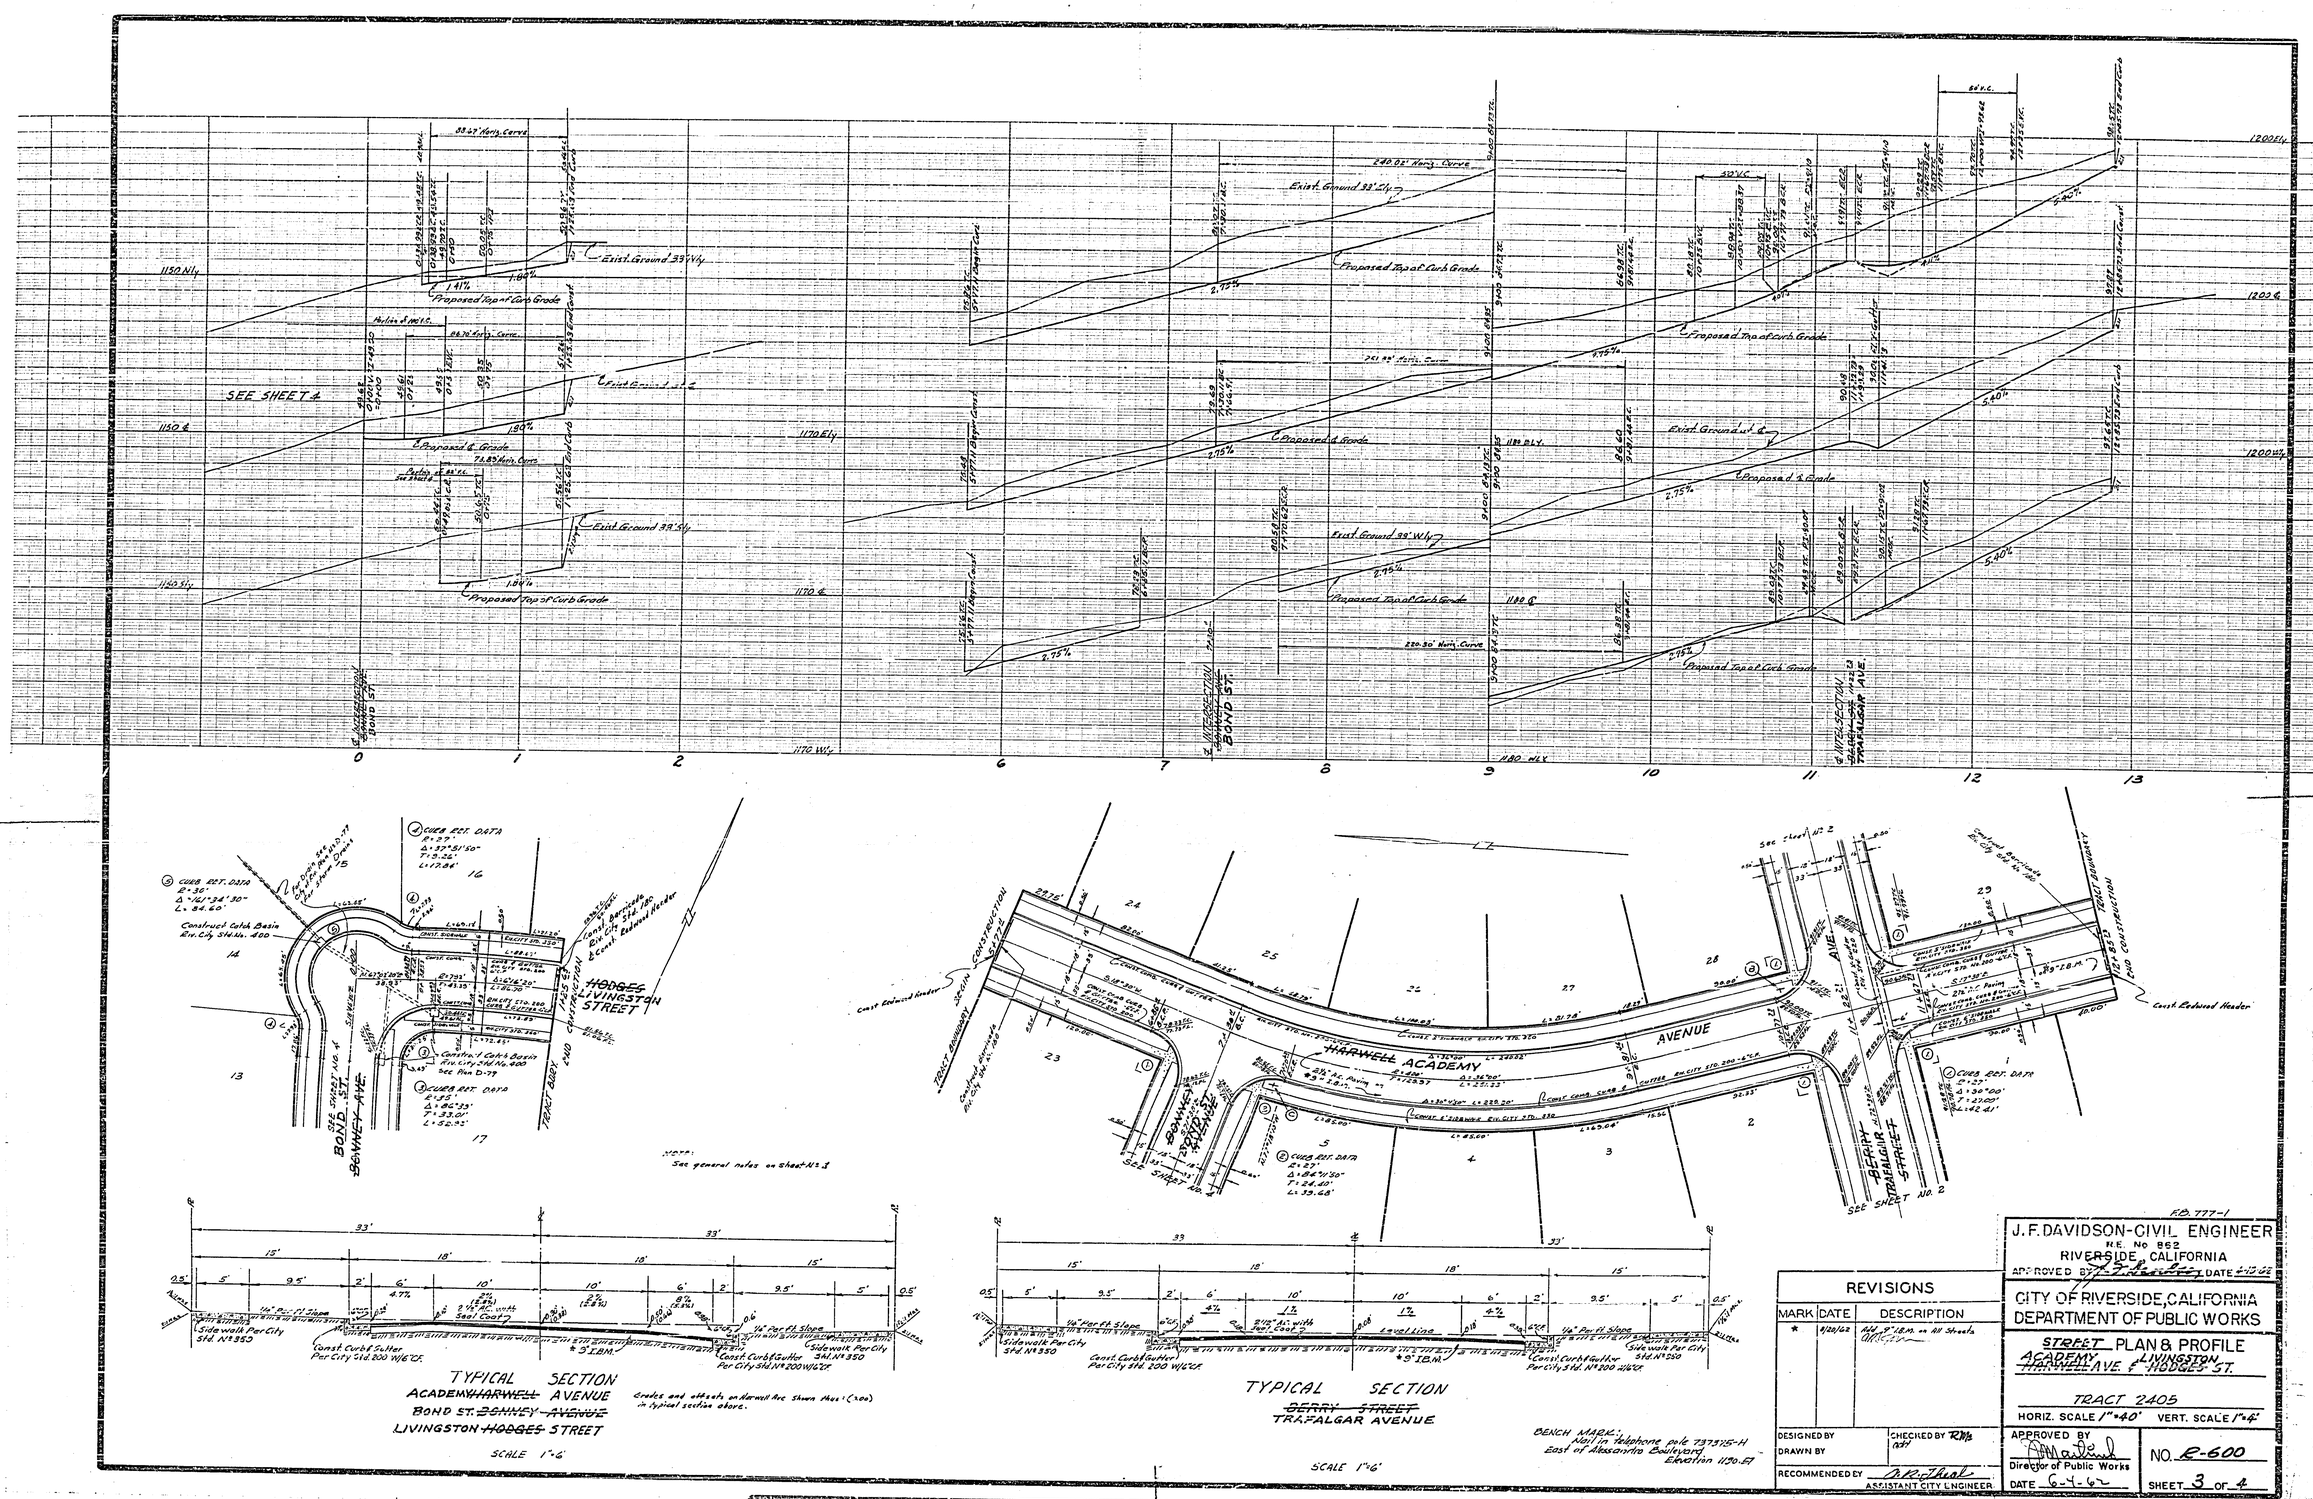

NOTE: See general notes on Sheet No. 3

TYPICAL SECTION
ACADEMY ~~HARWELL~~ AVENUE
BOND ST. ~~BONNEY AVENUE~~
LIVINGSTON ~~HODGES~~ STREET
SCALE 1"=6'

Grades and offsets on Harwell Ave. shown thus: (3.00) in typical section above.

TYPICAL SECTION
~~BERRY STREET~~
TRAFALGAR AVENUE
SCALE 1"=6'

BENCH MARK: Nail in telephone pole 737375-H East of Alessandro Boulevard Elevation 1130.51

REVISIONS		
MARK	DATE	DESCRIPTION
*	8/20/62	Add 9" I.B.M. on All Sheets

DESIGNED BY
DRAWN BY
CHECKED BY RMS
RECOMMENDED BY A.R. Thiel ASSISTANT CITY ENGINEER

F.B. 777-1

J. F. DAVIDSON-CIVIL ENGINEER
R.E. No 862
RIVERSIDE, CALIFORNIA
APPROVED BY [signature] DATE 6-15-62

CITY OF RIVERSIDE, CALIFORNIA
DEPARTMENT OF PUBLIC WORKS

STREET PLAN & PROFILE
ACADEMY ~~HARWELL~~ AVE. & LIVINGSTON ~~HODGES~~ ST.

TRACT 2405
HORIZ. SCALE 1"=40' VERT. SCALE 1"=4'

APPROVED BY [signature]
Director of Public Works
DATE 6-4-62

NO. R-600
SHEET 3 OF 4

2188

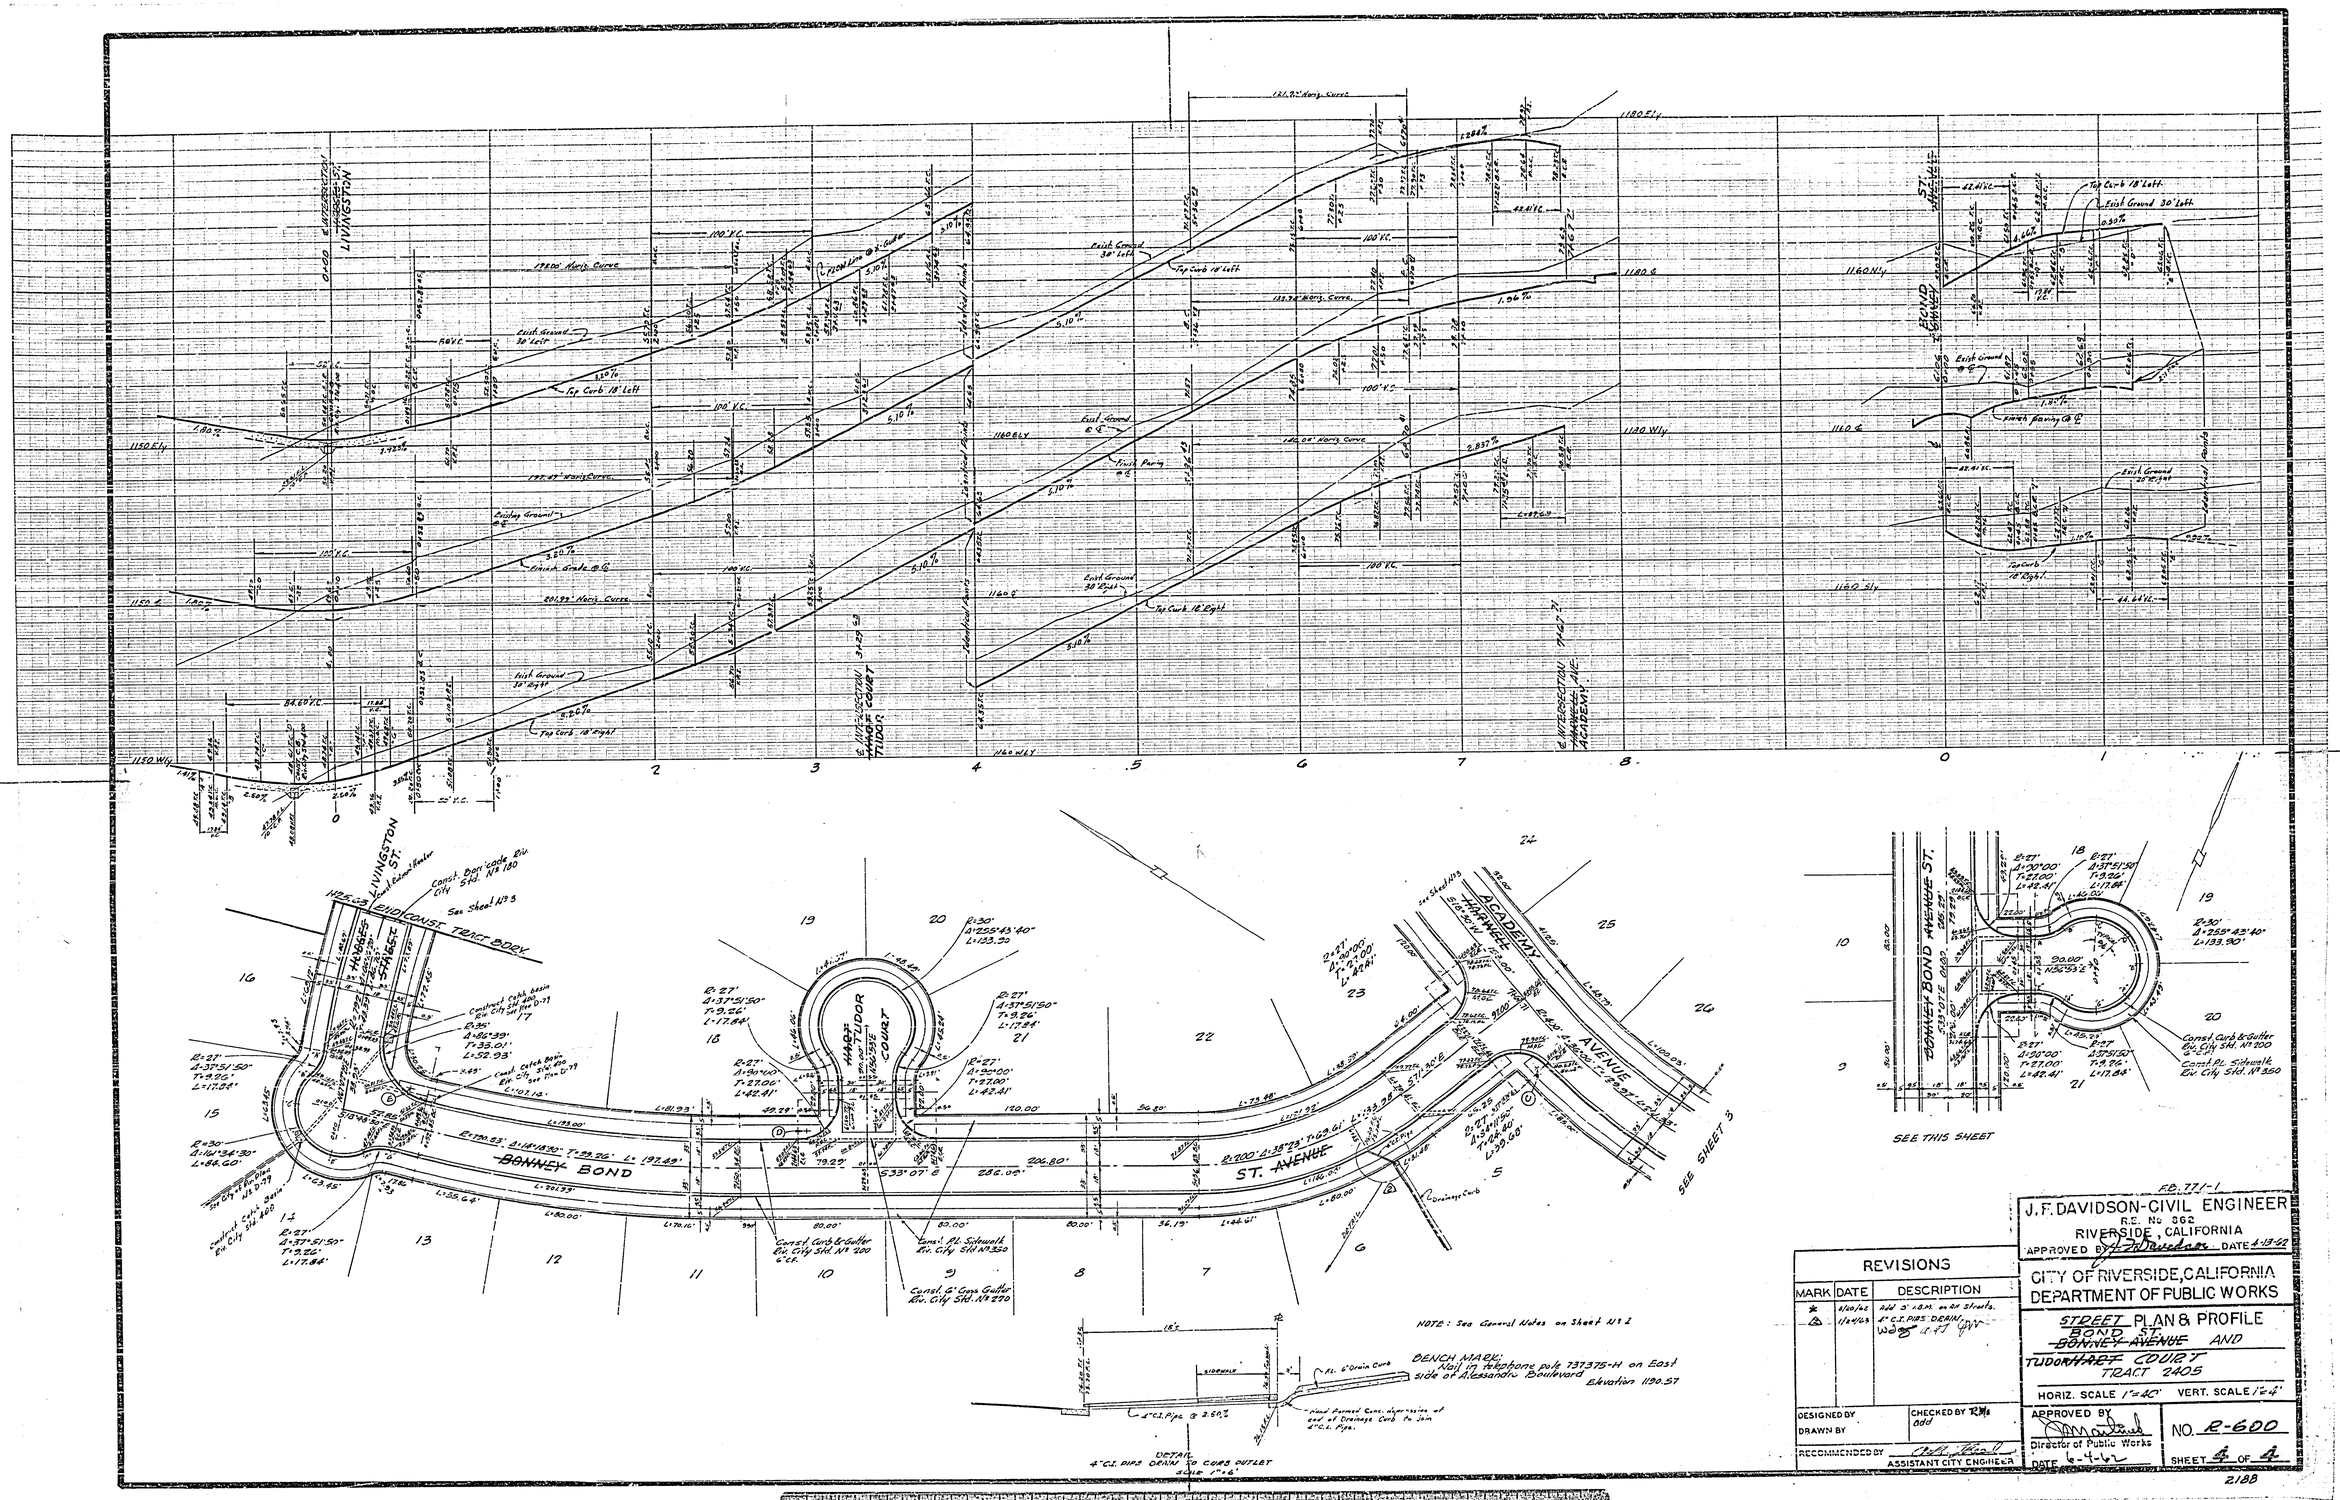

F.B. 771-1

J. F. DAVIDSON-CIVIL ENGINEER
R.E. No 362
RIVERSIDE, CALIFORNIA
APPROVED BY [signature] DATE 4-13-62

CITY OF RIVERSIDE, CALIFORNIA
DEPARTMENT OF PUBLIC WORKS

STREET PLAN & PROFILE
BOND ST. ~~BONNEY AVENUE~~ AND
TUDOR ~~HART~~ COURT
TRACT 2405

HORIZ. SCALE 1"=40' VERT. SCALE 1"=4'

REVISIONS		
MARK	DATE	DESCRIPTION
*	8/20/62	Add 5' I.B.M. on All Streets.
△	1/24/63	4" C.I. PIPE DRAIN.

DESIGNED BY
DRAWN BY
CHECKED BY RMB
RECOMMENDED BY [signature] ASSISTANT CITY ENGINEER

APPROVED BY [signature] Director of Public Works
DATE 6-4-62

NO. R-600
SHEET 4 OF 4

2188