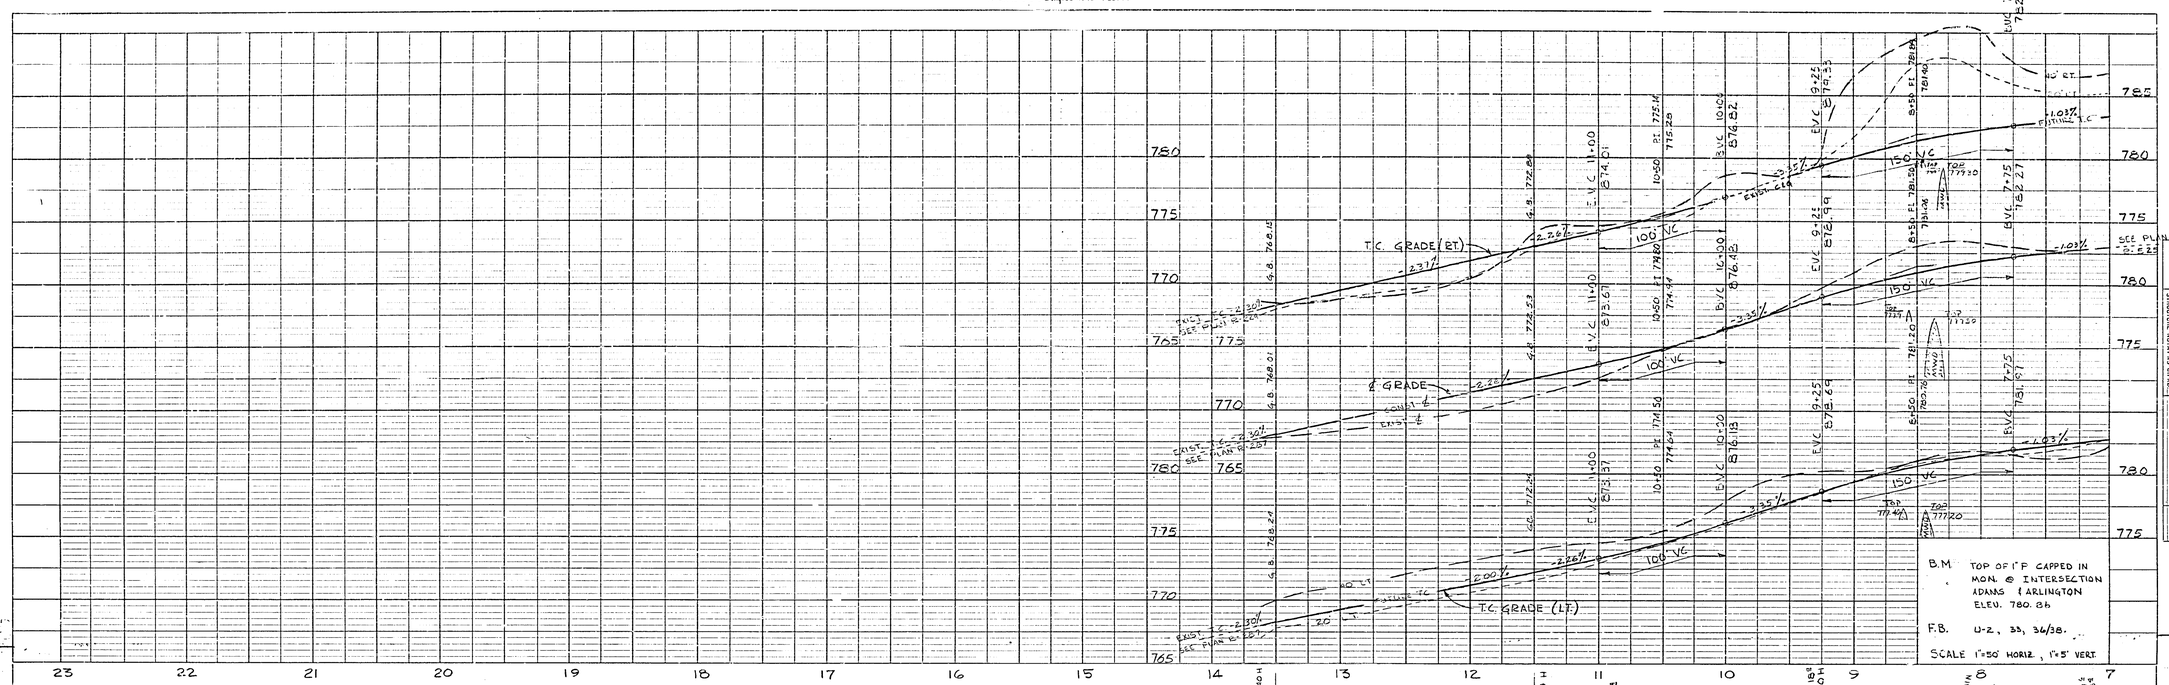

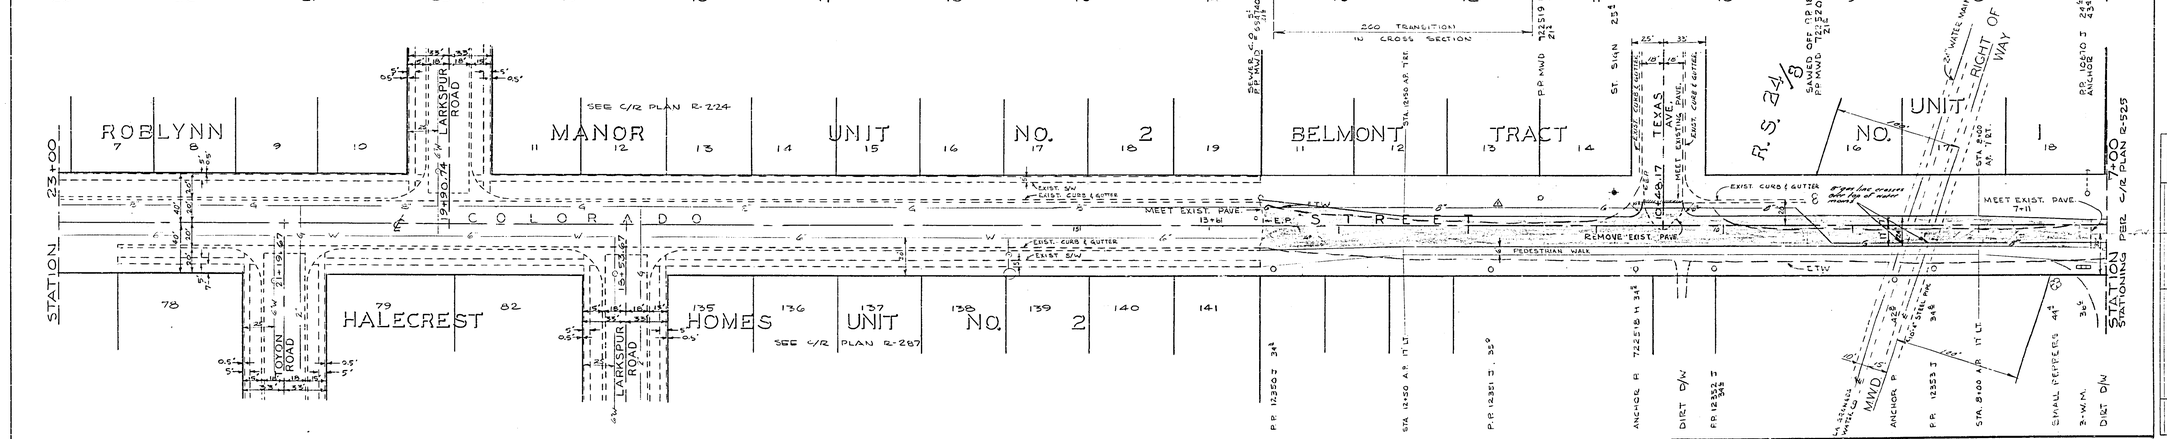

ESTIMATED EAR QUANTITIES

EARTHWORK	570	CY
REMOVE BITUMINOUS PAVE.	55	SY
ASPHALT CONCRETE	255	TON
AGGREGATE BASE	524	CY

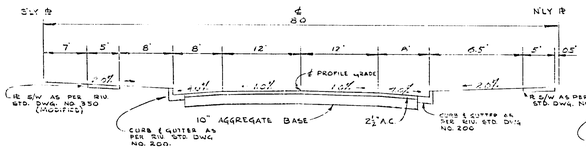

TYPICAL SECTION
STA. 13+50 TO STA. 23+00

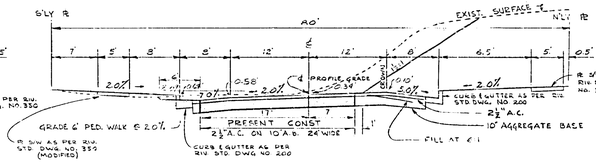

TYPICAL SECTION
STA. 8+00 TO STA. 11+50

SCALE 1"=50'

REVISIONS		
MARK	DATE	DESCRIPTION
A	10-14-62	Extend 8" gas line easterly of Sta. 17+60 ±

CITY OF RIVERSIDE, CALIFORNIA
DEPARTMENT OF PUBLIC WORKS

COLORADO STREET

BETWEEN
ADAMS ST. & MONROE ST.
STA. 7+00 TO STA. 23+00

COMPOSITE STREET WIDNG

DESIGNED BY	SUBMITTED BY	APPROVED BY	PROJ. NO. 5040-3036
DRAWN BY	PARK DEPT. / TRAFFIC DIV.	DIRECTOR OF PUBLIC WORKS	R-616
CHECKED BY	RECOMMENDED BY	DATE 8-17-62	SHEET 1 OF 1

CONTRACT PW-1, SHT. 10 OF 15