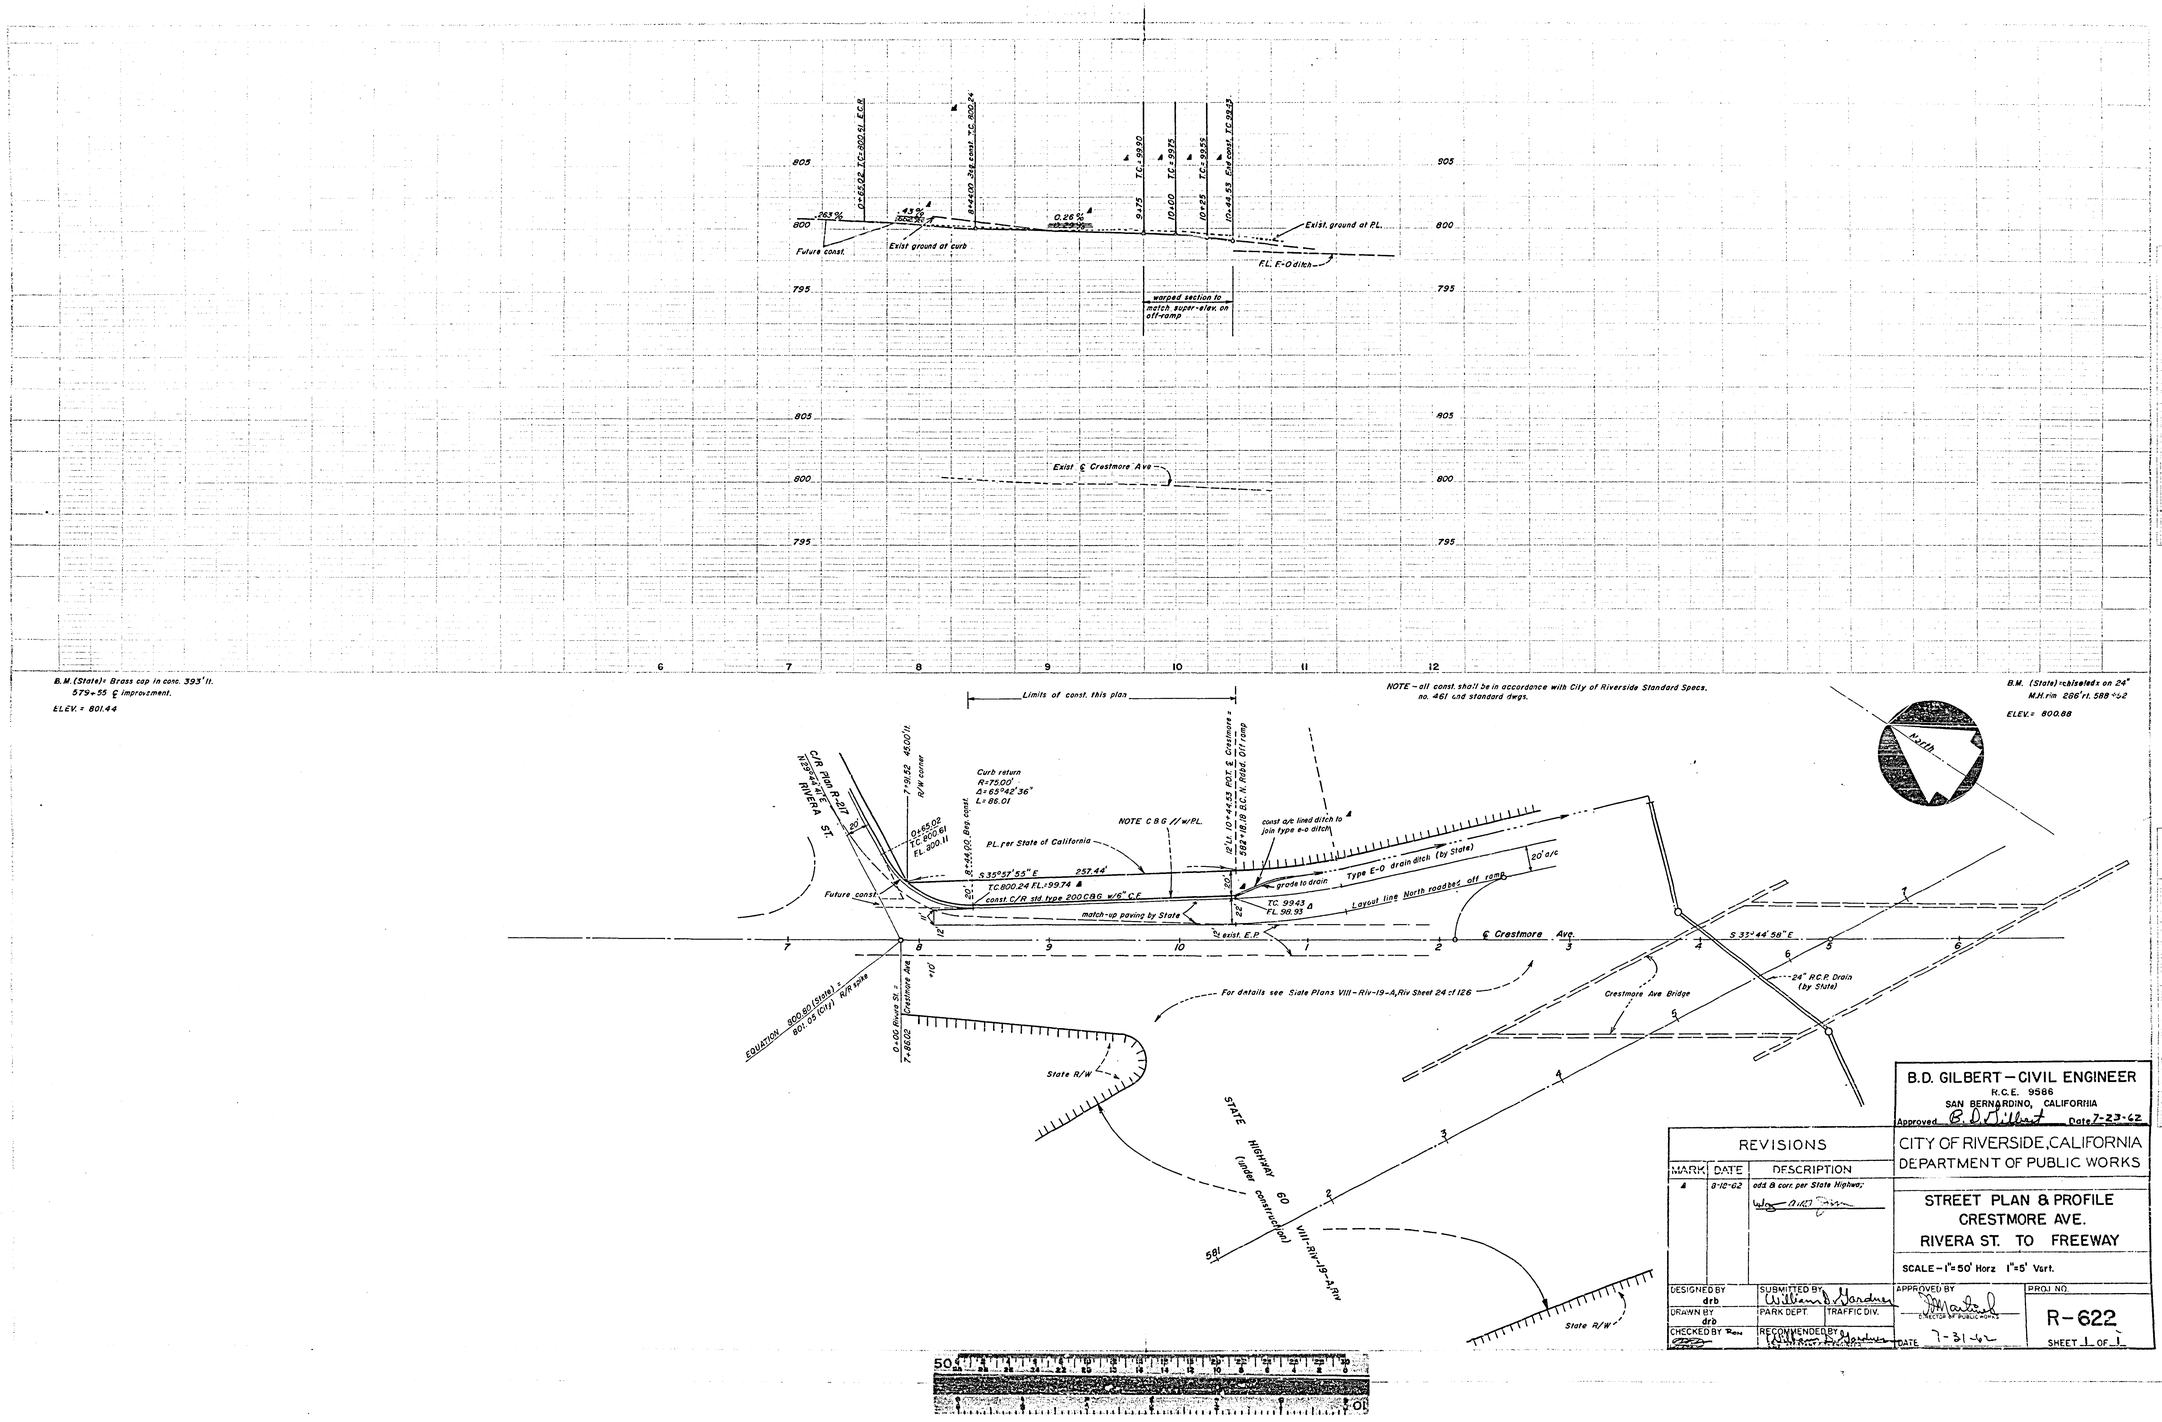

B.D. GILBERT – CIVIL ENGINEER
R.C.E. 9586
SAN BERNARDINO, CALIFORNIA
Approved B. D. Gilbert Date 7-23-62

CITY OF RIVERSIDE, CALIFORNIA
DEPARTMENT OF PUBLIC WORKS

STREET PLAN & PROFILE
CRESTMORE AVE.
RIVERA ST. TO FREEWAY

SCALE – 1"=50' Horz 1"=5' Vert.

REVISIONS		
MARK	DATE	DESCRIPTION
4	8-10-62	add & corr. per State Highway

DESIGNED BY drb	SUBMITTED BY		APPROVED BY
DRAWN BY drb	PARK DEPT.	TRAFFIC DIV.	PROJ. NO. R-622
CHECKED BY	RECOMMENDED BY	DATE 7-31-62	SHEET 1 OF 1