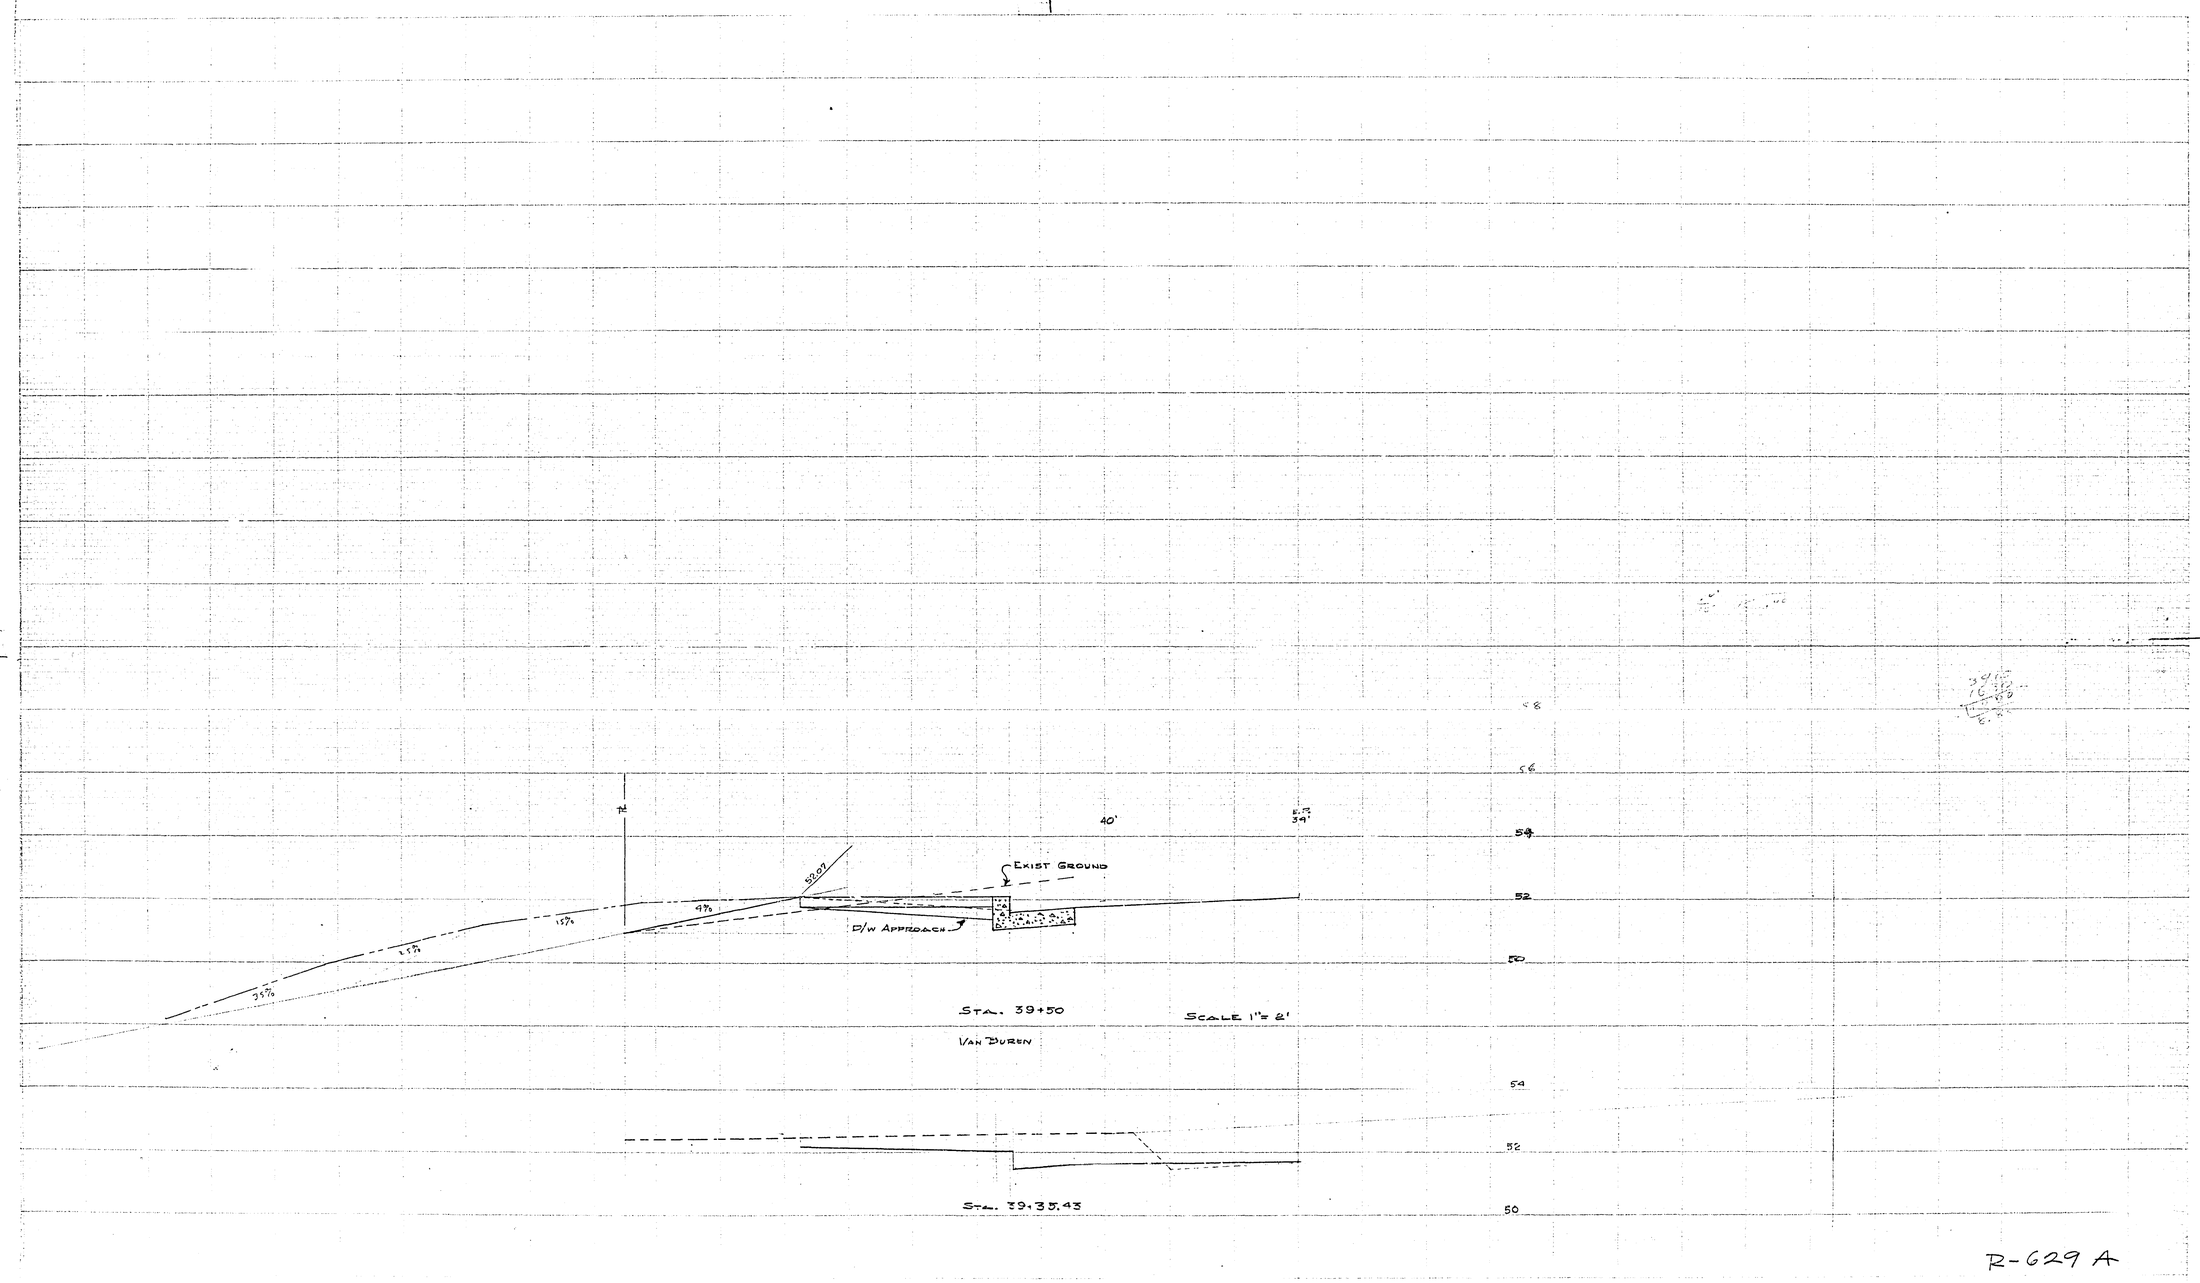

40'
E.P. 39'
52.07
EXIST GROUND
D/W APPROACH
4%
15%
15%
35%
STA. 39+50
VAN BUREN
SCALE 1"= 2'
STA. 39+35.43
58
56
54
52
50
54
52
50

R-629 A

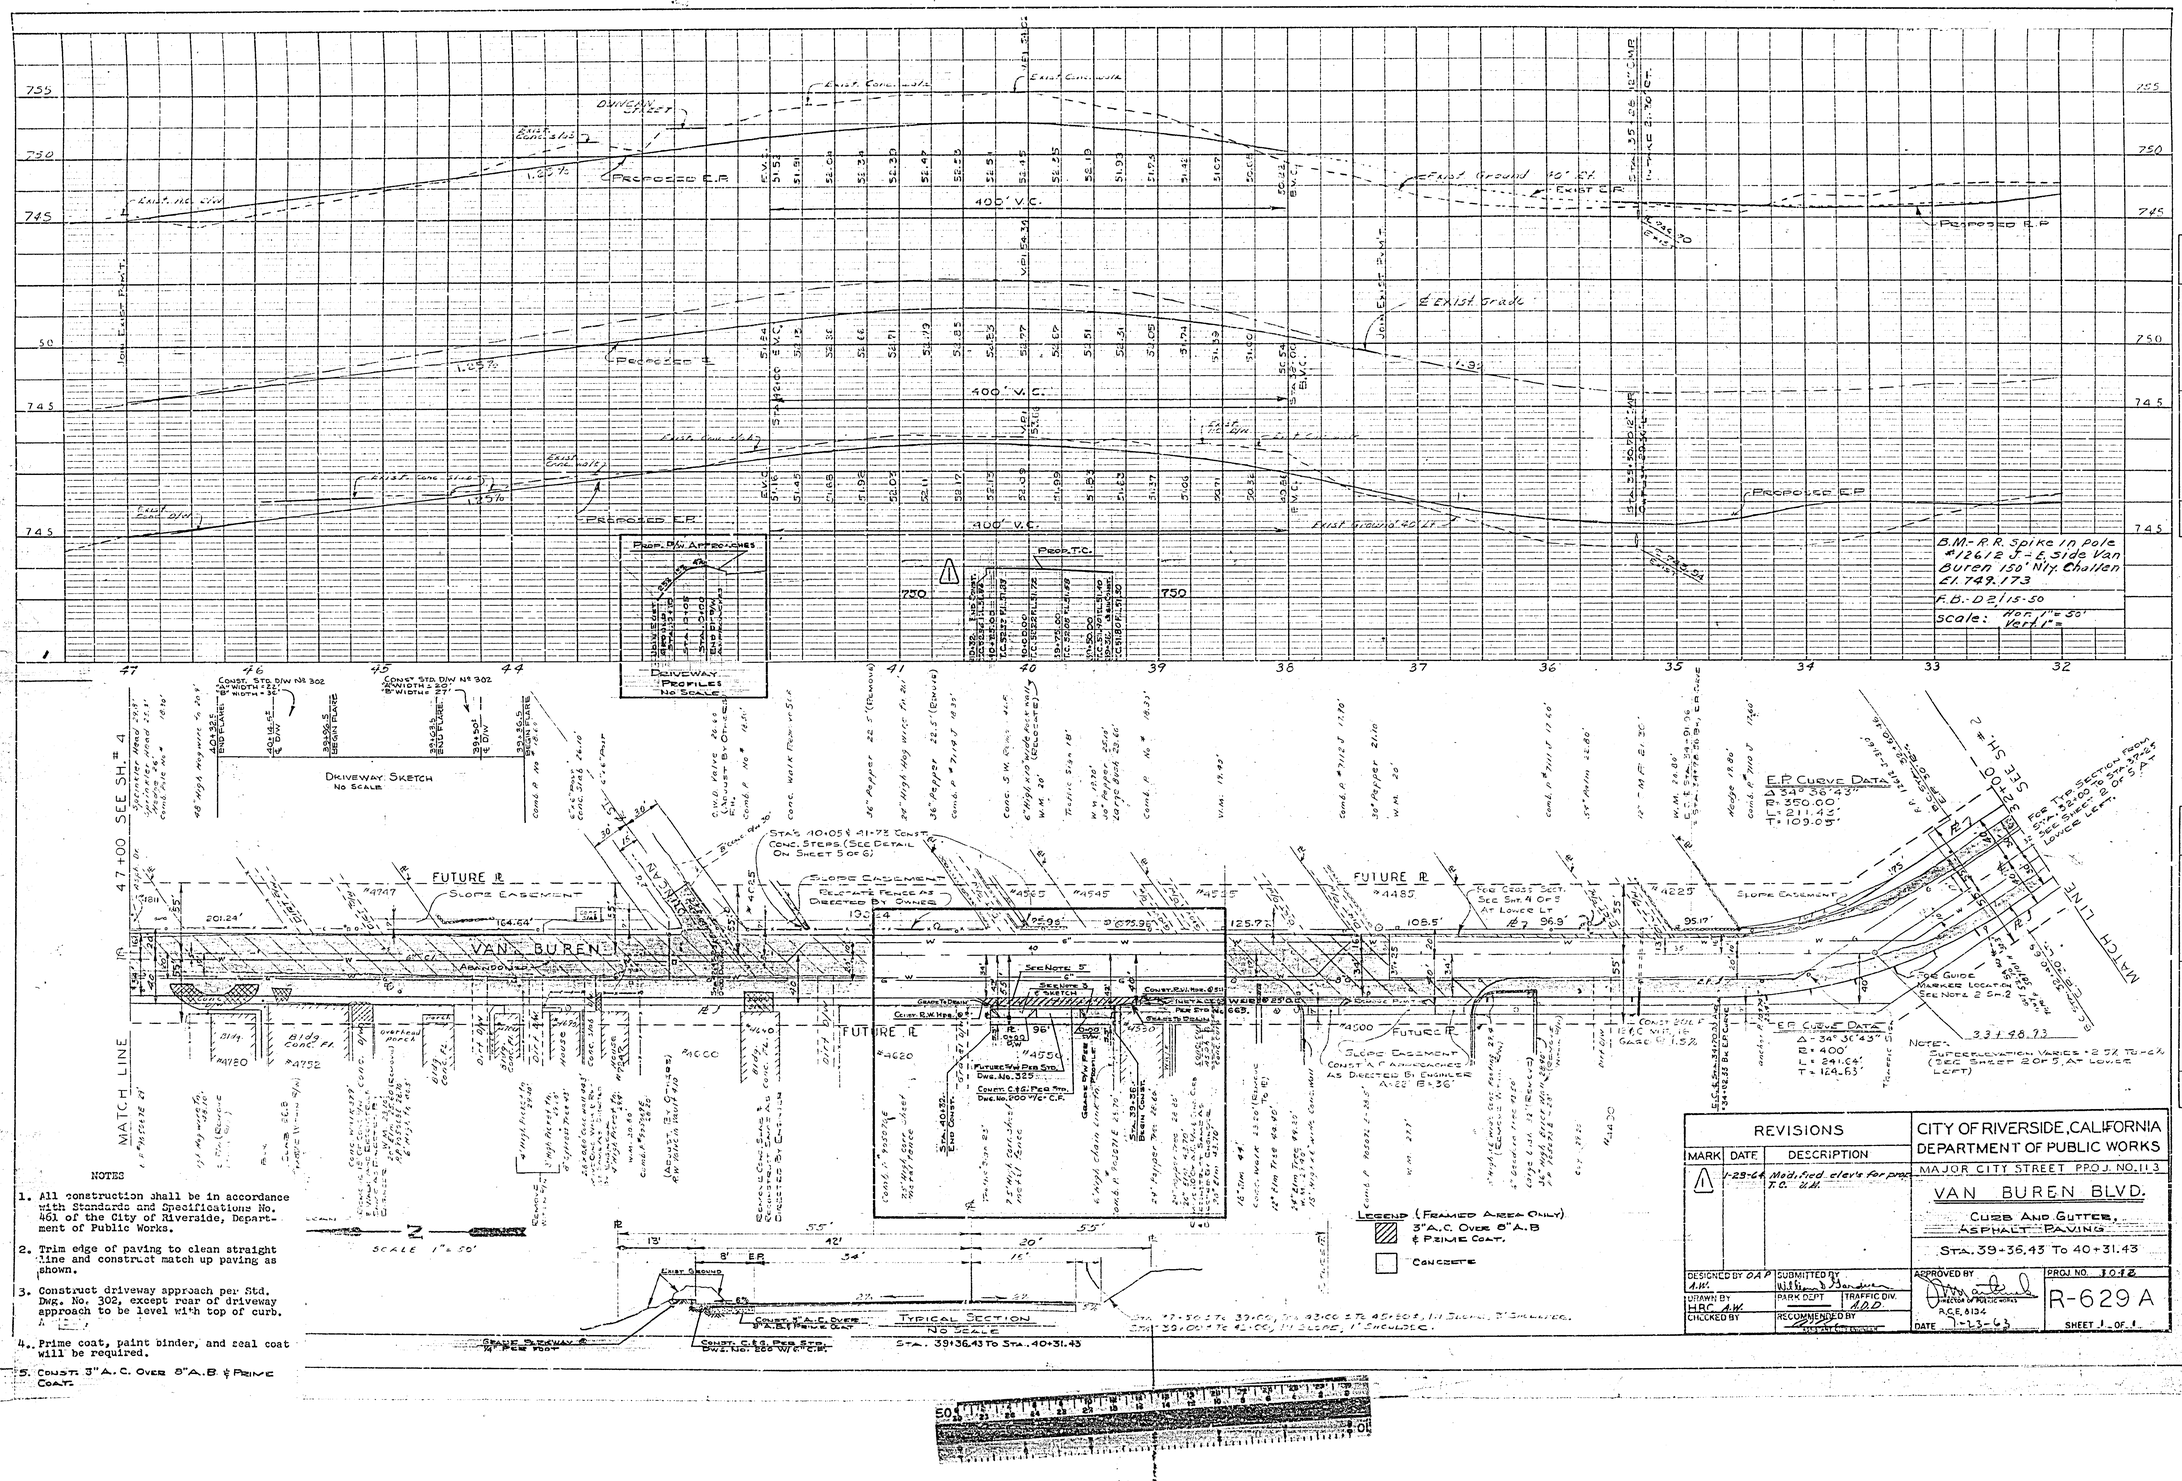

NOTES

1. All construction shall be in accordance with Standards and Specifications No. 461 of the City of Riverside, Department of Public Works.
2. Trim edge of paving to clean straight line and construct match up paving as shown.
3. Construct driveway approach per Std. Dwg. No. 302, except rear of driveway approach to be level with top of curb.
4. Prime coat, paint binder, and seal coat will be required.
5. Const. 3" A.C. Over 8" A.B. & Prime Coat.

REVISIONS		
MARK	DATE	DESCRIPTION
1	1-29-64	Modified elev's for prop. T.C. U.M.

CITY OF RIVERSIDE, CALIFORNIA
DEPARTMENT OF PUBLIC WORKS
MAJOR CITY STREET PROJ. NO. 113

VAN BUREN BLVD.
CURB AND GUTTER, ASPHALT PAVING
STA. 39+36.43 To 40+31.43

DESIGNED BY O.A.P. A.W.
DRAWN BY HRC A.W.
CHECKED BY
SUBMITTED BY William D. Gardner
PARK DEPT.
TRAFFIC DIV. A.D.D.
RECOMMENDED BY
APPROVED BY
DATE 1-23-63
PROJ. NO. 1012
R-629 A
SHEET 1 OF 1