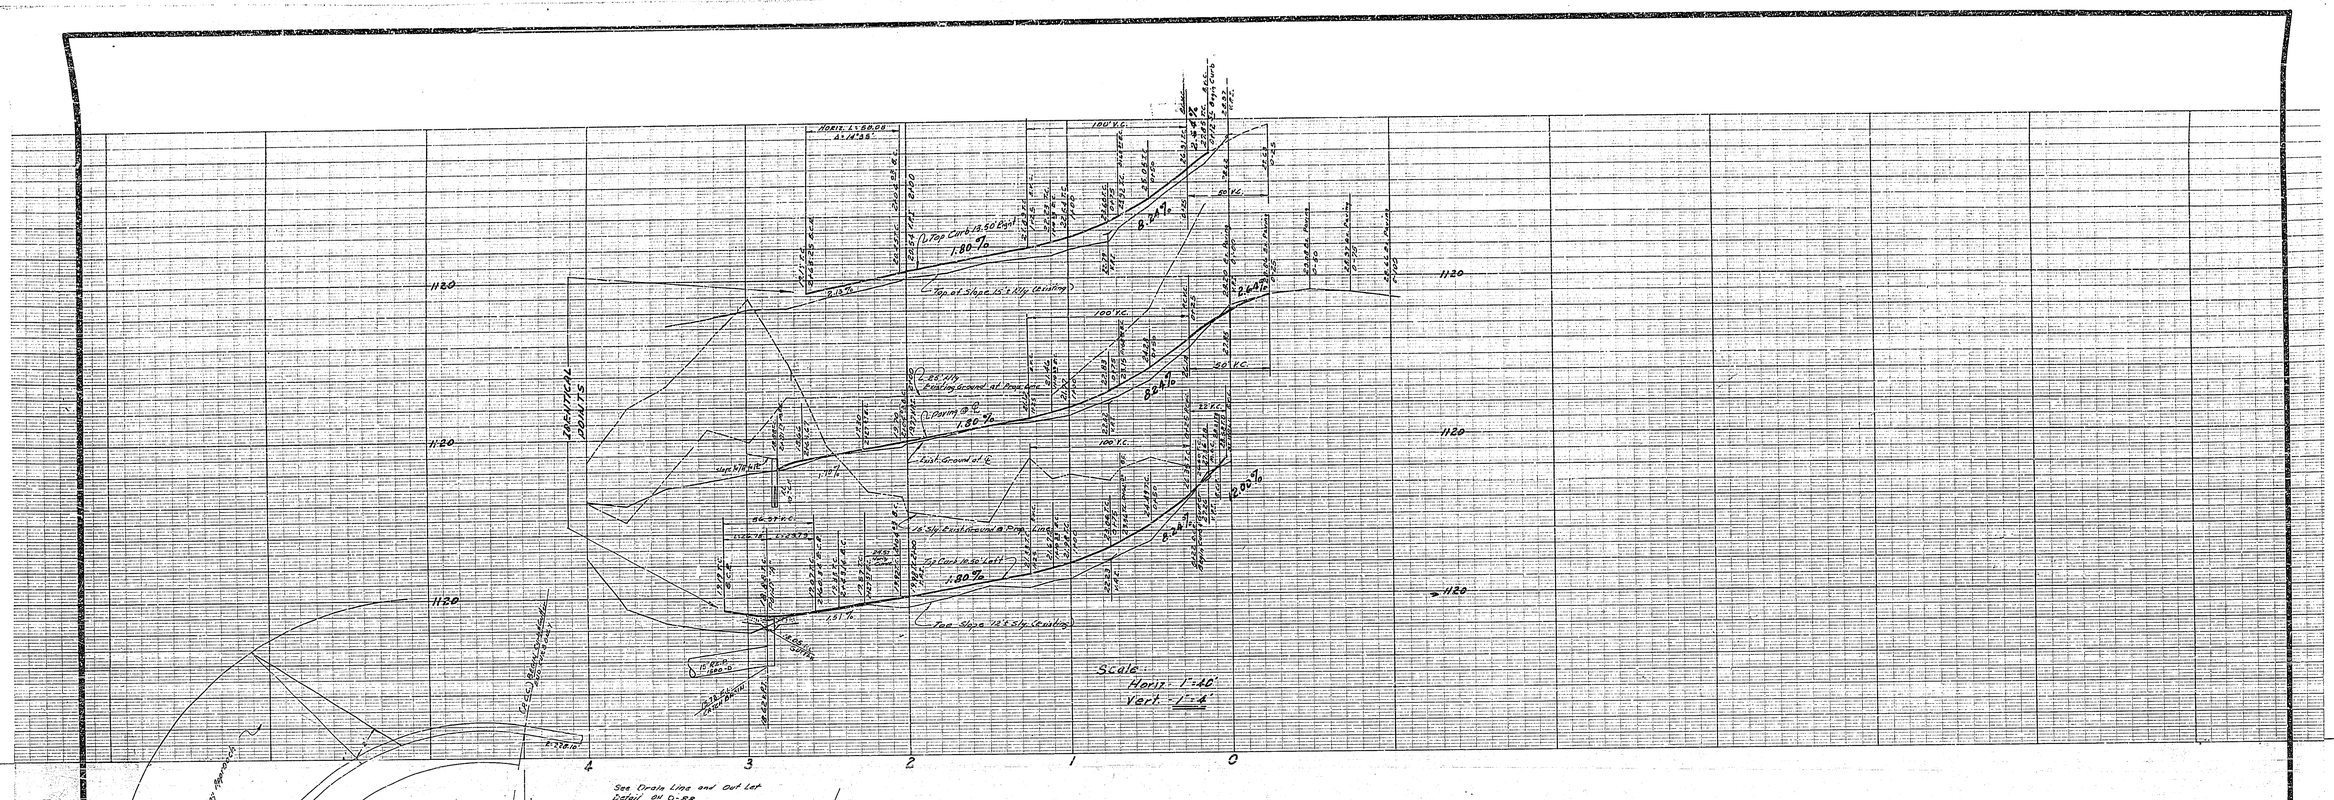

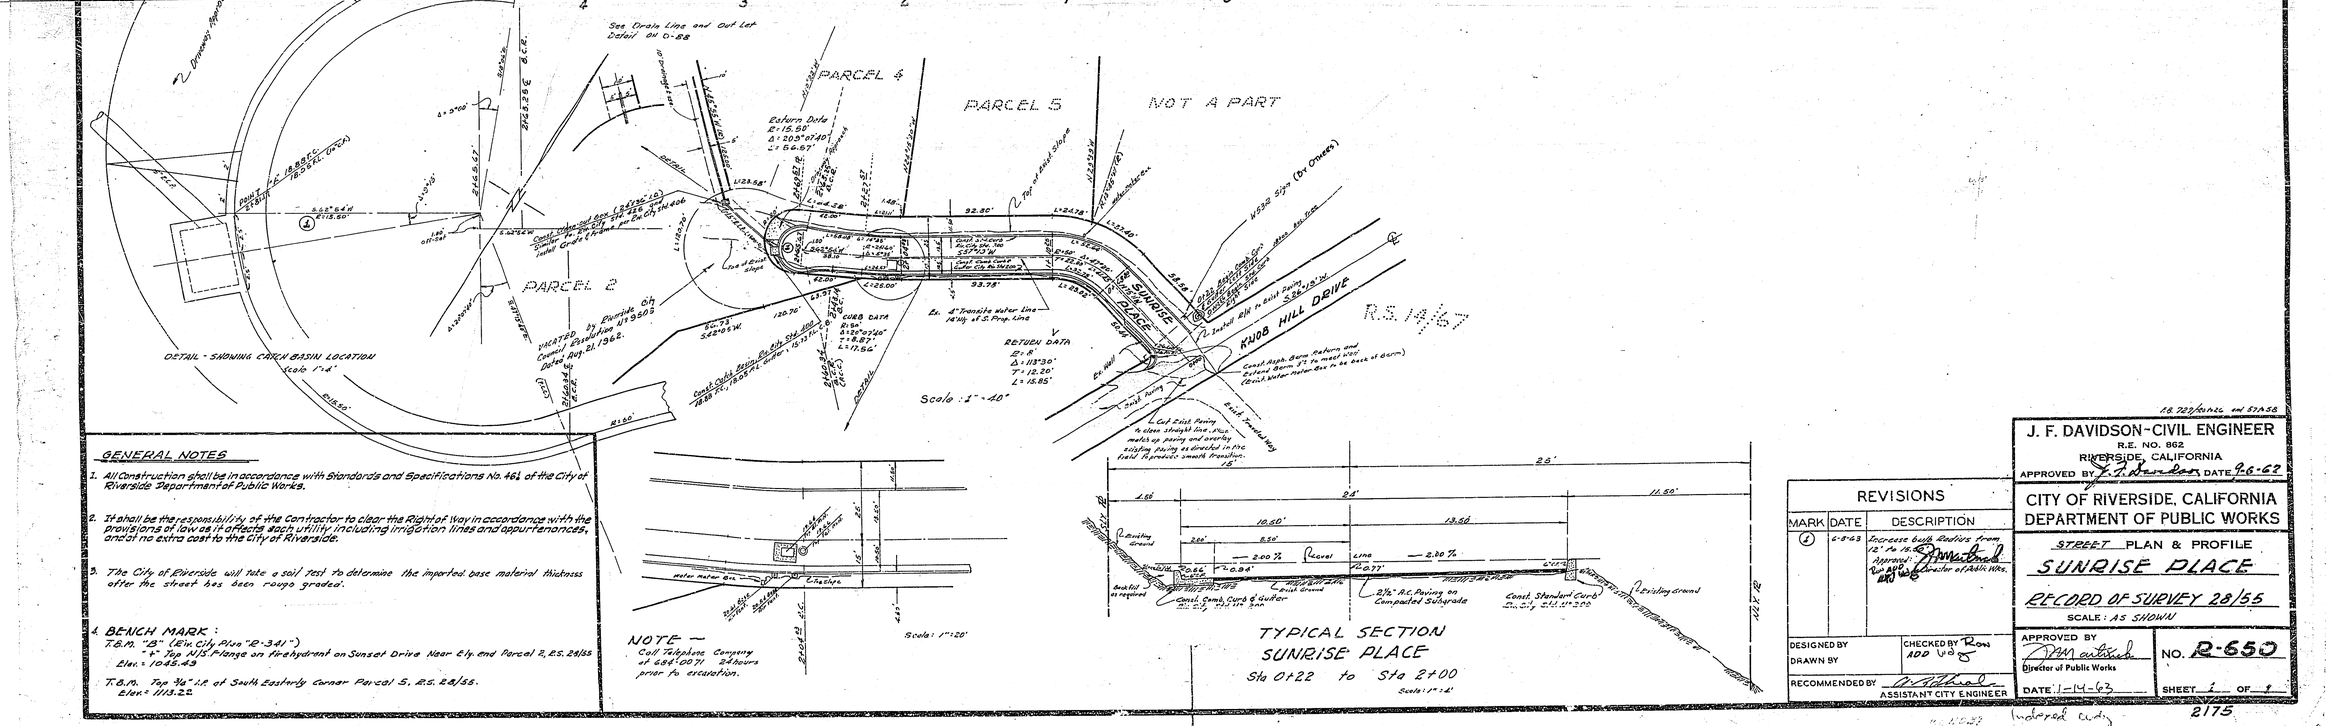

GENERAL NOTES

1. All Construction shall be in accordance with Standards and Specifications No. 461 of the City of Riverside Department of Public Works.
2. It shall be the responsibility of the Contractor to clear the Right of Way in accordance with the provisions of law as it affects each utility, including irrigation lines and appurtenances, and at no extra cost to the City of Riverside.
3. The City of Riverside will take a soil test to determine the imported base material thickness after the street has been rough graded.
4. BENCH MARK:
   T.B.M. "B" (Elev. City Plan "R-341")
   "+" Top U.S. Flange on fire hydrant on Sunset Drive Near Ely. end Parcel 2, R.S. 28/55
   Elev. = 1045.43
   T.B.M. Top 3/4" I.P. of South Easterly Corner Parcel 5, R.S. 28/55.
   Elev. = 1113.22

REVISIONS		
MARK	DATE	DESCRIPTION
1	2-8-63	Increase bulb Radius from 12' to 15.50' Approved: Director of Public Works

DESIGNED BY
DRAWN BY
CHECKED BY Ron
RECOMMENDED BY — ASSISTANT CITY ENGINEER

J. F. DAVIDSON-CIVIL ENGINEER
R.E. NO. 862
RIVERSIDE, CALIFORNIA
APPROVED BY J. F. Davidson DATE 9-6-62

CITY OF RIVERSIDE, CALIFORNIA
DEPARTMENT OF PUBLIC WORKS

STREET PLAN & PROFILE
SUNRISE PLACE
RECORD OF SURVEY 28/55
SCALE: AS SHOWN

APPROVED BY
Director of Public Works
DATE 1-14-63
NO. R-650
SHEET 1 OF 4

2175