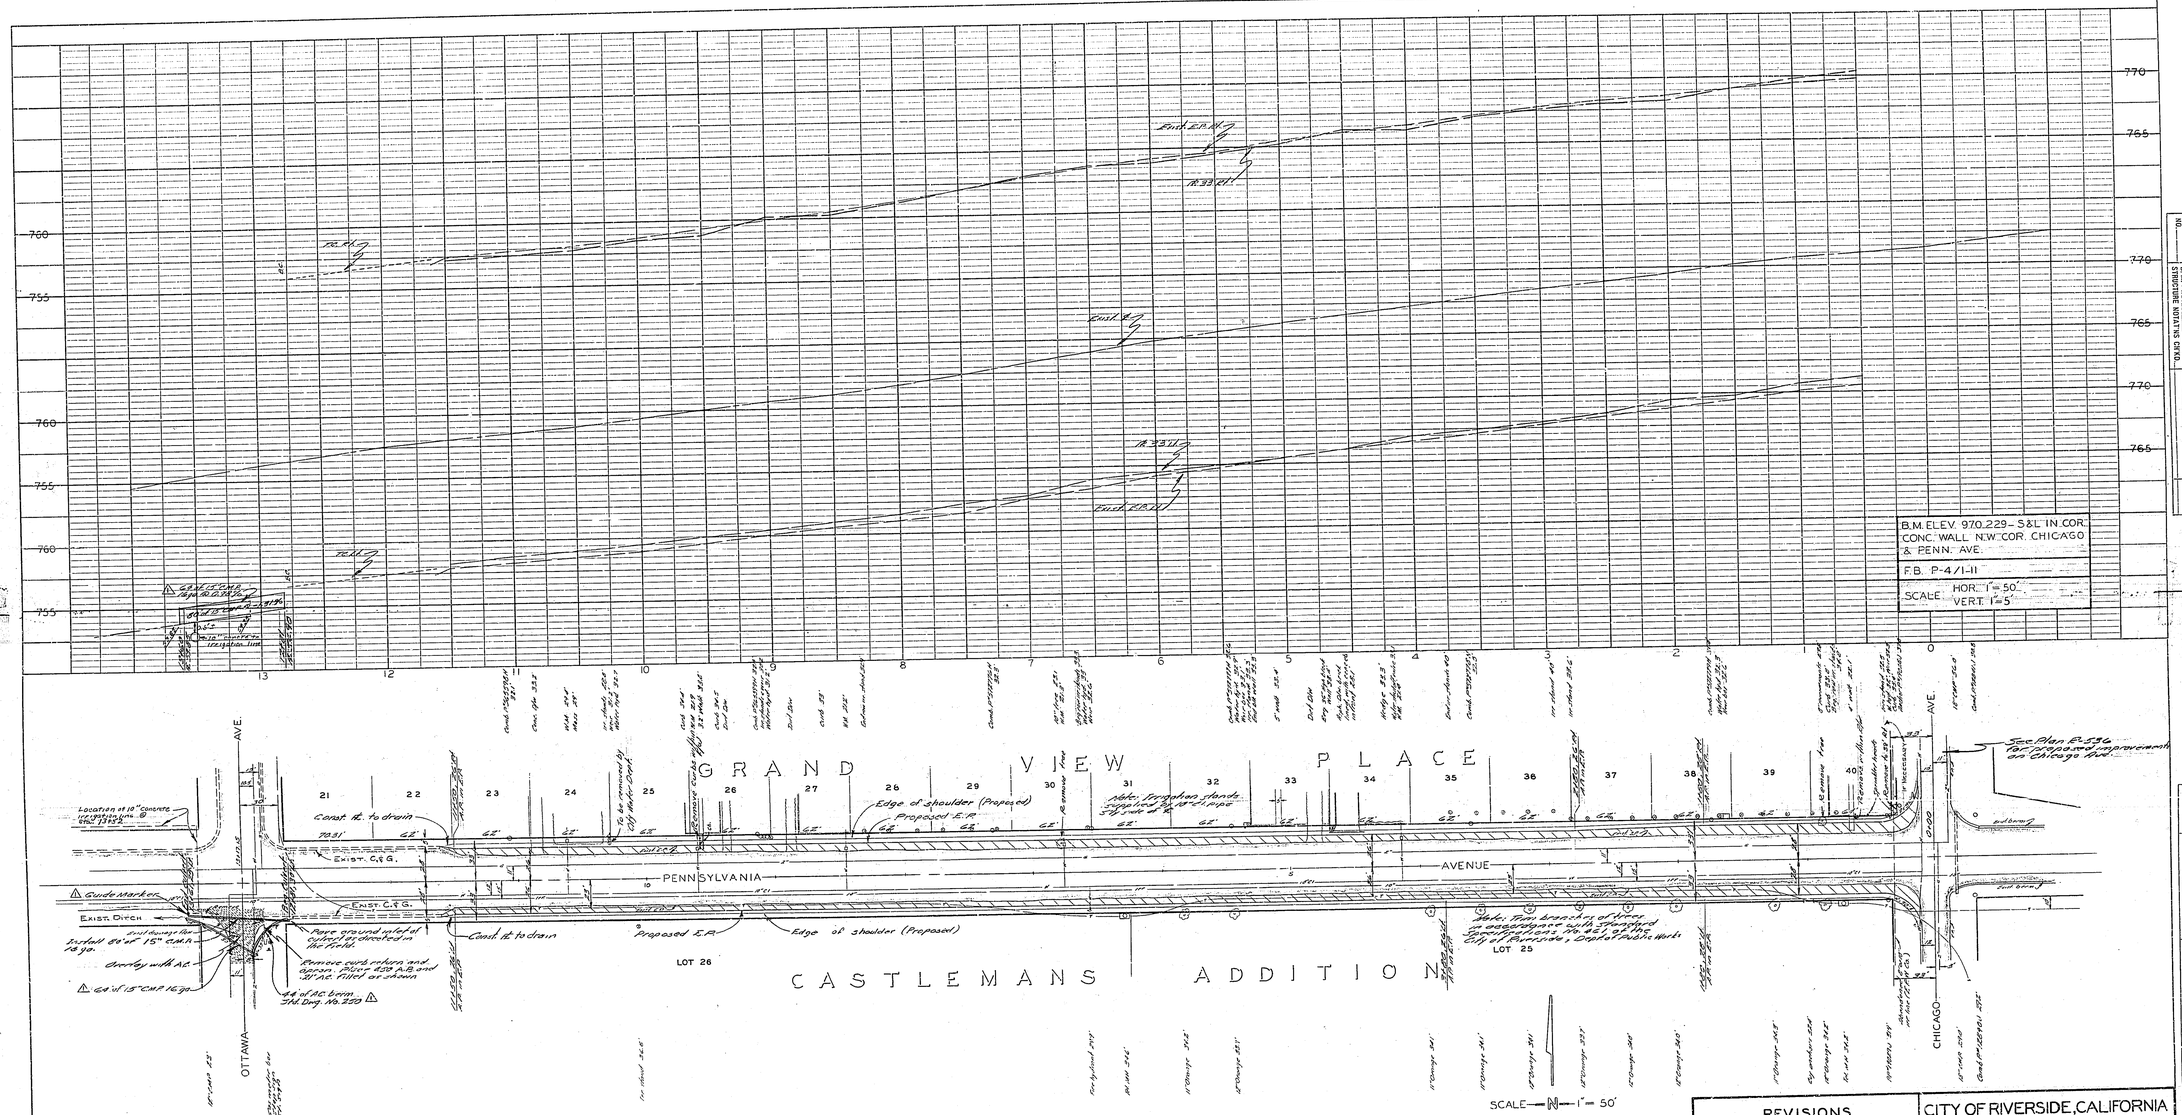

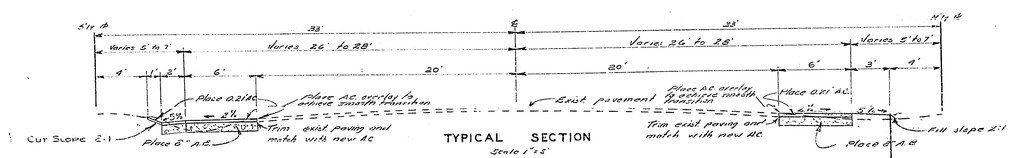

TYPICAL SECTION
Scale 1" = 5'

NOTE:
1. WATER METERS AND BOXES TO BE RELOCATED BY WATER DEPT., CITY OF RIVERSIDE.
2. RELOCATE ROAD SIGNS AND MAIL BOXES AS DIRECTED BY ENGINEER.

REVISIONS		
MARK	DATE	DESCRIPTION
1	11/25/63	Added "As Built" per Change Order No. 2

CITY OF RIVERSIDE, CALIFORNIA
DEPARTMENT OF PUBLIC WORKS

PENNSYLVANIA AVENUE WIDENING
CHICAGO AVE. TO OTTAWA AVE.

DESIGNED BY	SUBMITTED BY	APPROVED BY	PROJ. NO. 3052
DRAWN BY	PARK DEPT. / TRAFFIC DIV.	DIRECTOR OF PUBLIC WORKS	R-659
CHECKED BY	RECOMMENDED BY ASSISTANT CITY ENGINEER	DATE 5-20-63	SHEET 1 OF 1

PROFILE
NOTE BOOK NO.
SURVEYED
PLOTTED
GRADES CHECKED
B.M.'S NOTED
STRUCTURE NOTATIONS CHKD.
BY
DATE

PLAN
NOTE BOOK NO.
SURVEYED
PLOTTED
ALIGNMENT CHECKED
RT. OF WAY CHECKED
BY
DATE

[redacted]