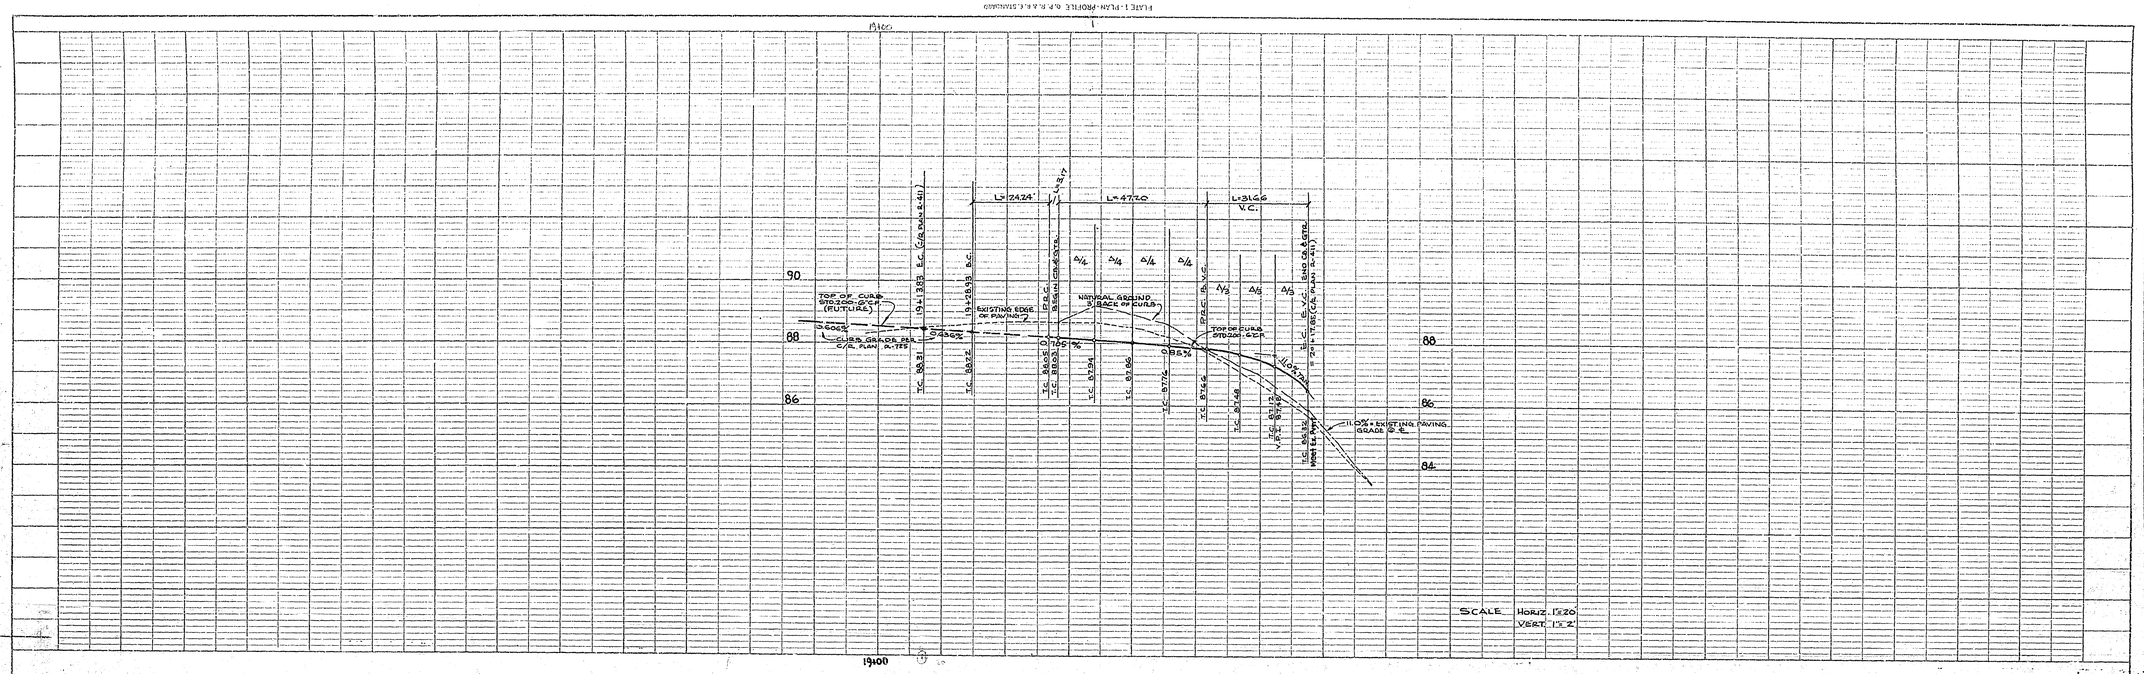

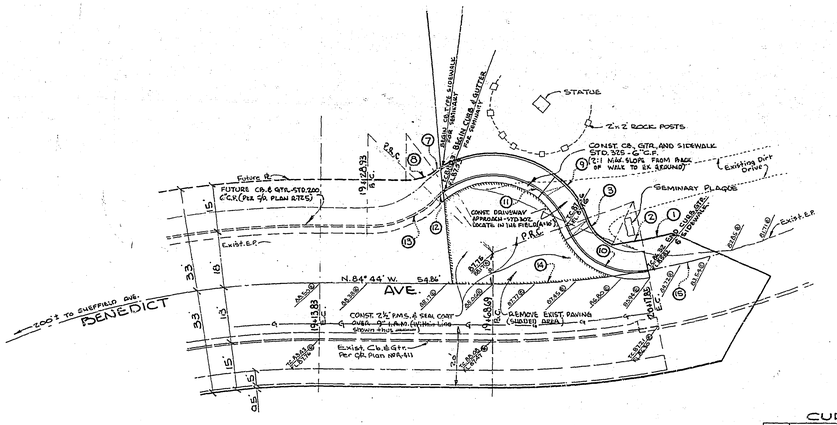

NOTE:
ALL CONSTRUCTIONS REQUIRED BY THIS PLAN OR C.U.P. #C-3-623 IS TO BE DONE AT THE OF CONSTRUCTION OF IMPROVEMENTS FOR TRACT NO. 2623, C/R PLAN R-775.

BENCH MARK: F.B. 438/41
AT WEST END OF HEADWALL ON SOUTH SIDE OF BRIDGE TO CASTLE.
ELEV. 1067.43

GENERAL NOTES

1. IT SHALL BE THE RESPONSIBILITY OF THE CONTRACTOR TO CLEAR THE RIGHT OF WAY IN ACCORDANCE WITH THE PROVISIONS OF LAW AS IT AFFECTS EACH UTILITY INCLUDING IRRIGATION LINES AND APPURTENANCES AND AT NO COST TO THE CITY.
2. CONSTRUCTION SHALL BE IN ACCORDANCE WITH THE CITY OF RIVERSIDE DEPARTMENT OF PUBLIC WORKS SPECIFICATIONS No. 461 AND STANDARD DRAWINGS.
3. TRIM EDGE OF EXISTING PAVING WHERE NEW PAVING JOINS EXISTING PAVEMENT TO CLEAN STRAIGHT LINE. CONSTRUCT MATCH-UP PAVING AS SHOWN AND OVERLAY EXISTING PAVING AS DIRECTED IN THE FIELD TO PRODUCE SMOOTH CROWN SECTION.
4. PAINT BINDER AND PRIME COAT ARE REQUIRED.
5. ELEVATIONS DESIGNATED WITH ⓔ ARE EXISTING.

QUANTITY ESTIMATE

CURB AND GUTTER - STD. 200 - 6"C.F.	80 L.F.
CURB TYPE SIDEWALK - STD. 325	500 S.F.
2½" P.M.S. & SEAL COAT	1670 S.F.
~~SHEET ASPHALT - HEAVY~~	~~75 S.Y.~~
I.B.M. (9")	46 C.Y.
PAVING REMOVAL	1870 S.F.
~~BARRICADE - STD. 150 - TYPE III~~	~~1 EA.~~

CURVE DATA

NO.	RAD	Δ	T	L
1	342.75	1 40 40	5.02	10.04
2	24.000	2 15 05	4.72	9.43
3	15.50	43 04 19	6.16	11.69
7	52.00	5 01 40	1.40	2.81
8	15.00	36 02 57	4.88	9.44
9	52.00	100 09 20	38.24	55.95
10	22.56	80 24 03	18.95	31.66
11	25.00	108 10 25	34.52	47.20
12	25.00	7 15 29	1.59	3.17
13	20.00	44 17 51	12.83	24.24
14	25.000	11 16 00	24.66	49.16
15	352.75	3 48 40	11.74	23.46

ALBERT A. WEBB ASSOCIATES
CIVIL ENGINEERS - RIVERSIDE, CALIFORNIA
APPROVED [signature] R.E. 9876 DATE 2/7/63

REVISION		
MARK	DATE	DESCRIPTION
		Letter 10/24/63 J.B. 10/10/63

CITY OF RIVERSIDE, CALIFORNIA
DEPARTMENT OF PUBLIC WORKS

STREET PLAN & PROFILE
BENEDICT AVENUE
EASTERLY TERMINATION AT ENTRANCE TO OUR LADY OF RIVERSIDE SEMINARY
C.U.P. #C-3-623

DATE DECEMBER 1962	SCALE 1"=20'	APPROVED BY [signature] INSPECTOR OF PUBLIC WORKS	NO. R-668
DRAWN [illegible]	W.O. 62-265		
CHECKED FOR [illegible]	F.B. 438/41	DATE 11-26-63	SHEET 1 OF 1

DWG. No. 62-265 A

PROFILE
SURVEYED
PLOTTED
HORIZ. CHECKED
VERT. CHECKED
NOTE BOOK
NO.
STRUCTURE DETAILS CHECKED
BY
DATE

PLAN
SURVEYED
PLOTTED
HORIZ. CHECKED
VERT. CHECKED
NOTE BOOK
NO.
RIGHT OF WAY CHECKED
BY
DATE